

AS-BUILT

ABO	18 Jul 2023	AS-BUILT	 A. Hiraka	 A. Hiraka	 Y. Takehana
REV	DATE	DESCRIPTION	Approved	Checked	Prepared
OWNER  VAN PHONG POWER COMPANY LIMITED					
PROJECT Van Phong 1 BOT Thermal Power Plant Project					
OWNER'S ENGINEER AFRY Switzerland Ltd.			 AF PÖYRY		
			Status ☐ Approved ☐ Approved with Comment ☐ Not Approved ☐ Reviewed ☐ Reviewed with Comment		
EPC CONTRACTORS IHI-TESSC-CTCI-DHI CONSORTIUM  					
PROJECT DOCUMENT No VP1-C-L2-I-CB-00006					REV ABO
DOCUMENT TITLE Logic Diagrams for Boiler Feedwater Pump					
EPC TOSHIBA Toshiba Energy Systems & Solutions Corporation			EPC DOCUMENT No. 4GCH01007		REV 3

OWNER : VAN PHONG POWER COMPANY LIMITED

PLANT : Van Phong 1 BOT Thermal
Power Plant Project 2 × 673MW

O/#: M211087/M211088

Logic Diagrams for Boiler Feedwater Pump(TM)

OWNER		 VAN PHONG POWER COMPANY LIMITED
PROJECT Van Phong 1 BOT Thermal Power Plant Project		
OWNER'S ENGINEER AFRY Switzerland Ltd.		 VAN PHONG POWER COMPANY LIMITED
		Status ☐ Approved ☐ Approved with Comment ☐ Not Approved ☐ Reviewed ☐ Reviewed with Comment
EPC CONTRACTORS IHI-TESSC-CTCI-DHI CONSORTIUM		
    中鼎工程股份有限公司 CTCI Corporation		
PROJECT DOCUMENT No VP1-C-L2-I-CB-00006		REV AB0
DOCUMENT TITLE Logic Diagrams for Boiler Feedwater Pump		

THE INFORMATION IN THIS MATERIAL IS
CONFIDENTIAL AND CONTAINS TOSHIBA'S
INTELLECTUAL PROPERTY INCLUDING KNOW-HOW.
IT SHALL NOT BE DISCLOSED TO ANY THIRD PARTY,
COPIED, REPRODUCED, USED FOR UNAUTHORIZED
PURPOSES NOR MODIFIED WITHOUT PRIOR WRITTEN
CONSENT OF TOSHIBA.
TOSHIBA ENERGY SYSTEMS & SOLUTIONS CORPORATION

GLOBAL PLANT ENGINEERING GROUP INFORMATION AND CONTROL SYSTEMS ENGINEERING DEPT. THERMAL & HYDRO POWER SYSTEM & SERVICE DIV.			
DRAWN BY	DESIGNED BY	CHECKED BY	APPROVED BY
T. MOGAMI	T. MOGAMI	A. HIRAKA	A. HIRAKA

Rev. No.	0	1	2	3								Van Phong 1 BOT Thermal Power Plant Project 2 × 673MW	SH
DATE	2021/3/5	2021/12/15	2022/11/8	2023/7/5									TM001
APPROVED BY	–	A. Hiraka	A. H	A. H									REV
REVISED BY	–	T. Mogami	C. B. D/Y. T/T. H	C. B. D/Y. T/T. H									3
CONTENTS	1st Issue	Revised	Revised	Revised								FRONT COVER	
												DRAWING No.	4GCH01007

SHEET No.	TITLE	REV.	SHEET No.	TITLE	REV.	SHEET No.	TITLE	REV.
TM001	FRONT COVER	3	TM115	FIELD AI PROCESSING (16)	2	TM149	FIELD AI PROCESSING (50)	2
TM002	INDEX(1)	3	TM116	FIELD AI PROCESSING (17)	3	TM150	FIELD AI PROCESSING (51)	2
TM003	INDEX(2)	3	TM117	FIELD AI PROCESSING (18)	2	TM151	FIELD AI PROCESSING (52)	3
TM004	INDEX(3)	3	TM118	FIELD AI PROCESSING (19)	2	TM152	FIELD AI PROCESSING (53)	1
TM005	INDEX(4)	3	TM119	FIELD AI PROCESSING (20)	2	TM153	FIELD AI PROCESSING (54)	1
TM006	INDEX(5)	3	TM120	FIELD AI PROCESSING (21)	2	TM154	FIELD AI PROCESSING (55)	1
TM015	REF DWG NO. LIST (1)	1	TM123	FIELD AI PROCESSING (24)	2	TM155	FIELD AI PROCESSING (56)	2
TM020	BOILER FEEDWATER PUMP	2	TM126	FIELD AI PROCESSING (27)	2	TM156	FIELD AI PROCESSING (57)	2
TM021	BFPT STAEM, SEAL & DRAIN SYSTEM	2	TM127	FIELD AI PROCESSING (28)	2	TM157	FIELD AI PROCESSING (58)	3
TM022	BFPT LUB OIL SYSTEM	2	TM128	FIELD AI PROCESSING (29)	2	TM158	FIELD AI PROCESSING (59)	3
TM025	BFPT A/B OIL SYSTEM STRT MSTR TIMING CHART	1	TM129	FIELD AI PROCESSING (30)	2	TM159	FIELD AI PROCESSING (60)	3
TM026	BFP START/STOP CONCEPT	0	TM130	FIELD AI PROCESSING (31)	2	TM160	FIELD AI PROCESSING (61)	1
TM027	MBFP START/IN SERV MSTR TIMING CHART	2	TM131	FIELD AI PROCESSING (32)	2	TM161	FIELD AI PROCESSING (62)	1
TM028	1st/2nd TBFP START/IN SERV MSTR TIMING CHART	2	TM132	FIELD AI PROCESSING (33)	2	TM162	FIELD AI PROCESSING (63)	2
TM029	MBFP OUT SERV/STOP MSTR TIMING CHART	2	TM133	FIELD AI PROCESSING (34)	2	TM163	FIELD AI PROCESSING (64)	3
TM030	2nd/1st TBFP OUT SERV/STOP MSTR TIMING CHART	2	TM134	FIELD AI PROCESSING (35)	3	TM164	FIELD AI PROCESSING (65)	2
TM100	FIELD AI PROCESSING (1)	3	TM135	FIELD AI PROCESSING (36)	2	TM165	FIELD AI PROCESSING (66)	3
TM101A	FIELD AI PROCESSING (2a)	1	TM136	FIELD AI PROCESSING (37)	2	TM166	FIELD AI PROCESSING (67)	2
TM101B	FIELD AI PROCESSING (2b)	1	TM137	FIELD AI PROCESSING (38)	2	TM167	FIELD AI PROCESSING (68)	3
TM101C	FIELD AI PROCESSING (2c)	1	TM138	FIELD AI PROCESSING (39)	3	TM168	FIELD AI PROCESSING (69)	3
TM102	FIELD AI PROCESSING (3)	1	TM139	FIELD AI PROCESSING (40)	2	TM168A	FIELD AI PROCESSING (70)	3
TM103	FIELD AI PROCESSING (4)	3	TM140	FIELD AI PROCESSING (41)	2	TM168B	FIELD AI PROCESSING (71)	3
TM104	FIELD AI PROCESSING (5)	2	TM141	FIELD AI PROCESSING (42)	2	TM173	FIELD AI PROCESSING (75)	1
TM105	FIELD AI PROCESSING (6)	2	TM142	FIELD AI PROCESSING (43)	2	TM174	FIELD AI PROCESSING (76)	1
TM106	FIELD AI PROCESSING (7)	2	TM143	FIELD AI PROCESSING (44)	2	TM175	FIELD AI PROCESSING (77)	2
TM107	FIELD AI PROCESSING (8)	2	TM144	FIELD AI PROCESSING (45)	3	TM176	FIELD AI PROCESSING (78)	2
TM108	FIELD AI PROCESSING (9)	2	TM145	FIELD AI PROCESSING (46)	2	TM180	BFP OUTLET WATER PRESS	2
TM109	FIELD AI PROCESSING (10)	2	TM146	FIELD AI PROCESSING (47)	3	TM181	MBFP OTL WTR PRESS	2
TM110	FIELD AI PROCESSING (11)	2	TM147	FIELD AI PROCESSING (48)	2	TM182	TBFP A OTL WTR PRESS	2
TM114	FIELD AI PROCESSING (15)	3	TM148	FIELD AI PROCESSING (49)	2	TM183	TBFP B OTL WTR PRESS	2

Rev.No.	0	1	2	3				PROJECT Van Phong 1 BOT Thermal Power Plant Project 2×673MW			
DATE	2021/3/5	2021/12/15	2022/11/8	2023/7/5							
CONTENTS	1st Issue	Revised	Revised	Revised					TITLE	DRAWING No.	SH
								INDEX (1)	4GCH01007	TM002	3
								Equipment No. : -			

SHEET No.	TITLE	REV.	SHEET No.	TITLE	REV.	SHEET No.	TITLE	REV.
TM184	MBFP INLET WATER FLOW (1)	2	TM270	FIELD DI PROCESSING (71)	2	TM372	SIGNAL TRANSFER (13)	2
TM184B	MBFP INLET WATER FLOW (2)	3	TM271	FIELD DI PROCESSING (72)	2	TM372A	SIGNAL TRANSFER (13A)	3
TM185	T-BFP A INLET WATER FLOW (1)	2	TM272	FIELD DI PROCESSING (73)	2	TM372B	SIGNAL TRANSFER (13B)	2
TM185A	T-BFP A INLET WATER FLOW (2)	3	TM273	FIELD DI PROCESSING (74)	3	TM372C	SIGNAL TRANSFER (13C)	2
TM186	T-BFP B INLET WATER FLOW (1)	2	TM274	FIELD DI PROCESSING (75)	2	TM374	SIGNAL TRANSFER (15)	3
TM186A	T-BFP B INLET WATER FLOW (2)	3	TM275	FIELD DI PROCESSING (76)	2	TM375	SIGNAL TRANSFER (16)	3
TM187	BFPT A LUBE OIL PRESSURE	2	TM276	FIELD DI PROCESSING (77)	2	TM380	SIGNAL TRANSFER (21)	1
TM188	BFPT B LUBE OIL PRESSURE	2	TM277	FIELD DI PROCESSING (78)	2	TM381	SIGNAL TRANSFER (22)	2
TM189	M-BFP LUBE OIL PRESSURE	1	TM280	FIELD DI PROCESSING (81)	3	TM384	SIGNAL TRANSFER (25)	3
TM190	BFPT A OIL CLR OTL LUBE OIL TEMP	3	TM281	FIELD DI PROCESSING (82)	1	TM385	SIGNAL TRANSFER (TSQ A) (26)	1
TM191	BFPT B OIL CLR OTL LUBE OIL TEMP	3	TM282	FIELD DI PROCESSING (83)	3	TM386	SIGNAL TRANSFER (ECS A) (27)	2
TM193	BFPT A OVER SPEED	3	TM283	FIELD DI PROCESSING (84)	3	TM388	SIGNAL TRANSFER(BSQ B) (28)	2
TM194	BFPT B OVER SPEED	3	TM284	FIELD DI PROCESSING (85)	3	TM390	SIGNAL TRANSFER (TSQ A) (91)	1
TM195	M-BFP SPEED	1	TM285	FIELD DI PROCESSING (86)	3	TM395	SIGNAL TRANSFER (ECS B) (1)	3
TM200	FIELD DI PROCESSING (1)	1	TM286	FIELD DI PROCESSING (87)	3	TM400	BFPT A OIL SYS STRT MSTR AUX AUTO	1
TM201	FIELD DI PROCESSING (2)	1	TM287	FIELD DI PROCESSING (88)	3	TM401	BFPT A OIL SYS STRT MSTR STRT INH	1
TM202	FIELD DI PROCESSING (3)	2	TM288	FIELD DI PROCESSING (89)	2	TM402	BFPT A OIL SYS STRT MSTR AUX FAILURE	1
TM203	FIELD DI PROCESSING (4)	3	TM300	BFPT A INPUT SIGNAL TRANSFER (1)	2	TM403	BFPT A OIL SYS STRT MSTR COMPLETE	2
TM204	FIELD DI PROCESSING (5)	2	TM301	BFPT A INPUT SIGNAL TRANSFER (2)	3	TM404	BFPT A OIL SYS STRT MSTR SPARE	1
TM205	FIELD DI PROCESSING (6)	2	TM310	BFPT B INPUT SIGNAL TRANSFER (1)	2	TM405	BFPT A OIL SYS STRT MSTR (SEQ-M1)	1
TM206	FIELD DI PROCESSING (7)	2	TM311	BFPT B INPUT SIGNAL TRANSFER (2)	3	TM406	BFPT A OIL SYS STRT MSTR (SEQ-S1)	1
TM207	FIELD DI PROCESSING (8)	2	TM320	M-BFP INPUT SIGNAL TRANSFER (1)	3	TM407	BFPT A OIL SYS STRT MSTR (SEQ-S2)	1
TM260	FIELD DI PROCESSING (61)	2	TM321	M-BFP INPUT SIGNAL TRANSFER (2)	1	TM408	BFPT A OIL SYS STRT MSTR (SEQ-S3)	1
TM261	FIELD DI PROCESSING (62)	2	TM330	M-BFP INPUT SIGNAL TRANSFER (3)	1	TM410	BFPT B OIL SYS STRT MSTR AUX AUTO	1
TM262	FIELD DI PROCESSING (63)	2	TM331	M-BFP INPUT SIGNAL TRANSFER (4)	1	TM411	BFPT B OIL SYS STRT MSTR STRT INH	1
TM263	FIELD DI PROCESSING (64)	3	TM365	SIGNAL TRANSFER (6)	1	TM412	BFPT B OIL SYS STRT MSTR AUX FAILURE	1
TM264	FIELD DI PROCESSING (65)	2	TM366	SIGNAL TRANSFER (7)	2	TM413	BFPT B OIL SYS STRT MSTR COMPLETE	2
TM265	FIELD DI PROCESSING (66)	2	TM369	SIGNAL TRANSFER (10)	2	TM414	BFPT B OIL SYS STRT MSTR SPARE	1
TM266	FIELD DI PROCESSING (67)	2	TM370	SIGNAL TRANSFER (11)	3	TM415	BFPT B OIL SYS STRT MSTR (SEQ-M1)	1
TM267	FIELD DI PROCESSING (68)	2	TM371	SIGNAL TRANSFER (12)	1	TM416	BFPT B OIL SYS STRT MSTR (SEQ-S1)	1

Rev.No.	0	1	2	3				PROJECT Van Phong 1 BOT Thermal Power Plant Project 2×673MW				
DATE	2021/3/5	2021/12/15	2022/11/8	2023/7/5								
CONTENTS	1st Issue	Revised	Revised	Revised					TITLE	DRAWING No.	SH	REV. MARK
								INDEX (2)	4GCH01007	TM003	3	
Equipment No. : -												

SHEET No.	TITLE	REV.	SHEET No.	TITLE	REV.	SHEET No.	TITLE	REV.
TM417	BFPT B OIL SYS STRT MSTR (SEQ-S2)	1	TM455	2ND TBFP SERV IN MA (SEQ-M)	2	TM481C	TBFP SERV OUT MA AUX FAIL (3)	1
TM418	BFPT B OIL SYS STRT MSTR (SEQ-S3)	1	TM455B	2ND TBFP SERV IN MA (SEQ-S1)	3	TM481D	TBFP SERV OUT MA AUX FAIL (4)	2
TM420	BFP STRT UP SEL PLANT SET UP	3	TM455C	2ND TBFP SERV IN MA (SEQ-S2)	3	TM483A	TBFP SERV OUT MA (T+T->T) (SEQ-M)	2
TM421	TBFP STUP ORDER SEL	3	TM455D	2ND TBFP SERV IN MA (SEQ-S3)	3	TM483B	TBFP SERV OUT MA (T+T->T) (SEQ-S1)	1
TM422	STRT AVAILABLE BFP INDICATION (1)	3	TM455E	2ND TBFP SERV IN MA (SEQ-S4)	1	TM483C	TBFP SERV OUT MA (T+T->T) (SEQ-S2)	1
TM423	STRT AVAILABLE BFP INDICATION (2)	1	TM455F	2ND TBFP SERV IN MA (SEQ-S5)	3	TM483D	TBFP SERV OUT MA (T+T->T) (SEQ-S3)	1
TM435	MBFP SERV IN MA AUX AUTO	1	TM455G	2ND TBFP SERV IN MA (SEQ-S6)	1	TM485A	TBFP SERV OUT MA (T+M->M) (SEQ-M)	2
TM436	MBFP SERV IN MA STRT INHIBIT	3	TM461A	BFPT RESET CMD	1	TM485B	TBFP SERV OUT MA (T+M->M) (SEQ-S1)	2
TM437	MBFP SERV IN MA AUX FAIL	1	TM461B	BFPT STRT CMD	2	TM485C	TBFP SERV OUT MA (T+M->M) (SEQ-S2)	1
TM438	MBFP SERV IN MA COMPLETE	2	TM461C	TBFP SERV IN CMD	1	TM485D	TBFP SERV OUT MA (T+M->M) (SEQ-S3)	1
TM441A	MBFP SERV IN MA (SEQ-M)	3	TM465	TBFP PRIORITY SET FOR SERV OUT	2	TM491	TBFP SERV OUT CMD	1
TM441B	MBFP SERV IN MA (SEQ-S1)	1	TM465A	PLANT SD MD SEL	2	TM495	BFPT TRIP CMD	1
TM441C	MBFP SERV IN MA (SEQ-S2)	1	TM465B	PLANT SD MD SEL	3	TM500	BFPT A TRIP (1)	1
TM441D	MBFP SERV IN MA (SEQ-S3)	1	TM466A	SD AVAILABLE BFP INDICATION (1)	1	TM501	BFPT A TRIP (2)	2
TM445	TBFP SERV IN MA AUX AUTO (1)	2	TM466B	SD AVAILABLE BFP INDICATION (2)	1	TM502	BFPT A MSV	2
TM446	TBFP SERV IN MA AUX AUTO (2)	2	TM470	MBFP SERV OUT MA AUX AUTO	1	TM503	BFPT A TRIP (3)	2
TM447	TBFP SERV IN MA STRT INHIBIT (1)	3	TM471	MBFP SERV OUT MA STRT INHIBIT	1	TM504	BFPT A TRIP (4)	2
TM448	TBFP SERV IN MA STRT INHIBIT (2)	3	TM472	MBFP SERV OUT MA AUX FAIL	1	TM506	BFPT A TRIP (6)	2
TM449	TBFP SERV IN MA STRT INHIBIT (3)	2	TM473	MBFP SERV OUT MA COMPLETE	2	TM507	BFPT A TRIP (7)	3
TM450	TBFP SERV IN MA AUX FAIL (1)	2	TM474A	MBFP SERV OUT MA (SEQ-M)	2	TM508	BFPT A TRIP (8)	3
TM451	TBFP SERV IN MA AUX FAIL (2)	2	TM474B	MBFP SERV OUT MA (SEQ-S1)	3	TM509	BFPT A TRIP (9)	2
TM452	TBFP SERV IN MA MA COMPLETE	2	TM474C	MBFP SERV OUT MA (SEQ-S2)	2	TM510	BFPT A MAIN STOP VALVE TEST (1)	3
TM453	1ST TBFP SERV IN MA (SEQ-M)	2	TM477A	TBFP SERV OUT MA AUX AUTO (1)	2	TM511	BFPT A MAIN STOP VALVE TEST (2)	2
TM453A	1ST TBFP SERV IN MA (SEQ-S1)	3	TM477B	TBFP SERV OUT MA AUX AUTO (2)	2	TM512	BFPT A BRG VIB TRIP (TSI) (1)	2
TM453B	1ST TBFP SERV IN MA (SEQ-S2)	3	TM477C	TBFP SERV OUT MA AUX AUTO (3)	1	TM513	BFPT A BRG VIB TRIP (TSI) (2)	3
TM453C	1ST TBFP SERV IN MA (SEQ-S3)	3	TM477D	TBFP SERV OUT MA AUX AUTO (4)	2	TM515	BFPT A INTERLOCK SIGNAL	2
TM453D	1ST TBFP SERV IN MA (SEQ-S4)	3	TM479	TBFP SERV OUT MA STRT INHIBIT	2	TM519	BFPT A TURNING GEAR (1)	3
TM453E	1ST TBFP SERV IN MA (SEQ-S5)	1	TM480	TBFP SERV OUT MA MA COMPLETE	2	TM520	BFPT A TURNING GEAR (2)	3
TM453F	1ST TBFP SERV IN MA (SEQ-S6)	3	TM481A	TBFP SERV OUT MA AUX FAIL (1)	1	TM521	BFPT A TURNING GEAR (3)	3
TM453G	1ST TBFP SERV IN MA (SEQ-S7)	1	TM481B	TBFP SERV OUT MA AUX FAIL (2)	1	TM530	BFPT A MAIN OIL PUMP SELECTOR	2

Rev.No.	0	1	2	3				PROJECT Van Phong 1 BOT Thermal Power Plant Project 2×673MW				
DATE	2021/3/5	2021/12/15	2022/11/8	2023/7/5								
CONTENTS	1st Issue	Revised	Revised	Revised					TITLE	DRAWING No.	SH	REV. MARK
								INDEX (3)	4GCH01007	TM004	3	
Equipment No. : -												


SHEET No.	TITLE	REV.	SHEET No.	TITLE	REV.	SHEET No.	TITLE	REV.
TM532	BFPT A MAIN OIL PUMP BACK UP STRT	2	TM660	BFPT B MAIN STOP VALVE TEST (1)	3	TM800	BFPT OIL TRANSF PP	2
TM533	BFPT A MAIN OIL PUMP LDG MSTR	2	TM661	BFPT B MAIN STOP VALVE TEST (2)	2	TM814	BFPT AUXS PCV I/L VLV (1)	1
TM535	BFPT A MAIN OIL PUMP A	2	TM662	BFPT B BRG VIB TRIP (TSI) (1)	2	TM815	BFPT AUXS PCV I/L VLV (2)	1
TM540	BFPT A MAIN OIL PUMP B	2	TM663	BFPT B BRG VIB TRIP (TSI) (2)	3	TM824	T-BFP A OTL VLV (1)	1
TM545	BFPT A EOP	3	TM665	BFPT B INTERLOCK SIGNAL	2	TM825	T-BFP A OTL VLV (2)	2
TM546	BFPT A EMARGENCY OIL PUMP (2)	2	TM669	BFPT B TURNING GEAR (1)	3	TM830	T-BFP A CONDITION (1)	3
TM549	BFPT A OIL TNK VAP EXTRCTR (1)	1	TM670	BFPT B TURNING GEAR (2)	3	TM831	T-BFP A CONDITION (2)	3
TM550	BFPT A OIL TNK VAP EXTRCTR (2)	2	TM671	BFPT B TURNING GEAR (3)	3	TM834	T-BFP B OTL VLV (1)	1
TM560	BFPT A OIL CONDTR FLTRP	2	TM680	BFPT B MAIN OIL PUMP SELECTOR	2	TM835	T-BFP B OTL VLV (2)	2
TM570	BFPT A MSV I/L VLV	2	TM682	BFPT B MAIN OIL PUMP BACK UP STRT	2	TM840	T-BFP B CONDITION (1)	3
TM579	BFPT A MSV B/S DV (1)	0	TM683	BFPT B MAIN OIL PUMP LDG MSTR	2	TM841	T-BFP B CONDITION (2)	3
TM580	BFPT A MSV B/S DV (2)	2	TM685	BFPT B MAIN OIL PUMP A	2	TM849	T-BFP HDR ISOL VLV (1)	1
TM584	BFPT A MSV A/S DV (1)	0	TM690	BFPT B MAIN OIL PUMP B	2	TM850	T-BFP HDR ISOL VLV (2)	2
TM585	BFPT A MSV A/S DV (2)	2	TM695	BFPT B EOP	3	TM851	T-BFP A NOISE ECLSR FAN	2
TM589	BFPT A CSG DV (1)	1	TM696	BFPT B EMARGENCY OIL PUMP (2)	2	TM854	T-BFP A NOISE ECLSR FAN (1)	2
TM590	BFPT A CSG DV (2)	3	TM699	BFPT B OIL TNK VAP EXTRCTR (1)	1	TM855	T-BFP A NOISE ECLSR FAN (2)	2
TM594	BFPT A EXHD DV (1)	0	TM700	BFPT B OIL TNK VAP EXTRCTR (2)	2	TM861	T-BFP B NOISE ECLSR FAN	2
TM595	BFPT A EXHD DV (2)	3	TM710	BFPT B OIL CONDTR FLTRP	2	TM864	T-BFP B NOISE ECLSR FAN (1)	1
TM599	BFPT A SSH DV (1)	0	TM720	BFPT B MSV I/L VLV	2	TM865	T-BFP B NOISE ECLSR FAN (2)	2
TM600	BFPT A SSH DV (2)	2	TM729	BFPT B MSV B/S DV (1)	0	TM919	MBFP (1)	2
TM605	BFPT A EXH VLV	2	TM730	BFPT B MSV B/S DV (2)	2	TM920	MBFP (2)	3
TM650	BFPT B TRIP (1)	1	TM734	BFPT B MSV A/S DV (1)	0	TM921	MBFP (3)	2
TM651	BFPT B TRIP (2)	2	TM735	BFPT B MSV A/S DV (2)	2	TM925	MBFP (4)	3
TM652	BFPT B MSV	2	TM739	BFPT B CSG DV (1)	1	TM929	MBFP AUXOP (1)	2
TM653	BFPT B TRIP (3)	2	TM740	BFPT B CSG DV (2)	3	TM930	MBFP AUXOP (2)	2
TM654	BFPT B TRIP (4)	2	TM744	BFPT B EXHD DV (1)	0	TM944	MBFP OTL VLV (1)	1
TM656	BFPT B TRIP (6)	2	TM745	BFPT B EXHD DV (2)	3	TM945	MBFP OTL VLV (2)	2
TM657	BFPT B TRIP (7)	3	TM749	BFPT B SSH DV (1)	0	TM950	MBFP CONDITION (1)	2
TM658	BFPT B TRIP (8)	2	TM750	BFPT B SSH DV (2)	2	TM951	MBFP CONDITION (2)	3
TM659	BFPT B TRIP (9)	2	TM755	BFPT B EXH VLV	2	TM961	MBFP NOISE ECLSR FAN	3

Rev.No.	0	1	2	3				PROJECT Van Phong 1 BOT Thermal Power Plant Project 2×673MW				
DATE	2021/3/5	2021/12/15	2022/11/8	2023/7/5								
CONTENTS	1st Issue	Revised	Revised	Revised					TITLE	DRAWING No.	SH	REV. MARK
								INDEX (4)	4GCH01007	TM005	3	
Equipment No. : -												


[illegible]

Rev.No.	0	1	2					PROJECT			
DATE	2021/3/5	2021/12/15	2022/11/8					Van Phong 1 BOT Thermal Power Plant Project 2×673MW			
CONTENTS	1st Issue	Revised	Revised					TITLE	DRAWING No.	SH	REV. MARK
								INDEX (5)	4GCH01007	TM006	2
								Equipment No. : -			

	A	B	C	D	E	F	G	H	I	J	K	L	M	N	O	P	Q	R	S	T	U	V	W	X	Y	Z	AA		
1																												1	
2	CATEGORY		TITLE										Logic sheet Symbol		DRAWING NUMBER														
CUSTOMER															TOSHIBA							2							
	STANDARD		STANDARD LOGIC DIAGRAMS FOR DCS CONTROLS										AA		VP1-C-L2-I-CB-00001					4GCH00999									
3	TURBINE	UNIT	LOGIC DIAGRAMS FOR STEAM TURBINE ALARM SYSTEM										TY		VP1-C-L2-I-CE-00002					4GCH01004							3		
			LOGIC DIAGRAMS FOR STEAM TURBINE SYSTEM										TB		VP1-C-L2-I-CB-00005					4GCH01002									
			LOGIC DIAGRAMS FOR STEAM TURBINE DRAIN SYSTEM										TC		VP1-C-L2-I-CB-00004					4GCH01005							4		
4			LOGIC DIAGRAMS FOR GLAND AND AIR EJECTION SYSTEM										TD		VP1-C-L2-I-CB-00002					4GCH01001									
			LOGIC DIAGRAMS FOR EXTRACTION SYSTEM										TE		VP1-C-L2-I-CB-00009					4GCH01009							5		
			LOGIC DIAGRAMS FOR CONDENSATE WATER AND FEEDWATER SYSTEM										TF		VP1-C-L2-I-CB-00007					4GCH01006									
5			LOGIC DIAGRAMS FOR BOILER FEEDWATER PUMP										TM		VP1-C-L2-I-CB-00006					4GCH01007							6		
			LOGIC DIAGRAMS FOR MAIN COOLING WATER SYSTEM										TJ		VP1-C-L2-I-CB-00003					4GCH01003									
			LOGIC DIAGRAMS FOR CLOSED CYCLE COOLING WATER SYSTEM										TK		VP1-C-L2-I-CB-00030					4GCH01013							7		
6			LOGIC DIAGRAMS FOR TURBINE MODULATING CONTROL										TM		VP1-C-L2-I-CB-00031					4GIH00083									
																											8		
7																													
8																													
9																												9	
10																												10	
11																												11	
12																												12	
13																												13	
14																												14	
15																												15	
	Rev. No.	1								PROJECT																			
	DATE	2021/12/15								Van Phong 1 BOT Thermal Power Plant Project 2×673MW																			
	CONTENTS	Added								TITLE					DRAWING No.					SH		REV. MARK							
										REF DWG NO. LIST (1)					4GCH01007					TM015		1							
	Equipment No. :										-																		

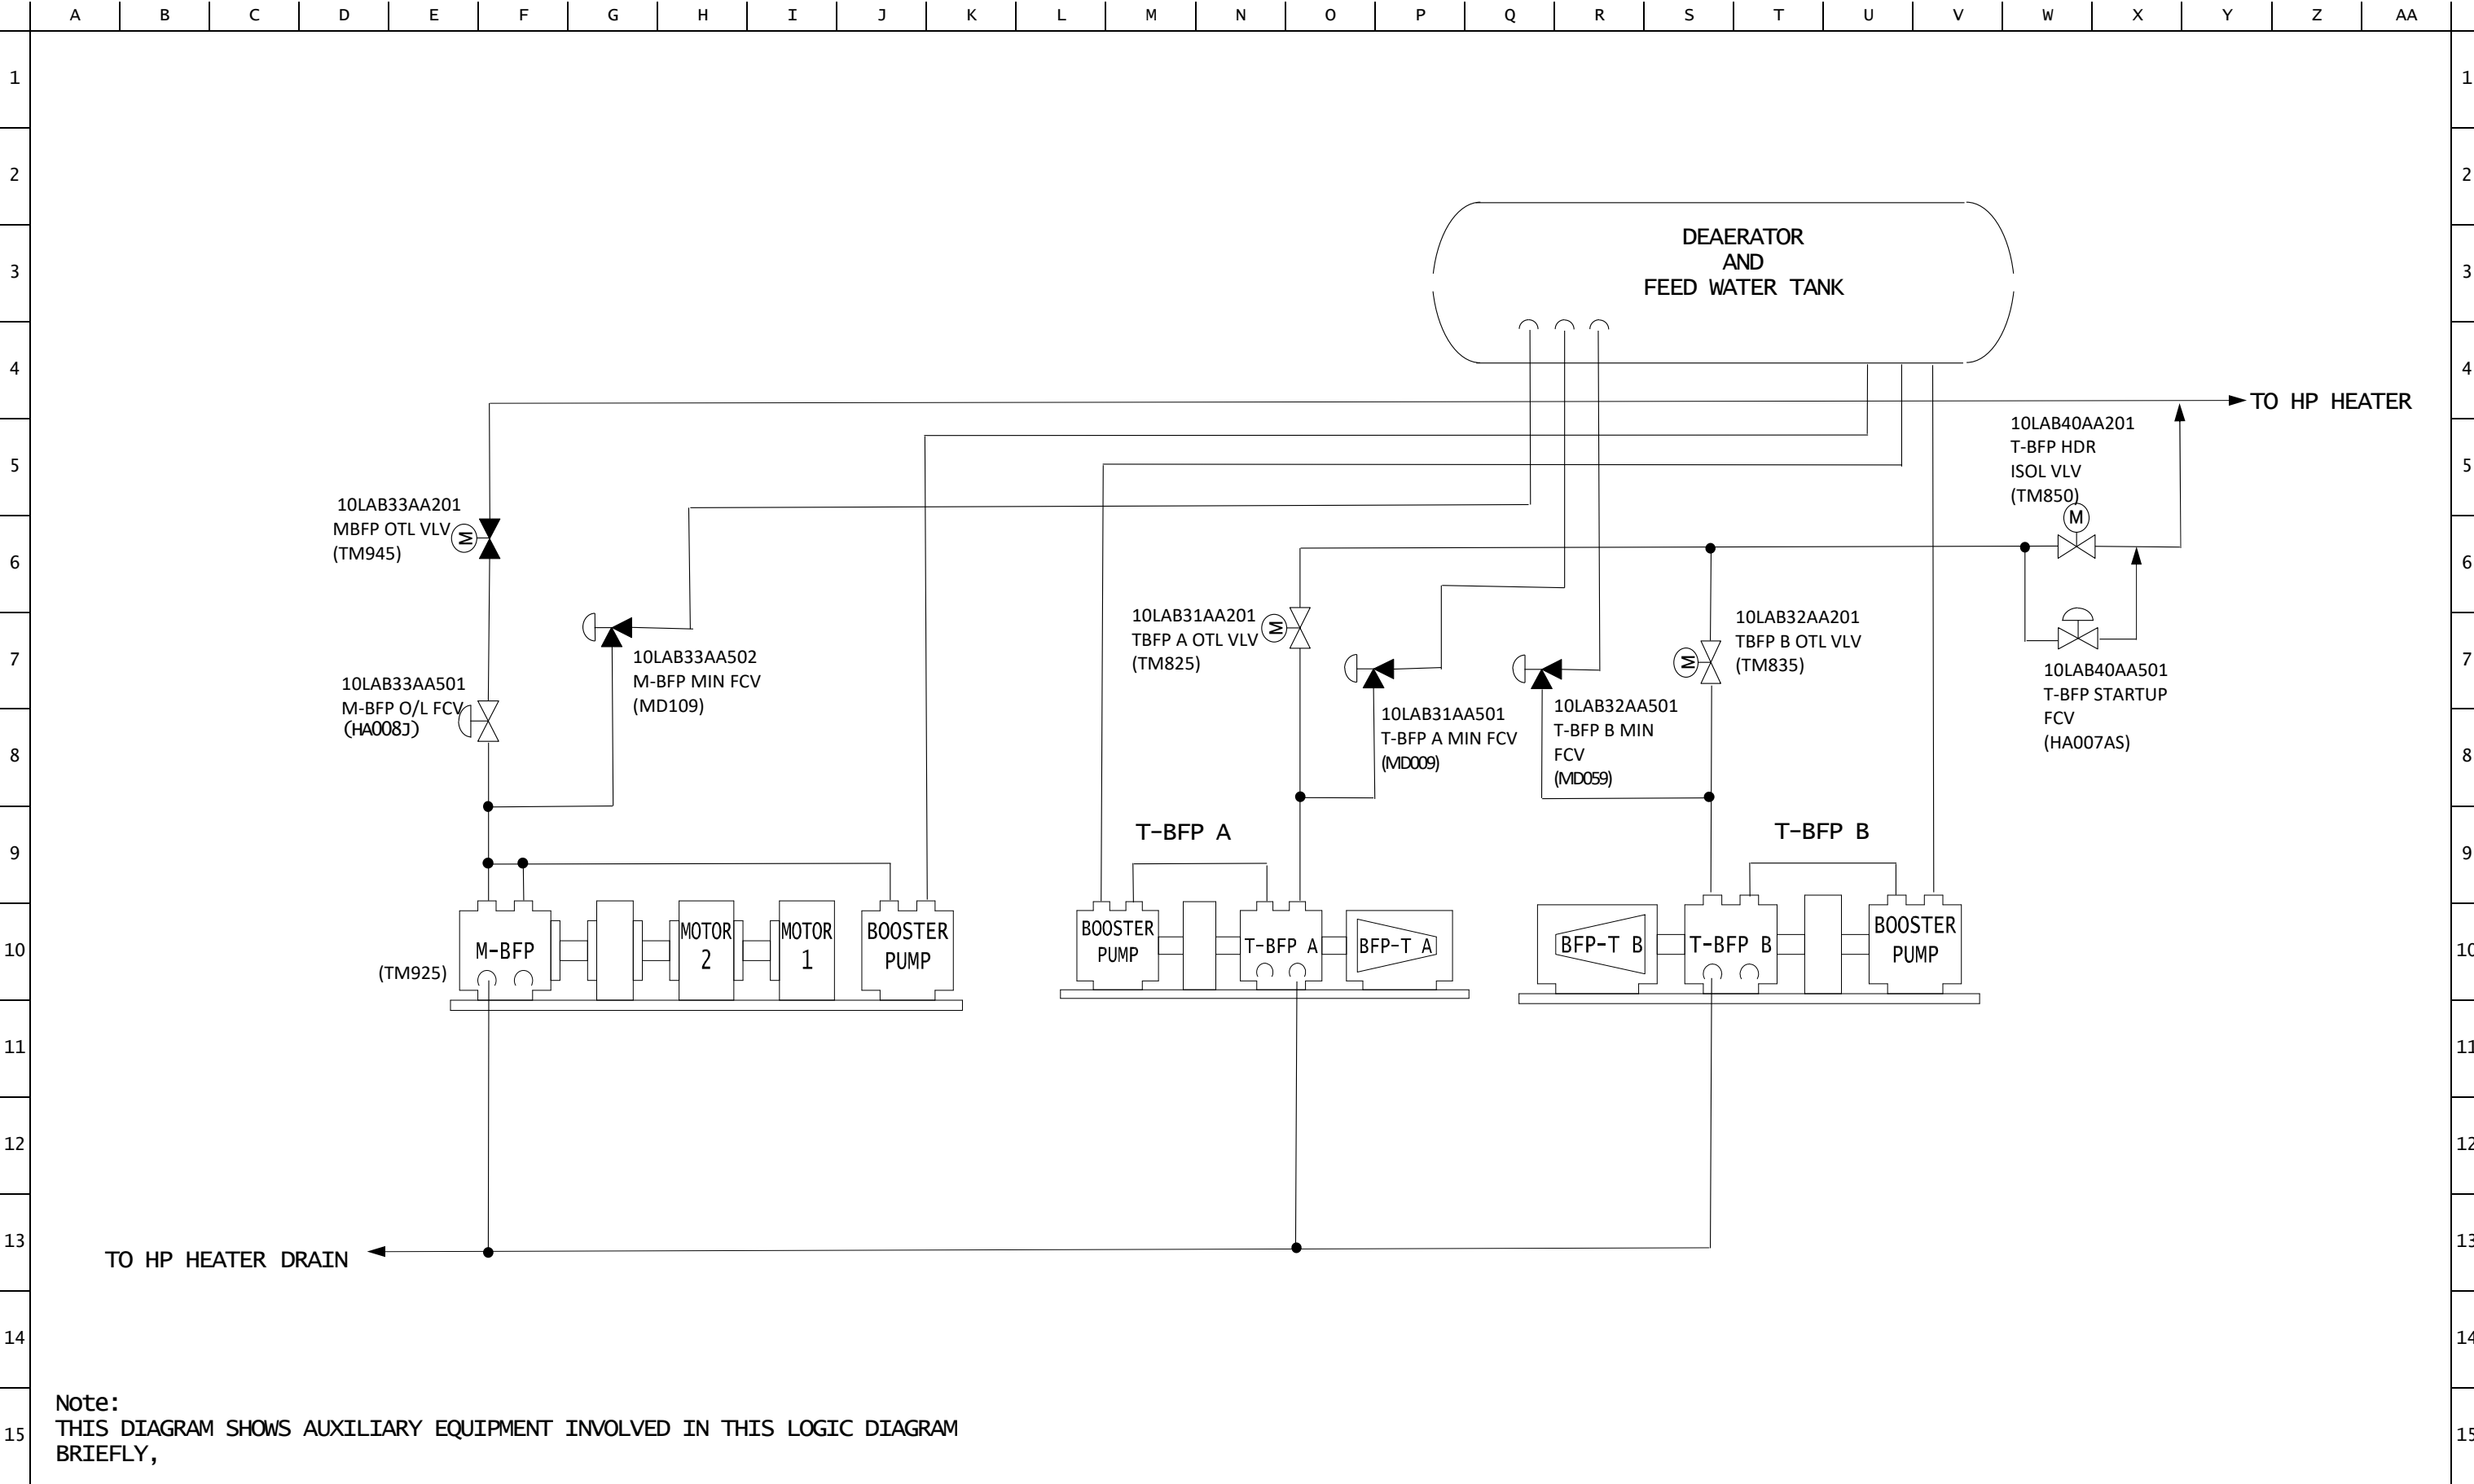


Rev.No.	0	1	2					PROJECT	Van Phong 1 BOT Thermal Power Plant Project 2x673MW			
DATE	2021/6/21	2021/12/15	2022/11/8					TITLE				
CONTENTS	1st Issue	Revised	Revised (0062)					BOILER FEEDWATER PUMP				
								Equipment No. : -	DRAWING No. 4GCH01007		SH TM020	REV. MARK 2

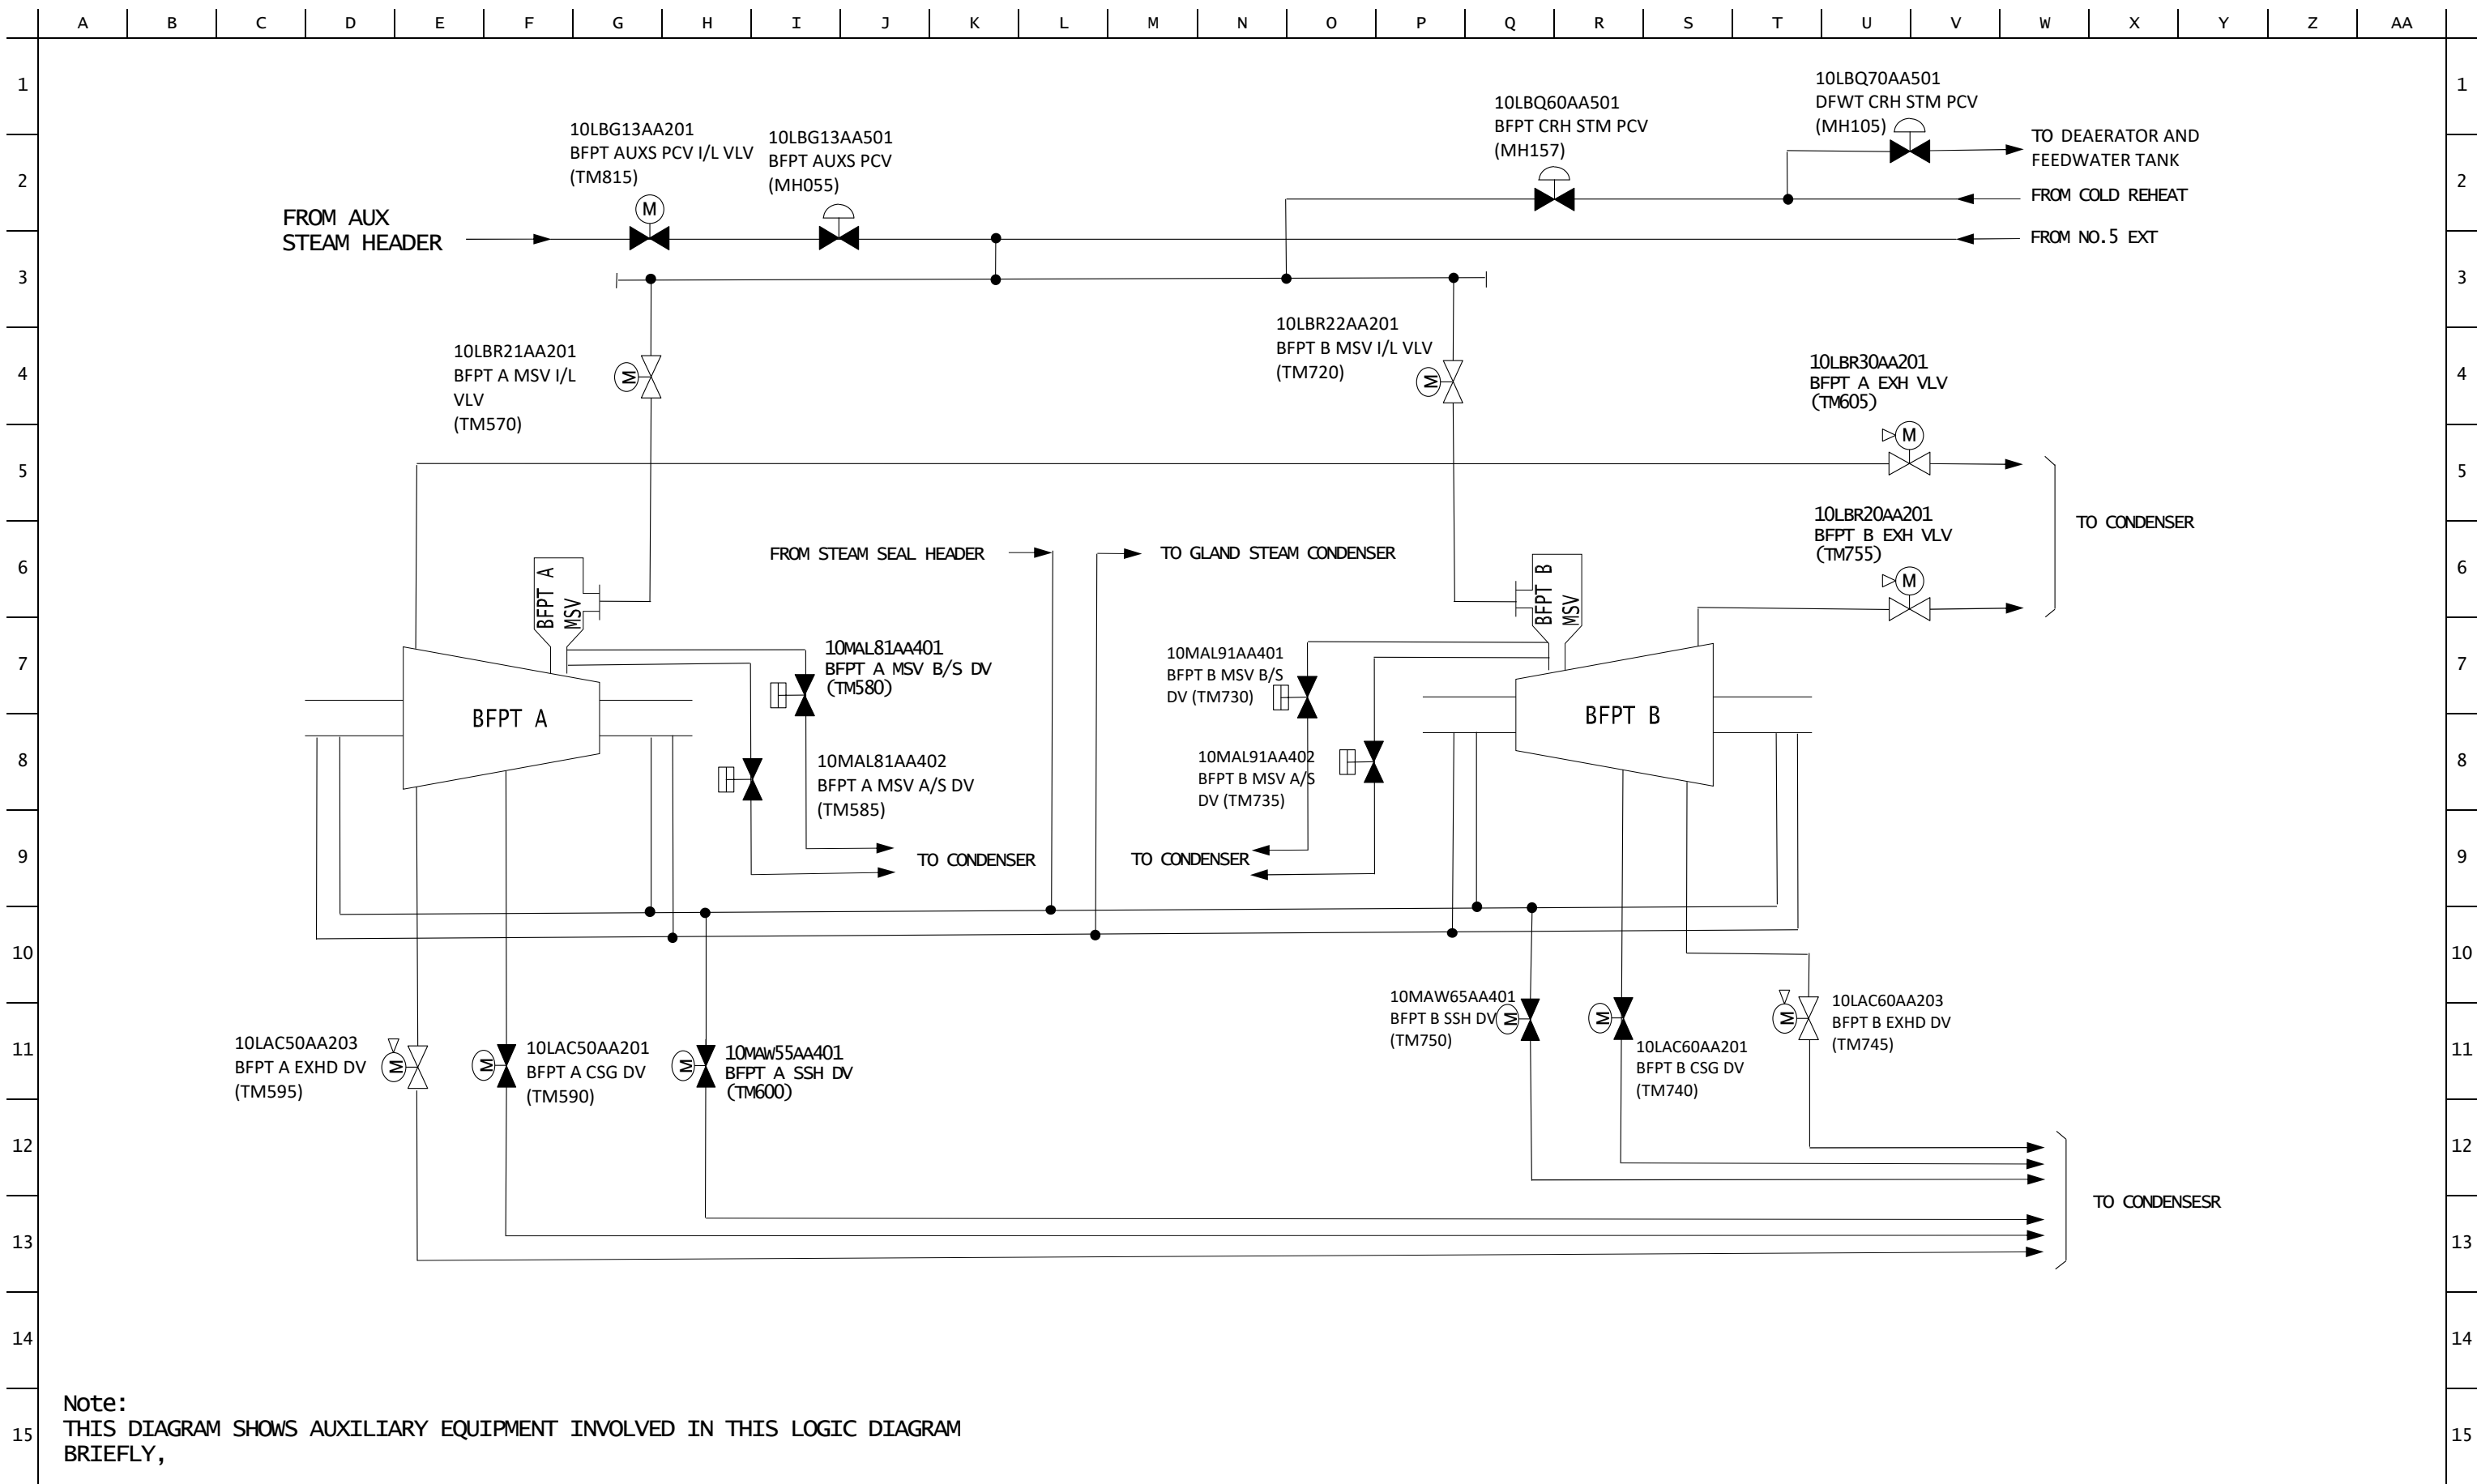


Note:
THIS DIAGRAM SHOWS AUXILIARY EQUIPMENT INVOLVED IN THIS LOGIC DIAGRAM BRIEFLY,

Rev.No.	0	2						PROJECT	DRAWING No. 4GCH01007			
DATE	2021/6/21	2022/11/8						Van Phong 1 BOT Thermal Power Plant Project 2x673MW				
CONTENTS	1st Issue	Revised (0062)						BFPT STAEM, SEAL & DRAIN SYSTEM				
								Equipment No. : -				
									SH TM021	REV. MARK 2		

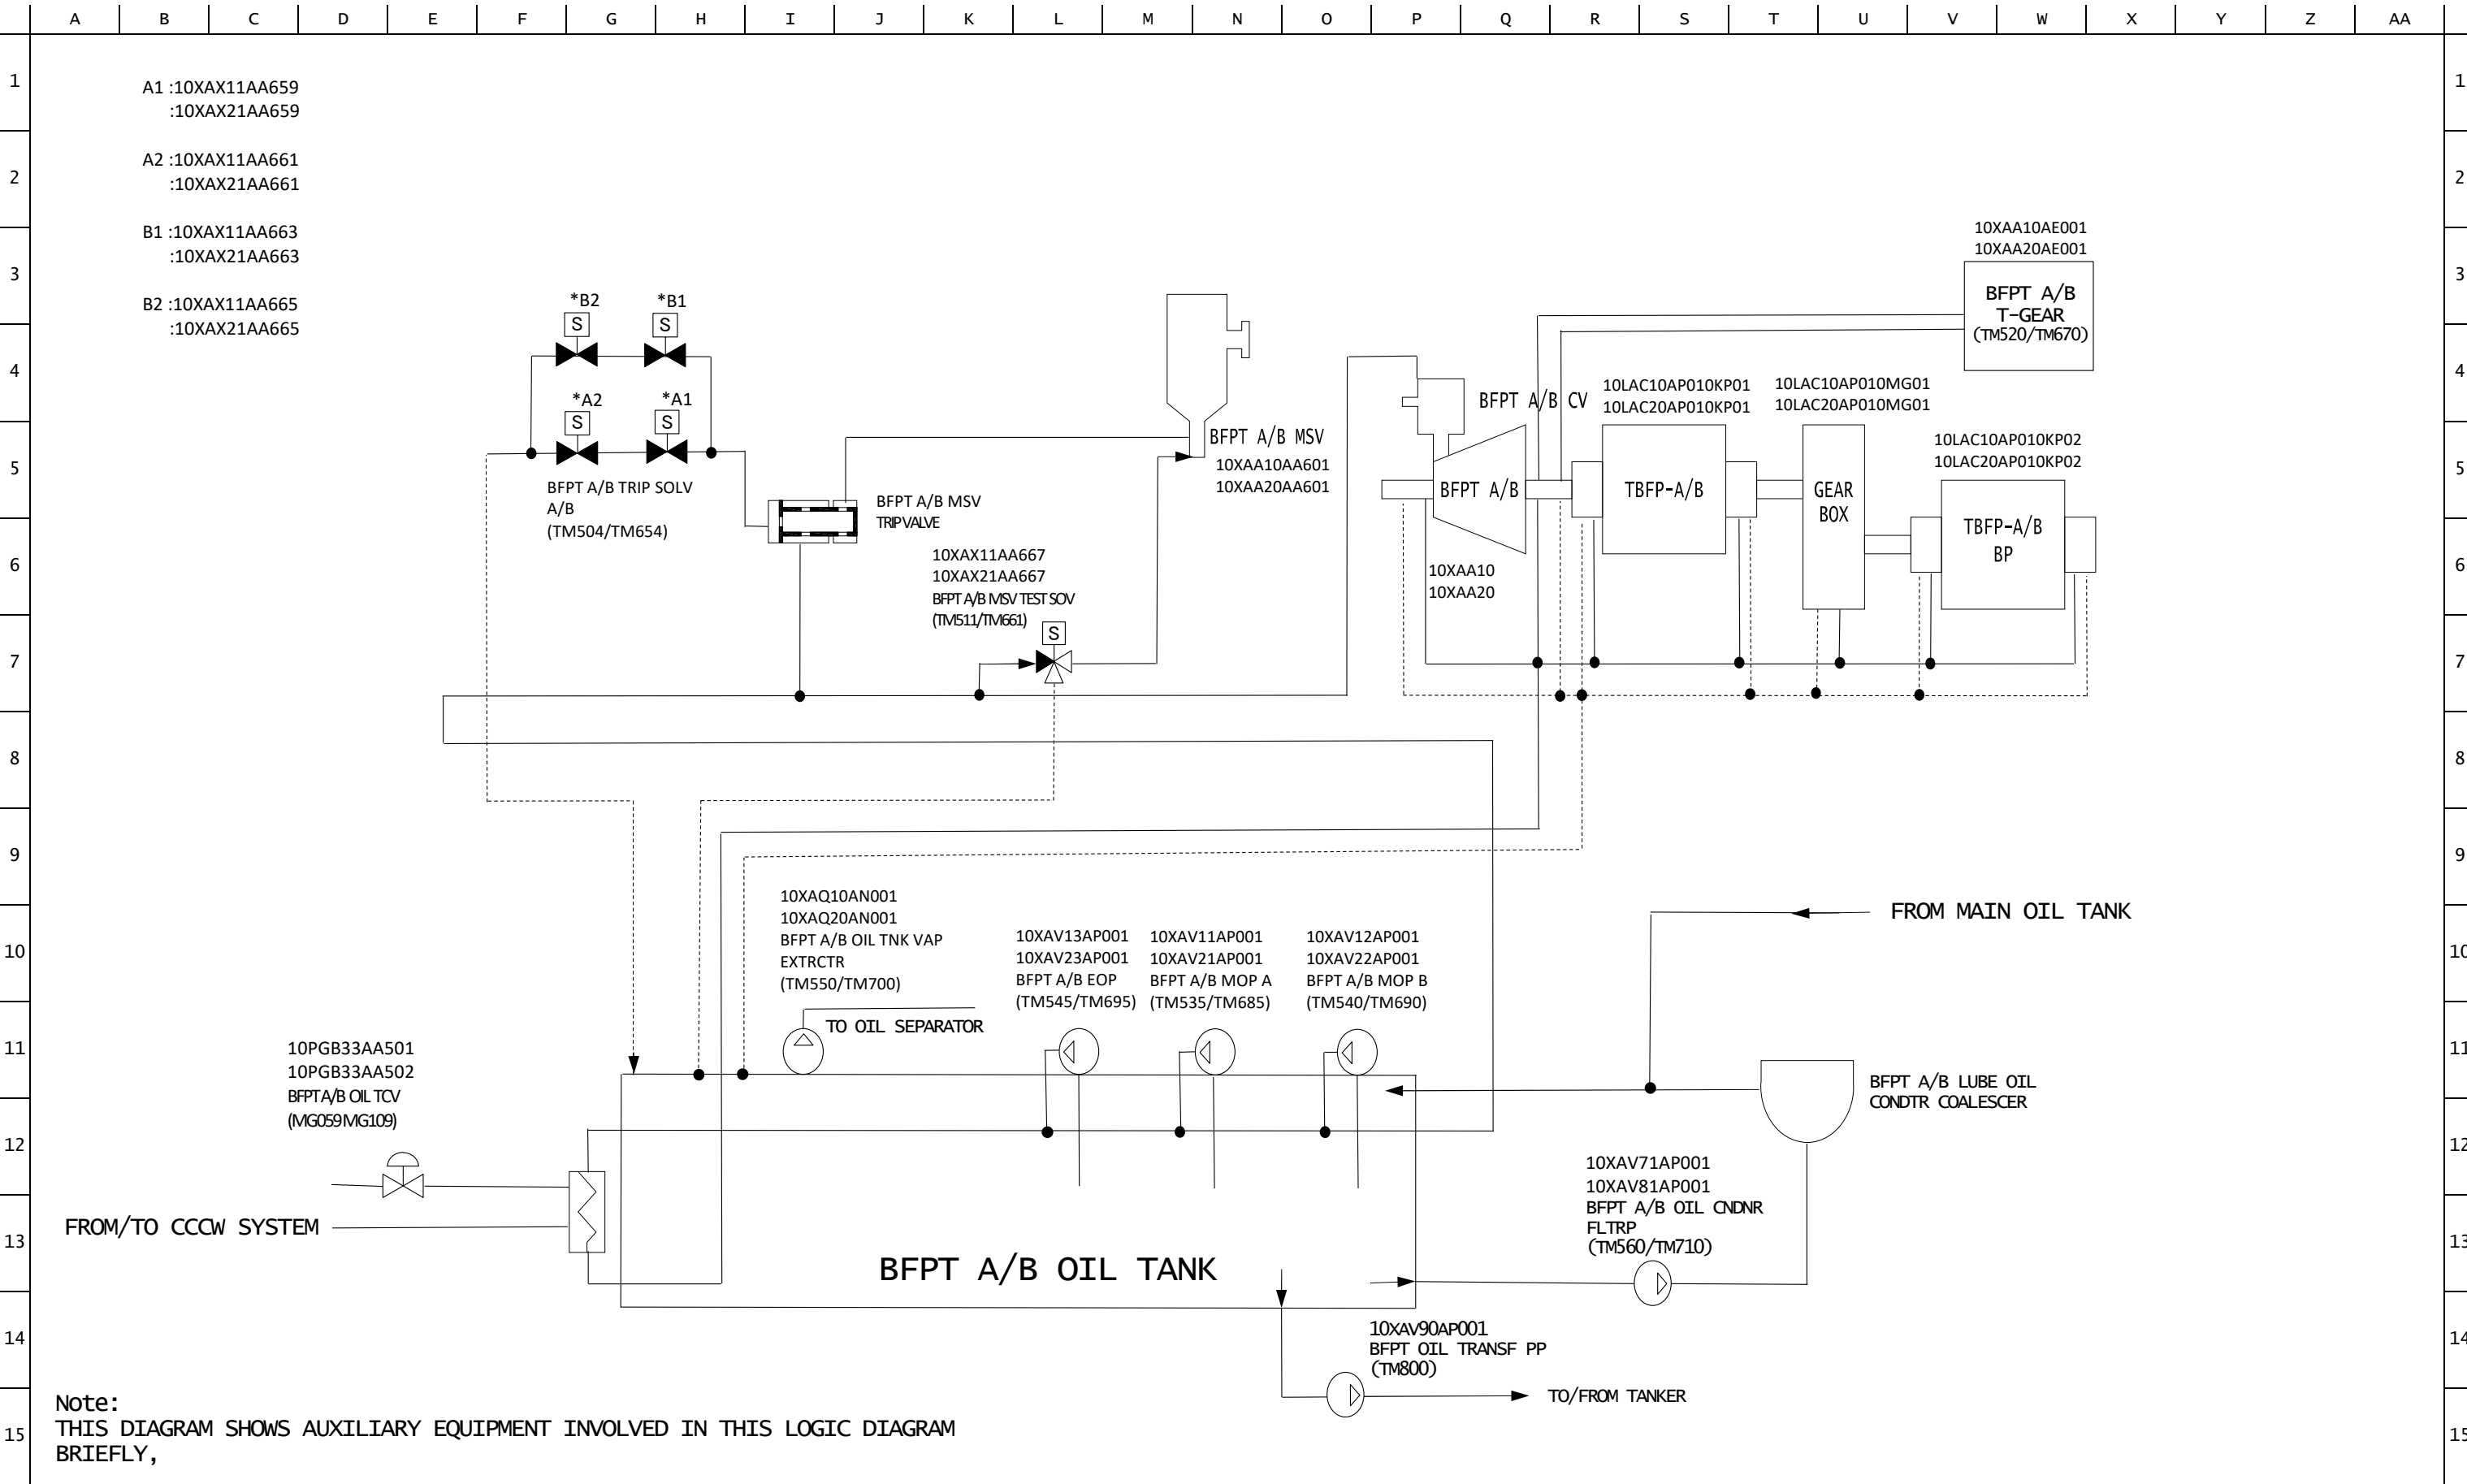

Rev.No.	0	1	2					PROJECT				
DATE	2021/6/21	2021/12/15	2022/11/8					Van Phong 1 BOT Thermal Power Plant Project 2x673MW				
CONTENTS	1st Issue	Revised	Revised (0062)					TITLE BFPT LUB OIL SYSTEM	DRAWING No. 4GCH01007	SH TM022	REV. MARK 2	
								Equipment No. : -				

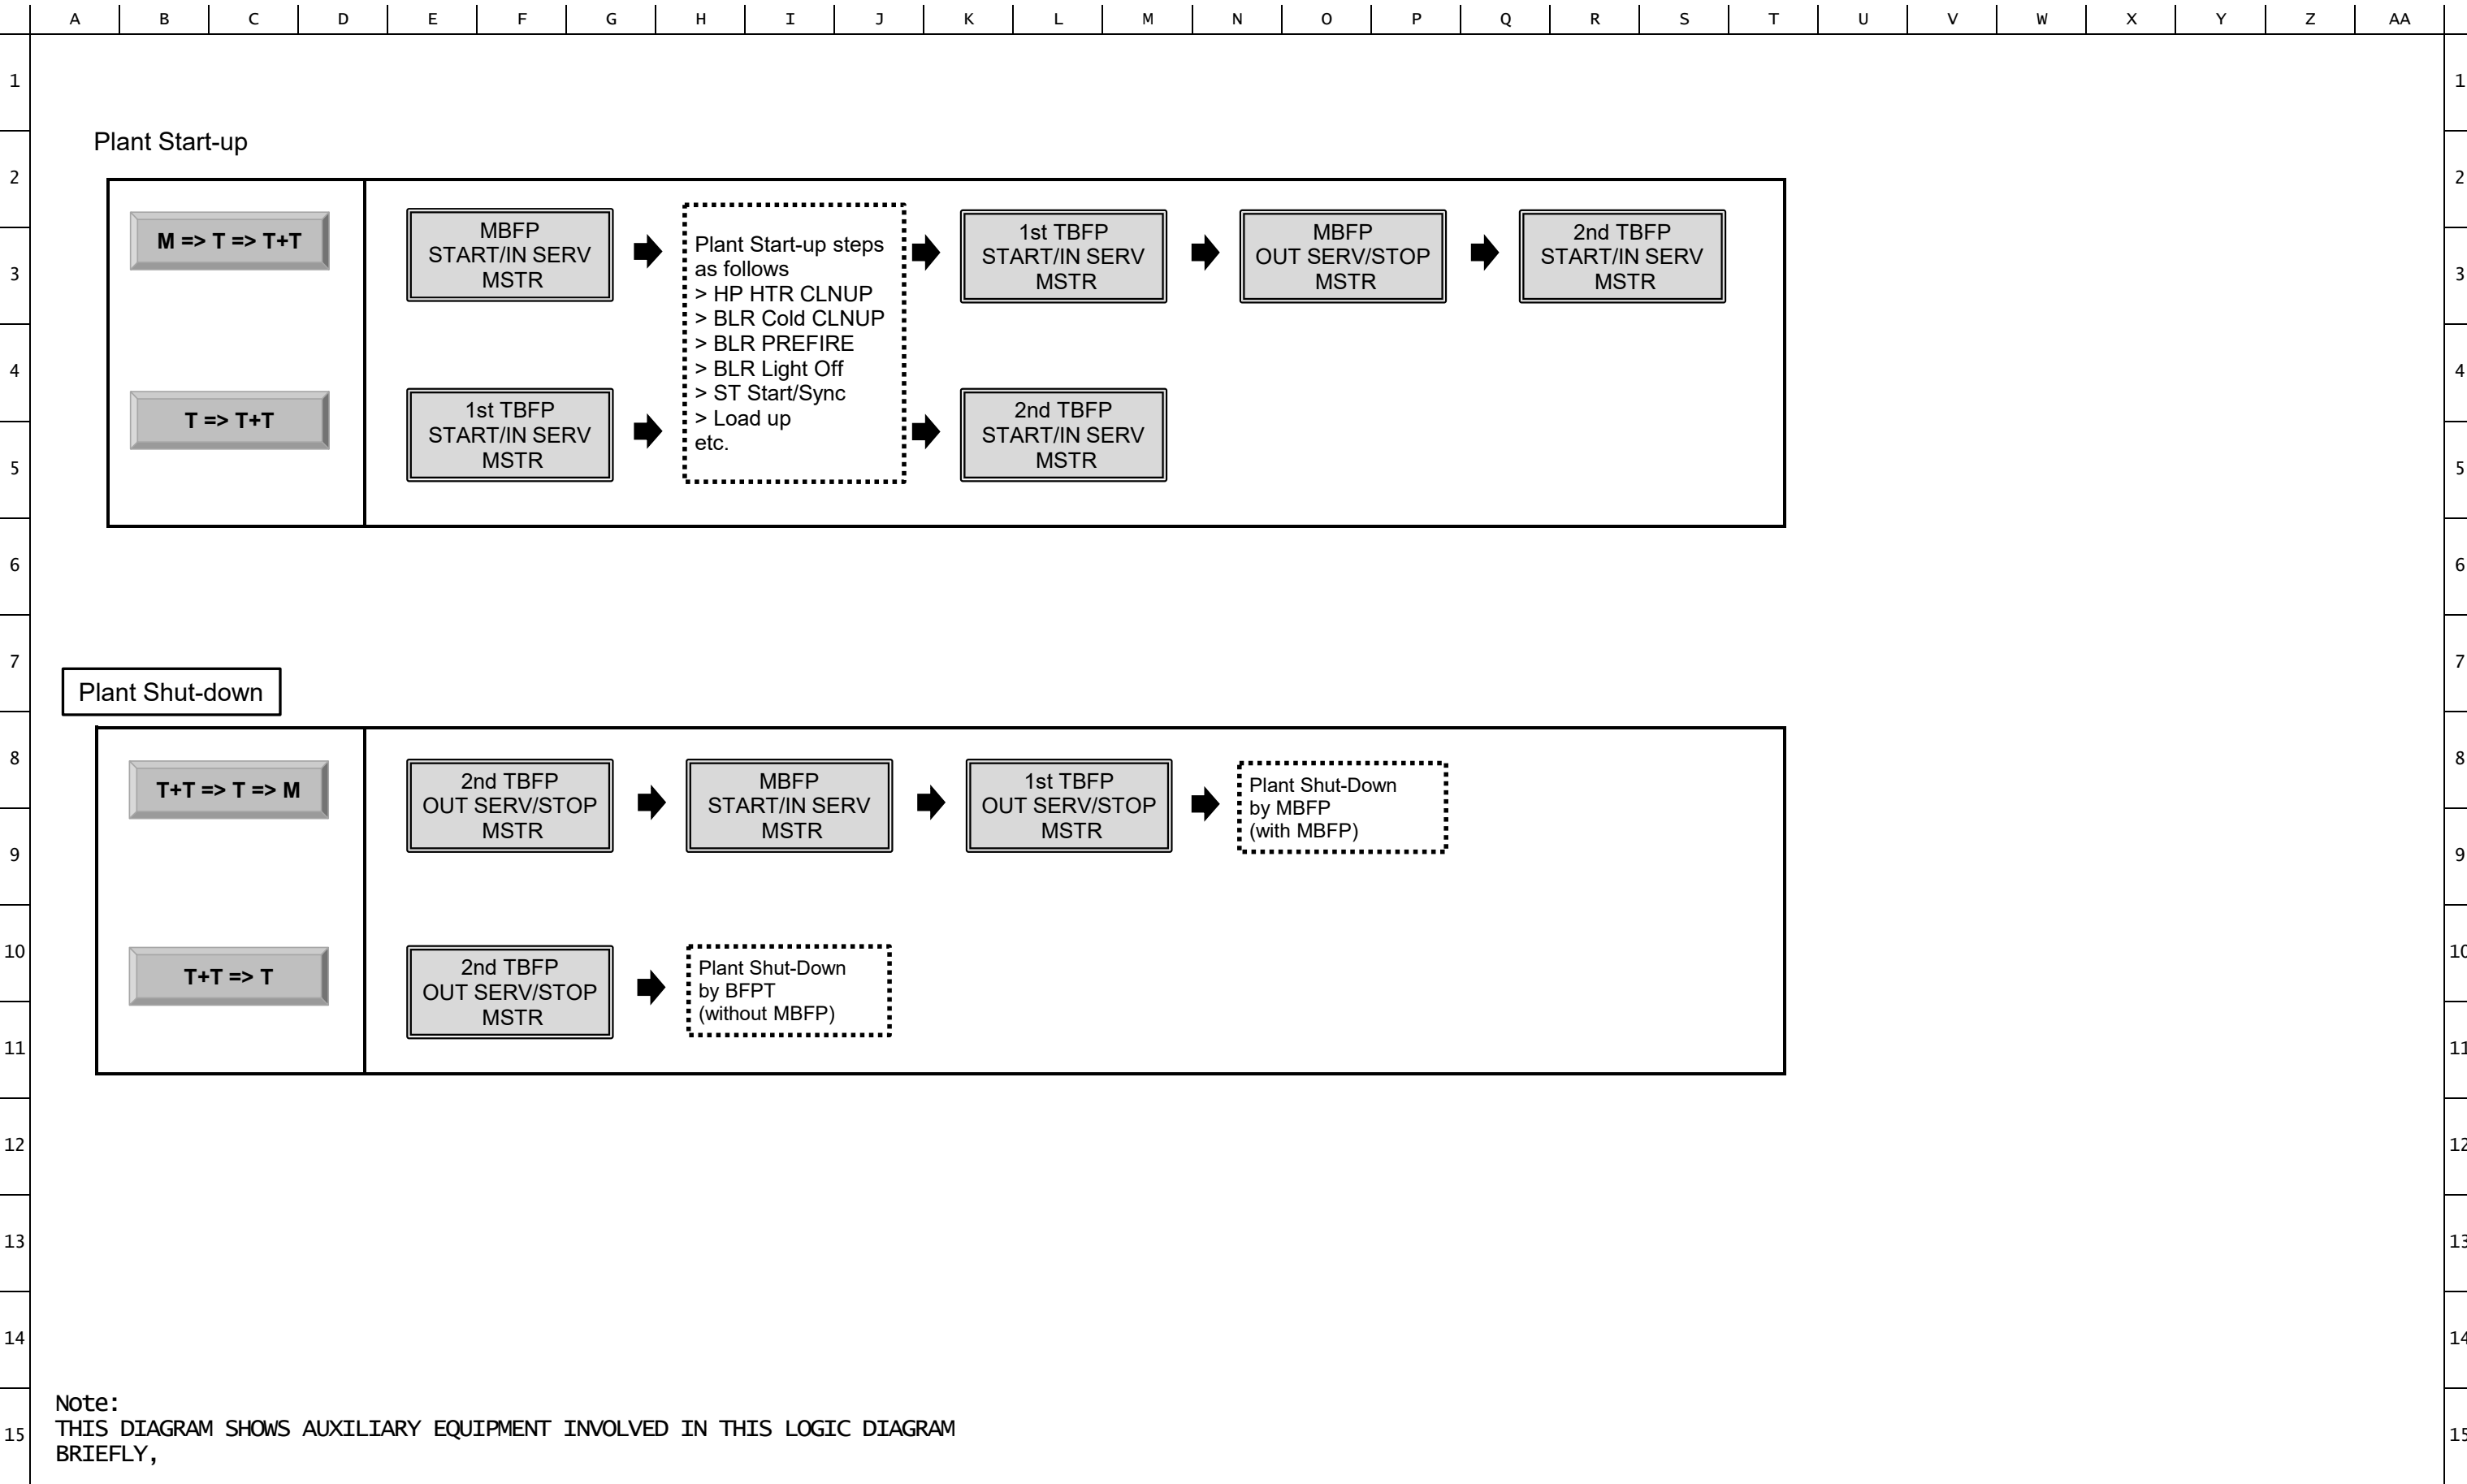

Rev.No.	0							PROJECT				
DATE	2021/6/21							Van Phong 1 BOT Thermal Power Plant Project 2x673MW				
CONTENTS	1st Issue							TITLE	DRAWING No.	SH	REV. MARK	
								BFP START/STOP CONCEPT	4GCH01007	TM026	0	
								Equipment No. : -				


	A	B	C	D	E	F	G	H	I	J	K	L	M	N	O	P	Q	R	S	T	U	V	W	X	Y	Z	AA			
1											MBFP START/IN SERV MSTR (TM435-TM441D)																		1	
2	TAG No.		LOGIC SHEET No.		EQUIPMENT NAME			STATUS																				2		
3	_0LAC30AP010		TM925		MBFP			RUN		S1 S2 S3 COMP																		3		
	_0LAB33AA201		TM945		MBFP OTL VLV			STOP																						
								OPEN																						
4	_0LAB33AA502		MD109		M-BFP MIN FCV			CLOSE																				4		
	_0LAB33AA501		HA008J		M-BFP O/L FCV			AUTO																						
								CLOSE																						
5	_0LAV30AA023		HA008Q		M-BFP HYDCPLG			AUTO																				5		
								CLOSE																						
6																												6		
7																												7		
8																												8		
9																												9		
10																												10		
11																												11		
12																												12		
13																												13		
14																												14		
15																												15		
	Rev.No.	0	1	2					PROJECT						Van Phong 1 BOT Thermal Power Plant Project 2x673MW															
	DATE	2021/6/21	2021/12/15	2022/11/8					TITLE																					
	CONTENTS	1st Issue	Revised	Revised (0062)					MBFP START/IN SERV MSTR TIMING CHART						DRAWING No.					SH		REV. MARK								
									Equipment No. : -						4GCH01007					TM027		2								

	A	B	C	D	E	F	G	H	I	J	K	L	M	N	O	P	Q	R	S	T	U	V	W	X	Y	Z	AA								
1											MBFP OUT SERV/STOP MSTR (TM470-TM474C)																				1				
2	TAG No.		LOGIC SHEET No.		EQUIPMENT NAME			STATUS		S1 S2 COMP																				2					
3	_0LAC30AP010		TM925		MBFP			RUN																						3					
	_0LAB33AA201		TM945		MBFP OTL VLV			STOP																											
4	_0LAB33AA502		MD109		M-BFP MIN FCV			OPEN																						4					
	_0LAB33AA501		HA008J		M-BFP O/L FCV			CLOSE																											
5	_0LAV30AA023		HA008Q		M-BFP HYDCPLG			AUTO																						5					
								CLOSE																						6					
6																														7					
7																														8					
8																														9					
9																														10					
10																														11					
11																														12					
12																														13					
13																														14					
14																														15					
15																														16					
Rev.No.		0		1		2										PROJECT																			
DATE		2021/6/21		2021/12/15		2022/11/8										Van Phong 1 BOT Thermal Power Plant Project 2x673MW																			
CONTENTS		1st Issue		Revised		Revised (0062)										TITLE										DRAWING No.					SH		REV. MARK		
																MBFP OUT SERV/STOP MSTR TIMING CHART										4GCH01007					TM029		2		
																Equipment No. : -																			

	A	B	C	D	E	F	G	H	I	J	K	L	M	N	O	P	Q	R	S	T	U	V	W	X	Y	Z	AA				
1											2nd TBFP OUT SERV/STOP MSTR (TM483A-TM483D)				PLANT SHUTDOWN by BFPT (without MBFP)				1st TBFP OUT SERV/STOP MSTR (with MBFP) (TM485A-TM485D)								1				
2	TAG No.		LOGIC SHEET No.		EQUIPMENT NAME				STATUS																		2				
3					TBFP-A TBFP-B				START		S1S2S3COMP				▼BFP Trip				S1S2S3COMP								3				
4	_XAX11AA659, 661/663, 665 _XAX21AA659, 661/663, 665		TM504 TM654		BFPT A TRIP SOLV A1,2/B1,2 BFPT B TRIP SOLV A1,2/B1,2				RST TRIP																		4				
5	_OLBR21AA201 _OLBR22AA201		TM570 TM720		BFPT A MSV I/L VLV BFPT B MSV I/L VLV				OPEN CLOSE																		5				
	_OMAL81AA401 _OMAL91AA401		TM580 TM730		BFPT A MSV B/S DV BFPT B MSV B/S DV				OPEN CLOSE		< 2900rpm				< 2900rpm				< 2900rpm												
6	_OMAL81AA402 _OMAL91AA402		TM585 TM735		BFPT A MSV A/S DV BFPT B MSV A/S DV				OPEN CLOSE																		6				
	_OLAC50AA201 _OLAC60AA201		TM590 TM740		BFPT A CSG DV BFPT B CSG DV				OPEN CLOSE		< 2000rpm				< 2000rpm				< 2000rpm												
7	_OMAW55AA401 _OMAW65AA401		TM600 TM750		BFPT A SSH DV BFPT B SSH DV				OPEN CLOSE																		7				
	_OLAC50AA203 _OLAC60AA203		TM595 TM745		BFPT A EXHD DV BFPT B EXHD DV				OPEN CLOSE																						
8	_OLBR30AA201 _OLBR20AA201		TM605 TM755		BFPT A EXH VLV BFPT B EXH VLV				OPEN CLOSE		Manual Operation								Manual Operation								8				
	_OLAB31AA201 _OLAB32AA201		TM825 TM835		T-BFP A OTL VLV T-BFP B OTL VLV				OPEN CLOSE																						
12	_OLAB31AA501 _OLAB32AA501		MD009 MD059		T-BFP A MIN FCV T-BFP B MIN FCV				AUTO CLOSE																		12				
9																											9				
10	_OLBG13AA201		TM815		BFPT AUXS PCV I/L VLV				OPEN CLOSE																		10				
11	_OLBG13AA501		MH055		BFPT AUXS PCV				AUTO CLOSE																		11				
12	_OLAB40AA201		TM850		T-BFP HDR ISOL VLV				OPEN CLOSE																		12				
	_OLAB40AA501		HA007AS		T-BFP STARTUP FCV				AUTO CLOSE																						
13																											13				
14																											14				
15																											15				
Rev.No.		0		1		2										PROJECT															
DATE		2021/6/21		2021/12/15		2022/11/8										Van Phong 1 BOT Thermal Power Plant Project 2x673MW															
CONTENTS		1st Issue		Revised		Revised (0062)										TITLE				DRAWING No.						SH		REV. MARK			
																2nd/1st TBFP OUT SERV/STOP MSTR TIMING CHART				4GCH01007						TM030		2			
																Equipment No. : -															

	A	B	C	D	E	F	G	H	I	J	K	L	M	N	O	P	Q	R	S	T	U	V	W	X	Y	Z	AA														
	Line Name			From	LID	Logic Chart																	LID	To	Line Name																
1	MBFP MOT 1 RUN			TM200	Z1	10LAC30AP010XQ01 10LAC30AP010XQ01 M-BFP CURR 1 MV SWGR 4-20mA 0 600 A IOAI-1 IO V AI Q DI-1 DI 3s FX-1 F(X) M-BFP CURR 1 ADL QTY QTY 0 600 A Y1 11																			M-BFP CURR 1																
2																										M-BFP CURR 1 QB															
3																																									
4																										M-BFP CURR 2															
5																										M-BFP CURR 2 QB															
6	MBFP MOT 2 RUN			TM201	Z1	10LAC30AP010XQ02 10LAC30AP010XQ02 M-BFP CURR 2 MV SWGR 4-20mA 0 600 A IOAI-2 IO V AI Q DI-2 DI 3s FX-2 F(X) M-BFP CURR 2 ADL QTY QTY 0 600 A Y2 21																																			
7																																									
8																																									
9																																									
10																																									
11						M-BFP CURR 1 TM100 FX-1 600 A 0 0 A 600																																			
12						M-BFP CURR 2 TM100 FX-2 600 A 0 0 A 600																																			
13						M-BFP CURR 1 TM100 FX-1 <table><tr><td></td><td>X</td><td>Y</td></tr><tr><td></td><td>A</td><td>A</td></tr><tr><td>1</td><td>0</td><td>0</td></tr><tr><td>2</td><td>600</td><td>600</td></tr><tr><td>3</td><td>600</td><td>600</td></tr></table>																		X	Y		A	A	1	0	0	2	600	600	3	600	600				
	X	Y																																							
	A	A																																							
1	0	0																																							
2	600	600																																							
3	600	600																																							
14						M-BFP CURR 2 TM100 FX-2 <table><tr><td></td><td>X</td><td>Y</td></tr><tr><td></td><td>A</td><td>A</td></tr><tr><td>1</td><td>0</td><td>0</td></tr><tr><td>2</td><td>600</td><td>600</td></tr><tr><td>3</td><td>600</td><td>600</td></tr></table>																		X	Y		A	A	1	0	0	2	600	600	3	600	600				
	X	Y																																							
	A	A																																							
1	0	0																																							
2	600	600																																							
3	600	600																																							
15																																									

Rev. No.	0	1	2	3				PROJECT	(TSQ B)			
DATE	2021/6/21	2021/12/15	2022/11/8	2023/7/5				Van Phong 1 BOT Thermal Power Plant Project 2×673MW				
CONTENTS	1st Issue	Revised (0015)	Revised (0064)	Revised (0112)				TITLE	DRAWING No.	SH	REV. MARK	
								FIELD AI PROCESSING (1)	4GCH01007	TM100	3	
								Equipment No. : -				

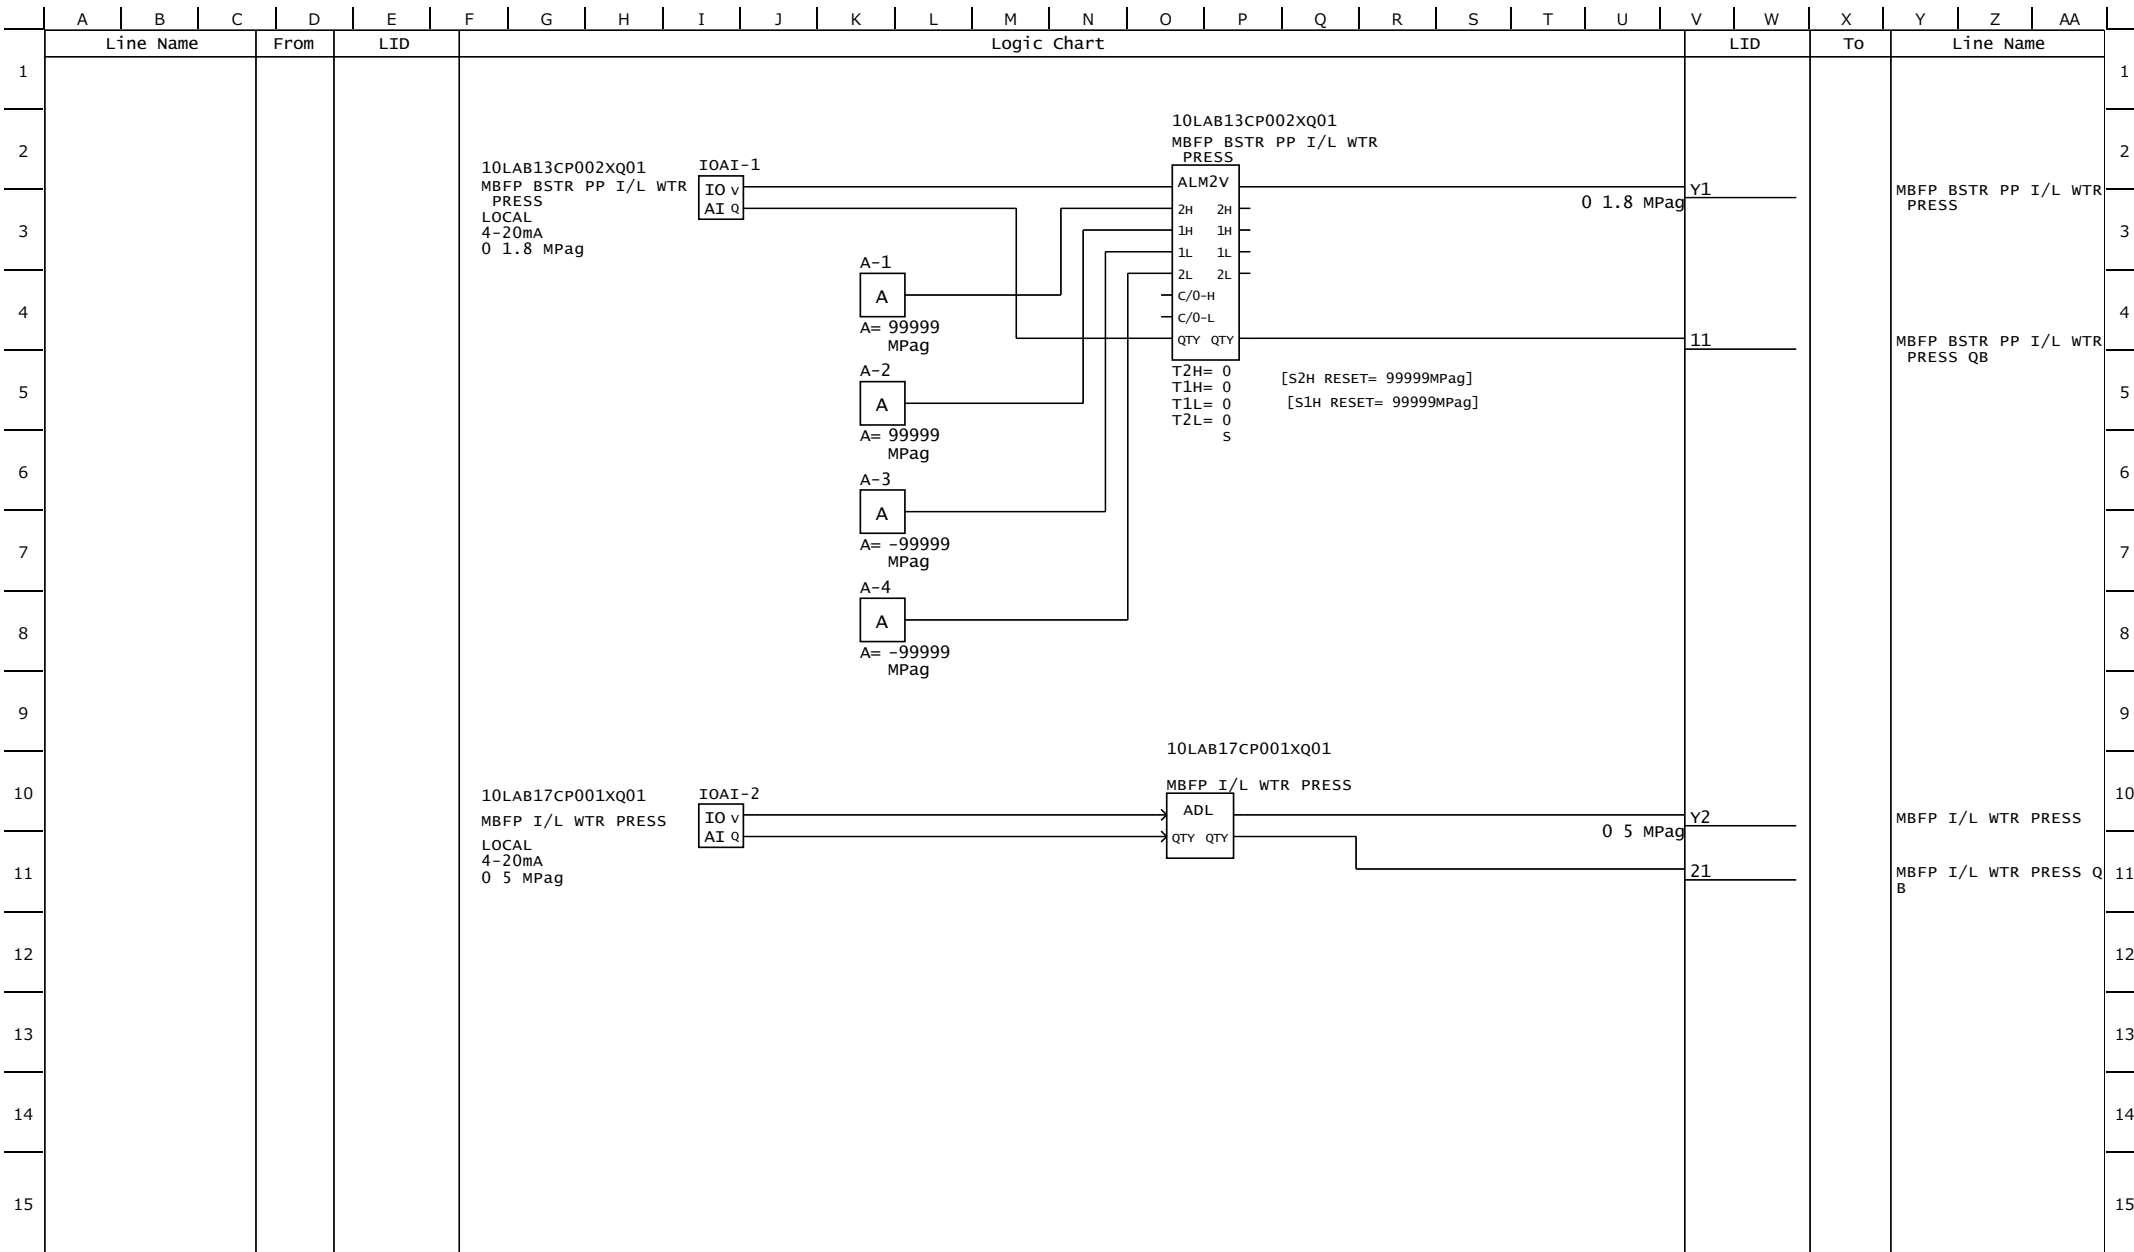

Rev. No.	0	1						PROJECT	(TSQ B)			
DATE	2021/6/21	2021/12/15						Van Phong 1 BOT Thermal Power Plant Project 2×673MW				
CONTENTS	1st Issue	Revised (0008)						TITLE	DRAWING No.	SH	REV. MARK	
								FIELD A1 PROCESSING (2a)	4GCH01007	TM101A	1	
								Equipment No. : -				

	A	B	C	D	E	F	G	H	I	J	K	L	M	N	O	P	Q	R	S	T	U	V	W	X	Y	Z	AA	
	Line Name			From	LID	Logic Chart																	LID	To	Line Name			
1																												1
2																												2
3																												3
4																												4
5																												5
6																												6
7																												7
8																												8
9																												9
10																												10
11																												11
12																												12
13																												13
14																												14
15																												15
	Rev. No.	0	1																			(TSQ B)						
	DATE	2021/6/21	2021/12/15																									
	CONTENTS	1st Issue	Revised (0008)																			DRAWING No.		SH		REV. MARK		
																						4GCH01007		TM101B		1		

	A	B	C	D	E	F	G	H	I	J	K	L	M	N	O	P	Q	R	S	T	U	V	W	X	Y	Z	AA	
	Line Name			From	LID	Logic Chart																	LID	To	Line Name			
1																												1
2																												2
3																												3
4																												4
5																												5
6																												6
7																												7
8																												8
9																												9
10																												10
11																												11
12																												12
13																												13
14																												14
15																												15

10LAB12CP002XQ01

TBFP B BSTR PP I/L W

TR PRESS

LOCAL

4-20mA

0 1.8 MPag

IOAI-5

IO v

AI Q

A-1

A

A= 99999 MPag

A-2

A

A= 99999 MPag

A-3

A

A= -99999 MPag

A-4

A

A= -99999 MPag

10LAB12CP002XQ01

TBFP B BSTR PP I/L W

TR PRESS

LOCAL

4-20mA

0 1.8 MPag

IOAI-5

IO v

AI Q

A-1

A

A= 99999 MPag

A-2

A

A= 99999 MPag

A-3

A

A= -99999 MPag

A-4

A

A= -99999 MPag

ALM2V

2H 2H

1H 1H

1L 1L

2L 2L

C/O-H

C/O-L

QTY QTY

0 1.8 MPag

Y5

51

T2H= 0

T1H= 0

T1L= 0

T2L= 0

S

[S2H RESET= 99999MPag]

[S1H RESET= 99999MPag]

10LAB16CP001XQ01

TBFP B I/L WTR PRESS

LOCAL

4-20mA

0 5 MPag

IOAI-6

IO v

AI Q

ADL

QTY QTY

0 5 MPag

Y6


61

	A	B	C	D	E	F	G	H	I	J	K	L	M	N	O	P	Q	R	S	T	U	V	W	X	Y	Z	AA
	Line Name			From	LID	Logic Chart																	LID	To	Line Name		
1						10LAB45CP001XQ01 BFP OTL WTR PRESS A LOCAL 4-20mA 0 50 MPag IOAI-2 IO V AI Q ADL QTY QTY 0 50 MPag																	Y2	TM180	BFP OTL WTR PRESS A	1	
2																										2	
3																										3	
4																										4	
5						10LAB45CP001XQ01 BFP OTL WTR PRESS A LOCAL 4-20mA 0 50 MPag IOAI-2 IO V AI Q ADL QTY QTY 0 50 MPag																	Y2	TM180	BFP OTL WTR PRESS A	5	
6																										6	
7																										7	
8																										8	
9						10LAB45CP002XQ01 BFP OTL WTR PRESS B LOCAL 4-20mA 0 50 MPag IOAI-3 IO V AI Q ADL QTY QTY 0 50 MPag																	Y3	TM180	BFP OTL WTR PRESS B	9	
10																										10	
11																										11	
12																										12	
13																										13	
14																										14	
15																										15	

Rev. No.	0	1						PROJECT	(TSQ B)			
DATE	2021/6/21	2021/12/15						Van Phong 1 BOT Thermal Power Plant Project 2×673MW				
CONTENTS	1st Issue	Revised (0008)						TITLE	DRAWING No.	SH	REV. MARK	
								FIELD AI PROCESSING (3)	4GCH01007	TM102	1	
								Equipment No. : -				

	A	B	C	D	E	F	G	H	I	J	K	L	M	N	O	P	Q	R	S	T	U	V	W	X	Y	Z	AA	
	Line Name			From	LID	Logic Chart																	LID	To	Line Name			
1																												1
2																												2
3																												3
4																												4
5																												5
6																												6
7																												7
8																												8
9																												9
10																												10
11																												11
12																												12
13																												13
14																												14
15																												15

Rev. No.	0	1	3					PROJECT Van Phong 1 BOT Thermal Power Plant Project 2×673MW	(TSQ B)		
DATE	2021/6/21	2021/12/15	2023/7/5								
CONTENTS	1st Issue	Revised (0007, 0008, 0024)	Revised (0164)					TITLE FIELD AI PROCESSING (4)	DRAWING No. 4GCH01007	SH TM103	REV. MARK 3
								Equipment No. : -			

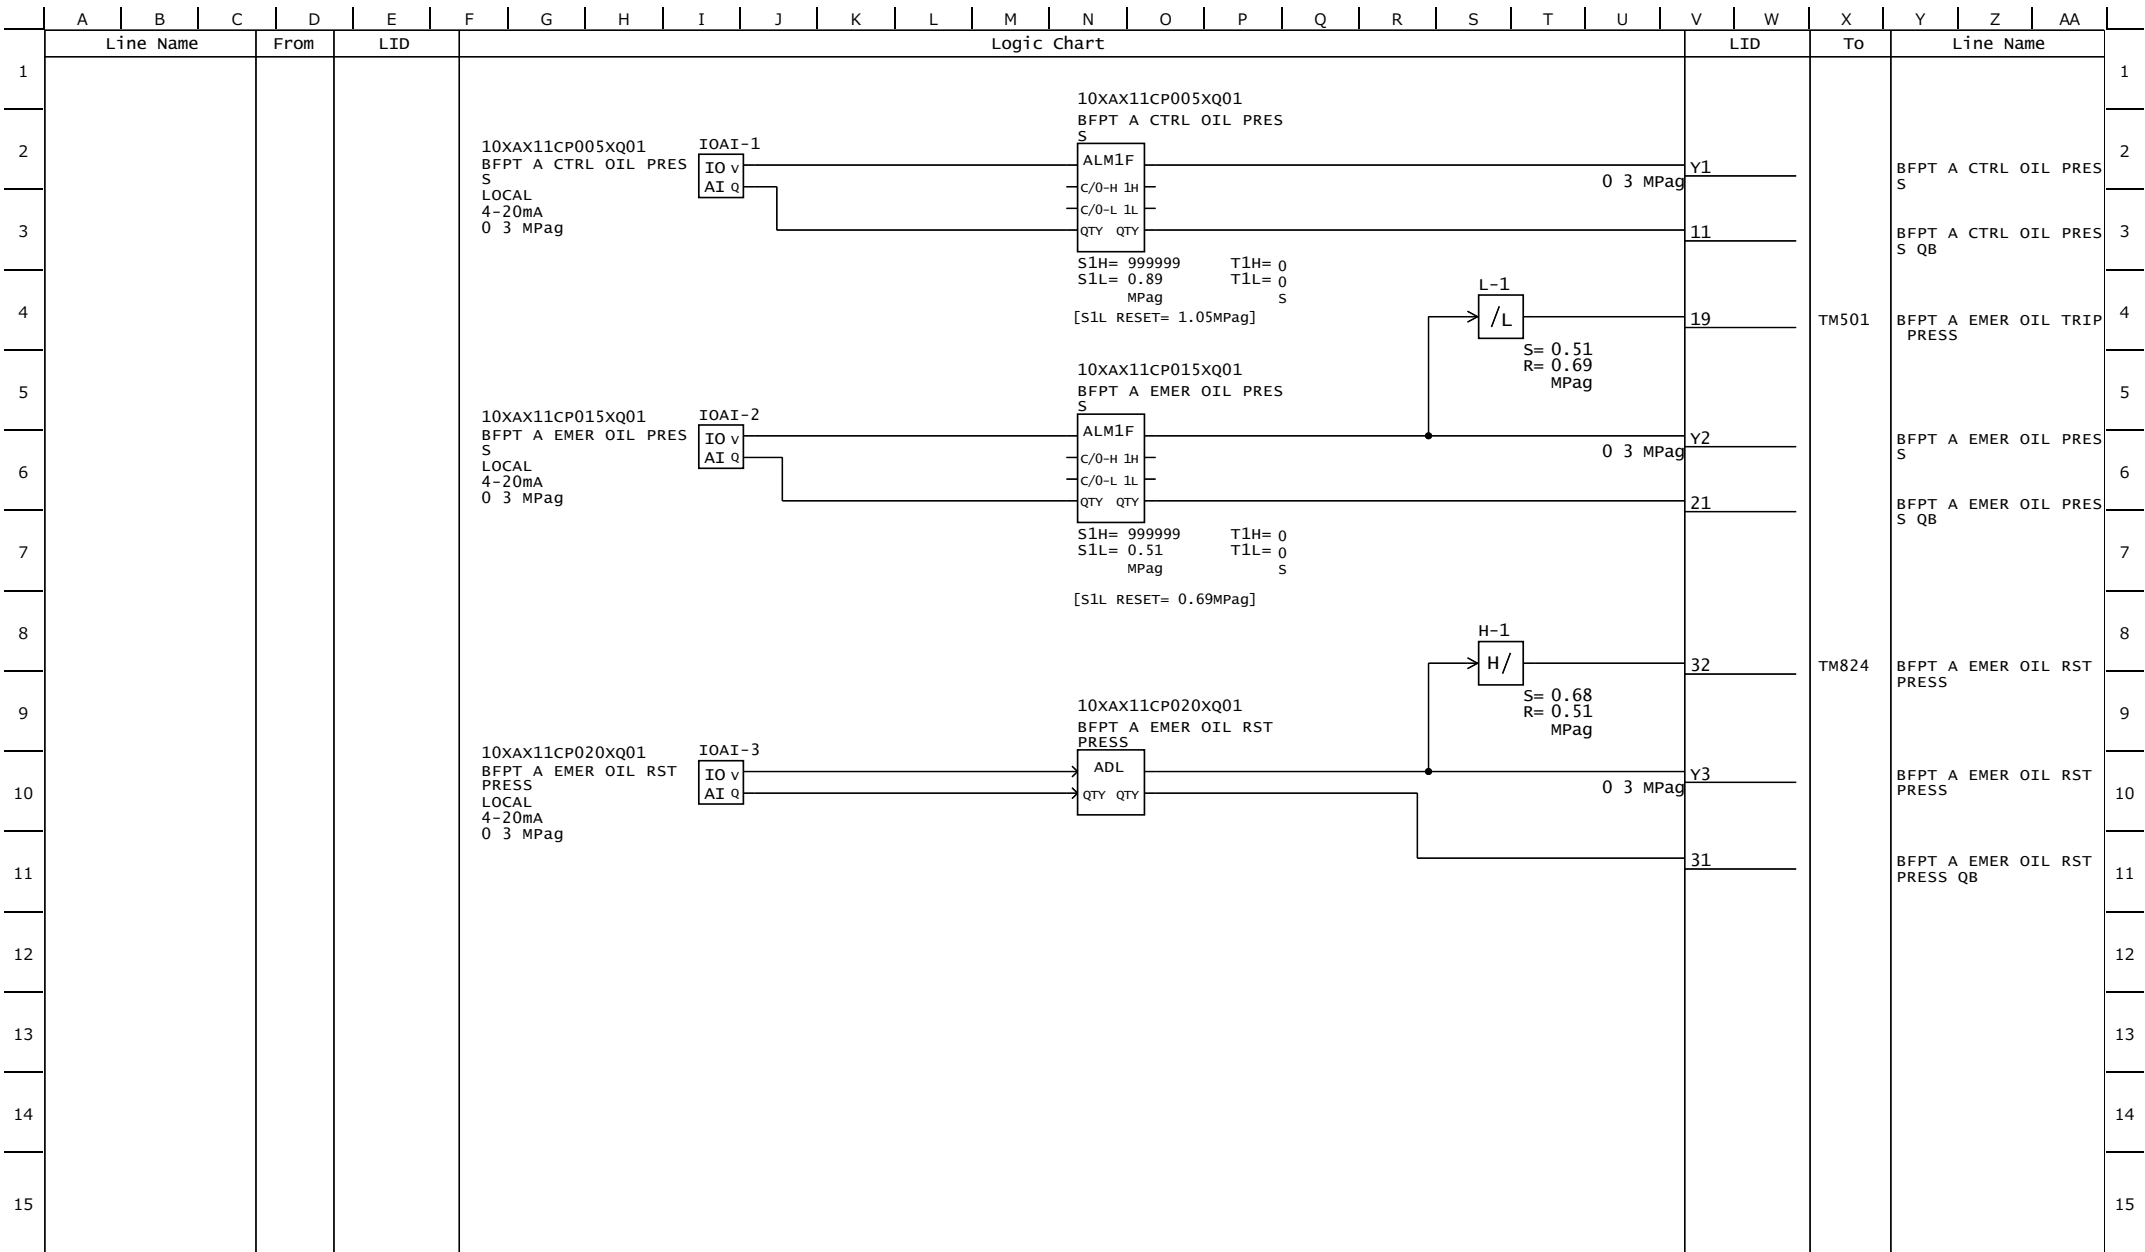


Rev. No.	0	1	2					PROJECT	(TSQ B)			
DATE	2021/6/21	2021/12/15	2022/11/8					Van Phong 1 BOT Thermal Power Plant Project 2×673MW				
CONTENTS	1st Issue	Revised (0008)	Revised & Tuning (0064, 0071, 0080)					TITLE	DRAWING No.	SH	REV. MARK	
								FIELD AI PROCESSING (5)	4GCH01007	TM104	2	
								Equipment No. : -				

	A	B	C	D	E	F	G	H	I	J	K	L	M	N	O	P	Q	R	S	T	U	V	W	X	Y	Z	AA		
	Line Name			From	LID	Logic Chart																		LID	To	Line Name			
1																												1	
2																										BFPT A EXH STM PRESS		2	
3																										BFPT A EXH STM PRESS QB		3	
4																										BFPT A EXH STM PRESS QB		4	
5																												5	
6																										BFPT A FA STAGE PRESS S		6	
7																										BFPT A FA STAGE PRESS QB		7	
8																										BFPT A LUBE OIL PRESS A		8	
9																										BFPT A LUBE OIL PRESS A QB		9	
10																										BFPT A LUBE OIL PRESS B		10	
11																										BFPT A LUBE OIL PRESS B QB		11	
12																										BFPT A LUBE OIL PRESS C		12	
13																										BFPT A LUBE OIL PRESS C QB		13	
14																												14	
15																												15	
	Rev. No.	0	1	2												PROJECT				(TSQ B)									
	DATE	2021/6/21	2021/12/15	2022/11/8												Van Phong 1 BOT Thermal Power Plant Project 2×673MW													
	CONTENTS	1st Issue	Revised (0008)	Revised & Tuning (0039, 0056, 0064)												TITLE				DRAWING No.				SH		REV. MARK			
																FIELD AI PROCESSING (6)				4GCH01007				TM105		2			
																Equipment No. : -													

	A	B	C	D	E	F	G	H	I	J	K	L	M	N	O	P	Q	R	S	T	U	V	W	X	Y	Z	AA	
	Line Name		From	LID	Logic Chart																	LID	To	Line Name				
1																									1			
2																									2			
3																									3			
4																									4			
5																									5			
6																									6			
7																									7			
8																									8			
9																									9			
10																									10			
11																									11			
12																									12			
13																									13			
14																									14			
15																									15			

Rev. No.	0	1	2					PROJECT Van Phong 1 BOT Thermal Power Plant Project 2×673MW	(TSQ B)		
DATE	2021/6/21	2021/12/15	2022/11/8								
CONTENTS	1st Issue	Revised (0008, 0015)	Revised & Tuning (0056, 0064, 0071)					TITLE	DRAWING No.	SH	REV. MARK
								FIELD AI PROCESSING (7)	4GCH01007	TM106	2
								Equipment No. : -			

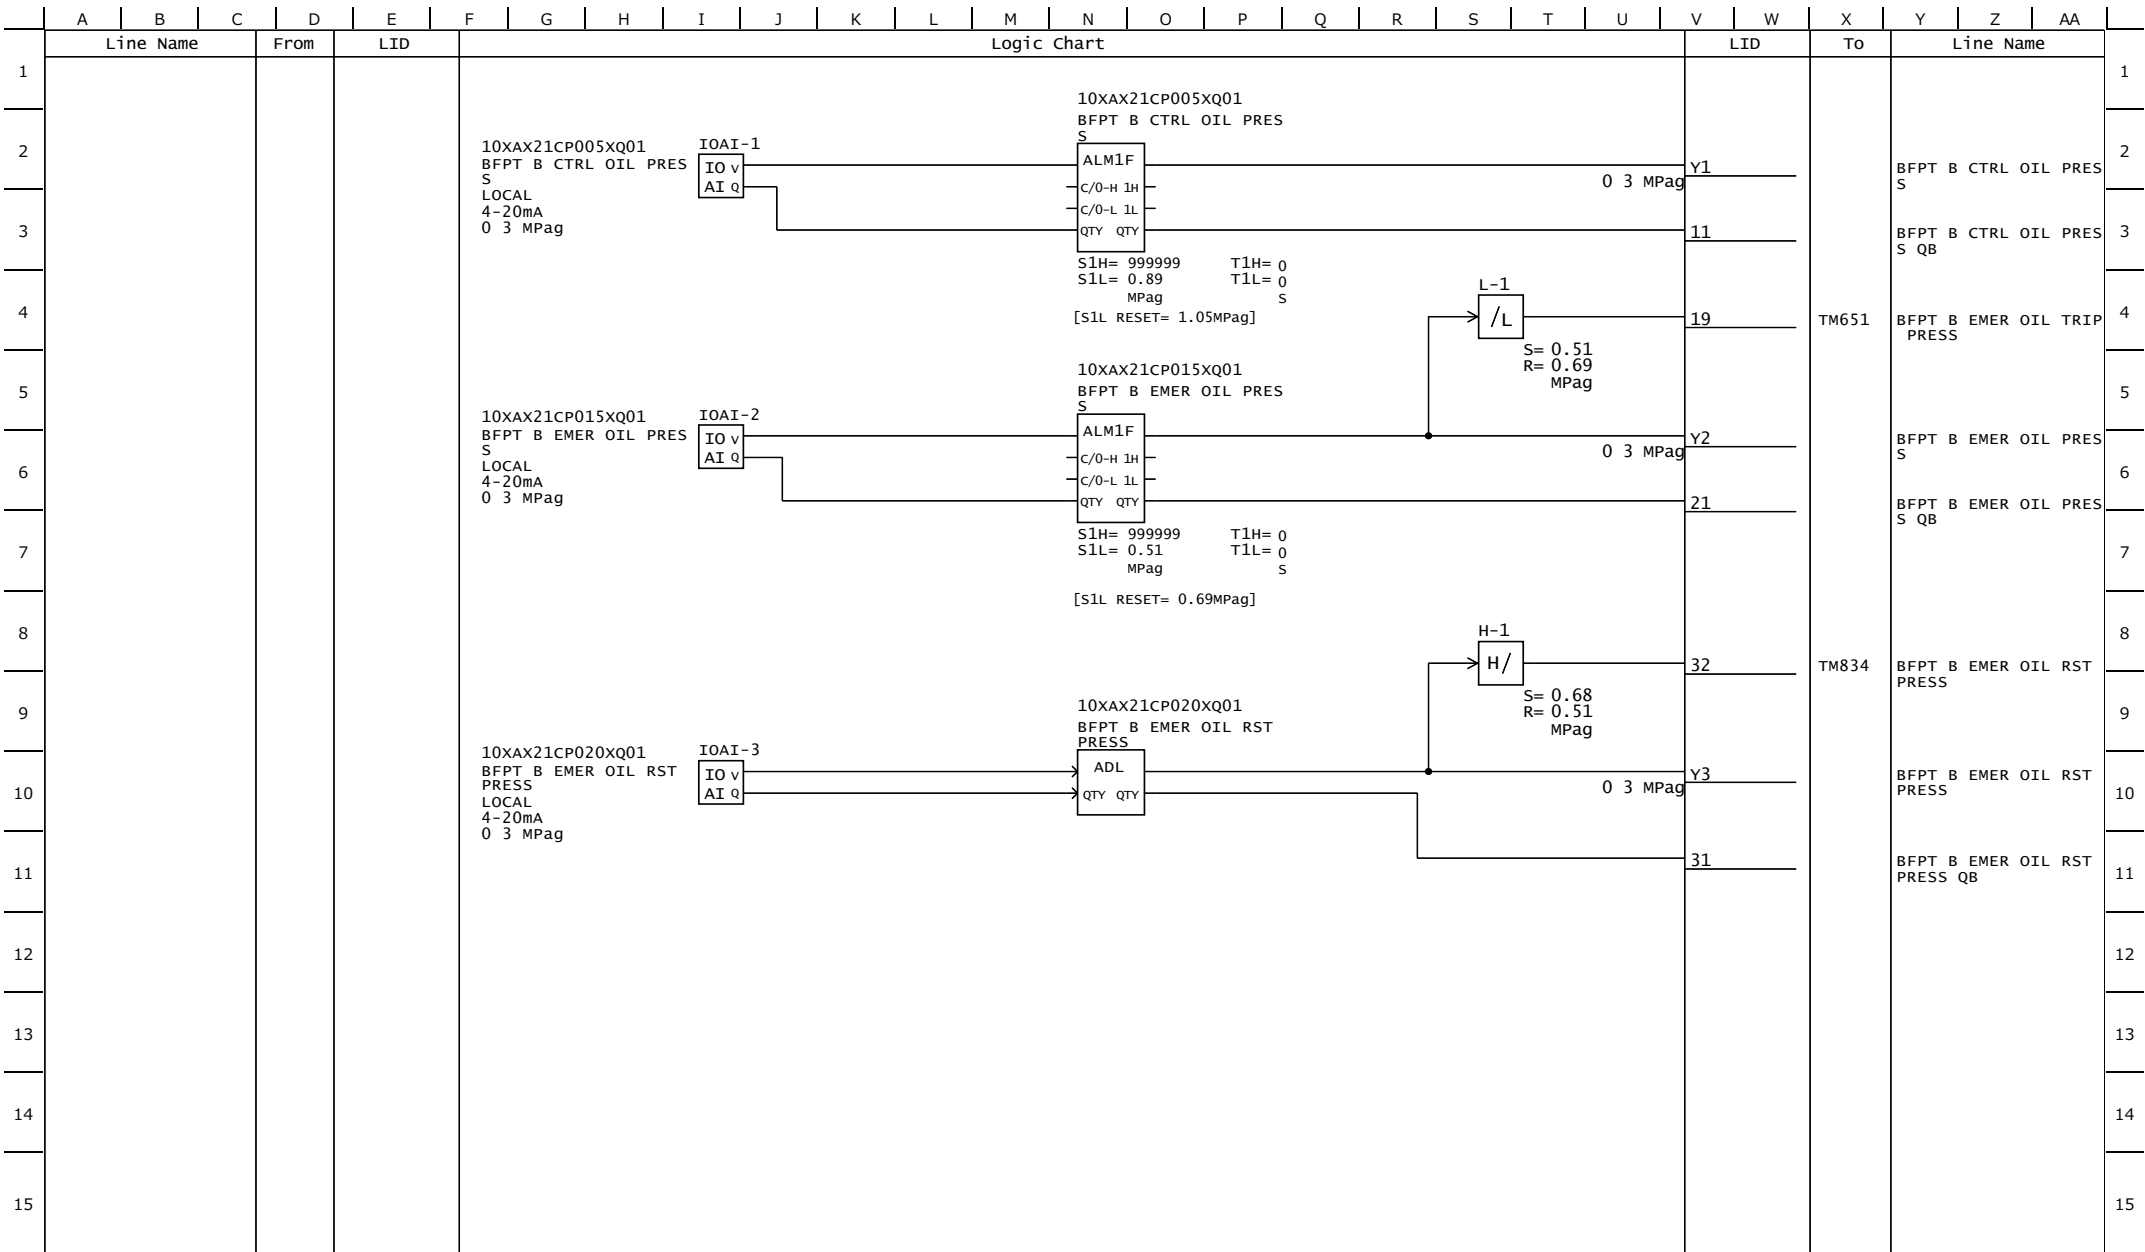

Rev. No.	0	1	2					PROJECT Van Phong 1 BOT Thermal Power Plant Project 2×673MW	(TSQ B)			
DATE	2021/6/21	2021/12/15	2022/11/8									
CONTENTS	1st Issue	Revised (0008)	Revised & Tuning (0064, 0071, 0080)					TITLE	DRAWING No.	SH	REV. MARK	
								FIELD AI PROCESSING (8)	4GCH01007	TM107	2	
								Equipment No. : -				

	A	B	C	D	E	F	G	H	I	J	K	L	M	N	O	P	Q	R	S	T	U	V	W	X	Y	Z	AA	
	Line Name		From	LID	Logic Chart																		LID	To	Line Name			
1																											1	
2																											2	
3																											3	
4																											4	
5																											5	
6																											6	
7																											7	
8																											8	
9																											9	
10																											10	
11																											11	
12																											12	
13																											13	
14																											14	
15																											15	

Rev. No.	0	1	2					PROJECT Van Phong 1 BOT Thermal Power Plant Project 2×673MW	(TSQ B)			
DATE	2021/6/21	2021/12/15	2022/11/8									
CONTENTS	1st Issue	Revised (0008, 0015)	Revised & Tuning (0056, 0064, 0071)					TITLE	DRAWING No.	SH	REV. MARK	
								FIELD AI PROCESSING (10)	4GCH01007	TM109	2	
								Equipment No. : -				

	A	B	C	D	E	F	G	H	I	J	K	L	M	N	O	P	Q	R	S	T	U	V	W	X	Y	Z	AA		
	Line Name			From	LID	Logic Chart																	LID	To	Line Name				
1						10LAB13CP003XQ01 MBFP BSTR PPSUSTNR D P LOCAL 4-20mA -100 100 kPa IOAI-1 IO v AI Q 10LAB13CP003XQ01 MBFP BSTR PPSUSTNR D P ALM2F 2H 1H C/0-H 1L C/0-L 2L QTY QTY [S2H RESET= 25kPa] [S1H RESET= 15kPa] S2H= 30 S1H= 20 S1L= -999999 S2L= -999999 kPa T2H= 0 T1H= 0 T1L= 0 T2L= 0 S -100 100kPa Y1 12 11																						1	
2																												2	
3																												3	
4																												4	
5																												5	
6																												6	
7																													7
8																													8
9																													9
10																													10
11																													11
12																													12
13																													13
14																													14
15																													15

Rev. No.	0	1	2					PROJECT	(TSQ B)			
DATE	2021/6/21	2021/12/15	2022/11/8					Van Phong 1 BOT Thermal Power Plant Project 2×673MW				
CONTENTS	1st Issue	Revised (0008)	Revised & Tuning (0032, 0056, 0064)					TITLE	DRAWING No.	SH	REV. MARK	
								FIELD A1 PROCESSING (11)	4GCH01007	TM110	2	
								Equipment No. : -				

	A	B	C	D	E	F	G	H	I	J	K	L	M	N	O	P	Q	R	S	T	U	V	W	X	Y	Z	AA	
	Line Name			From	LID	Logic Chart																	LID	To	Line Name			
1																											1	
2						10LAB33CP001XQ01 MBFP OTL WTR PRESS A LOCAL 4-20mA 0 60 MPag	IOAI-1 IO V AI Q											ADL QTY QTY	0 60 MPag	Y1	TM181	MBFP OTL WTR PRESS A			2			
3																						11	TM181	MBFP OTL WTR PRESS A QB			3	
4						10LAB33CP002XQ01 MBFP OTL WTR PRESS B LOCAL 4-20mA 0 60 MPag	IOAI-2 IO V AI Q											ADL QTY QTY	0 60 MPag	Y2	TM181	MBFP OTL WTR PRESS B			4			
5																						21	TM181	MBFP OTL WTR PRESS B QB			5	
6																											6	
7																											7	
8																											8	
9																											9	
10																											10	
11						10LAC30CS051XQ01 MBFP SPD LOCAL 4-20mA 0 7000 rpm	IOAI-3 IO V AI Q											MBFP_SPD ALM3F	0 7000 rpm	Y8	MD101 TM184	MBFP SPD			11			
12																		3H 2H 1H 1L -C/0-H 2L -C/0-L 3L QTY QTY			03		MBFP SPD HI HI HI			12		
13																		S3H= 999999 S2H= 999999 S1H= 999999 S1L= -999999 S2L= -999999 S3L= -999999 rpm	T3H= 0 T2H= 0 T1H= 0 T1L= 0 T2L= 0 T3L= 0 S		01		MBFP SPD HI			13		
14																						81	MD101 TM184	MBFP SPD QB			14	
15																											15	

Y1

Rev. No.	0	1	2	3				PROJECT	(TSQ B)			
DATE	2021/6/21	2021/12/15	2022/11/8	2023/7/5				Van Phong 1 BOT Thermal Power Plant Project 2×673MW				
CONTENTS	1st Issue	Revised (0007, 0008, 0015, 0024)	Revised & Tuning (0048, 0056, 0064)	Revised (0118, 0186)				TITLE	DRAWING No.	SH	REV. MARK	
								FIELD A1 PROCESSING (15)	4GCH01007	TM114	3	
								Equipment No. : -				

	A	B	C	D	E	F	G	H	I	J	K	L	M	N	O	P	Q	R	S	T	U	V	W	X	Y	Z	AA	
	Line Name		From	LID	Logic Chart																		LID	To	Line Name			
1																											1	
2					10LAC30CT051XQ01 MBFP BSTR PP THRST B RG TEMP LOCAL RTD 0 150 degC	IOAI-1 IO v AI q												10LAC30CT051XQ01 MBFP BSTR PP THRST B RG TEMP ALM2F 2H 1H C/0-H 1L C/0-L 2L QTY QTY S2H= 100 T2H= 0 S1H= 90 T1H= 0 S1L= -999999 T1L= 0 S2L= -999999 T2L= 0 degC S [S2H RESET= 90degC] [S1H RESET= 80degC]	Y1		MBFP BSTR PP THRST B RG TEMP	2						
3																											3	
4																											4	
5																							11		MBFP BSTR PP THRST B RG TEMP QB	5		
6																											6	
7					10LAC30CT052XQ01 MBFP BSTR PP DE BRG TEMP LOCAL RTD 0 150 degC	IOAI-2 IO v AI q												10LAC30CT052XQ01 MBFP BSTR PP DE BRG TEMP ALM2F 2H 1H C/0-H 1L C/0-L 2L QTY QTY S2H= 100 T2H= 0 S1H= 90 T1H= 0 S1L= -999999 T1L= 0 S2L= -999999 T2L= 0 degC S [S2H RESET= 90degC] [S1H RESET= 80degC]	Y2		MBFP BSTR PP DE BRG TEMP	7						
8																											8	
9																							21		MBFP BSTR PP DE BRG TEMP QB	9		
10																											10	
11																											11	
12					10LAC30CT053XQ01 MBFP BSTR PP NDE BRG TEMP LOCAL RTD 0 150 degC	IOAI-3 IO v AI q												10LAC30CT053XQ01 MBFP BSTR PP NDE BRG TEMP ALM2F 2H 1H C/0-H 1L C/0-L 2L QTY QTY S2H= 100 T2H= 0 S1H= 90 T1H= 0 S1L= -999999 T1L= 0 S2L= -999999 T2L= 0 degC S [S2H RESET= 90degC] [S1H RESET= 80degC]	Y3		MBFP BSTR PP NDE BRG TEMP	12						
13																											13	
14																							31		MBFP BSTR PP NDE BRG TEMP QB	14		
15																											15	

MBFP BSTR PP THRST B

RG TEMP

Rev. No.	0	1	2					PROJECT Van Phong 1 BOT Thermal Power Plant Project 2×673MW	(TSQ B)			
DATE	2021/6/21	2021/12/15	2022/11/8									
CONTENTS	1st Issue	Revised (0008, 0015)	Revised & Tuning (0056, 0064)					TITLE	DRAWING No.	SH	REV. MARK	
								FIELD AI PROCESSING (18)	4GCH01007	TM117	2	
								Equipment No. : —				

	A	B	C	D	E	F	G	H	I	J	K	L	M	N	O	P	Q	R	S	T	U	V	W	X	Y	Z	AA	
	Line Name		From	LID	Logic Chart																			LID	To	Line Name		
1																												1
2																												
3																												3
4																												4
5																												
6																												6
7																												7
8																												
9																												9
10																												10
11																												
12																												12
13																												13
14																												14
15																												

Rev. No.	0	1	2					PROJECT Van Phong 1 BOT Thermal Power Plant Project 2×673MW	(TSQ B)			
DATE	2021/6/21	2021/12/15	2022/11/8									
CONTENTS	1st Issue	Revised (0008, 0015)	Revised & Tuning (0056, 0064)					TITLE	DRAWING No.	SH	REV. MARK	
								FIELD A1 PROCESSING (19)	4GCH01007	TM118	2	
								Equipment No. :	-			

	A	B	C	D	E	F	G	H	I	J	K	L	M	N	O	P	Q	R	S	T	U	V	W	X	Y	Z	AA	
	Line Name			From	LID	Logic Chart																	LID	To	Line Name			
1						10LAC30CT057xQ01 10LAC30CT057xQ01 MBFP UPR BRL TEMP A LOCAL RTD 0 250 degC IOAI-1 IO V AI Q ALM2F 2H 1H C/0-H 1L C/0-L 2L QTY QTY S2H= 99999 S1H= 99999 S1L= -999999 S2L= -999999 degC [S2H RESET= 99999degC] [S1H RESET= 99999degC] 10LAC30CT058xQ01 10LAC30CT058xQ01 MBFP UPR BRL TEMP B LOCAL RTD 0 250 degC IOAI-2 IO V AI Q ALM2F 2H 1H C/0-H 1L C/0-L 2L QTY QTY S2H= 99999 S1H= 99999 S1L= -999999 S2L= -999999 degC [S2H RESET= 99999degC] [S1H RESET= 99999degC]																	y1	TM950 TM951	MBFP UPR BRL TEMP A	1		
2																										2		
3																										3		
4																										4		
5																										5		
6																										6		
7																										7		
8																										8		
9																										9		
10																										10		
11																										11		
12																										12		
13																										13		
14																										14		
15																										15		
Rev. No.			0	1	2										PROJECT			(TSQ B)										
DATE			2021/6/21	2021/12/15	2022/11/8										Van Phong 1 BOT Thermal Power Plant Project 2×673MW													
CONTENTS			1st Issue	Revised (0008,0015)	Revised (0080)										TITLE			DRAWING No.				SH		REV. MARK				
															FIELD AI PROCESSING (20)			4GCH01007				TM119		2				
															Equipment No. : -													

	A	B	C	D	E	F	G	H	I	J	K	L	M	N	O	P	Q	R	S	T	U	V	W	X	Y	Z	AA	
	Line Name			From	LID	Logic Chart																	LID	To	Line Name			
1																												1
2																												2
3																												3
4																												4
5																												5
6																												6
7																												7
8																												8
9																												9
10																												10
11																												11
12																												12
13																												13
14																												14
15																												15

Rev. No.	0	1	2					PROJECT	(TSQ B)			
DATE	2021/6/21	2021/12/15	2022/11/8					Van Phong 1 BOT Thermal Power Plant Project 2×673MW				
CONTENTS	1st Issue	Revised (0008, 0015)	Revised (0080)					TITLE	DRAWING No.	SH	REV. MARK	
								FIELD A1 PROCESSING (21)	4GCH01007	TM120	2	
								Equipment No. :	-			

	A	B	C	D	E	F	G	H	I	J	K	L	M	N	O	P	Q	R	S	T	U	V	W	X	Y	Z	AA					
	Line Name		From	LID	Logic Chart																			LID	To	Line Name						
1																												1				
2					10LAC30CT079XQ01 MBFP MOT 2 HOT AIR T ENP LOCAL RTD -60 180 degC IOAI-1 IO v AI Q 10LAC30CT079XQ01 MBFP MOT 2 HOT AIR T ENP LOCAL RTD -60 180 degC ALM2F 2H 1H C/O-H 1L C/O-L 2L QTY QTY S2H= 99999 T2H= 0 S1H= 94 T1H= 0 S1L= -999999 T1L= 0 S2L= -999999 T2L= 0 degC S [S1H RESET= 90degC] -60 180 degC Y1																							MBFP MOT 2 HOT AIR T ENP		2		
3																													3			
4																								11		MBFP MOT 2 HOT AIR T ENP QB		4				
5																													5			
6																													6			
7					10LAC30CT080XQ01 MBFP MOT 2 CLD AIR T EMP LOCAL RTD -60 180 degC IOAI-2 IO v AI Q 10LAC30CT080XQ01 MBFP MOT 2 CLD AIR T EMP LOCAL RTD -60 180 degC ALM2F 2H 1H C/O-H 1L C/O-L 2L QTY QTY S2H= 99999 T2H= 0 S1H= 65 T1H= 0 S1L= -999999 T1L= 0 S2L= -999999 T2L= 0 degC S [S1H RESET= 60degC] -60 180 degC Y2																									MBFP MOT 2 CLD AIR T EMP		7
8																													8			
9																								21		MBFP MOT 2 CLD AIR T EMP QB		9				
10																													10			
11																													11			
12																													12			
13																													13			
14																													14			
15																													15			

Rev. No.	0	1	2					PROJECT	(TSQ B)			
DATE	2021/6/21	2021/12/15	2022/11/8					Van Phong 1 BOT Thermal Power Plant Project 2×673MW				
CONTENTS	1st Issue	Revised (0008, 0015)	Revised & Tuning (0056, 0064)					TITLE	DRAWING No.	SH	REV. MARK	
								FIELD A1 PROCESSING (27)	4GCH01007	TM126	2	
								Equipment No. : -				

	A	B	C	D	E	F	G	H	I	J	K	L	M	N	O	P	Q	R	S	T	U	V	W	X	Y	Z	AA		
	Line Name			From	LID	Logic Chart																		LID	To	Line Name			
1																													1
2																													2
3																													3
4																													4
5																													5
6																													6
7																													7
8																													8
9																													9
10																													10
11																													11
12																													12
13																													13
14																													14
15																													15
Rev. No.		0	1	2					PROJECT				(TSQ B)																
DATE		2021/6/21	2021/12/15	2022/11/8					Van Phong 1 BOT Thermal Power Plant Project 2×673MW																				
CONTENTS		1st Issue	Revised (0008, 0015)	Revised & Tuning (0048, 0056, 0064)					TITLE				DRAWING No.						SH		REV. MARK								
									FIELD AI PROCESSING (28)				4GCH01007						TM127		2								
									Equipment No. :																				

	A	B	C	D	E	F	G	H	I	J	K	L	M	N	O	P	Q	R	S	T	U	V	W	X	Y	Z	AA		
	Line Name			From	LID	Logic Chart																		LID	To	Line Name			
1																													1
2																													2
3																													3
4																													4
5																													5
6																													6
7																													7
8																													8
9																													9
10																													10
11																													11
12																													12
13																													13
14																													14
15																													15
	Rev. No.	0	1	2																			(TSQ B)						
	DATE	2021/6/21	2021/12/15	2022/11/8																									
	CONTENTS	1st Issue	Revised (0008,0015)	Revised & Tuning (0048,0056, 0064)																			DRAWING No.		SH		REV. MARK		
																							4GCH01007		TM128		2		

Y1

0 180 degC

	A	B	C	D	E	F	G	H	I	J	K	L	M	N	O	P	Q	R	S	T	U	V	W	X	Y	Z	AA
	Line Name			From	LID	Logic Chart																		LID	To	Line Name	
1																											
2																											
Rev. No.		0	1	2					PROJECT				(TSQ B)														
DATE		2021/6/21	2021/12/15	2022/11/8					Van Phong 1 BOT Thermal Power Plant Project 2×673MW																		
CONTENTS		1st Issue	Revised (0008, 0015)	Revised & Tuning (0048, 0056, 0064)					TITLE				DRAWING No.				SH		REV. MARK								
									FIELD AI PROCESSING (30)				4GCH01007				TM129		2								
									Equipment No. :																		

Y1

0 180 degC

	A	B	C	D	E	F	G	H	I	J	K	L	M	N	O	P	Q	R	S	T	U	V	W	X	Y	Z	AA	
	Line Name			From	LID	Logic Chart																	LID	To	Line Name			
1																												1
2																												2
3																												3
4																												4
5																												5
6																												6
7																												7
8																												8
9																												9
10																												10
11																												11
12																												12
13																												13
14																												14
15																												15

Rev. No.	0	1	2					PROJECT	(TSQ B)			
DATE	2021/6/21	2021/12/15	2022/11/8					Van Phong 1 BOT Thermal Power Plant Project 2×673MW				
CONTENTS	1st Issue	Revised (0008, 0015)	Revised & Tuning (0048, 0056, 0064)					TITLE	DRAWING No.	SH	REV. MARK	
								FIELD A1 PROCESSING (31)	4GCH01007	TM130	2	
								Equipment No. : -				

	A	B	C	D	E	F	G	H	I	J	K	L	M	N	O	P	Q	R	S	T	U	V	W	X	Y	Z	AA																			
	Line Name			From	LID	Logic Chart																	LID	To	Line Name																					
1																												1																		
2						10LAC30CT096xQ01 MBFP BSTR PP RTN SL WTR DE TEMP LOCAL RTD 0 210 degC	IOAI-1 IO v AI q															10LAC30CT096xQ01 MBFP BSTR PP RTN SL WTR DE TEMP ALM2F 2H 1H C/O-H 1L C/O-L 2L QTY QTY S2H= 90 T2H= 0 S1H= 80 T1H= 0 S1L= -999999 T1L= 0 S2L= -999999 T2L= 0 degC S [S2H RESET= 85degC] [S1H RESET= 75degC]																								2
3																							Y1		MBFP BSTR PP RTN SL WTR DE TEMP			2																		
4																							03		MBFP BSTR PP RTN SL WTR DE TEMP HI HI			3																		
5																							11		MBFP BSTR PP RTN SL WTR DE TEMP QB			4																		
6																												5																		
7						10LAC30CT097xQ01 MBFP BSTR PP RTN SL WTR NDE TEMP LOCAL RTD 0 210 degC	IOAI-2 IO v AI q															10LAC30CT097xQ01 MBFP BSTR PP RTN SL WTR NDE TEMP ALM2F 2H 1H C/O-H 1L C/O-L 2L QTY QTY S2H= 90 T2H= 0 S1H= 80 T1H= 0 S1L= -999999 T1L= 0 S2L= -999999 T2L= 0 degC S [S2H RESET= 85degC] [S1H RESET= 75degC]																						6		
8																							Y2		MBFP BSTR PP RTN SL WTR NDE TEMP			7																		
9																							13		MBFP BSTR PP RTN SL WTR NDE TEMP HI HI			8																		
10																							21		MBFP BSTR PP RTN SL WTR NDE TEMP QB			9																		
11																												10																		
12																													11																	
13																												12																		
14																												13																		
15																												14																		
																												15																		

Rev. No.	0	1	2					PROJECT	(TSQ B)			
DATE	2021/6/21	2021/12/15	2022/11/8					Van Phong 1 BOT Thermal Power Plant Project 2×673MW				
CONTENTS	1st Issue	Revised (0008, 0015)	Revised & Tuning (0056, 0064)					TITLE	DRAWING No.	SH	REV. MARK	
								FIELD A1 PROCESSING (32)	4GCH01007	TM131	2	
								Equipment No. : -				

	A	B	C	D	E	F	G	H	I	J	K	L	M	N	O	P	Q	R	S	T	U	V	W	X	Y	Z	AA		
	Line Name			From	LID	Logic Chart																	LID	To	Line Name				
1																													1
2																													2
3																													3
4																													4
5																													5
6																													6
7																													7
8																													8
9																													9
10																													10
11																													11
12																													12
13																													13
14																													14
15																													15

Rev. No.	0	1	2					PROJECT	(TSQ B)			
DATE	2021/6/21	2021/12/15	2022/11/8					Van Phong 1 BOT Thermal Power Plant Project 2×673MW				
CONTENTS	1st Issue	Revised (0008, 0015)	Revised & Tuning (0056, 0064)					TITLE	DRAWING No.	SH	REV. MARK	
								FIELD A1 PROCESSING (33)	4GCH01007	TM132	2	
								Equipment No. :	-			

	A	B	C	D	E	F	G	H	I	J	K	L	M	N	O	P	Q	R	S	T	U	V	W	X	Y	Z	AA		
	Line Name		From	LID	Logic Chart																			LID	To	Line Name			
1																												1	
2					10LAV30CT091XQ01 MBFP LUBE OIL CLR I/ L OIL TEMP LOCAL RTD 0 180 degC	IOAI-1 IO v AI q																		10LAV30CT091XQ01 MBFP LUBE OIL CLR I/ L OIL TEMP ALM2F 2H 1H C/O-H 1L C/O-L 2L QTY QTY	0 180 degC	Y1	MBFP LUBE OIL CLR I/ L OIL TEMP		2
3																												3	
4																								S2H= 99999 T2H= 0 S1H= 65 T1H= 0 S1L= -999999 T1L= 0 S2L= -999999 T2L= 0 degC S [S1H RESET= 60degC]		11	MBFP LUBE OIL CLR I/ L OIL TEMP QB		4
5																												5	
6																												6	
7					10LAV30CT092XQ01 MBFP LUBE OIL CLR OT L OIL TEMP LOCAL RTD 0 180 degC	IOAI-2 IO v AI q																		10LAV30CT092XQ01 MBFP LUBE OIL CLR OT L OIL TEMP ALM2F 2H 1H C/O-H 1L C/O-L 2L QTY QTY	0 180 degC	Y2	MBFP LUBE OIL CLR OT L OIL TEMP		7
8																												8	
9																								S2H= 60 T2H= 0 S1H= 55 T1H= 0 S1L= -999999 T1L= 0 S2L= -999999 T2L= 0 degC S [S2H RESET= 55degC] [S1H RESET= 50degC]		21	MBFP LUBE OIL CLR OT L OIL TEMP QB		9
10																												10	
11																												11	
12																												12	
13																												13	
14																												14	
15																												15	

MBFP LUBE OIL CLR I/

L OIL TEMP

Rev. No.	0	1	2					PROJECT	(TSQ B)			
DATE	2021/6/21	2021/12/15	2022/11/8					Van Phong 1 BOT Thermal Power Plant Project 2×673MW				
CONTENTS	1st Issue	Revised (0007, 0008, 0015, 0026)	Revised & Tuning (0056, 0064)					TITLE	DRAWING No.	SH	REV. MARK	
								FIELD A1 PROCESSING (34)	4GCH01007	TM133	2	
								Equipment No. : -				

	A	B	C	D	E	F	G	H	I	J	K	L	M	N	O	P	Q	R	S	T	U	V	W	X	Y	Z	AA	
	Line Name		From	LID	Logic Chart																		LID	To	Line Name			
1																											1	
2					10LAC10CT051xQ01 TBFP A BSTR PP THRST BRG TEMP LOCAL RTD 0 150 degC	IOAI-1 IO V AI Q													10LAC10CT051xQ01 TBFP A BSTR PP THRST BRG TEMP ALM2F 2H 1H C/0-H 1L C/0-L 2L QTY QTY S2H= 100 S1H= 90 S1L= -999999 S2L= -999999 degC [S2H RESET= 90degC] [S1H RESET= 80degC]	T2H= 0 T1H= 0 T1L= 0 T2L= 0 S	0 150 degC	Y1	TBFP A BSTR PP THRST BRG TEMP	2				
3																											3	
4																											4	
5																											5	
6																											6	
7					10LAC10CT052xQ01 TBFP A BSTR PP DE BR G TEMP LOCAL RTD 0 150 degC	IOAI-2 IO V AI Q													10LAC10CT052xQ01 TBFP A BSTR PP DE BR G TEMP ALM2F 2H 1H C/0-H 1L C/0-L 2L QTY QTY S2H= 100 S1H= 90 S1L= -999999 S2L= -999999 degC [S2H RESET= 90degC] [S1H RESET= 80degC]	T2H= 0 T1H= 0 T1L= 0 T2L= 0 S	0 150 degC	Y2	TBFP A BSTR PP DE BR G TEMP	7				
8																											8	
9																											9	
10																											10	
11																											11	
12					10LAC10CT053xQ01 TBFP A BSTR PP NDE B RG TEMP LOCAL RTD 0 150 degC	IOAI-3 IO V AI Q													10LAC10CT053xQ01 TBFP A BSTR PP NDE B RG TEMP ALM2F 2H 1H C/0-H 1L C/0-L 2L QTY QTY S2H= 100 S1H= 90 S1L= -999999 S2L= -999999 degC [S2H RESET= 90degC] [S1H RESET= 80degC]	T2H= 0 T1H= 0 T1L= 0 T2L= 0 S	0 150 degC	Y3	TBFP A BSTR PP NDE B RG TEMP	12				
13																											13	
14																											14	
15																											15	

Y1

0 150 degC

Rev. No.	0	1	2					PROJECT Van Phong 1 BOT Thermal Power Plant Project 2×673MW	(TSQ B)			
DATE	2021/6/21	2021/12/15	2022/11/8									
CONTENTS	1st Issue	Revised (0008, 0015)	TUNING (0064)					TITLE	DRAWING No.	SH	REV. MARK	
								FIELD A1 PROCESSING (36)	4GCH01007	TM135	2	
								Equipment No. : -				

	A	B	C	D	E	F	G	H	I	J	K	L	M	N	O	P	Q	R	S	T	U	V	W	X	Y	Z	AA	
	Line Name		From	LID	Logic Chart																		LID	To	Line Name			
1																												1
2					10LAC10CT054XQ01 10LAC10CT054XQ01 TBFP A NDE BRG TEMP LOCAL RTD 0 150 degC IOAI-1 IO V AI Q TBFP A ALM2F 2H 1H C/0-H 1L C/0-L 2L QTY QTY S2H= 100 S1H= 90 S1L= -999999 S2L= -999999 degC T2H= 0 T1H= 0 T1L= 0 T2L= 0 S [S2H RESET= 90degC] [S1H RESET= 80degC]																		Y1		TBFP A NDE BRG TEMP			2
3																							13		TBFP A NDE BRG TEMP HI HI			3
4																							11		TBFP A NDE BRG TEMP QB			4
5																												5
6																												6
7					10LAC10CT055XQ01 10LAC10CT055XQ01 TBFP A THRST BRG TEM P LOCAL RTD 0 150 degC IOAI-2 IO V AI Q TBFP A ALM2F 2H 1H C/0-H 1L C/0-L 2L QTY QTY S2H= 100 S1H= 90 S1L= -999999 S2L= -999999 degC T2H= 0 T1H= 0 T1L= 0 T2L= 0 S [S2H RESET= 90degC] [S1H RESET= 80degC]																		Y2		TBFP A THRST BRG TEM P			7
8																							23		TBFP A THRST BRG TEM P HI HI			8
9																							21		TBFP A THRST BRG TEM P QB			9
10																												10
11																												11
12					10LAC10CT056XQ01 10LAC10CT056XQ01 TBFP A DE BRG TEMP LOCAL RTD 0 150 degC IOAI-3 IO V AI Q TBFP A ALM2F 2H 1H C/0-H 1L C/0-L 2L QTY QTY S2H= 100 S1H= 90 S1L= -999999 S2L= -999999 degC T2H= 0 T1H= 0 T1L= 0 T2L= 0 S [S2H RESET= 90degC] [S1H RESET= 80degC]																		Y3		TBFP A DE BRG TEMP			12
13																							33		TBFP A DE BRG TEMP HI HI			13
14																							31		TBFP A DE BRG TEMP QB			14
15																												15

Rev. No.	0	1	2					PROJECT Van Phong 1 BOT Thermal Power Plant Project 2×673MW	(TSQ B)			
DATE	2021/6/21	2021/12/15	2022/11/8									
CONTENTS	1st Issue	Revised (0008, 0015)	TUNING (0064)					TITLE	DRAWING No.	SH	REV. MARK	
								FIELD A1 PROCESSING (37)	4GCH01007	TM136	2	
								Equipment No. : —				

	A	B	C	D	E	F	G	H	I	J	K	L	M	N	O	P	Q	R	S	T	U	V	W	X	Y	Z	AA
	Line Name		From	LID	Logic Chart																	LID	To	Line Name			
1																											1
2					10LAC10CT057XQ01 TBFP A UPR BRL TEMP A LOCAL RTD 0 250 degC	IOAI-1 IO v AI q											10LAC10CT057XQ01 TBFP A UPR BRL TEMP A ALM2F 2H 1H C/0-H 1L C/0-L 2L QTY QTY S2H= 99999 T2H= 0 S1H= 90 T1H= 0 S1L= -999999 T1L= 0 S2L= -999999 T2L= 0 degC S [S1H RESET= 85degC]	Y1 0 250 degC	TM830 TM831	TBFP A UPR BRL TEMP A			2				
3																											3
4																						11	TM830	TBFP A UPR BRL TEMP A QB			4
5																											5
6																											6
7					10LAC10CT058XQ01 TBFP A UPR BRL TEMP B LOCAL RTD 0 250 degC	IOAI-2 IO v AI q											10LAC10CT058XQ01 TBFP A UPR BRL TEMP B ALM2F 2H 1H C/0-H 1L C/0-L 2L QTY QTY S2H= 99999 T2H= 0 S1H= 90 T1H= 0 S1L= -999999 T1L= 0 S2L= -999999 T2L= 0 degC S [S1H RESET= 85degC]	Y2 0 250 degC	TM830 TM831	TBFP A UPR BRL TEMP B			7				
8																											8
9																						21	TM830	TBFP A UPR BRL TEMP B QB			9
10																											10
11																											11
12																											12
13																											13
14																											14
15																											15

Y1

0 250 degC

TM830

TM831

TBFP A UPR BRL TEMP

A

Rev. No.	0	1	2					PROJECT Van Phong 1 BOT Thermal Power Plant Project 2×673MW	(TSQ B)			
DATE	2021/6/21	2021/12/15	2022/11/8									
CONTENTS	1st Issue	Revised (0007, 0008, 0015)	Revised & Tuning (0056, 0064, 0080)					TITLE	DRAWING No.	SH	REV. MARK	
								FIELD AI PROCESSING (38)	4GCH01007	TM137	2	
								Equipment No. : -				

	A	B	C	D	E	F	G	H	I	J	K	L	M	N	O	P	Q	R	S	T	U	V	W	X	Y	Z	AA	
	Line Name		From	LID	Logic Chart																	LID	To	Line Name				
1					10LAC10CT059xQ01 TBFP A LWR BRL TEMP A LOCAL RTD 0 250 degC IOAI-1 IO v AI Q 10LAC10CT059xQ01 TBFP A LWR BRL TEMP A LOCAL RTD 0 250 degC ALM2F 2H 1H C/0-H 1L C/0-L 2L QTY QTY S2H= 99999 T2H= 0 S1H= 99999 T1H= 0 S1L= -999999 T1L= 0 S2L= -999999 T2L= 0 degC S [S2H RESET= 99999degC] [S1H RESET= 99999degC]																		TM830 TM831	TBFP A LWR BRL TEMP A			1	
2																						Y1						2
3																												3
4																						11						4
5																												5
6																												6
7					10LAC10CT060xQ01 TBFP A LWR BRL TEMP B LOCAL RTD 0 250 degC IOAI-2 IO v AI Q 10LAC10CT060xQ01 TBFP A LWR BRL TEMP B LOCAL RTD 0 250 degC ALM2F 2H 1H C/0-H 1L C/0-L 2L QTY QTY S2H= 99999 T2H= 0 S1H= 99999 T1H= 0 S1L= -999999 T1L= 0 S2L= -999999 T2L= 0 degC S [S2H RESET= 99999degC] [S1H RESET= 99999degC]																		TM831	TBFP A LWR BRL TEMP B			7	
8																						Y2						8
9																						21						9
10																												10
11																												11
12																											12	
13																											13	
14																											14	
15																											15	

Y1

0 250 degC

TM830

TM831

TBFP A LWR BRL TEMP

A

Rev. No.	0	1	2	3				PROJECT	(TSQ B)			
DATE	2021/6/21	2021/12/15	2022/11/8	2023/7/5				Van Phong 1 BOT Thermal Power Plant Project 2×673MW				
CONTENTS	1st Issue	Revised (0008,0015)	Revised (0080)	Revised (0152)				TITLE	DRAWING No.	SH	REV. MARK	
								FIELD A1 PROCESSING (39)	4GCH01007	TM138	3	
								Equipment No. : -				

	A	B	C	D	E	F	G	H	I	J	K	L	M	N	O	P	Q	R	S	T	U	V	W	X	Y	Z	AA		
	Line Name		From	LID	Logic Chart																			LID	To	Line Name			
1																												1	
2					10LAC10CT061XQ01 TBFP A GBOX PP SIDE DE BRG TEMP LOCAL RTD 0 150 degC				IOAI-1 IO v AI Q																				2
3																													3
4																													4
5																													5
6																													6
7					10LAC10CT062XQ01 TBFP A GBOX PP SIDE NDE BRG TEMP LOCAL RTD 0 150 degC				IOAI-2 IO v AI Q																				7
8																													8
9																													9
10																													10
11																													11
12																													12
13																													13
14																													14
15																													15

Y1

0 150 degC

13

11

TBFP A GBOX PP SIDE

DE BRG TEMP

TBFP A GBOX PP SIDE

DE BRG TEMP HI HI

TBFP A GBOX PP SIDE

DE BRG TEMP QB

Rev. No.	0	1	2					PROJECT	(TSQ B)			
DATE	2021/6/21	2021/12/15	2022/11/8					Van Phong 1 BOT Thermal Power Plant Project 2×673MW				
CONTENTS	1st Issue	Revised (0008, 0015)	Revised & Tuning (0056, 0064)					TITLE	DRAWING No.	SH	REV. MARK	
								FIELD A1 PROCESSING (40)	4GCH01007	TM139	2	
								Equipment No. : -				

	A	B	C	D	E	F	G	H	I	J	K	L	M	N	O	P	Q	R	S	T	U	V	W	X	Y	Z	AA	
	Line Name		From	LID	Logic Chart																	LID	To	Line Name				
1																											1	
2																											2	
3																											3	
4																											4	
5																											5	
6																											6	
7																											7	
8																											8	
9																											9	
10																											10	
11																											11	
12																											12	
13																											13	
14																											14	
15																											15	

10LAC10CT063xQ01
TBFP A GB BSTR PP SI
DE DE BRG TEMP
LOCAL
RTD
0 150 degC

IOAI-1
IO V
AI Q

10LAC10CT063xQ01
TBFP A GB BSTR PP SI
DE DE BRG TEMP

ALM2F
2H
1H
C/O-H 1L
C/O-L 2L
QTY QTY

S2H= 115 T2H= 0
S1H= 108 T1H= 0
S1L= -999999 T1L= 0
S2L= -999999 T2L= 0
degC S

[S2H RESET= 110degC]
[S1H RESET= 100degC]

0 150 degC

Y1

13

11

TBFP A GB BSTR PP SI
DE DE BRG TEMP

TBFP A GB BSTR PP SI
DE DE BRG TEMP HI HI

TBFP A GB BSTR PP SI
DE DE BRG TEMP QB

10LAC10CT064xQ01
TBFP A GB BSTR PP SI
DE NDE BRG TEMP
LOCAL
RTD
0 150 degC

IOAI-2
IO V
AI Q

10LAC10CT064xQ01
TBFP A GB BSTR PP SI
DE NDE BRG TEMP

ALM2F
2H
1H
C/O-H 1L
C/O-L 2L
QTY QTY

S2H= 115 T2H= 0
S1H= 108 T1H= 0
S1L= -999999 T1L= 0
S2L= -999999 T2L= 0
degC S

[S2H RESET= 110degC]
[S1H RESET= 100degC]

0 150 degC

Y2

23

21

TBFP A GB BSTR PP SI
DE NDE BRG TEMP

TBFP A GB BSTR PP SI
DE NDE BRG TEM HI HI

TBFP A GB BSTR PP SI
DE NDE BRG TEMP QB

Rev. No.	0	1	2					PROJECT	(TSQ B)			
DATE	2021/6/21	2021/12/15	2022/11/8					Van Phong 1 BOT Thermal Power Plant Project 2×673MW				
CONTENTS	1st Issue	Revised (0008, 0015)	Revised & Tuning (0056, 0064)					TITLE	DRAWING No.	SH	REV. MARK	
								FIELD A1 PROCESSING (41)	4GCH01007	TM140	2	
								Equipment No. :	-			

	A	B	C	D	E	F	G	H	I	J	K	L	M	N	O	P	Q	R	S	T	U	V	W	X	Y	Z	AA	
	Line Name		From	LID	Logic Chart																	LID	To	Line Name				
1																											1	
2					10LAC10CT096XQ01 TBFP A BSTR PP RTN S L WTR DE TEMP LOCAL RTD 0 210 degC				IOAI-1 IO v AI q													10LAC10CT096XQ01 TBFP A BSTR PP RTN S L WTR DE TEMP ALM2F 2H 1H C/0-H 1L C/0-L 2L QTY QTY S2H= 90 T2H= 0 S1H= 80 T1H= 0 S1L= -999999 T1L= 0 S2L= -999999 T2L= 0 degC						

Y1

0 210 degC

13

11

TBFP A BSTR PP RTN S

L WTR DE TEMP

TBFP A BSTR PP RTN S

L WTR DE TEMP HI HI

TBFP A BSTR PP RTN S

L WTR DE TEMP QB

Rev. No.	0	1	2					PROJECT	(TSQ B)			
DATE	2021/6/21	2021/12/15	2022/11/8					Van Phong 1 BOT Thermal Power Plant Project 2×673MW				
CONTENTS	1st Issue	Revised (0008, 0015)	Revised & Tuning (0064)					TITLE	DRAWING No.	SH	REV. MARK	
								FIELD A1 PROCESSING (42)	4GCH01007	TM141	2	
								Equipment No. :	-			

	A	B	C	D	E	F	G	H	I	J	K	L	M	N	O	P	Q	R	S	T	U	V	W	X	Y	Z	AA			
	Line Name		From	LID	Logic Chart																		LID	To	Line Name					
1																											1			
2					10LAC10CT098xQ01 TBFP A RTN SL WTR ND E TEMP LOCAL RTD 0 210 degC	IOAI-1 IO V AI Q													10LAC10CT098xQ01 TBFP A RTN SL WTR ND E TEMP ALM2F 2H 1H C/0-H 1L C/0-L 2L QTY QTY S2H= 80 S1H= 70 S1L= -999999 S2L= -999999 degC [S2H RESET= 75degC] [S1H RESET= 65degC]	T2H= 0 T1H= 0 T1L= 0 T2L= 0 S	Y1 0 210 degC		TBFP A RTN SL WTR ND E TEMP	2						
3																							13		TBFP A RTN SL WTR ND E TEMP HI HI	3				
4																							11		TBFP A RTN SL WTR ND E TEMP QB	4				
5																													5	
6																													6	
7					10LAC10CT099xQ01 TBFP A RTN SL WTR DE TEMP LOCAL RTD 0 210 degC	IOAI-2 IO V AI Q													10LAC10CT099xQ01 TBFP A RTN SL WTR DE TEMP ALM2F 2H 1H C/0-H 1L C/0-L 2L QTY QTY S2H= 80 S1H= 70 S1L= -999999 S2L= -999999 degC [S2H RESET= 75degC] [S1H RESET= 65degC]	T2H= 0 T1H= 0 T1L= 0 T2L= 0 S	Y2 0 210 degC		TBFP A RTN SL WTR DE TEMP	7						
8																							23		TBFP A RTN SL WTR DE TEMP HI HI	8				
9																							21		TBFP A RTN SL WTR DE TEMP QB	9				
10																													10	
11																													11	
12					10LAC10CT095xQ01 TBFP A NOISE HOOD TE MP LOCAL RTD -30 300 degC	IOAI-3 IO V AI Q													10LAC10CT095xQ01 TBFP A NOISE HOOD TE MP ALM2F 2H 1H C/0-H 1L C/0-L 2L QTY QTY S2H= 999999 S1H= 55 S1L= -999999 S2L= -999999 degC [S2H RESET= 999999degC] [S1H RESET= 50degC]	T2H= 0 T1H= 0 T1L= 0 T2L= 0 S	Y3 -30 300 degC	TM851	TBFP A NOISE HOOD TE MP	12						
13																							33		TBFP A NOISE HOOD TE MP HI HI	13				
14																							31	TM851	TBFP A NOISE HOOD TE MP QB	14				
15																														15

Y1

0 210 degC

Rev. No.	0	1	2					PROJECT Van Phong 1 BOT Thermal Power Plant Project 2×673MW	(TSQ B)			
DATE	2021/6/21	2021/12/15	2022/11/8									
CONTENTS	1st Issue	Revised (0008, 0015, 0026)	Revised & Tuning (0045, 0056, 0064)						TITLE	DRAWING No.	SH	REV. MARK
								FIELD A1 PROCESSING (43)	4GCH01007	TM142	2	
								Equipment No. : -				

	A	B	C	D	E	F	G	H	I	J	K	L	M	N	O	P	Q	R	S	T	U	V	W	X	Y	Z	AA		
	Line Name			From	LID	Logic Chart																		LID	To	Line Name			
1																													1
2																													2
3																													3
4																													4
5																													5
6																													6
7																													7
8																													8
9																													9
10																													10
11																													11
12																													12
13																													13
14																													14
15																													15
	Rev. No.	0	1	2																			(TSQ B)						
	DATE	2021/6/21	2021/12/15	2022/11/8																									
	CONTENTS	1st Issue	Revised (0008,0015)	TUNING (0064)																			DRAWING No.		SH		REV. MARK		
																							4GCH01007		TM143		2		

TBFP B BSTR PP THRST

BRG TEMP

	A	B	C	D	E	F	G	H	I	J	K	L	M	N	O	P	Q	R	S	T	U	V	W	X	Y	Z	AA	
	Line Name		From	LID	Logic Chart																		LID	To	Line Name			
1																											1	
2					10LAC20CT054xQ01 10LAC20CT054xQ01 TBFP B NDE BRG TEMP LOCAL RTD 0 150 degC IOAI-1 IO V AI Q TBFP B NDE BRG TEMP ALM2F 2H 1H C/0-H 1L C/0-L 2L QTY QTY S2H= 100 S1H= 90 S1L= -999999 S2L= -999999 degC T2H= 0 T1H= 0 T1L= 0 T2L= 0 S [S2H RESET= 90degC] [S1H RESET= 80degC] 0 150 degC Y1																				TBFP B NDE BRG TEMP		2	
3																							13		TBFP B NDE BRG TEMP HI HI		3	
4																							11		TBFP B NDE BRG TEMP QB		4	
5																											5	
6																											6	
7					10LAC20CT055xQ01 10LAC20CT055xQ01 TBFP B THRST BRG TEM P LOCAL RTD 0 150 degC IOAI-2 IO V AI Q TBFP B THRST BRG TEM P ALM2F 2H 1H C/0-H 1L C/0-L 2L QTY QTY S2H= 100 S1H= 90 S1L= -999999 S2L= -999999 degC T2H= 0 T1H= 0 T1L= 0 T2L= 0 S [S2H RESET= 90degC] [S1H RESET= 80degC] 0 150 degC Y2																				TBFP B THRST BRG TEM P		7	
8																							23		TBFP B THRST BRG TEM P HI HI		8	
9																							21		TBFP B THRST BRG TEM P QB		9	
10																											10	
11																											11	
12					10LAC20CT056xQ01 10LAC20CT056xQ01 TBFP B DE BRG TEMP LOCAL RTD 0 150 degC IOAI-3 IO V AI Q TBFP B DE BRG TEMP ALM2F 2H 1H C/0-H 1L C/0-L 2L QTY QTY S2H= 100 S1H= 90 S1L= -999999 S2L= -999999 degC T2H= 0 T1H= 0 T1L= 0 T2L= 0 S [S2H RESET= 90degC] [S1H RESET= 80degC] 0 150 degC Y3																				TBFP B DE BRG TEMP		12	
13																							33		TBFP B DE BRG TEMP HI HI		13	
14																							31		TBFP B DE BRG TEMP QB		14	
15																											15	

Rev. No.	0	1	2	3				PROJECT	(TSQ B)			
DATE	2021/6/21	2021/12/15	2022/11/8	2023/7/5				Van Phong 1 BOT Thermal Power Plant Project 2×673MW				
CONTENTS	1st Issue	Revised (0008, 0015)	Revised & Tuning (0064)	Revised (0186)				TITLE	DRAWING No.	SH	REV. MARK	
								FIELD A1 PROCESSING (45)	4GCH01007	TM144	3	
								Equipment No. : -				

	A	B	C	D	E	F	G	H	I	J	K	L	M	N	O	P	Q	R	S	T	U	V	W	X	Y	Z	AA	
	Line Name		From	LID	Logic Chart																			LID	To	Line Name		
1																												1
2					10LAC20CT057xQ01 TBFP B UPR BRL TEMP A LOCAL RTD 0 250 degC	IOAI-1 IO v AI Q														10LAC20CT057xQ01 TBFP B UPR BRL TEMP A ALM2F 2H 1H C/0-H 1L C/0-L 2L QTY QTY S2H= 99999 T2H= 0 S1H= 90 T1H= 0 S1L= -999999 T1L= 0 S2L= -999999 T2L= 0 degC S [S1H RESET= 85degC]	Y1 0 250 degC	TM840 TM841	TBFP B UPR BRL TEMP A	2				
3																												3
4																								11	TM840	TBFP B UPR BRL TEMP A QB	4	
5																												5
6																												6
7					10LAC20CT058xQ01 TBFP B UPR BRL TEMP B LOCAL RTD 0 250 degC	IOAI-2 IO v AI Q														10LAC20CT058xQ01 TBFP B UPR BRL TEMP B ALM2F 2H 1H C/0-H 1L C/0-L 2L QTY QTY S2H= 99999 T2H= 0 S1H= 90 T1H= 0 S1L= -999999 T1L= 0 S2L= -999999 T2L= 0 degC S [S1H RESET= 85degC]	Y2 0 250 degC	TM840 TM841	TBFP B UPR BRL TEMP B	7				
8																												8
9																								21	TM840	TBFP B UPR BRL TEMP B QB	9	
10																												10
11																												11
12																												12
13																												13
14																												14
15																												15

Y1

0 250 degC

TM840

TM841

TBFP B UPR BRL TEMP

A

Rev. No.	0	1	2					PROJECT	(TSQ B)			
DATE	2021/6/21	2021/12/15	2022/11/8					Van Phong 1 BOT Thermal Power Plant Project 2×673MW				
CONTENTS	1st Issue	Revised (0008, 0015)	Revised & Tuning (0056, 0064, 0080)					TITLE	DRAWING No.	SH	REV. MARK	
								FIELD A1 PROCESSING (46)	4GCH01007	TM145	2	
								Equipment No. : -				

	A	B	C	D	E	F	G	H	I	J	K	L	M	N	O	P	Q	R	S	T	U	V	W	X	Y	Z	AA	
	Line Name		From	LID	Logic Chart																			LID	To	Line Name		
1																												1
2					10LAC20CT059XQ01 TBFP B LWR BRL TEMP A LOCAL RTD 0 250 degC IOAI-1 IO v AI q 10LAC20CT059XQ01 TBFP B LWR BRL TEMP A LOCAL RTD 0 250 degC ALM2F 2H 1H C/0-H 1L C/0-L 2L QTY QTY S2H= 99999 T2H= 0 S1H= 99999 T1H= 0 S1L= -999999 T1L= 0 S2L= -999999 T2L= 0 degC S [S2H RESET= 99999degC] [S1H RESET= 99999degC]																			Y1	TM840 TM841	TBFP B LWR BRL TEMP A	2	
3																												3
4																								11	TM840	TBFP B LWR BRL TEMP A QB	4	
5																												5
6																												6
7					10LAC20CT060XQ01 TBFP B LWR BRL TEMP B LOCAL RTD 0 250 degC IOAI-2 IO v AI q 10LAC20CT060XQ01 TBFP B LWR BRL TEMP B LOCAL RTD 0 250 degC ALM2F 2H 1H C/0-H 1L C/0-L 2L QTY QTY S2H= 99999 T2H= 0 S1H= 99999 T1H= 0 S1L= -999999 T1L= 0 S2L= -999999 T2L= 0 degC S [S2H RESET= 99999degC] [S1H RESET= 99999degC]																			Y2	TM841	TBFP B LWR BRL TEMP B	7	
8																												8
9																								21		TBFP B LWR BRL TEMP B QB	9	
10																												10
11																												11
12																												12
13																												13
14																												14
15																												15

Y1

0 250 degC

TM840

TM841

TBFP B LWR BRL TEMP

A

Rev. No.	0	1	2	3				PROJECT	(TSQ B)			
DATE	2021/6/21	2021/12/15	2022/11/8	2023/7/5				Van Phong 1 BOT Thermal Power Plant Project 2×673MW				
CONTENTS	1st Issue	Revised (0008, 0015)	Revised (0080)	Revised (0152)				TITLE	DRAWING No.	SH	REV. MARK	
								FIELD A1 PROCESSING (47)	4GCH01007	TM146	3	
								Equipment No. : -				

	A	B	C	D	E	F	G	H	I	J	K	L	M	N	O	P	Q	R	S	T	U	V	W	X	Y	Z	AA	
	Line Name			From	LID	Logic Chart																	LID	To	Line Name			
1																												1
2																												2
3																												3
4																												4
5																												5
6																												6
7																												7
8																												8
9																												9
10																												10
11																												11
12																												12
13																												13
14																												14
15																												15

Y1

0 150 degC

13

11

2 TBFP B GBOX PP SID D | E BRG TEMP | | | 2 || 3 | TBFP B GBOX PP SID D | | | 3 |
4																											E BRG TEMP HI HI			4
5																											TBFP B GBOX PP SID D			5
6																											E BRG TEMP QB			6
7						10LAC20CT062xQ01 TBFP B GBOX PP SID N DE BRG TEMP LOCAL RTD 0 150 degC IOAI-2 IO V AI Q 10LAC20CT062xQ01 TBFP B GBOX PP SID N DE BRG TEMP LOCAL RTD 0 150 degC ALM2F 2H 1H C/O-H 1L C/O-L 2L QTY QTY S2H= 115 S1H= 108 S1L= -999999 S2L= -999999 degC S T2H= 0 T1H= 0 T1L= 0 T2L= 0 [S2H RESET= 110degC] [S1H RESET= 100degC]																								

Y2

0 150 degC

23

21

7 TBFP B GBOX PP SID N | DE BRG TEMP | | | 7 || 8 | TBFP B GBOX PP SID N | | | 8 |
9																											DE BRG TEMP HI HI			9
10																											TBFP B GBOX PP SID N			10
11																											DE BRG TEMP QB			11
12																														12
13																														13
14																														14
15																														15

Rev. No.	0	1	2					PROJECT	(TSQ B)			
DATE	2021/6/21	2021/12/15	2022/11/8					Van Phong 1 BOT Thermal Power Plant Project 2×673MW				
CONTENTS	1st Issue	Revised (0008, 0015, 0026)	Revised & Tuning (0056, 0064)					TITLE	DRAWING No.	SH	REV. MARK	
								FIELD A1 PROCESSING (48)	4GCH01007	TM147	2	
								Equipment No. : -				

	A	B	C	D	E	F	G	H	I	J	K	L	M	N	O	P	Q	R	S	T	U	V	W	X	Y	Z	AA								
	Line Name			From	LID	Logic Chart																			LID	To	Line Name								
1																														1					
2						10LAC20CT096xQ01 TBFP B BSTR PP RTN S L WTR DE TEMP LOCAL RTD 0 210 degC IOAI-1 IO v AI q 10LAC20CT096xQ01 TBFP B BSTR PP RTN S L WTR DE TEMP LOCAL RTD 0 210 degC IOAI-1 IO v AI q ALM2F 2H 1H C/O-H 1L C/O-L 2L QTY QTY S2H= 90 S1H= 80 S1L= -999999 S2L= -999999 degC [S2H RESET= 85degC] [S1H RESET= 75degC] T2H= 0 T1H= 0 T1L= 0 T2L= 0 S 0 210 degC																								Y1		TBFP B BSTR PP RTN S L WTR DE TEMP			2
3																									13		TBFP B BSTR PP RTN S L WTR DE TEMP HI HI			3					
4																									11		TBFP B BSTR PP RTN S L WTR DE TEMP QB			4					
5																															5				
6																															6				
7						10LAC20CT097xQ01 TBFP B BSTR PP RTN S L WTR NDE TEMP LOCAL RTD 0 210 degC IOAI-2 IO v AI q 10LAC20CT097xQ01 TBFP B BSTR PP RTN S L WTR NDE TEMP LOCAL RTD 0 210 degC IOAI-2 IO v AI q ALM2F 2H 1H C/O-H 1L C/O-L 2L QTY QTY S2H= 90 S1H= 80 S1L= -999999 S2L= -999999 degC [S2H RESET= 85degC] [S1H RESET= 75degC] T2H= 0 T1H= 0 T1L= 0 T2L= 0 S 0 210 degC																									Y2		TBFP B BSTR PP RTN S L WTR NDE TEMP		
8																									23		TBFP B BSTR PP RTN S L WTR NDE TEMP HI HI			8					
9																									21		TBFP B BSTR PP RTN S L WTR NDE TEMP QB			9					
10																															10				
11																															11				
12																															12				
13																															13				
14																															14				
15																															15				

Rev. No.	0	1	2					PROJECT	(TSQ B)			
DATE	2021/6/21	2021/12/15	2022/11/8					Van Phong 1 BOT Thermal Power Plant Project 2×673MW				
CONTENTS	1st Issue	Revised (0008, 0015)	Revised & Tuning (0056, 0064)					TITLE	DRAWING No.	SH	REV. MARK	
								FIELD A1 PROCESSING (50)	4GCH01007	TM149	2	
								Equipment No. : -				

	A	B	C	D	E	F	G	H	I	J	K	L	M	N	O	P	Q	R	S	T	U	V	W	X	Y	Z	AA						
	Line Name		From	LID	Logic Chart																		LID	To	Line Name								
1																											1						
2					10LAC20CT099xQ01 TBFP B RTN SL WTR DE TEMP LOCAL RTD 0 210 degC	IOAI-1 IO V AI Q												10LAC20CT099XQ01 TBFP B RTN SL WTR DE TEMP ALM2F 2H 1H C/0-H 1L C/0-L 2L QTY QTY S2H= 80 S1H= 70 S1L= -999999 S2L= -999999 degC [S2H RESET= 75degC] [S1H RESET= 65degC]	T2H= 0 T1H= 0 T1L= 0 T2L= 0 S	Y1 0 210 degC		TBFP B RTN SL WTR DE TEMP	2										
3																				13			TBFP B RTN SL WTR DE TEMP HI HI	3									
4																				11			TBFP B RTN SL WTR DE TEMP QB	4									
5																																	5
6																																	6
7					10LAC20CT098xQ01 TBFP B RTN SL WTR ND E TEMP LOCAL RTD 0 210 degC	IOAI-2 IO V AI Q												10LAC20CT098XQ01 TBFP B RTN SL WTR ND E TEMP ALM2F 2H 1H C/0-H 1L C/0-L 2L QTY QTY S2H= 80 S1H= 70 S1L= -999999 S2L= -999999 degC [S2H RESET= 75degC] [S1H RESET= 65degC]	T2H= 0 T1H= 0 T1L= 0 T2L= 0 S	Y2 0 210 degC		TBFP B RTN SL WTR ND E TEMP	7										
8																				23			TBFP B RTN SL WTR ND E TEMP HI HI	8									
9																				21			TBFP B RTN SL WTR ND E TEMP QB	9									
10																																	10
11																																	11
12					10LAC20CT095xQ01 TBFP B NOISE HOOD TE MP LOCAL RTD -30 300 degC	IOAI-3 IO V AI Q												10LAC20CT095XQ01 TBFP B NOISE HOOD TE MP ALM2F 2H 1H C/0-H 1L C/0-L 2L QTY QTY S2H= 999999 S1H= 55 S1L= -999999 S2L= -999999 degC [S2H RESET= 999999degC] [S1H RESET= 50degC]	T2H= 0 T1H= 0 T1L= 0 T2L= 0 S	Y3 -30 300 degC	TM861	TBFP B NOISE HOOD TE MP	12										
13																				33			TBFP B NOISE HOOD TE MP HI HI	13									
14																				31	TM861		TBFP B NOISE HOOD TE MP QB	14									
15																																	15

Y1

0 210 degC

13

11

2 | TBFP B RTN SL WTR DE | | TEMP | 2 || 3 | TBFP B RTN SL WTR DE | | TEMP HI HI | 3 |
4																									TBFP B RTN SL WTR DE		TEMP QB	4
5																												5
6																												6
7					10LAC20CT098xQ01 TBFP B RTN SL WTR ND E TEMP LOCAL RTD 0 210 degC IOAI-2 IO V AI Q 10LAC20CT098xQ01 TBFP B RTN SL WTR ND E TEMP LOCAL RTD 0 210 degC ALM2F 2H 1H C/0-H 1L C/0-L 2L QTY QTY S2H= 80 S1H= 70 S1L= -999999 S2L= -999999 degC T2H= 0 T1H= 0 T1L= 0 T2L= 0 S [S2H RESET= 75degC] [S1H RESET= 65degC]																							

Y2

0 210 degC

23

21

7 | TBFP B RTN SL WTR ND | | E TEMP | 7 || 8 | TBFP B RTN SL WTR ND | | E TEMP HI HI | 8 |
9																									TBFP B RTN SL WTR ND		E TEMP QB	9
10																												10
11																												11
12					10LAC20CT095xQ01 TBFP B NOISE HOOD TE MP LOCAL RTD -30 300 degC IOAI-3 IO V AI Q 10LAC20CT095xQ01 TBFP B NOISE HOOD TE MP LOCAL RTD -30 300 degC ALM2F 2H 1H C/0-H 1L C/0-L 2L QTY QTY S2H= 999999 S1H= 55 S1L= -999999 S2L= -999999 degC T2H= 0 T1H= 0 T1L= 0 T2L= 0 S [S2H RESET= 999999degC] [S1H RESET= 50degC]																							

Y3

-30 300 degC

33

31

12 | TM861 | TBFP B NOISE HOOD TE | | MP | 12 || 13 | TBFP B NOISE HOOD TE | | MP HI HI | 13 |
| 14 | TM861 | TBFP B NOISE HOOD TE | | MP QB | 14 |
| 15 | 15 |

Rev. No.	0	1	2					PROJECT Van Phong 1 BOT Thermal Power Plant Project 2×673MW	(TSQ B)			
DATE	2021/6/21	2021/12/15	2022/11/8									
CONTENTS	1st Issue	Revised (0008, 0015)	Revised & Tuning (0045, 0056, 0064)						TITLE	DRAWING No.	SH	REV. MARK
								FIELD A1 PROCESSING (51)	4GCH01007	TM150	2	
								Equipment No. : -				

	A	B	C	D	E	F	G	H	I	J	K	L	M	N	O	P	Q	R	S	T	U	V	W	X	Y	Z	AA
	Line Name			From	LID	Logic Chart																	LID	To	Line Name		
1																											
2																											
3																											
10XAA10CT051XQ01
BFPT A 1ST STAGE SHE
LL TEMP
LOCAL
mV(TYPE-E)
0 450 degC

IOAI-3
IO V
AI Q

10XAA10CT051XQ01
BFPT A 1ST STAGE SHE
LL TEMP

ALM2F
2H
1H
C/O-H 1L
C/O-L 2L
QTY QTY

0 450 degC

Y3

BFPT A 1ST STAGE SHE
LL TEMP

[S2H RESET= 99999degC]
[S1H RESET= 99999degC]

S2H= 99999 T2H= 0
S1H= 99999 T1H= 0
S1L= -99999 T1L= 0
S2L= -99999 T2L= 0
degC S

31

BFPT A 1ST STAGE SHE
LL TEMP QB

10XAA20CT051XQ01
BFPT B 1ST STAGE SHE
LL TEMP
LOCAL
mV(TYPE-E)
0 450 degC

IOAI-4
IO V
AI Q

10XAA20CT051XQ01
BFPT B 1ST STAGE SHE
LL TEMP

ALM2F
2H
1H
C/O-H 1L
C/O-L 2L
QTY QTY

0 450 degC

Y4

BFPT B 1ST STAGE SHE
LL TEMP

[S2H RESET= 99999degC]
[S1H RESET= 99999degC]

S2H= 99999 T2H= 0
S1H= 99999 T1H= 0
S1L= -99999 T1L= 0
S2L= -99999 T2L= 0
degC S

41

BFPT B 1ST STAGE SHE
LL TEMP QB

Rev. No.	0	1	3					PROJECT	(TSQ B)			
DATE	2021/6/21	2021/12/15	2023/7/5					Van Phong 1 BOT Thermal Power Plant Project 2×673MW				
CONTENTS	1st Issue	Revised (0008, 0015)	Revised (0137, 0143)					TITLE	DRAWING No.	SH	REV. MARK	
								FIELD AI PROCESSING (52)	4GCH01007	TM151	3	
								Equipment No. : -				

	A	B	C	D	E	F	G	H	I	J	K	L	M	N	O	P	Q	R	S	T	U	V	W	X	Y	Z	AA		
	Line Name			From	LID	Logic Chart																		LID	To	Line Name			
1																												1	
2																												2	
3																												3	
4																												4	
5																												5	
6																												6	
7																												7	
8																												8	
9																												9	
10																												10	
11																												11	
12																												12	
13																												13	
14																												14	
15																												15	
	Rev. No.		0		1												PROJECT		(TSQ B)										
	DATE		2021/6/21		2021/12/15												Van Phong 1 BOT Thermal Power Plant Project 2×673MW												
	CONTENTS		1st Issue		Revised (0008,0015)												TITLE		DRAWING No.					SH		REV. MARK			
																	FIELD AI PROCESSING (53)		4GCH01007					TM152		1			
																	Equipment No. : -												

	A	B	C	D	E	F	G	H	I	J	K	L	M	N	O	P	Q	R	S	T	U	V	W	X	Y	Z	AA		
	Line Name			From	LID	Logic Chart																		LID	To	Line Name			
1																													1
2																													2
3																													3
4																													4
5																													5
6																													6
7																													7
8																													8
9																													9
10																													10
11																													11
12																													12
13																													13
14																													14
15																													15
	Rev. No.		0		1												PROJECT		(TSQ B)										
	DATE		2021/6/21		2021/12/15												Van Phong 1 BOT Thermal Power Plant Project 2×673MW												
	CONTENTS		1st Issue		Revised (0008,0015)												TITLE		DRAWING No.					SH		REV. MARK			
																	FIELD AI PROCESSING (54)		4GCH01007					TM153		1			
																	Equipment No. : -												

Y1

0 150 degC

2 BFPT B THRBRG MTL TE | | MP (R-L) | || 3 | 11 | | BFPT B THRBRG MTL TE | | 3 |
| 4 | MP (R-L) QB | | 4 |
| 5 | | | | | 10XAD20CT015XQ01 BFPT B THRBRG MTL TE MP (R-R) LOCAL mV(TYPE-E) 0 150 degC IOAI-2 IO V AI Q |

10XAD20CT015XQ01

BFPT B THRBRG MTL TE

MP (R-R)

LOCAL

mV(TYPE-E)

0 150 degC

ALM2F

2H

1H

C/O-H 1L

C/O-L 2L

QTY QTY

[S2H RESET= 99999degC]

[S1H RESET= 99999degC]

S2H= 99999

S1H= 99999

S1L= -999999

S2L= -999999

T2H= 0

T1H= 0

T1L= 0

T2L= 0

degC

S

Y2

0 150 degC

5 BFPT B THRBRG MTL TE | | MP (R-R) | || 6 | 21 | | BFPT B THRBRG MTL TE | | 6 |
| 7 | MP (R-R) QB | | 7 |
| 8 | | | | | 10XAD20CT020XQ01 BFPT B THRBRG MTL TE MP (F-L) LOCAL mV(TYPE-E) 0 150 degC IOAI-3 IO V AI Q |

10XAD20CT020XQ01

BFPT B THRBRG MTL TE

MP (F-L)

LOCAL

mV(TYPE-E)

0 150 degC

ALM2F

2H

1H

C/O-H 1L

C/O-L 2L

QTY QTY

[S2H RESET= 99999degC]

[S1H RESET= 99999degC]

S2H= 99999

S1H= 99999

S1L= -999999

S2L= -999999

T2H= 0

T1H= 0

T1L= 0

T2L= 0

degC

S

Y3

0 150 degC

8 BFPT B THRBRG MTL TE | | MP (F-L) | || 9 | 31 | | BFPT B THRBRG MTL TE | | 9 |
10																									MP (F-L) QB		10
11																											11
12					10XAD20CT019XQ01 BFPT B THRBRG MTL TE MP (F-R) LOCAL mV(TYPE-E) 0 150 degC IOAI-4 IO V AI Q																						

10XAD20CT019XQ01

BFPT B THRBRG MTL TE

MP (F-R)

LOCAL

mV(TYPE-E)

0 150 degC

ALM2F

2H

1H

C/O-H 1L

C/O-L 2L

QTY QTY

[S2H RESET= 99999degC]

[S1H RESET= 99999degC]

S2H= 99999

S1H= 99999

S1L= -999999

S2L= -999999

T2H= 0

T1H= 0

T1L= 0

T2L= 0

degC

S

Y4

0 150 degC

12 BFPT B THRBRG MTL TE | | MP (F-R) | || 13 | 41 | | BFPT B THRBRG MTL TE | | 13 |
14																									MP (F-R) QB		14			
15																											15			
Rev. No.		0	1														PROJECT				(TSQ B)									
DATE		2021/6/21	2021/12/15														Van Phong 1 BOT Thermal													
																	Power Plant Project 2×673MW													
CONTENTS		1st Issue	Revised (0008,0015)														TITLE				DRAWING No.				SH		REV. MARK			
																	FIELD AI PROCESSING (54)				4GCH01007				TM153		1			
																	Equipment No. : -													

	A	B	C	D	E	F	G	H	I	J	K	L	M	N	O	P	Q	R	S	T	U	V	W	X	Y	Z	AA			
	Line Name		From	LID	Logic Chart																		LID	To	Line Name					
1																											1			
2					10XAV10CT005XQ01 BFPT A OIL TNK TEMP LOCAL mV(TYPE-E) 0 100 degC IOAI-1 IO v AI q																		10XAV10CT005XQ01 BFPT A OIL TNK TEMP ALM2F 2H 1H C/O-H 1L C/O-L 2L QTY QTY [S2H RESET= 99999degC] [S1H RESET= 99999degC] S2H= 99999 S1H= 99999 S1L= -999999 S2L= -999999 T2H= 0 T1H= 0 T1L= 0 T2L= 0 S degC 0 100 degC		Y1		BFPT A OIL TNK TEMP		2	
3																							11		BFPT A OIL TNK TEMP QB		3			
4																											4			
5					10XAV15CT005XQ01 BFPT A OIL CLR OTL L UBE OIL TEMP A LOCAL mV(TYPE-E) 0 100 degC IOAI-2 IO v AI q																		10XAV15CT005XQ01 BFPT A OIL CLR OTL L UBE OIL TEMP A ADL QTY QTY 0 100 degC		Y2	TM190	BFPT A OIL CLR OTL L UBE OIL TEMP A		5	
6																							21	TM190	BFPT A OIL CLR OTL L UBE OIL TEMP A QB		6			
7					10XAV15CT010XQ01 BFPT A OIL CLR OTL L UBE OIL TEMP B LOCAL mV(TYPE-E) 0 100 degC IOAI-3 IO v AI q																		10XAV15CT010XQ01 BFPT A OIL CLR OTL L UBE OIL TEMP B ADL QTY QTY 0 100 degC		Y3	TM190	BFPT A OIL CLR OTL L UBE OIL TEMP B		7	
8																							31	TM190	BFPT A OIL CLR OTL L UBE OIL TEMP B QB		8			
9					10XAV20CT005XQ01 BFPT B OIL TNK TEMP LOCAL mV(TYPE-E) 0 100 degC IOAI-4 IO v AI q																		10XAV20CT005XQ01 BFPT B OIL TNK TEMP ALM2F 2H 1H C/O-H 1L C/O-L 2L QTY QTY [S2H RESET= 99999degC] [S1H RESET= 99999degC] S2H= 99999 S1H= 99999 S1L= -999999 S2L= -999999 T2H= 0 T1H= 0 T1L= 0 T2L= 0 S degC 0 100 degC		Y4		BFPT B OIL TNK TEMP		9	
10																							41		BFPT B OIL RESVR TEM P QB		10			
11																											11			
12					10XAV25CT005XQ01 BFPT B OIL CLR OTL L UBE OIL TEMP A LOCAL mV(TYPE-E) 0 100 degC IOAI-5 IO v AI q																		10XAV25CT005XQ01 BFPT B OIL CLR OTL L UBE OIL TEMP A ADL QTY QTY 0 100 degC		Y5	TM191	BFPT B OIL CLR OTL L UBE OIL TEMP A		12	
13																							51	TM191	BFPT B OIL CLR OTL L UBE OIL TEMP A QB		13			
14					10XAV25CT010XQ01 BFPT B OIL CLR OTL L UBE OIL TEMP B LOCAL mV(TYPE-E) 0-100degC IOAI-6 IO v AI q																		10XAV25CT010XQ01 BFPT B OIL CLR OTL L UBE OIL TEMP B ADL QTY QTY 0 100 degC		Y6	TM191	BFPT B OIL CLR OTL L UBE OIL TEMP B		14	
15																							61	TM191	BFPT B OIL CLR OTL L UBE OIL TEMP B QB		15			
	Rev. No.	0	1														PROJECT				(TSQ B)									
	DATE	2021/6/21	2021/12/15														Van Phong 1 BOT Thermal Power Plant Project 2×673MW													
	CONTENTS	1st Issue	Revised (0008, 0015)														TITLE				DRAWING No.				SH		REV. MARK			
																	FIELD AI PROCESSING (55)				4GCH01007				TM154		1			
																	Equipment No. : -													

	A	B	C	D	E	F	G	H	I	J	K	L	M	N	O	P	Q	R	S	T	U	V	W	X	Y	Z	AA	
	Line Name		From	LID	Logic Chart																	LID	To	Line Name				
1																										1		
2					10XAV16CT010XQ01 BFPT A THRBRG OIL DR N TEMP LOCAL mV(TYPE-E) 0 -100 degC IOAI-1 IO V AI Q 10XAV16CT010XQ01 BFPT A THRBRG OIL DR N TEMP LOCAL mV(TYPE-E) 0 -100 degC ALM2F 2H 1H C/0-H 1L C/0-L 2L QTY QTY S2H= 99999 T2H= 0 S1H= 82 T1H= 0 S1L= -999999 T1L= 0 S2L= -999999 T2L= 0 degC S [S1H RESET= 82degC]																							

Y1


0 100 degC

	A	B	C	D	E	F	G	H	I	J	K	L	M	N	O	P	Q	R	S	T	U	V	W	X	Y	Z	AA	
	Line Name		From	LID	Logic Chart																		LID	To	Line Name			
1																											1	
2					10XAV26CT010XQ01 BFPT B THRBRG OIL DR N TEMP LOCAL mV(TYPE-E) 0 100 degC IOAI-1 IO V AI Q 10XAV26CT010XQ01 BFPT B THRBRG OIL DR N TEMP ALM2F 2H 1H C/0-H 1L C/0-L 2L QTY QTY S2H= 99999 T2H= 0 S1H= 82 T1H= 0 S1L= -999999 T1L= 0 S2L= -999999 T2L= 0 degC S [S1H RESET= 82degC]																							

Y1

0 100 degC

	A	B	C	D	E	F	G	H	I	J	K	L	M	N	O	P	Q	R	S	T	U	V	W	X	Y	Z	AA						
	Line Name		From	LID	Logic Chart																												
1																													1				
2					10LAB11CT051XQ01 TBFP A BSTR PP I/L W TR TEMP LOCAL mV(TYPE-E) 0 300 degC IOAI-1 IO V AI Q ADL QTY QTY 0 300 degC Y1																										2		
3																														3			
4					10LAB15CT051XQ01 TBFP A I/L WTR TEMP LOCAL mV(TYPE-E) 0 300 degC IOAI-2 IO V AI Q ADL QTY QTY 0 300 degC Y2																										4		
5																														5			
6					10LAB31CT051XQ01 TBFP A OTL WTR TEMP LOCAL mV(TYPE-E) 0 300 degC IOAI-3 IO V AI Q ADL QTY QTY 0 300 degC Y3																											6	
7																														7			
8					10LAB12CT051XQ01 TBFP B BSTR PP I/L W TR TEMP LOCAL mV(TYPE-E) 0 300 degC IOAI-4 IO V AI Q ADL QTY QTY 0 300 degC Y4																											8	
9																														9			
10					10LAB16CT051XQ01 TBFP B I/L WTR TEMP LOCAL mV(TYPE-E) 0 300 degC IOAI-5 IO V AI Q ADL QTY QTY 0 300 degC Y5																											10	
11																														11			
12					10LAB32CT051XQ01 TBFP B OTL WTR TEMP LOCAL mV(TYPE-E) 0 300 degC IOAI-6 IO V AI Q ADL QTY QTY 0 300 degC Y6																												12
13																														13			
14																														14			
15																														15			
Rev. No.		0	1	3													PROJECT				(TSQ B)												
DATE		2021/6/21	2021/12/15	2023/7/5													Van Phong 1 BOT Thermal																
																	Power Plant Project 2×673MW																
CONTENTS		1st Issue	Revised (0007,0008, 0015)	Revised (0166)													TITLE				DRAWING No.				SH		REV. MARK						
																	FIELD AI PROCESSING (59)				4GCH01007				TM158		3						
																	Equipment No. : -																

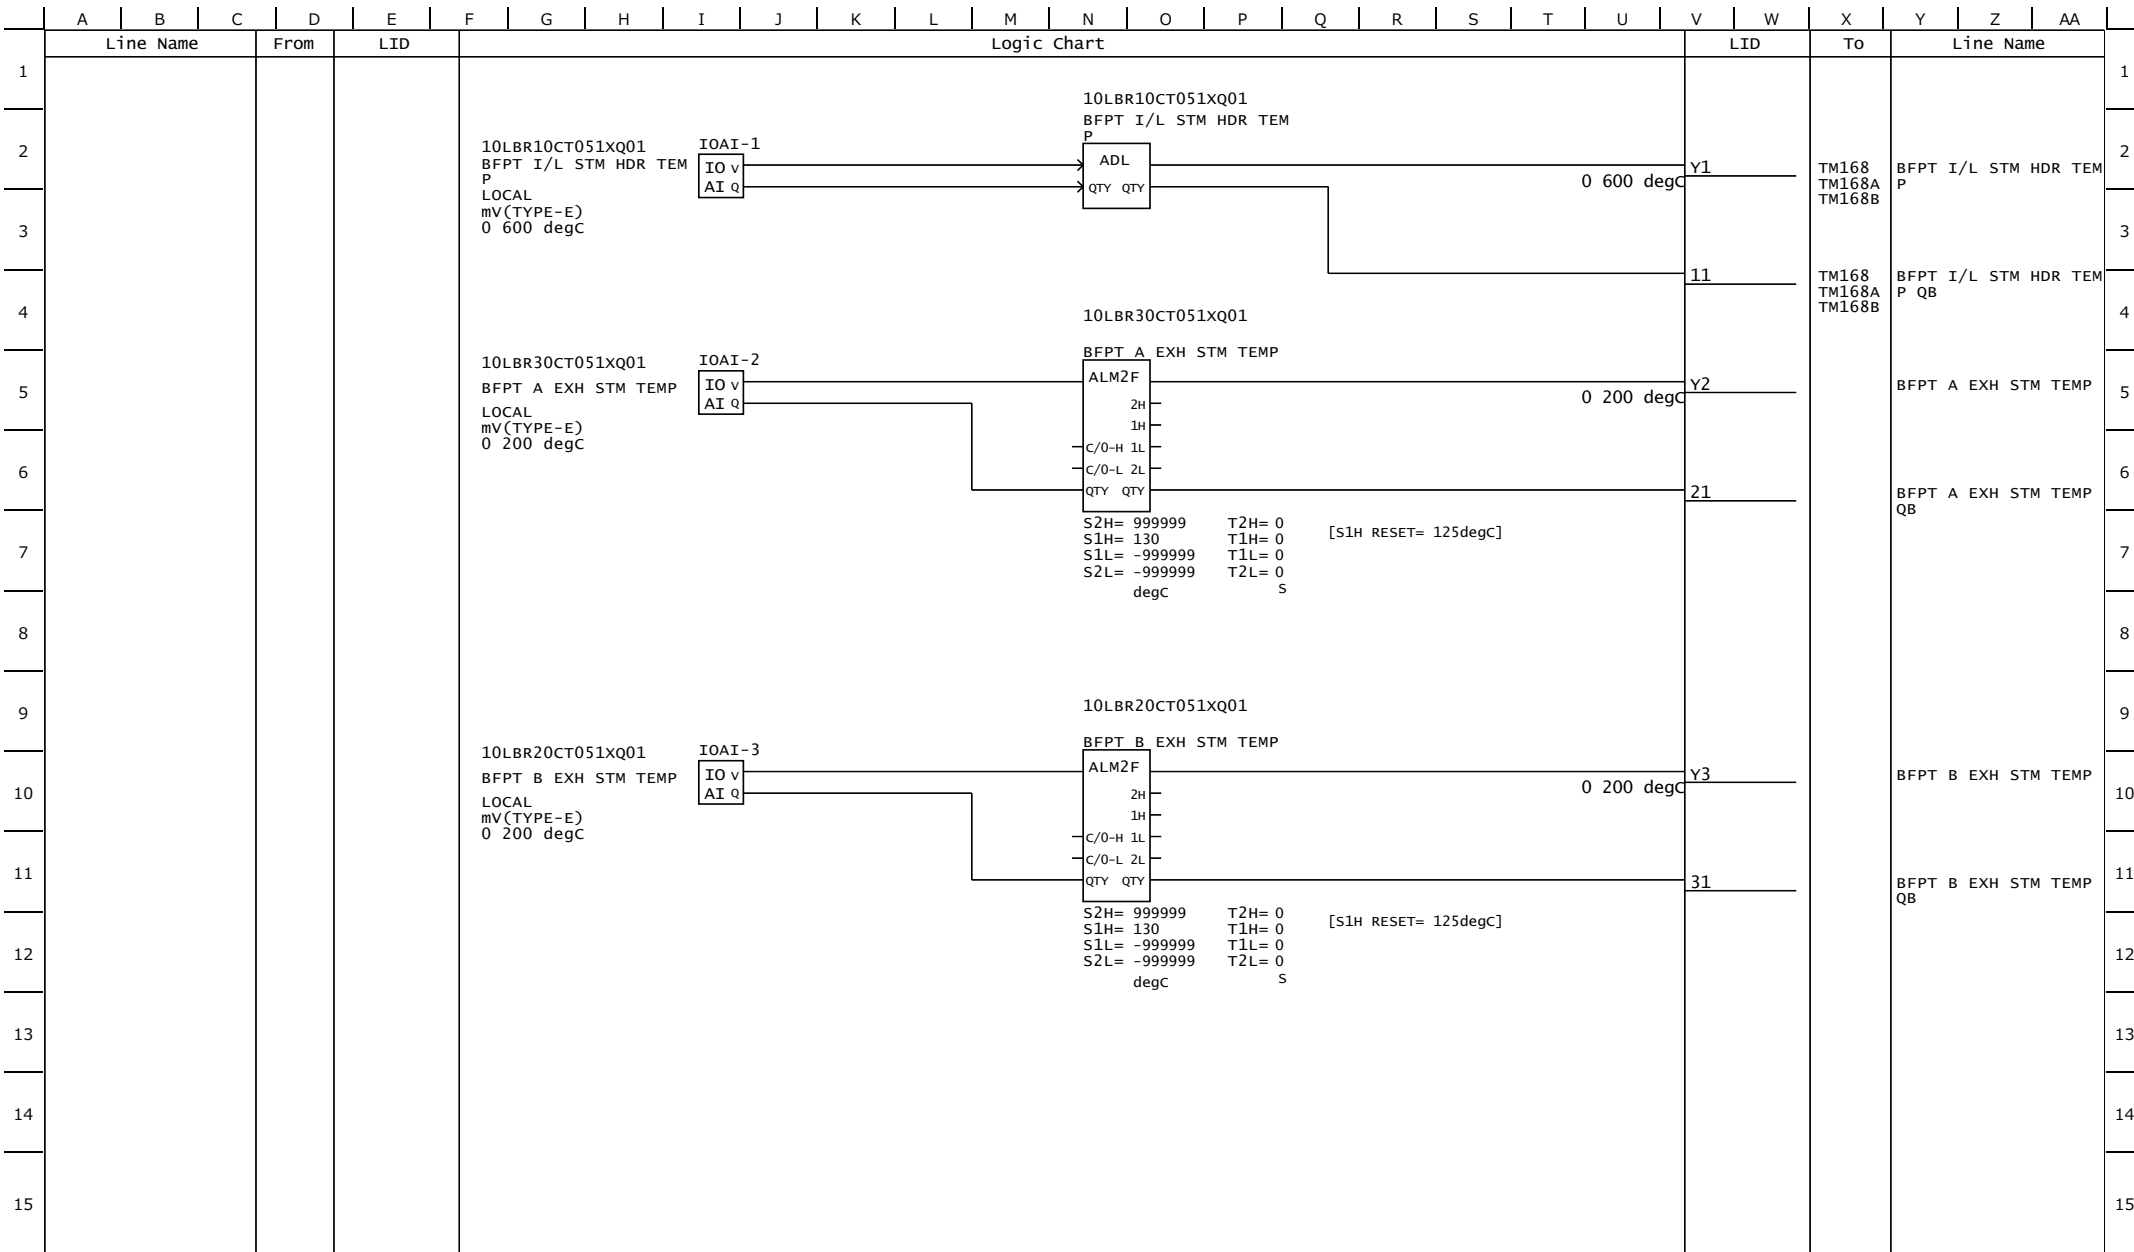

Rev. No.	0	1	2	3				PROJECT	(TSQ B)			
DATE	2021/6/21	2021/12/15	2022/11/8	2023/7/5				Van Phong 1 BOT Thermal Power Plant Project 2×673MW				
CONTENTS	1st Issue	Revised (0007, 0008, 0015)	TUNING (0056, 0064)	Revised (0166)				TITLE	DRAWING No.	SH	REV. MARK	
								FIELD A1 PROCESSING (60)	4GCH01007	TM159	3	
								Equipment No. : -				

	A	B	C	D	E	F	G	H	I	J	K	L	M	N	O	P	Q	R	S	T	U	V	W	X	Y	Z	AA						
	Line Name			From	LID	Logic Chart																	LID	To	Line Name								
1																												1					
2																												2					
3																												3					
4																												4					
5																												5					
6																												6					
7																												7					
8																												8					
9																												9					
10																												10					
11																												11					
12																												12					
13																												13					
14																												14					
15																												15					
Rev. No.						0		1																		PROJECT		(TSQ B)					
DATE						2021/6/21		2021/12/15																		Van Phong 1 BOT Thermal		Power Plant Project 2×673MW					
CONTENTS						1st Issue		Revised (0015)																		TITLE		DRAWING No.		SH		REV. MARK	
																										FIELD AI PROCESSING (61)		4GCH01007		TM160		1	
																										Equipment No. :		-					

Y1

TM193

BFPT A OVRSPD A

2
3																						11	TM193	BFPT A OVRSPD A QB			3
4																											4
5					10LAY10CS005XQ01 10LAY10CS005XQ01 BFPT A OVRSPD B TSQ B PULSE 0-100-120% (0-6000-7200rpm) (TM508) IOAI-2 IO V AI Q Fx-2 F(X) BFPT A OVRSPD B ADL QTY QTY 0 7200 rpm																						

Y2

TM193

BFPT A OVRSPD B

5
6																						21	TM193	BFPT A OVRSPD B QB			6
7																											7
8					10LAY10CS006XQ01 10LAY10CS006XQ01 BFPT A OVRSPD C TSQ B PULSE 0-100-120% (0-6000-7200rpm) (TM508) IOAI-3 IO V AI Q Fx-3 F(X) BFPT A OVRSPD C ADL QTY QTY 0 7200 rpm																						

Y3

TM193

BFPT A OVRSPD C

9
9																						31	TM193	BFPT A OVRSPD C QB			10
10																											10
11																											11
12					BFPT A OVRSPD A TM160 Fx-1 7200 rmp 0 % 120 BFPT A OVRSPD A TM160 Fx-1 X Y % rmp 1 0 0 2 100 6000 3 120 7200 BFPT A OVRSPD B TM160 Fx-2 7200 rmp 0 % 120 BFPT A OVRSPD B TM160 Fx-2 X Y % rmp 1 0 0 2 100 6000 3 120 7200 BFPT A OVRSPD C TM160 Fx-3 7200 rmp 0 % 120 BFPT A OVRSPD C TM160 Fx-3 X Y % rmp 1 0 0 2 100 6000 3 120 7200																						
12																											
13																											13
14																											14
15																											15
Rev. No.		0	1																			PROJECT			(TSQ B)		
DATE		2021/6/21	2021/12/15																			Van Phong 1 BOT Thermal					
																						Power Plant Project 2×673MW					
CONTENTS		1st Issue	Revised (0015)																			TITLE			DRAWING No.		
																						FIELD AI PROCESSING (61)			SH		
																						Equipment No. : -			REV. MARK		
																						4GCH01007			TM160		
																									1		

	A	B	C	D	E	F	G	H	I	J	K	L	M	N	O	P	Q	R	S	T	U	V	W	X	Y	Z	AA																														
	Line Name			From	LID	Logic Chart																			LID	To	Line Name																														
1																														1																											
2						10LAY20CS004XQ01 BFPT B OVRSPD A TSQ B PULSE 0-100-120% (0-6000-7200rpm) (TM658)	IOAI-1 IO v AI q Fx-1 F(X) BFPT B OVRSPD A ADL QTY QTY 0 7200 rpm																		Y1	TM194	BFPT B OVRSPD A			2																											
3																									11	TM194	BFPT B OVRSPD A QB			3																											
4																														4																											
5						10LAY20CS005XQ01 BFPT B OVRSPD B TSQ B PULSE 0-100-120% (0-6000-7200rpm) (TM658)	IOAI-2 IO v AI q Fx-2 F(X) BFPT B OVRSPD B ADL QTY QTY 0 7200 rpm																		Y2	TM194	BFPT B OVRSPD B			5																											
6																									21	TM194	BFPT B OVRSPD B QB			6																											
7																														7																											
8						10LAY20CS006XQ01 BFPT B OVRSPD C TSQ B PULSE 0-100-120% (0-6000-7200rpm) (TM658)	IOAI-3 IO v AI q Fx-3 F(X) BFPT B OVRSPD C ADL QTY QTY 0 7200 rpm																		Y3	TM194	BFPT B OVRSPD C			9																											
9																									31	TM194	BFPT B OVRSPD C QB			10																											
10																														10																											
11																														11																											
12						BFPT B OVRSPD A TM161 Fx-1 7200 rmp 0 0 % 120 BFPT B OVRSPD A TM161 Fx-1 <table><tr><th></th><th>X</th><th>Y</th></tr><tr><th></th><th>%</th><th>rmp</th></tr><tr><td>1</td><td>0</td><td>0</td></tr><tr><td>2</td><td>100</td><td>6000</td></tr><tr><td>3</td><td>120</td><td>7200</td></tr></table> BFPT B OVRSPD B TM161 Fx-2 7200 rmp 0 0 % 120 BFPT B OVRSPD B TM161 Fx-2 <table><tr><th></th><th>X</th><th>Y</th></tr><tr><th></th><th>%</th><th>rmp</th></tr><tr><td>1</td><td>0</td><td>0</td></tr><tr><td>2</td><td>100</td><td>6000</td></tr><tr><td>3</td><td>120</td><td>7200</td></tr></table> BFPT B OVRSPD C TM161 Fx-3 7200 rmp 0 0 % 120 BFPT B OVRSPD C TM161 Fx-3 <table><tr><th></th><th>X</th><th>Y</th></tr><tr><th></th><th>%</th><th>rmp</th></tr><tr><td>1</td><td>0</td><td>0</td></tr><tr><td>2</td><td>100</td><td>6000</td></tr><tr><td>3</td><td>120</td><td>7200</td></tr></table>		X	Y		%	rmp	1	0	0	2	100	6000	3	120	7200		X	Y		%	rmp	1	0	0	2	100	6000	3	120	7200		X	Y		%	rmp	1	0	0	2	100	6000	3	120	7200						12
	X	Y																																																							
	%	rmp																																																							
1	0	0																																																							
2	100	6000																																																							
3	120	7200																																																							
	X	Y																																																							
	%	rmp																																																							
1	0	0																																																							
2	100	6000																																																							
3	120	7200																																																							
	X	Y																																																							
	%	rmp																																																							
1	0	0																																																							
2	100	6000																																																							
3	120	7200																																																							
13																														13																											
14																														14																											
15																														15																											

Y1

TM194

BFPT B OVRSPD A

2 | 2 || 3 | 3 |
| 4 | 4 |
| 5 | | | | | 10LAY20CS005XQ01 10LAY20CS005XQ01 BFPT B OVRSPD B TSQ B PULSE 0-100-120% (0-6000-7200rpm) (TM658) IOAI-2 IO V AI Q Fx-2 F(X) BFPT B OVRSPD B ADL QTY QTY 0 7200 rpm |

Y2

TM194

BFPT B OVRSPD B

5 | 5 || 6 | 6 |
| 7 | 7 |
| 8 | | | | | 10LAY20CS006XQ01 10LAY20CS006XQ01 BFPT B OVRSPD C TSQ B PULSE 0-100-120% (0-6000-7200rpm) (TM658) IOAI-3 IO V AI Q Fx-3 F(X) BFPT B OVRSPD C ADL QTY QTY 0 7200 rpm |

Y3

TM194

BFPT B OVRSPD C

8 | 8 || 9 | 9 |
10																												10	
11																												11	
12					BFPT B OVRSPD A TM161 Fx-1 TM161 Fx-1		X	Y		---	-----	------		%	rpm			1	0	0		2	100	6000		3	120	7200	

BFPT B OVRSPD A

12 | 12 || 13 | 13 |
| 14 | 14 |
| 15 | 15 |

Rev. No.	0	1						PROJECT Van Phong 1 BOT Thermal Power Plant Project 2×673MW	(TSQ B)		
DATE	2021/6/21	2021/12/15									
CONTENTS	1st Issue	Revised (0015)						TITLE FIELD AI PROCESSING (62)	DRAWING No. 4GCH01007	SH TM161	REV. MARK 1
								Equipment No. : —			


	A	B	C	D	E	F	G	H	I	J	K	L	M	N	O	P	Q	R	S	T	U	V	W	X	Y	Z	AA																						
	Line Name			From	LID	Logic Chart																	LID	To	Line Name																								
1						10LAB17CF001XQ01 MBFP I/L WTR FLW A LOCAL 4-20mA 0 400 kPa IOAI-1 IO v AI Q Ft-1 F(t) T= 0.4 ADL QTY QTY TPC-1 TPC DP T P K= 67.35 DBZ-1 DBZ= 0 t/h 10LAB17CF001ZQ01 MBFP I/L WTR FLW A ADL QTY QTY 0 1348 t/h 10LAB17CF002XQ01 MBFP I/L WTR FLW B LOCAL 4-20mA 0 400 kPa IOAI-2 IO v AI Q Ft-2 F(t) T= 0.4 ADL QTY QTY TPC-2 TPC DP T P K= 67.35 DBZ-2 DBZ= 0 t/h 10LAB17CF002ZQ01 MBFP I/L WTR FLW B ADL QTY QTY 0 1348 t/h MBFP I/L WTR FLW COM PS TM162 A1 0 2 - A-2 A A= 1.0 -																																											
2																																									Y1	TM184	MBFP I/L WTR FLW A		2				
3																																								11	TM184	MBFP I/L WTR FLW A Q	B		3				
4																																													4				
5																																													5				
6																																									Y2	TM184	MBFP I/L WTR FLW B		6				
7																																								21	TM184	MBFP I/L WTR FLW B Q	B		7				
8																																													8				
9																																													9				
10																																													10				
11																																													11				
12																																													12				
13																																													13				
14																																													14				
15																																													15				
Rev. No.		0	1	3									PROJECT								(TSQ B)																												
DATE		2021/6/21	2021/12/15	2023/7/5									Van Phong 1 BOT Thermal Power Plant Project 2×673MW																																				
CONTENTS		1st Issue	Revised (0008, 0015)	Revised (0098)									TITLE								DRAWING No.				SH		REV. MARK																						
													FIELD AI PROCESSING (64)								4GCH01007				TM163		3																						
													Equipment No. :																																				


A-2


A

A= 1.0

-

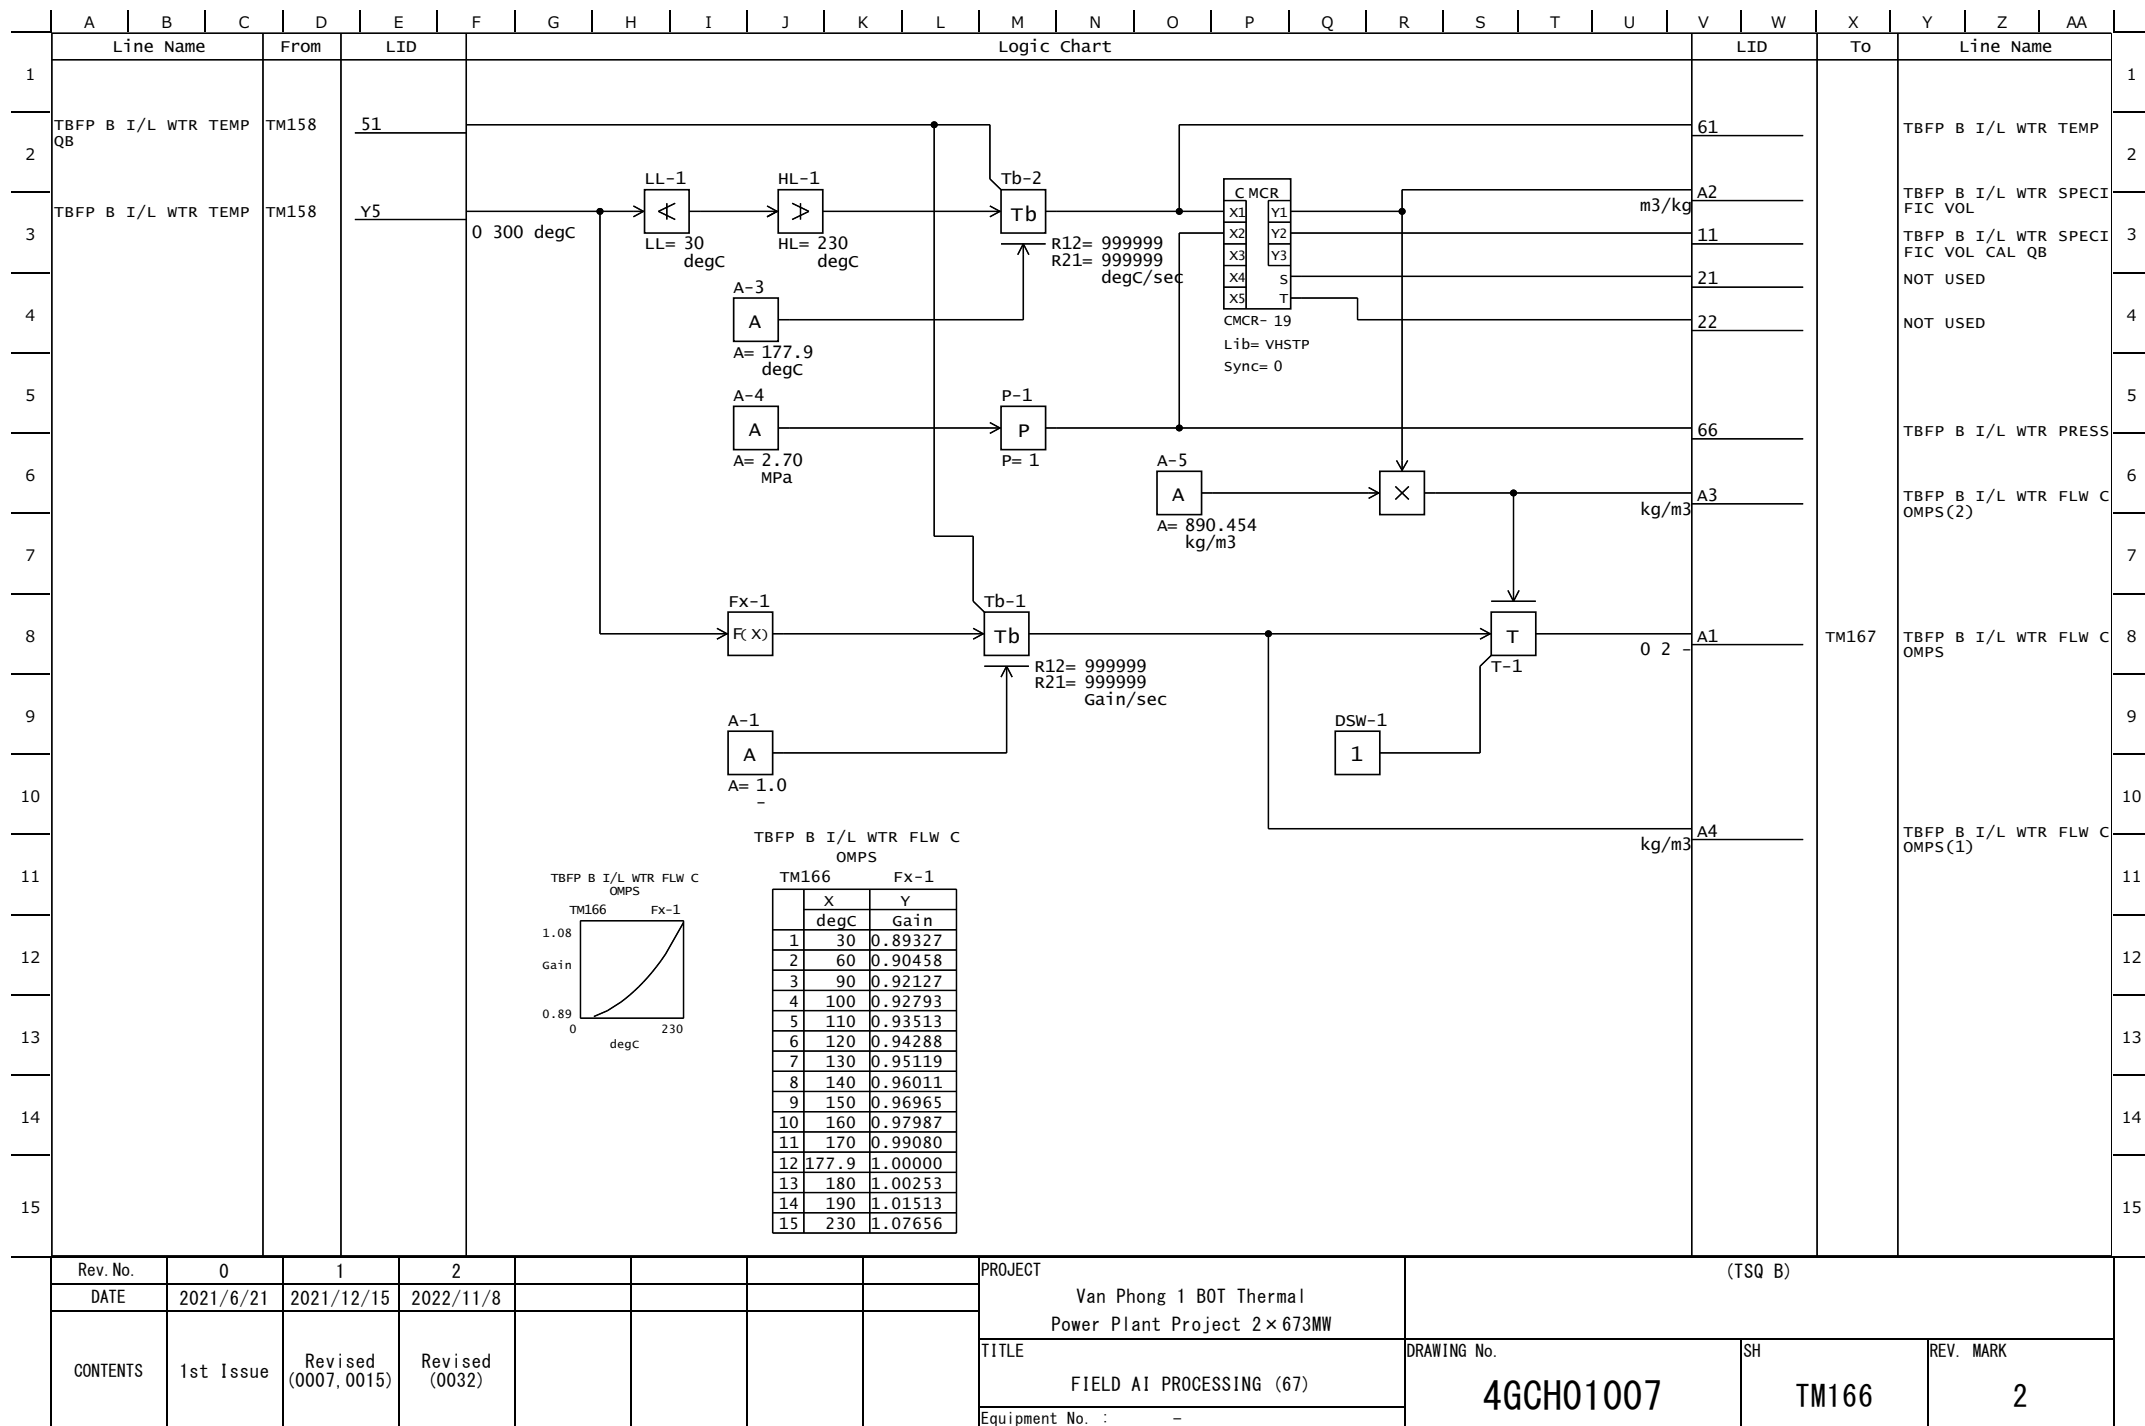


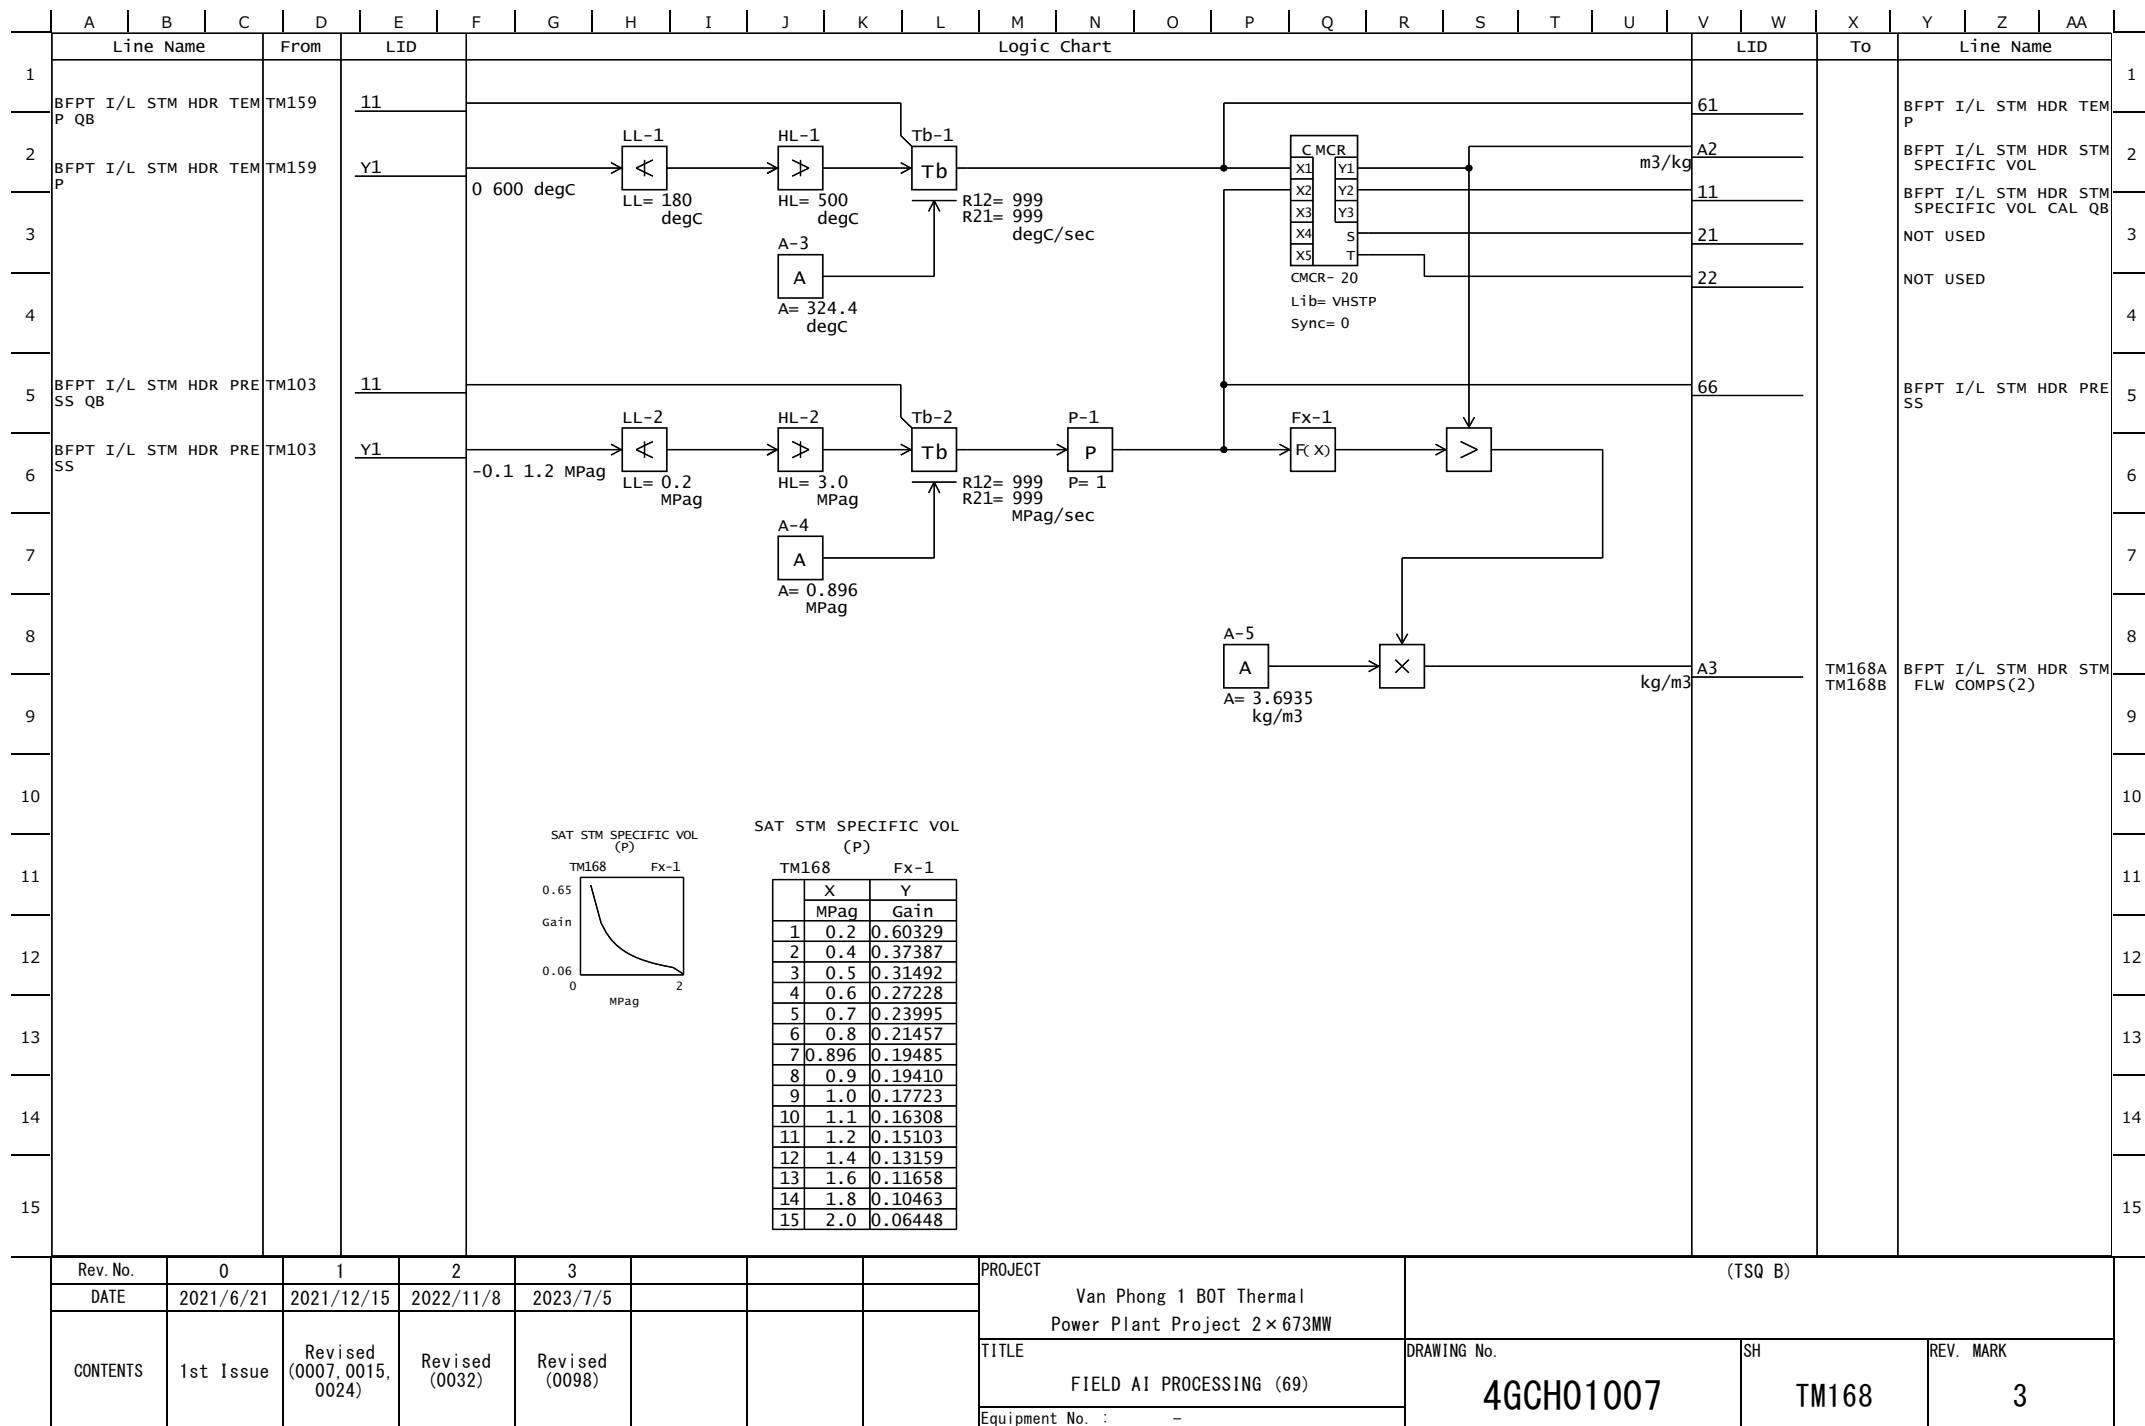

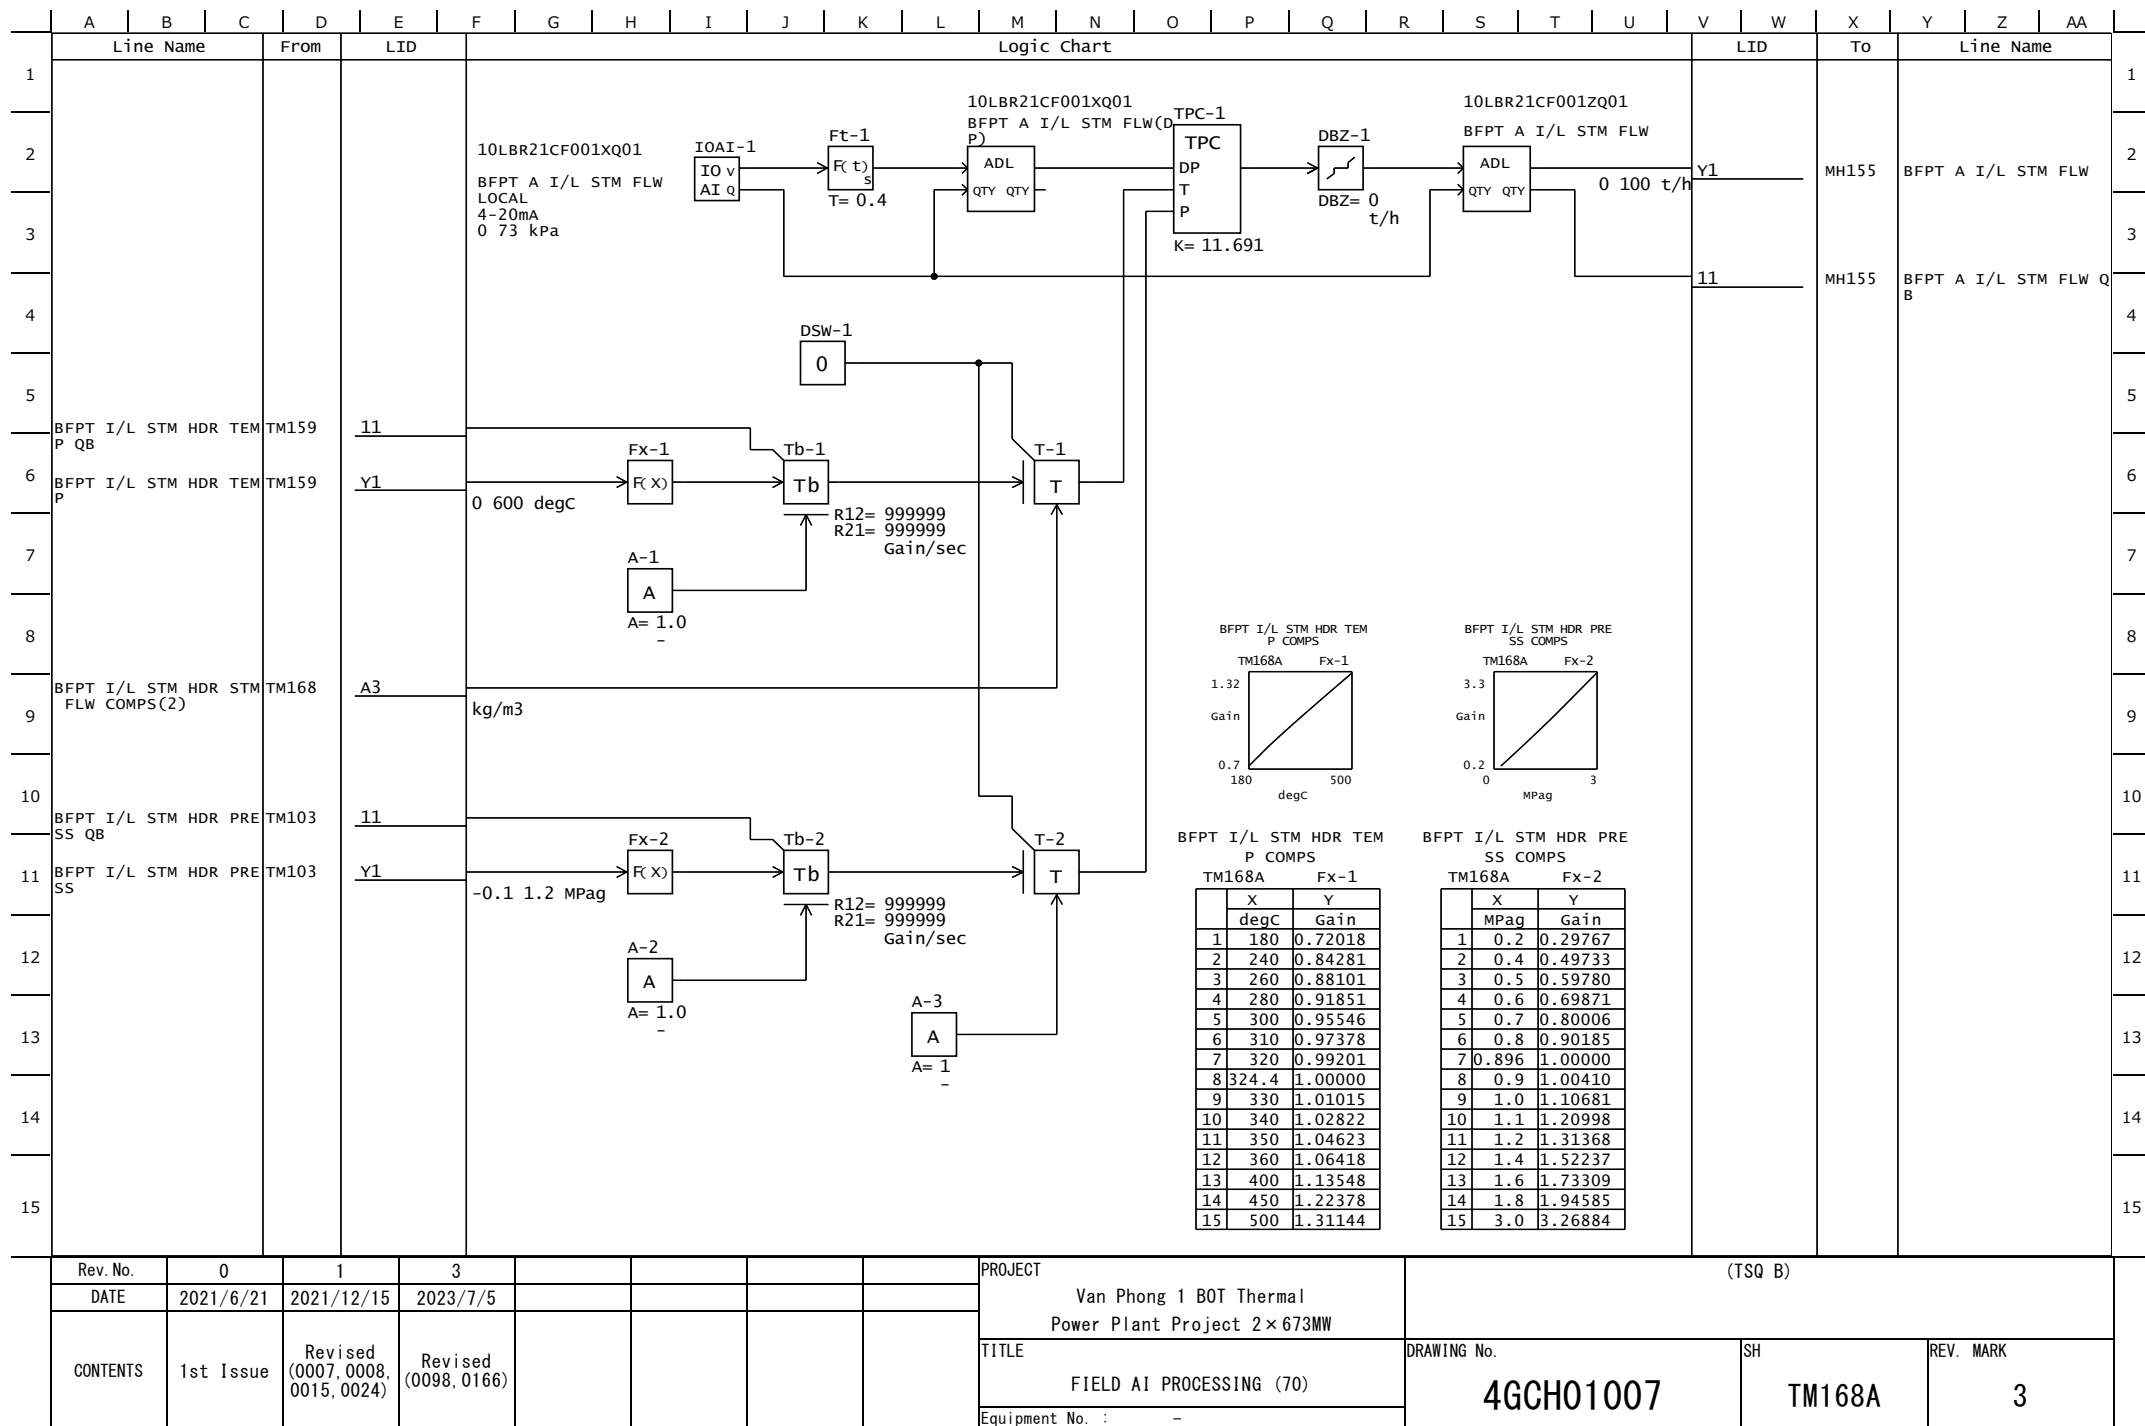

Rev. No.	0	1	3
DATE	2021/6/21	2021/12/15	2023/7/5
CONTENTS	1st Issue	Revised (0007, 0008, 0015, 0024)	Revised (0098, 0166)

PROJECT Van Phong 1 BOT Thermal Power Plant Project 2×673MW		(TSQ B)	
TITLE FIELD AI PROCESSING (70)		DRAWING No. 4GCH01007	SH TM168A
Equipment No. : -		REV. MARK 3	

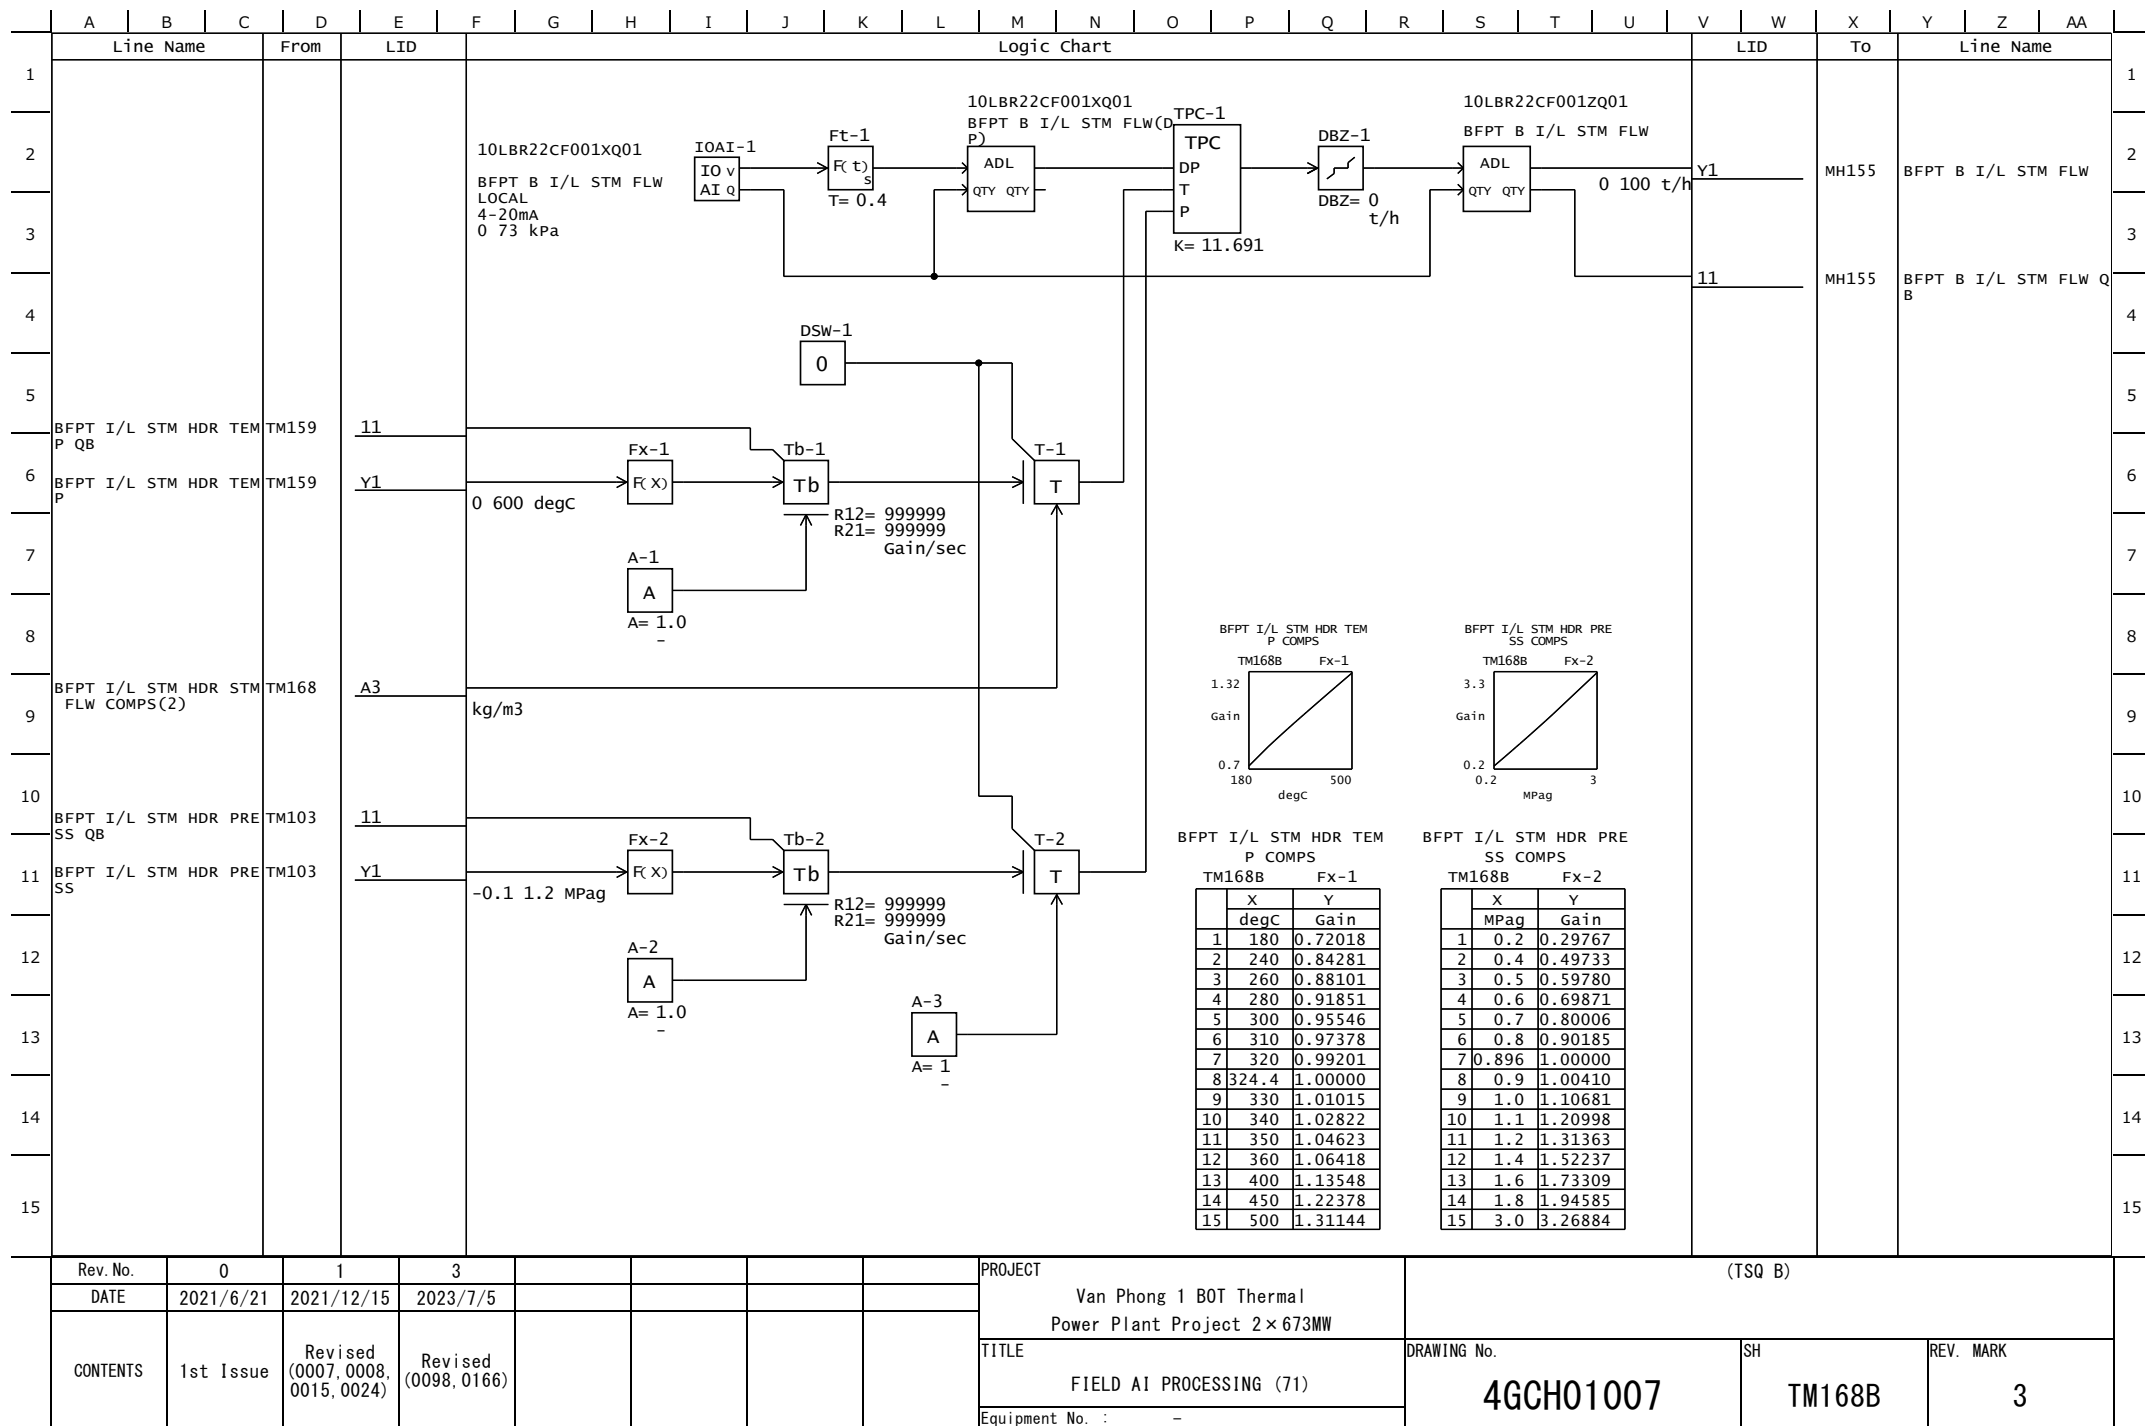


	A	B	C	D	E	F	G	H	I	J	K	L	M	N	O	P	Q	R	S	T	U	V	W	X	Y	Z	AA			
	Line Name			From	LID	Logic Chart																	LID	To	Line Name					
1																												1		
2						10LAC50AA203xQ01 BFPT A EXHD DV POSN LOCAL 4-20mA 0 100 %	IOAI-1 IO v AI q											10LAC50AA203xQ01 BFPT A EXHD DV POSN		ADL		0 100 %					Y1	TM595	BFPT A EXHD DV POSN	2
3																											11			3
4																														4
5						10LAC60AA203xQ01 BFPT B EXHD DV POSN LOCAL 4-20mA 0 100 %	IOAI-2 IO v AI q											10LAC60AA203xQ01 BFPT B EXHD DV POSN		ADL		0 100 %					Y2	TM745	BFPT B EXHD DV POSN	5
6																											21			6
7																														7
8						10LBR30AA201xQ01 BFPT A EXH VLV POSN LOCAL 4-20mA 0 100 %	IOAI-3 IO v AI q											10LBR30AA201xQ01 BFPT A EXH VLV POSN		ADL		0 100 %					Y3	TM605	BFPT A EXH VLV POSN	9
10																											31			10
11																														11
12						10LBR20AA201xQ01 BFPT B EXH VLV POSN LOCAL 4-20mA 0 100 %	IOAI-4 IO v AI q											10LBR20AA201xQ01 BFPT B EXH VLV POSN		ADL		0 100 %					Y4	TM755	BFPT B EXH VLV POSN	13
14																											41			14
15																														15

Rev. No.	0	1						PROJECT	(TSQ B)			
DATE	2021/6/21	2021/12/15						Van Phong 1 BOT Thermal Power Plant Project 2×673MW				
CONTENTS	1st Issue	Revised (0008,0015)						TITLE	DRAWING No.	SH	REV. MARK	
								FIELD A1 PROCESSING (75)	4GCH01007	TM173	1	
								Equipment No. : -				

	A	B	C	D	E	F	G	H	I	J	K	L	M	N	O	P	Q	R	S	T	U	V	W	X	Y	Z	AA		
	Line Name			From	LID	Logic Chart																	LID	To	Line Name				
1						10LBG13AA201xQ01 BFPT AUXS PCV I/L VL V POSN LOCAL 4-20mA 0 100 % IOAI-1 IO V AI Q ADL QTY QTY 10LBG13AA201xQ01 BFPT AUXS PCV I/L VL V POSN 0 100 %																		TM815	BFPT AUXS PCV I/L VL V POSN BFPT AUXS PCV I/L VL V POSN QB			1	
2																												2	
3																												3	
4																												4	
5																												5	
6																												6	
7																												7	
8																												8	
9																												9	
10																												10	
11																												11	
12																												12	
13																												13	
14																												14	
15																												15	
Rev. No.		0		1										PROJECT		(TSQ B)													
DATE		2021/6/21		2021/12/15										Van Phong 1 BOT Thermal Power Plant Project 2×673MW															
CONTENTS		1st Issue		Revised (0008, 0015)										TITLE		DRAWING No.					SH		REV. MARK						
														FIELD AI PROCESSING (76)		4GCH01007					TM174		1						
														Equipment No. : -															

	A	B	C	D	E	F	G	H	I	J	K	L	M	N	O	P	Q	R	S	T	U	V	W	X	Y	Z	AA		
	Line Name			From	LID	Logic Chart																	LID	To	Line Name				
1																												1	
2						10LAY10CS001xQ01 BFPT A SPD A LOCAL PULSE 0 7200 rpm	IOAI-1 IO v AI Q			BFPT A SPD A ADL QTY QTY			0 7200 rpm										Y1 11	TM507	BFPT A SPD A BFPT A SPD A QB			2	
3																												3	
4																												4	
5						10LAY10CS002xQ01 BFPT A SPD B LOCAL PULSE 0 7200 rpm	IOAI-2 IO v AI Q			BFPT A SPD B ADL QTY QTY			0 7200 rpm										Y2 21	TM507	BFPT A SPD B BFPT A SPD B QB			5	
6																												6	
7																												7	
8						10LAY10CS003xQ01 BFPT A SPD C LOCAL PULSE 0 7200 rpm	IOAI-3 IO v AI Q			BFPT A SPD C ADL QTY QTY			0 7200 rpm										Y3 31	TM507	BFPT A SPD C BFPT A SPD C QB			8	
9																												9	
10																												10	
11																												11	
12						10XAA10AA602xQ01 BFPT A CV POSN LOCAL LVDT 0 100 %	IOAI-4 IO v AI Q			BFPT A CV POSN ADL QTY QTY			0 100 %										Y4 41		BFPT A CV POSN BFPT A CV POSN QB			12	
13																												13	
14																												14	
15																												15	
	Rev. No.	2																					(BFPT A EHC)						
	DATE	2022/11/8																											
	CONTENTS	Sheet Added (0062)																					DRAWING No.		SH		REV. MARK		
																							4GCH01007		TM175		2		

	A	B	C	D	E	F	G	H	I	J	K	L	M	N	O	P	Q	R	S	T	U	V	W	X	Y	Z	AA								
	Line Name			From	LID	Logic Chart																	LID	To	Line Name										
1																												1							
2						10LAY20CS001xQ01 BFPT B SPD A LOCAL PULSE 0 7200 rpm	IOAI-1 IO v AI Q		BFPT B SPD A ADL QTY QTY		0 7200 rpm										Y1 11	TM657	BFPT B SPD A BFPT B SPD A QB		2 3										
3																												4							
4																												5							
5						10LAY20CS002xQ01 BFPT B SPD B LOCAL PULSE 0 7200 rpm	IOAI-2 IO v AI Q		BFPT B SPD B ADL QTY QTY		0 7200 rpm										Y2 21	TM657	BFPT B SPD B BFPT B SPD B QB		6 7										
6																												8							
7																												9							
8						10LAY20CS003xQ01 BFPT B SPD C LOCAL PULSE 0 7200 rpm	IOAI-3 IO v AI Q		BFPT B SPD C ADL QTY QTY		0 7200 rpm										Y3 31	TM657	BFPT B SPD C BFPT B SPD C QB		10 11										
9																												12							
10																												13							
11																												14							
12						10XAA20AA602xQ01 BFPT B CV POSN LOCAL LVDT 0 100 %	IOAI-4 IO v AI Q		BFPT B CV POSN ADL QTY QTY		0 100 %										Y4 41		BFPT B CV POSN BFPT B CV POSN QB		15										
13																												16							
14																												17							
15																												18							
Rev. No.		2																										PROJECT		(BFPT B EHC)					
DATE		2022/11/8																										Van Phong 1 BOT Thermal Power Plant Project 2×673MW							
CONTENTS		Sheet Added (0062)																										TITLE		DRAWING No.		SH		REV. MARK	
																												FIELD AI PROCESSING (78)		4GCH01007		TM176		2	
																												Equipment No. : -							

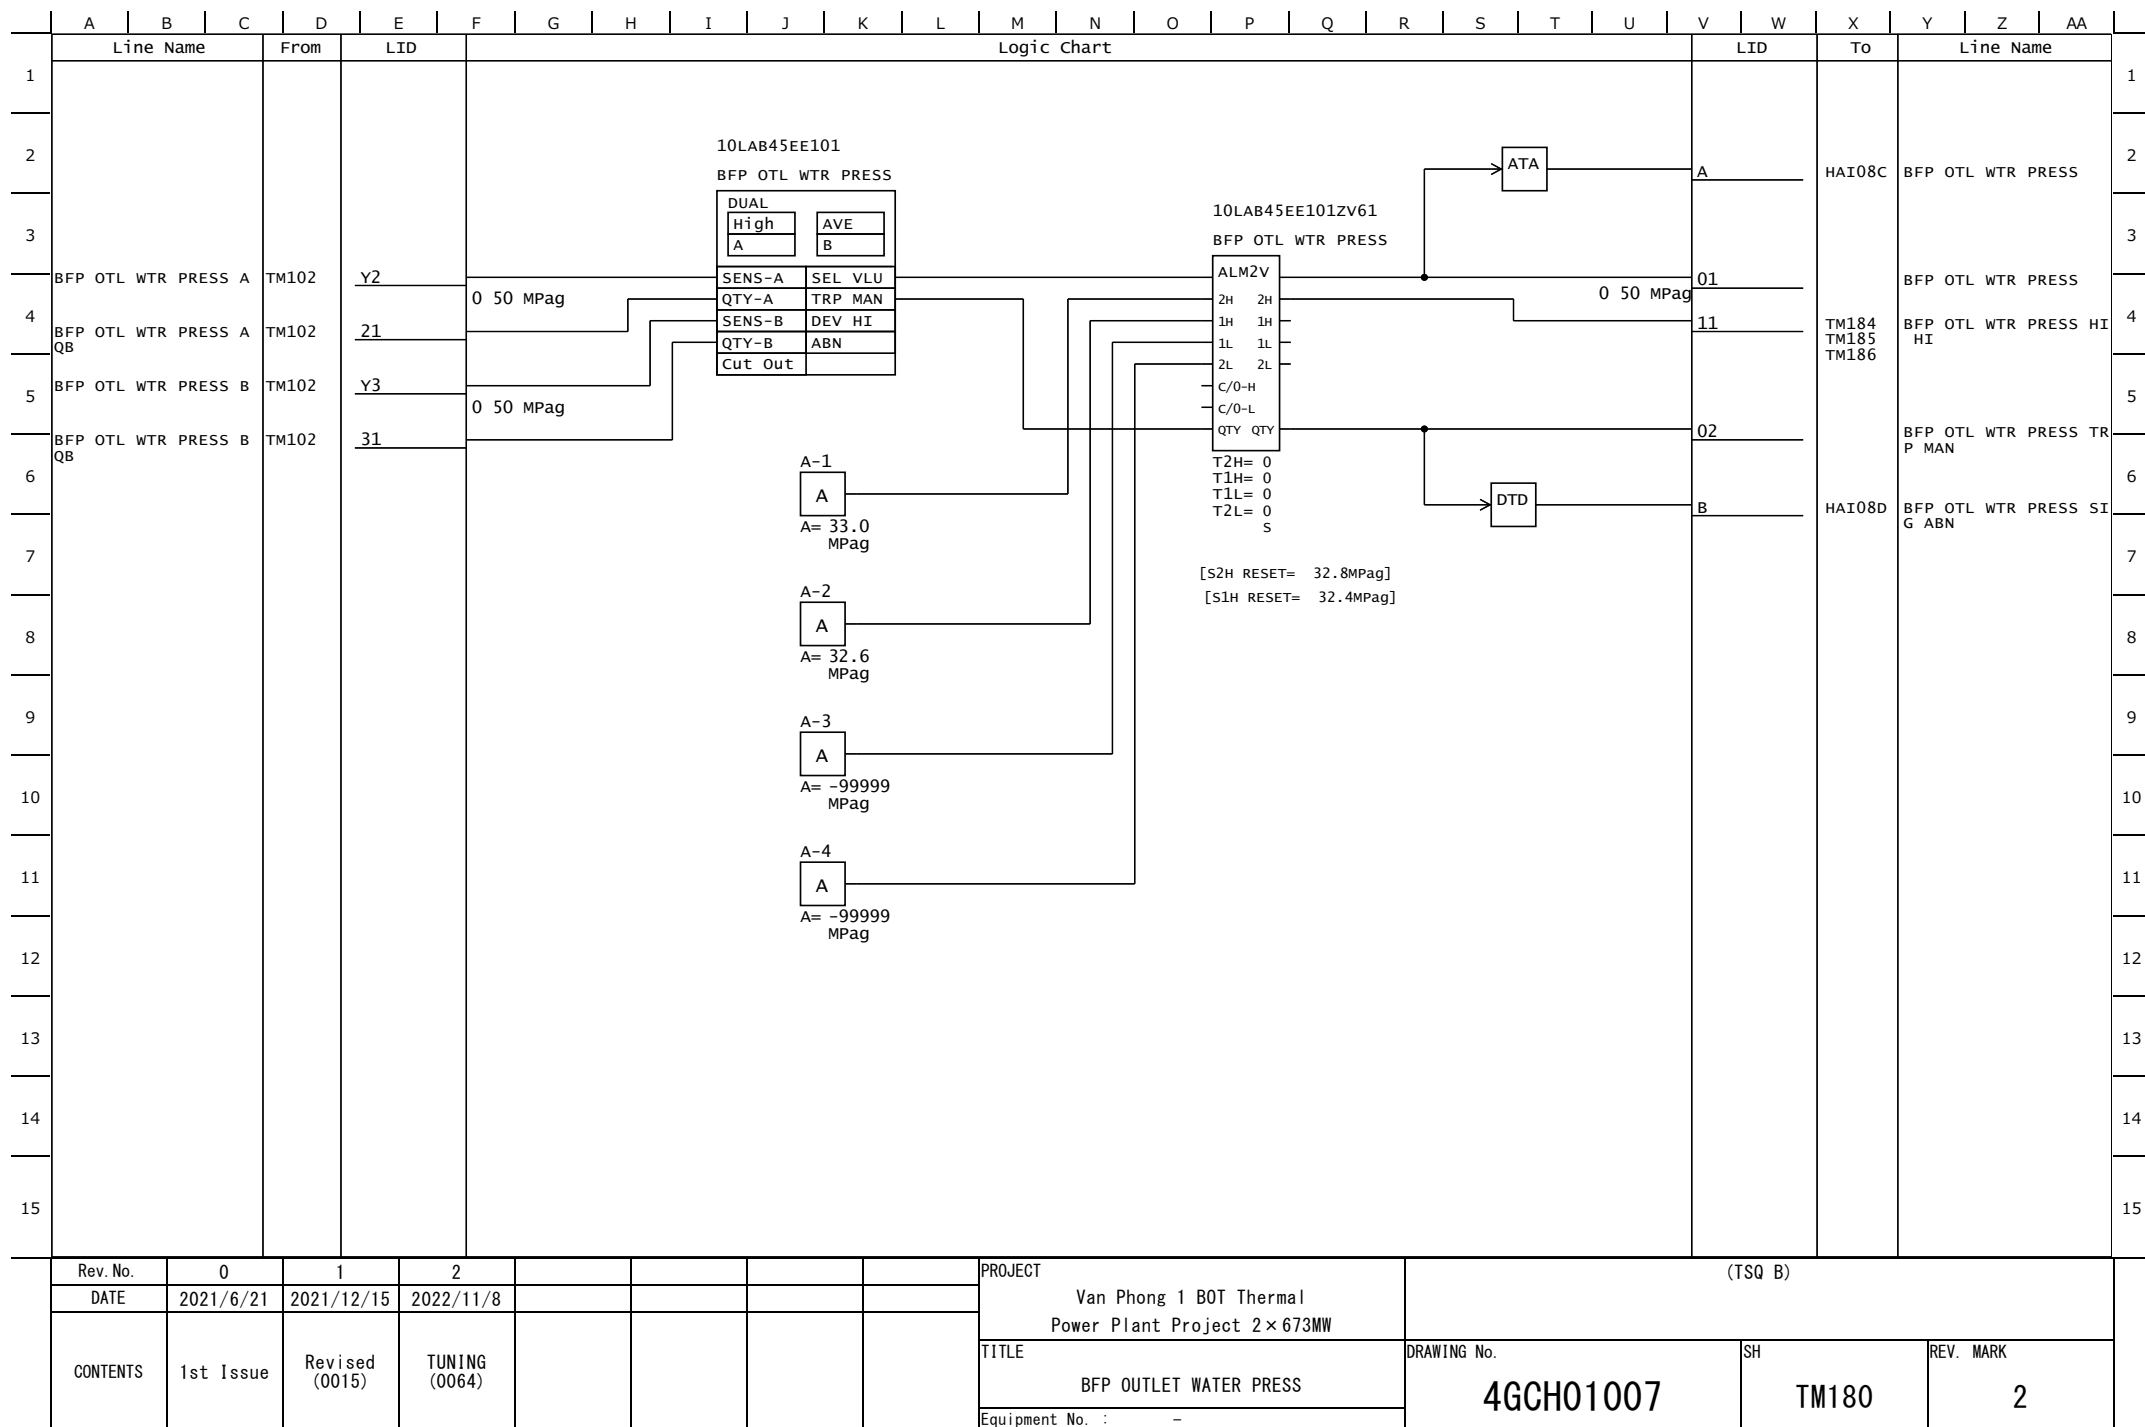

	A	B	C	D	E	F	G	H	I	J	K	L	M	N	O	P	Q	R	S	T	U	V	W	X	Y	Z	AA	
	Line Name			From	LID	Logic Chart																	LID	To	Line Name			
1																												1
2																												2
3																												3
4	MBFP OTL WTR PRESS A			TM114	Y1																				MBFP OTL WTR PRESS			4
5	MBFP OTL WTR PRESS A			TM114	11																							5
6	MBFP OTL WTR PRESS B			TM114	Y2																							6
7	MBFP OTL WTR PRESS B			TM114	21																							7
8																												8
9																												9
10																												10
11																												11
12																												12
13																												13
14																												14
15																												15

Rev. No.	0	1	2						PROJECT	(TSQ B)											
DATE	2021/6/21	2021/12/15	2022/11/8						Van Phong 1 BOT Thermal Power Plant Project 2×673MW												
CONTENTS	1st Issue	Revised (0007, 0015, 0024)	Revised (0056, 0064)						TITLE	DRAWING No.					SH	REV. MARK					
									MBFP OTL WTR PRESS	4GCH01007					TM181	2					
									Equipment No. : -												

	A	B	C	D	E	F	G	H	I	J	K	L	M	N	O	P	Q	R	S	T	U	V	W	X	Y	Z	AA		
	Line Name			From	LID	Logic Chart																	LID	To	Line Name				
1	TBFP A OTL WTR PRESS A A QB B B QB			TM115	Y2 21 Y3 31	0 60 MPag 0 60 MPag	10LAB31EE101 TBFP A OTL WTR PRESS DUAL High A AVE B SENS-A QTY-A SENS-B QTY-B Cut Out SEL VLU TRP MAN DEV HI ABN 10LAB31EE101ZV61 TBFP A OTL WTR PRESS ALM2F 2H 1H C/O-H 1L C/O-L 2L QTY QTY S2H= 49.5 S1H= 49 S1L= -999999 S2L= -999999 MPag T2H= 0 T1H= 0 T1L= 0 T2L= 0 S [S2H RESET=49.48MPag] [S1H RESET=48.98MPag] ATA 0 60 MPag																	01	HAI07D	TBFP A OTL WTR PRESS			1
2																													2
3																													3
4																													4
5																													5
6																													6
7																								02	HAI07F	TBFP A OTL WTR PRESS TRP MAN			7
8																								B		TBFP A OTL WTR PRESS TRP ABN			8
9																													9
10																													10
11																													11
12																													12
13																													13
14																													14
15																													15
	Rev. No.	0	1	2																									
	DATE	2021/6/21	2021/12/15	2022/11/8																									
	CONTENTS	1st Issue	Revised (0015)	Revised & Tuning (0056, 0064)																									


	A	B	C	D	E	F	G	H	I	J	K	L	M	N	O	P	Q	R	S	T	U	V	W	X	Y	Z	AA	
	Line Name		From	LID	Logic Chart																	LID	To	Line Name				
1	TBFP B OTL WTR PRESS A		TM116	Y2	10LAB32EE101 TBFP B OTL WTR PRESS DUAL High A AVE B SENS-A QTY-A SENS-B QTY-B Cut Out SEL VLU TRP MAN DEV HI ABN 10LAB32EE101ZV61 TBFP B OTL WTR PRESS ALM2F 2H 1H C/O-H 1L C/O-L 2L QTY QTY S2H= 49.5 S1H= 49 S1L= -999999 S2L= -999999 MPag T2H= 0 T1H= 0 T1L= 0 T2L= 0 S [S2H RESET=49.48MPag] [S1H RESET=48.98MPag] ATA 0 60 MPag																							

01


02

B


	A	B	C	D	E	F	G	H	I	J	K	L	M	N	O	P	Q	R	S	T	U	V	W	X	Y	Z	AA		
	Line Name			From	LID	Logic Chart																	LID	To	Line Name				
1																												1	
2																												2	
3																												3	
4																												4	
5																												5	
6																												6	
7																												7	
8																												8	
9																												9	
10																												10	
11																												11	
12																												12	
13																												13	
14																												14	
15																												15	
	Rev. No.	0	1	2	3									PROJECT					(TSQ B)										
	DATE	2021/6/21	2021/12/15	2022/11/8	2023/7/5									Van Phong 1 BOT Thermal Power Plant Project 2×673MW															
	CONTENTS	1st Issue	Revised (0015)	Revised (0056)	Revised (0087)									TITLE					DRAWING No.					SH		REV. MARK			
														MBFP INLET WATER FLOW (2)					4GCH01007					TM184B		3			
														Equipment No. : -															

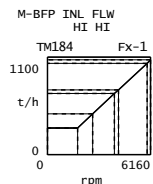


	X	Y
	rpm	t/h
1	0	300
2	1800	300
3	2700	460
4	4000	690
5	4247	730
6	5958	1030
7	6160	1070

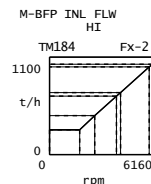


	X	Y
	rpm	t/h
1	0	280
2	1800	280
3	2700	440
4	4000	660
5	4247	700
6	5958	990
7	6160	1020

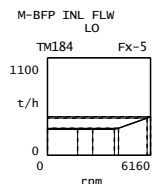

	X	Y
	rpm	t/h
1	0	295
2	1800	295
3	2700	295
4	4000	295
5	4247	305
6	5958	420
7	6160	435

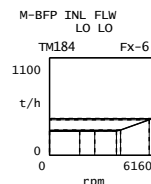


	X	Y
	rpm	t/h
1	0	275
2	1800	275
3	2700	275
4	4000	275
5	4247	285
6	5958	400
7	6160	415

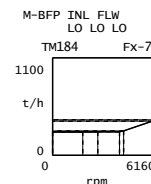


	X	Y
	rpm	t/h
1	0	265
2	1800	265
3	2700	265
4	4000	265
5	4247	275
6	5958	385
7	6160	400

TBL-1	
DUMMY	
-	-
-	-
-	-


	A	B	C	D	E	F	G	H	I	J	K	L	M	N	O	P	Q	R	S	T	U	V	W	X	Y	Z	AA			
	Line Name			From	LID	Logic Chart																		LID	To	Line Name				
1																													1	
2																													2	
3																													3	
4																													4	
5																													5	
6																													6	
7																													7	
8																													8	
9																													9	
10																													10	
11																													11	
12																													12	
13																													13	
14																													14	
15																													15	
	Rev. No.	0	1	2	3																		PROJECT			(TSQ B)				
	DATE	2021/6/21	2021/12/15	2022/11/8	2023/7/5																		Van Phong 1 BOT Thermal Power Plant Project 2×673MW							
	CONTENTS	1st Issue	Revised (0015)	Revised (0056)	Revised (0087)																		TITLE		DRAWING No.		SH	REV. MARK		
																							T-BFP A INLET WATER FLOW (2)		4GCH01007		TM185A		3	
																							Equipment No. : -							

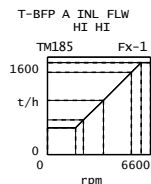


	X	Y
	rpm	t/h
1	0	440
2	1800	440
3	2300	570
4	3587	890
5	5373	1350
6	6000	1510
7	6600	1510

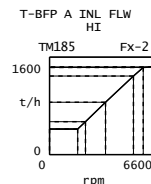


	X	Y
	rpm	t/h
1	0	420
2	1800	420
3	2300	540
4	3587	860
5	5373	1290
6	6000	1430
7	6600	1440

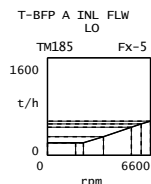

	X	Y
	rpm	t/h
1	0	205
2	1800	205
3	2300	205
4	3587	305
5	5373	460
6	6000	515
7	6600	560

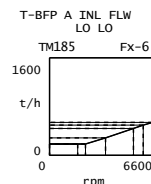



	X	Y
	rpm	t/h
1	0	185
2	1800	185
3	2300	185
4	3587	285
5	5373	440
6	6000	495
7	6600	540

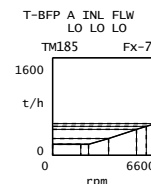

	X	Y
	rpm	t/h
1	0	180
2	1800	180
3	2300	180
4	3587	275
5	5373	425
6	6000	475
7	6600	520

TBL-1	
DUMMY	
-	-
-	-
-	-

	A	B	C	D	E	F	G	H	I	J	K	L	M	N	O	P	Q	R	S	T	U	V	W	X	Y	Z	AA		
	Line Name			From	LID	Logic Chart																	LID	To	Line Name				
1																												1	
2																												2	
3																												3	
4																												4	
5																												5	
6																												6	
7																												7	
8																												8	
9																												9	
10																												10	
11																												11	
12																												12	
13																												13	
14																												14	
15																												15	
Rev. No.		0	1	2	3					PROJECT										(TSQ B)									
DATE		2021/6/21	2021/12/15	2022/11/8	2023/7/5					Van Phong 1 BOT Thermal Power Plant Project 2×673MW																			
CONTENTS		1st Issue	Revised (0015)	Revised (0056)	Revised (0087)					TITLE										DRAWING No.				SH	REV. MARK				
										T-BFP B INLET WATER FLOW (2)										4GCH01007				TM186A		3			
										Equipment No. : -																			

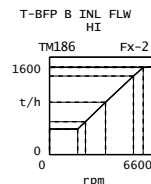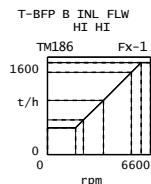

T-BFP B INL FLW
HI HI




TM186 Fx-1

	X	Y
	rpm	t/h
1	0	440
2	1800	440
3	2300	570
4	3587	890
5	5373	1350
6	6000	1510
7	6600	1510

T-BFP B INL FLW
HI HI

TM186 Fx-2

	X	Y
	rpm	t/h
1	0	420
2	1800	420
3	2300	540
4	3587	860
5	5373	1290
6	6000	1430
7	6600	1440

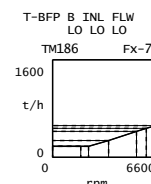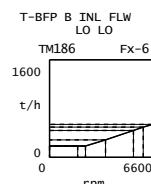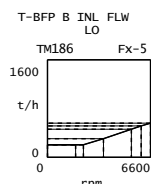

T-BFP B INL FLW
LO LO

TM186 Fx-5

	X	Y
	rpm	t/h
1	0	205
2	1800	205
3	2300	205
4	3587	305
5	5373	460
6	6000	515
7	6600	560

T-BFP B INL FLW
LO LO

TM186 Fx-6

	X	Y
	rpm	t/h
1	0	185
2	1800	185
3	2300	185
4	3587	285
5	5373	440
6	6000	495
7	6600	540

T-BFP B INL FLW
LO LO LO

TM186 Fx-7

	X	Y
	rpm	t/h
1	0	180
2	1800	180
3	2300	180
4	3587	275
5	5373	425
6	6000	475
7	6600	520

TBL-1

DUMMY	
-	-
-	-
-	-

	A	B	C	D	E	F	G	H	I	J	K	L	M	N	O	P	Q	R	S	T	U	V	W	X	Y	Z	AA																			
	Line Name			From	LID	Logic Chart																	LID	To	Line Name																					
1						10XAV16EE151 BFPT A LUBE OIL PRES S TRIPLE MED AVE A B C SENS-A SEL VLU QTY-A TRP MAN SENS-B A DEV HI QTY-B B DEV HI SENS-C C DEV HI QTY-C ABN Cut Out 10XAV16EB001ZV61 BFPT A LUBE OIL PRES S ALM1F C/O-H 1H C/O-L 1L QTY QTY S1H= 999999 S1L= 0.110 MPag T1H= 0 T1L= 0 S [S1L RESET= 0.110MPag]																	01	TM519	BFPT A LUBE OIL PRES S	3																				
2																																													2	
3	BFPT A LUBE OIL PRES S A	TM105		Y3																			0 1 MPag																							3
4	BFPT A LUBE OIL PRES S A QB	TM105		31																																										4
5	BFPT A LUBE OIL PRES S B	TM105		Y4																			0 1 MPag																							5
6	BFPT A LUBE OIL PRES S B QB	TM105		41																																										6
7	BFPT A LUBE OIL PRES S C	TM105		Y5																			0 1 MPag																							7
8	BFPT A LUBE OIL PRES S C QB	TM105		51																									8																	
9																													9																	
10																													10																	
11																													11																	
12																													12																	
13																													13																	
14																													14																	
15																													15																	

Rev. No.	0	1	2							PROJECT		(TSQ B)			
DATE	2021/6/21	2021/12/15	2022/11/8							Van Phong 1 BOT Thermal Power Plant Project 2×673MW					
CONTENTS	1st Issue	Revised (0015)	Revised & Tuning (0056, 0064)							TITLE		DRAWING No.		SH	REV. MARK
										BFPT A LUBE OIL PRESSURE		4GCH01007		TM187	2
										Equipment No. : -					

10XAV16EB002ZV22

BFPT A LUBE OIL PRES

S LO LO


DALM


QTY QTY


ALM= 1

Rev. No.	0	1	2					PROJECT	(TSQ B)			
DATE	2021/6/21	2021/12/15	2022/11/8					Van Phong 1 BOT Thermal Power Plant Project 2×673MW				
CONTENTS	1st Issue	Revised (0015)	Revised & Tuning (0056, 0064)					TITLE	DRAWING No.	SH	REV. MARK	
								BFPT A LUBE OIL PRESSURE	4GCH01007	TM187	2	
								Equipment No. : -				


	A	B	C	D	E	F	G	H	I	J	K	L	M	N	O	P	Q	R	S	T	U	V	W	X	Y	Z	AA						
	Line Name			From	LID	Logic Chart																	LID	To	Line Name								
1	BFPT B LUBE OIL PRES S A			TM108	Y3	0 1 MPag	10XAV26EE151 BFPT B LUBE OIL PRES S TRIPLE MED A AVE B C SENS-ASEL VLU QTY-ATRPMAN SENS-BA DEV HI QTY-BB DEV HI SENS-CC DEV HI QTY-CABN Cut Out 10XAV26EB001ZV61 BFPT B LUBE OIL PRES S ALM1F C/O-H 1H C/O-L 1L QTY QTY S1H= 999999 S1L= 0.110 MPag T1H= 0 T1L= 0 S [S1L RESET= 0.110MPag] 01 <td rowspan="7">TM669</td> <td colspan="3" rowspan="7">BFPT B LUBE OIL PRES S</td> <td>3</td>																	TM669	BFPT B LUBE OIL PRES S			3					
2																																	
4																																	
5																																	
6																																	
7																																	
8																																	
9	BFPT B LUBE OIL PRES S A QB			TM108	31	0 1 MPag	L-1 /L S= 0.080 R= 0.080 MPag L-2 /L S= 0.080 R= 0.080 MPag L-3 /L S= 0.080 R= 0.080 MPag DSW-1 1 05 <td rowspan="7">TM699</td> <td colspan="3" rowspan="7">BFPT B LUBE OIL PRES S LO</td> <td>5</td>																	TM699	BFPT B LUBE OIL PRES S LO			5					
6																																	
7																																	
8																																	
9																																	
10																																	
11																																	
12	BFPT B LUBE OIL PRES S B			TM108	Y4	0 1 MPag	L-1 /L S= 0.080 R= 0.080 MPag L-2 /L S= 0.080 R= 0.080 MPag L-3 /L S= 0.080 R= 0.080 MPag DSW-1 1 02																	TM650	BFPT B LUBE OIL PRES S TRP MAN			6					
7																																	
8																																	
9																																	
10																																	
11																																	
12																																	
13	BFPT B LUBE OIL PRES S B QB			TM108	41	0 1 MPag	L-1 /L S= 0.080 R= 0.080 MPag L-2 /L S= 0.080 R= 0.080 MPag L-3 /L S= 0.080 R= 0.080 MPag DSW-1 1 06																	TM650	BFPT B LUBE OIL PRES S LO LO			9					
10																																	
11																																	
12																																	
13																																	
14																																	
15																																	
15	BFPT B LUBE OIL PRES S C QB			TM108	51	0 1 MPag	L-1 /L S= 0.080 R= 0.080 MPag L-2 /L S= 0.080 R= 0.080 MPag L-3 /L S= 0.080 R= 0.080 MPag DSW-1 1 06																	TM650	BFPT B LUBE OIL PRES S LO LO			9					
10																																	
11																																	
12																																	
13																																	
14																																	
15																																	
Rev. No.			0	1	2																		PROJECT			(TSQ B)							
DATE			2021/6/21	2021/12/15	2022/11/8																		Van Phong 1 BOT Thermal Power Plant Project 2×673MW										
CONTENTS			1st Issue	Revised (0015)	Revised & Tuning (0056, 0064)																		TITLE			DRAWING No.			SH		REV. MARK		
																							BFPT B LUBE OIL PRESSURE			4GCH01007			TM188		2		
																							Equipment No. : -										

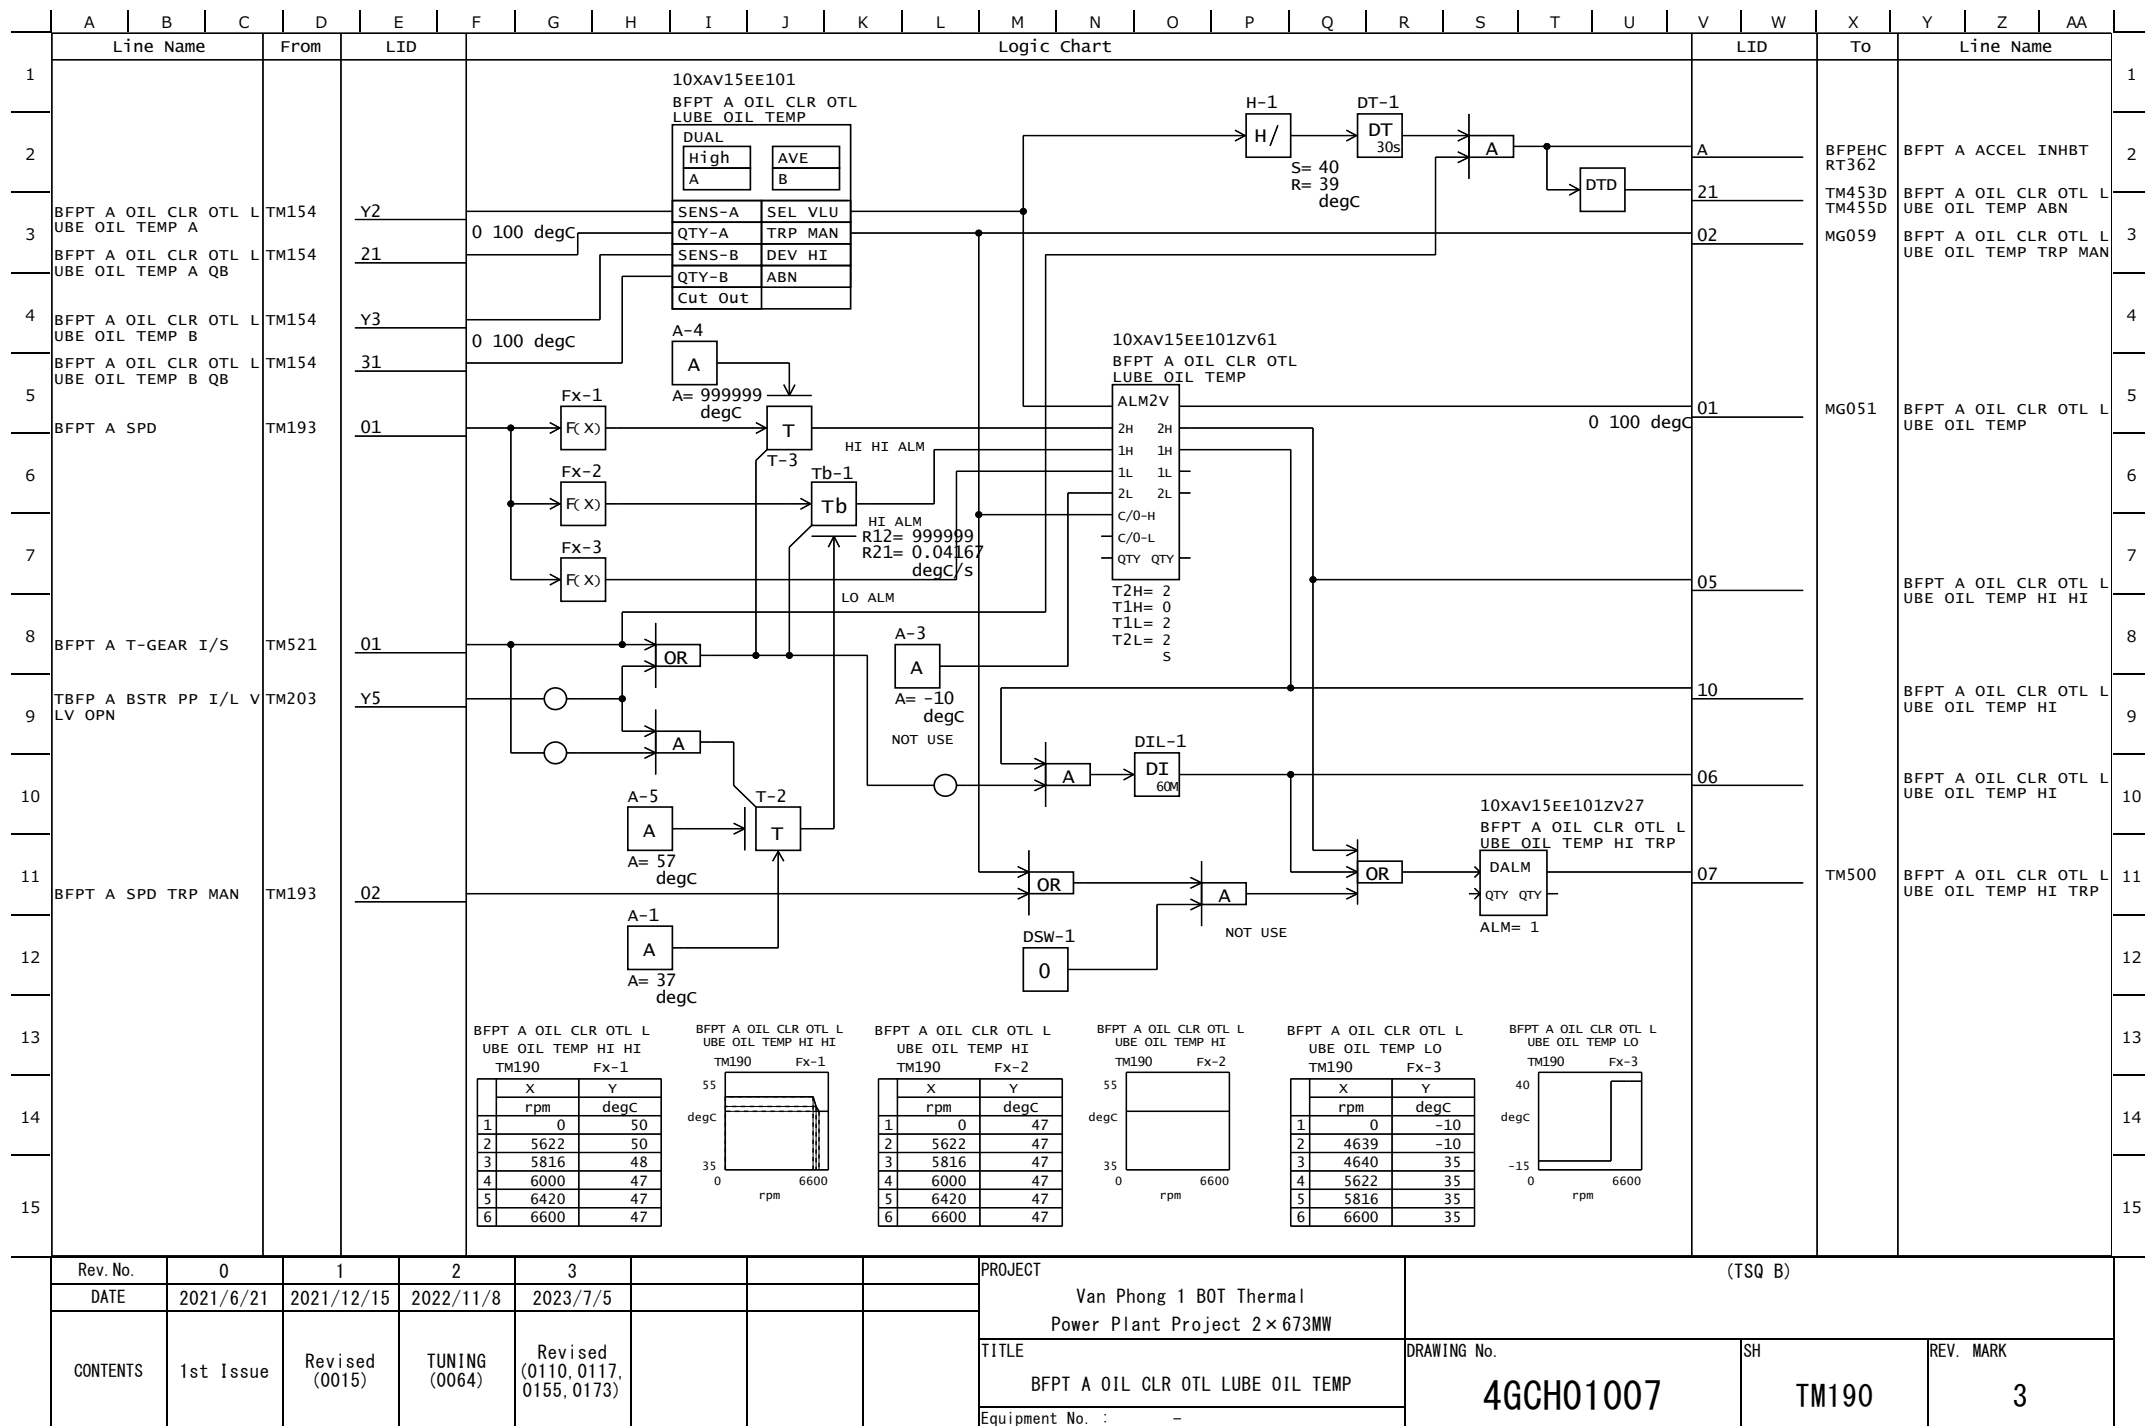

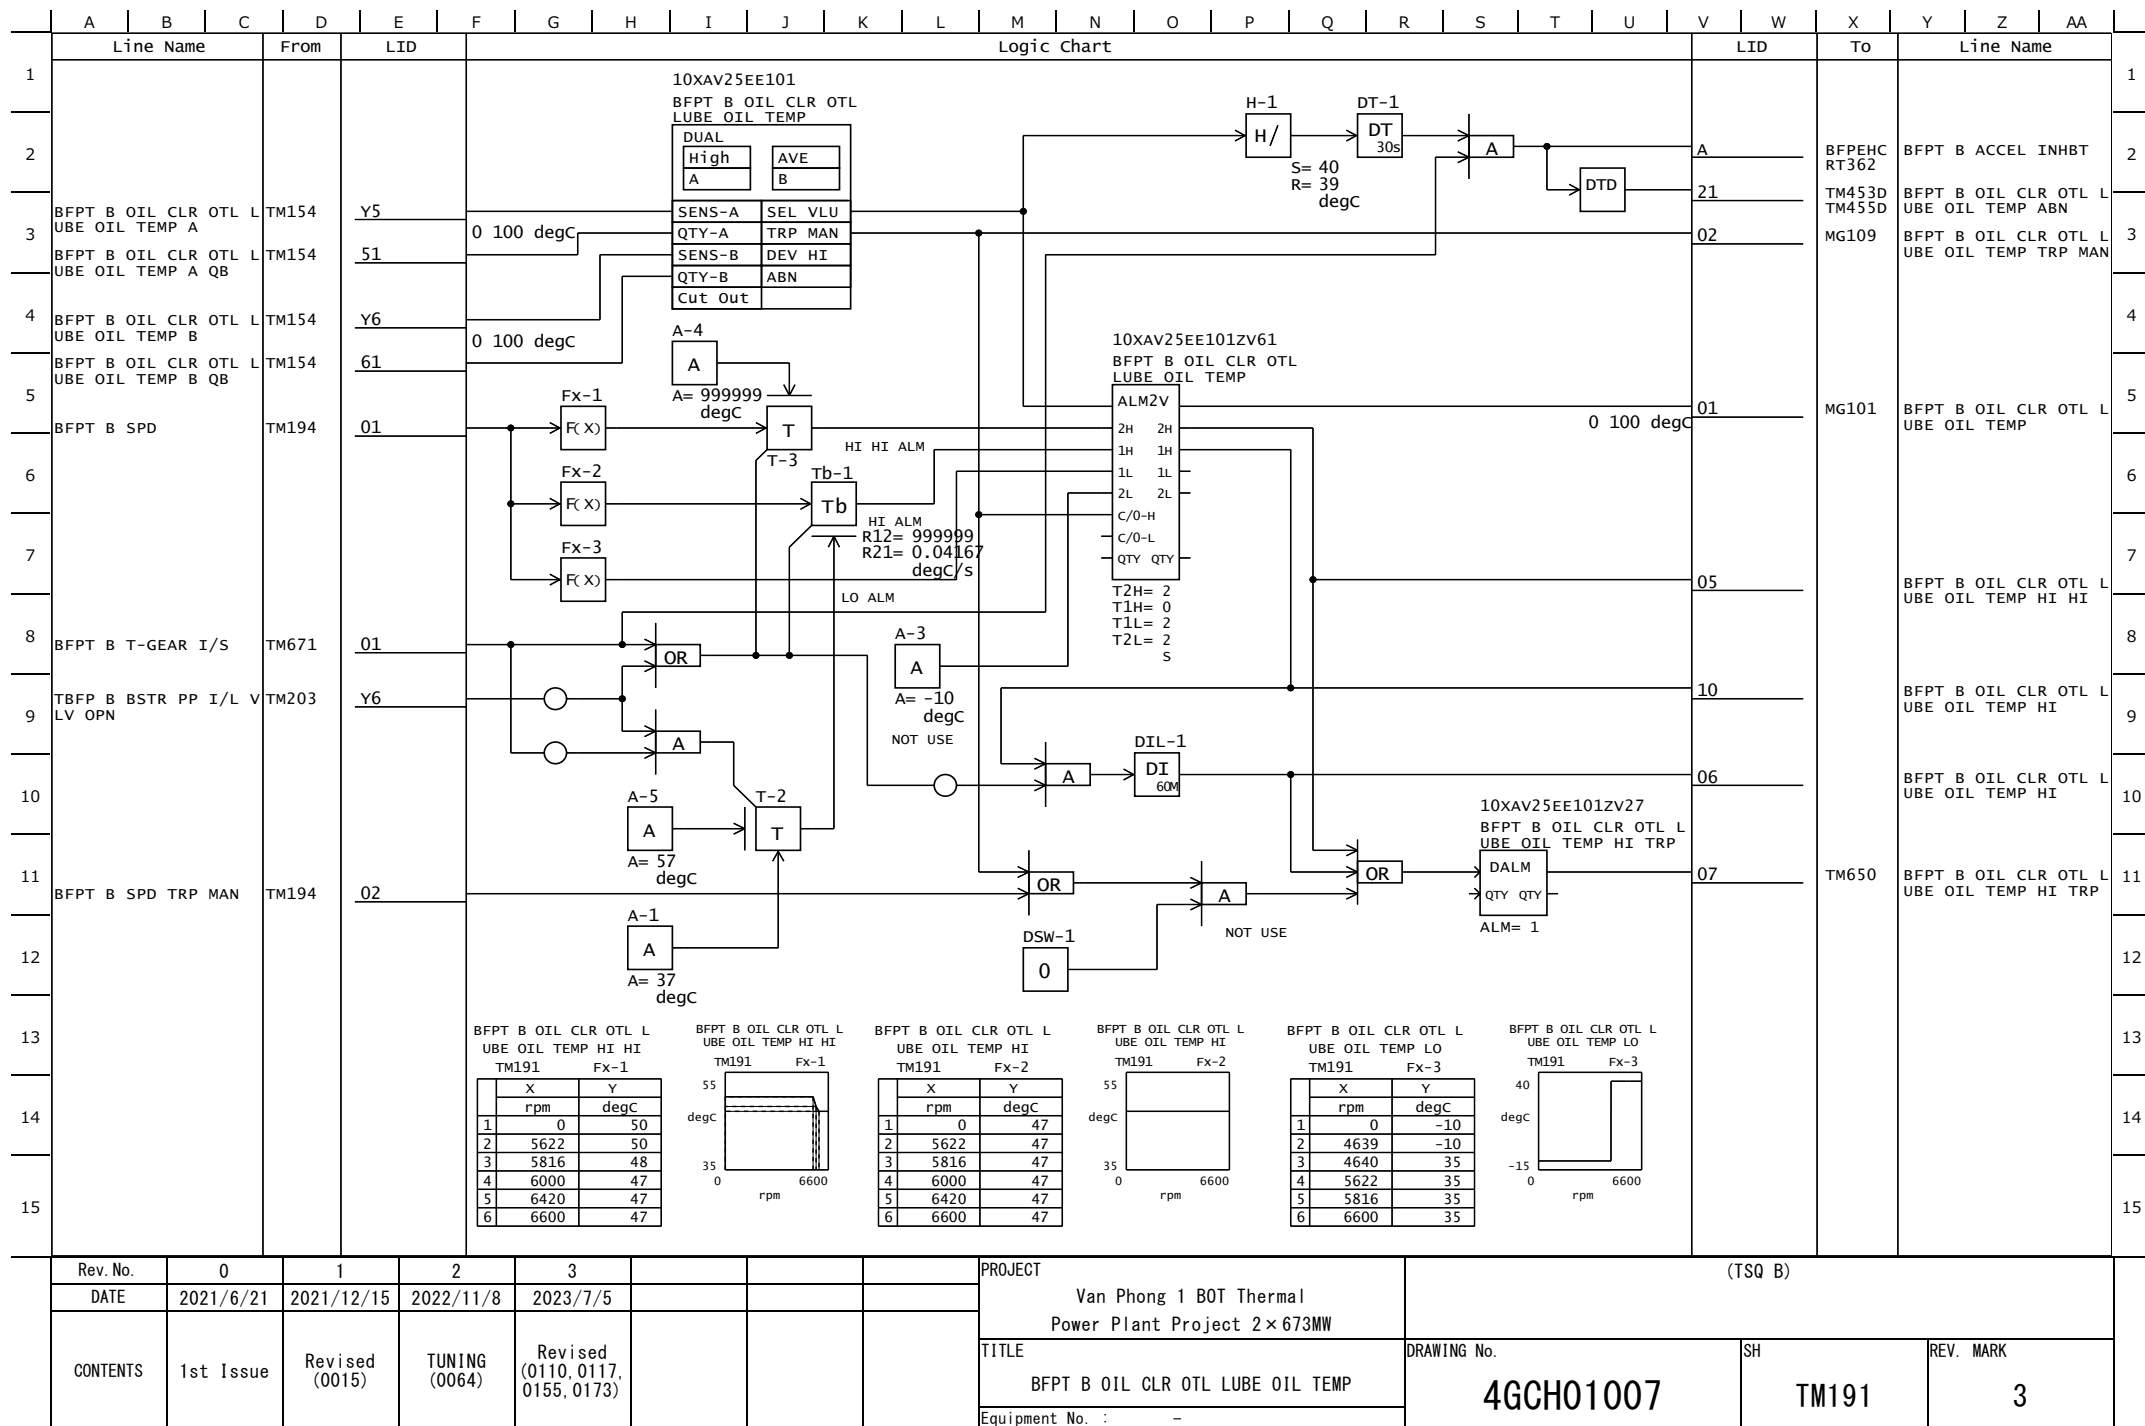

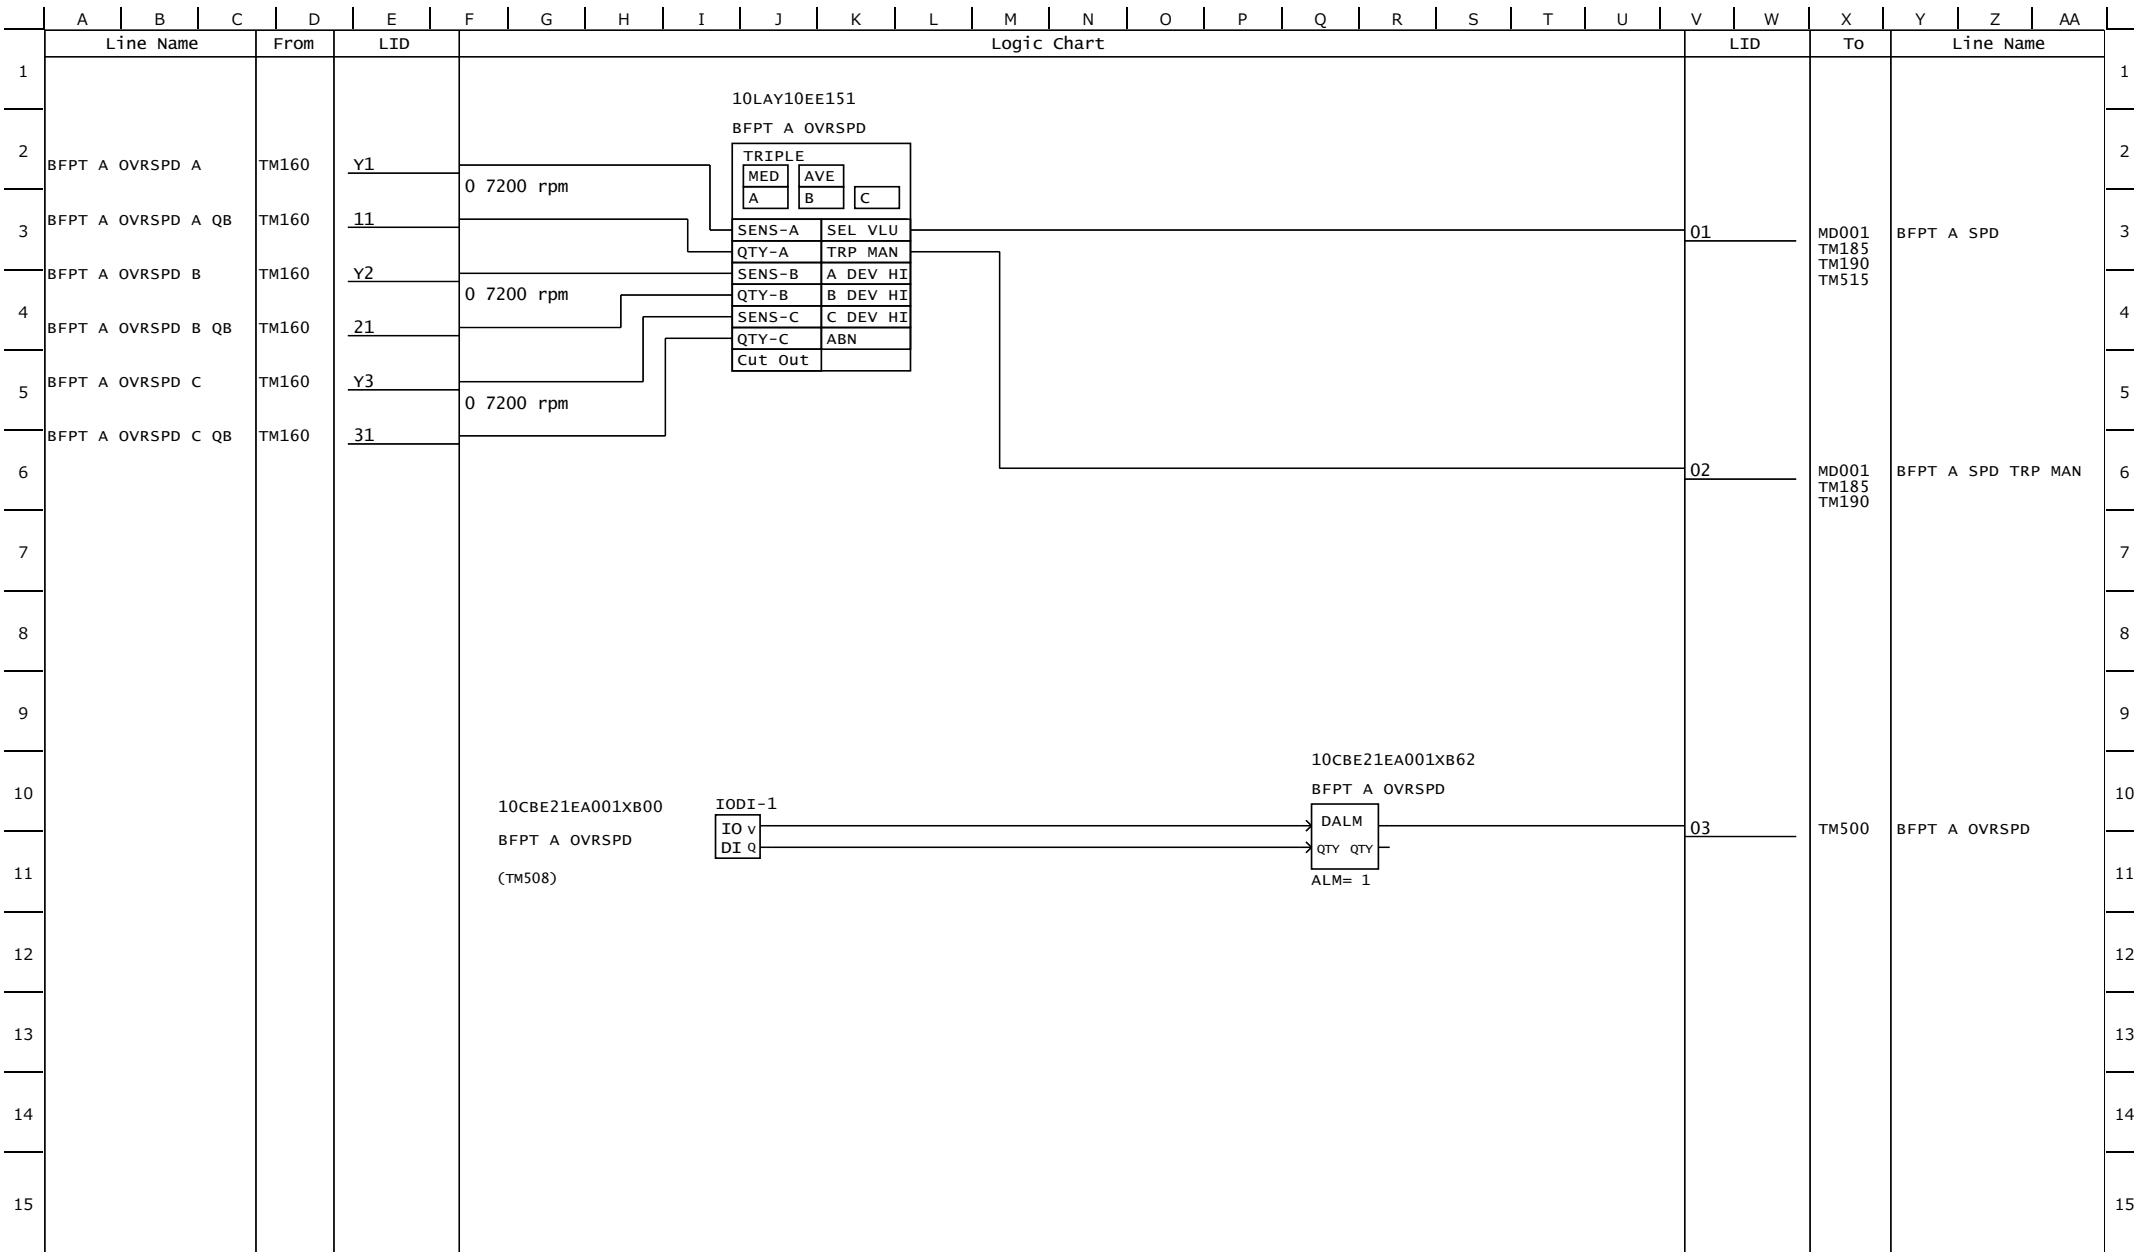

Rev. No.	0	1	2	3				PROJECT	(TSQ B)			
DATE	2021/6/21	2021/12/15	2022/11/8	2023/7/5				Van Phong 1 BOT Thermal Power Plant Project 2×673MW				
CONTENTS	1st Issue	Revised (0007, 0015, 0016)	Revised & Tuning (0062, 0064)	Revised (0186)				TITLE	DRAWING No.	SH	REV. MARK	
								BFPT A OVER SPEED	4GCH01007	TM193	3	
								Equipment No. : -				

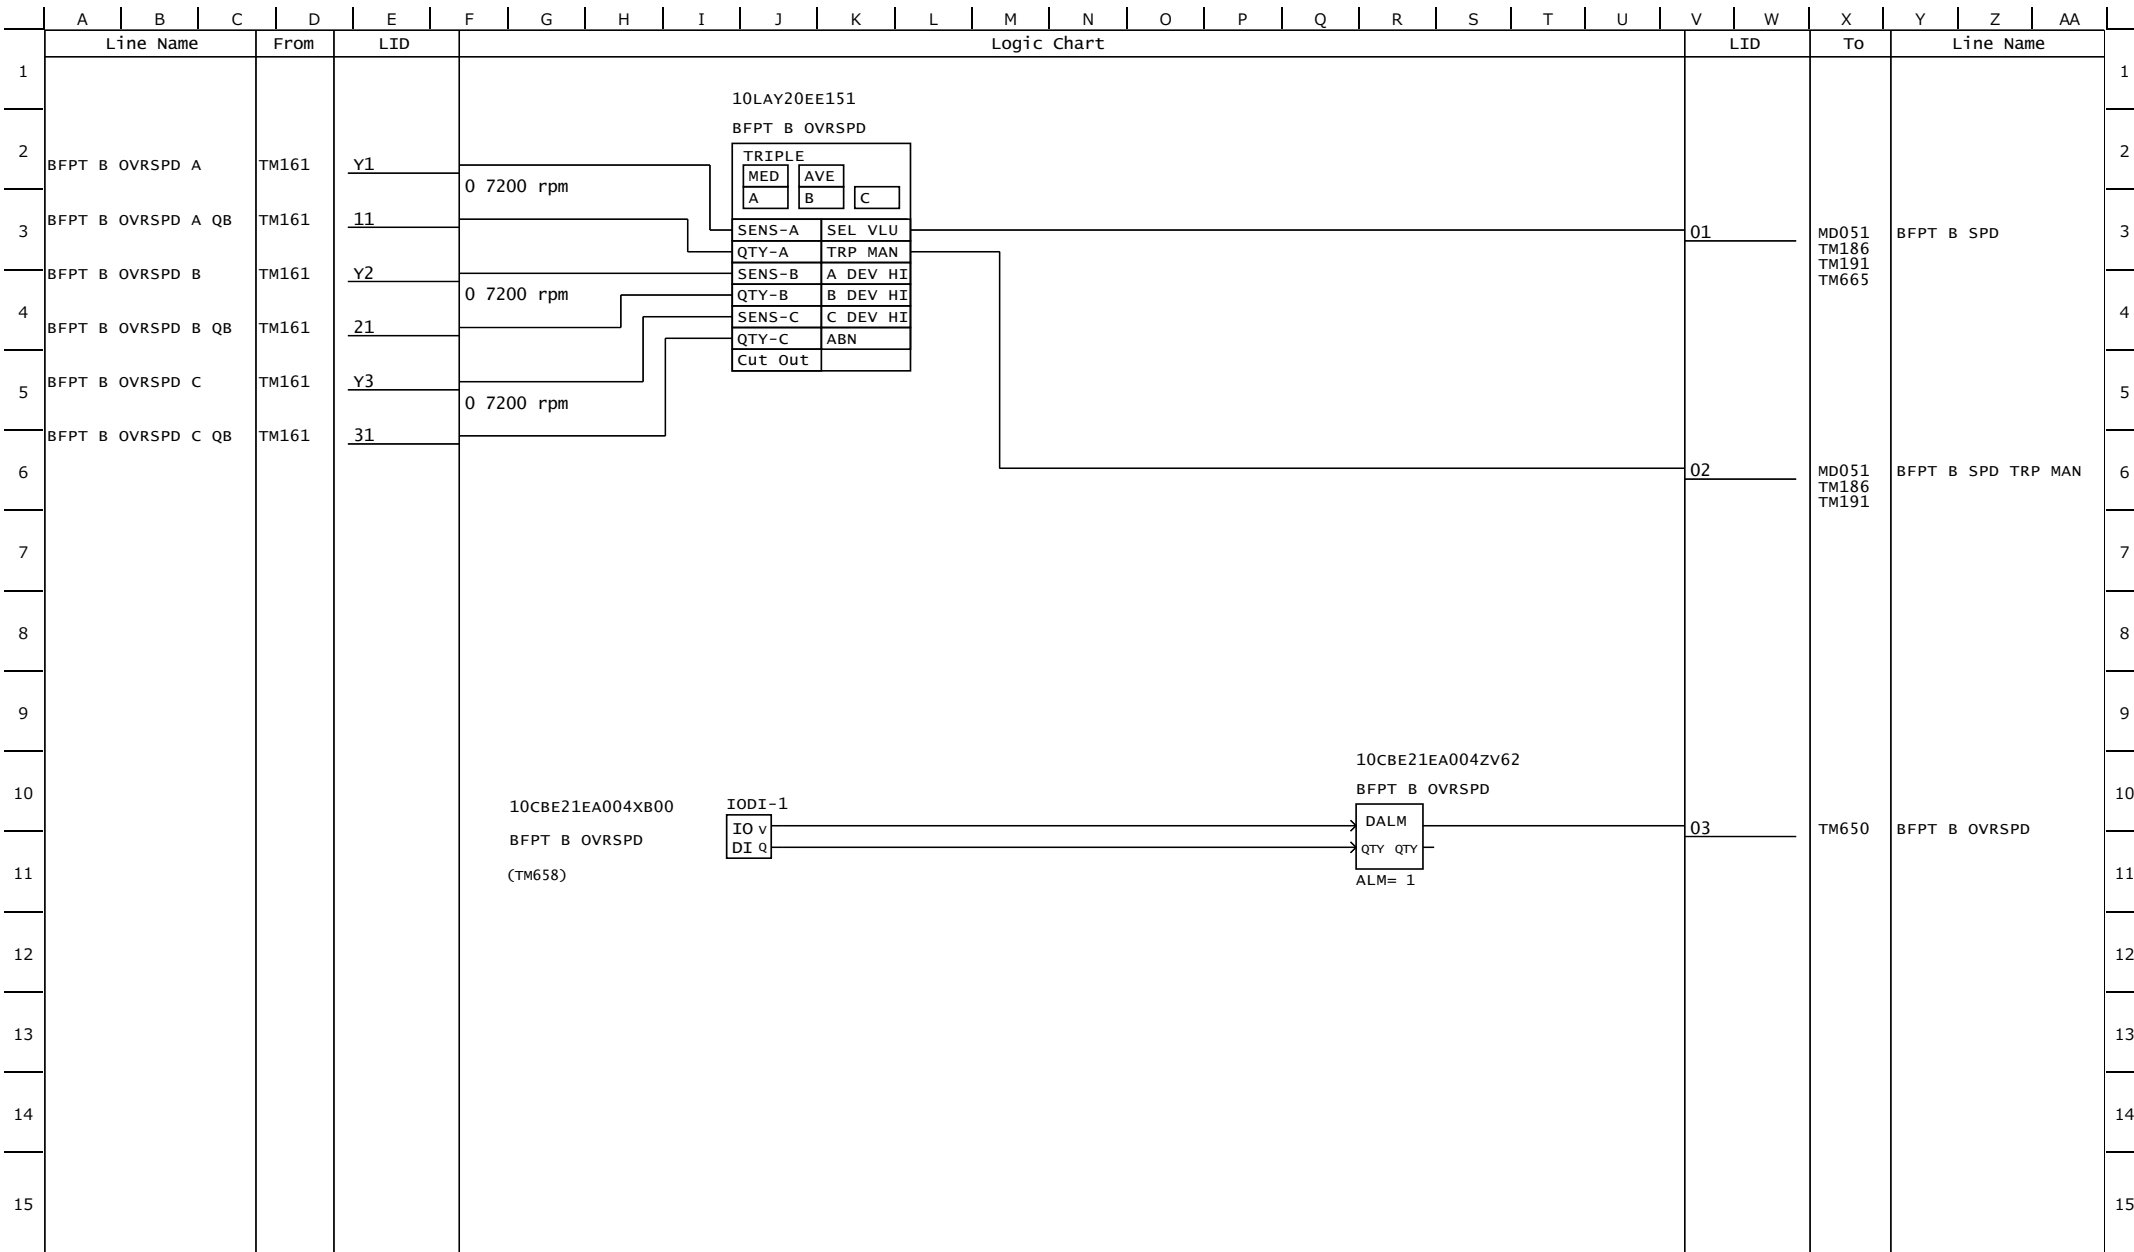

Rev. No.	0	1	2	3				PROJECT	(TSQ B)			
DATE	2021/6/21	2021/12/15	2022/11/8	2023/7/5				Van Phong 1 BOT Thermal Power Plant Project 2×673MW				
CONTENTS	1st Issue	Revised (0007, 0015, 0016)	Revised & Tuning (0062, 0064)	Revised (0186)				TITLE	DRAWING No.	SH	REV. MARK	
								BFPT B OVER SPEED	4GCH01007	TM194	3	
Equipment No. : -												

	A	B	C	D	E	F	G	H	I	J	K	L	M	N	O	P	Q	R	S	T	U	V	W	X	Y	Z	AA						
	Line Name			From	LID	Logic Chart																	LID	To	Line Name								
1																												1					
2																												2					
3																												3					
4																												4					
5																												5					
6																												6					
7																												7					
8																												8					
9																												9					
10																												10					
11																												11					
12																												12					
13																												13					
14																												14					
15																												15					
Rev. No.		0		1										PROJECT		(TSQ B)																	
DATE		2021/6/21		2021/12/15										Van Phong 1 BOT Thermal Power Plant Project 2×673MW																			
CONTENTS		1st Issue		Revised (0007, 0015)										TITLE		DRAWING No.				SH		REV. MARK											
														M-BFP SPEED		4GCH01007				TM195		1											
														Equipment No. : -																			

	A	B	C	D	E	F	G	H	I	J	K	L	M	N	O	P	Q	R	S	T	U	V	W	X	Y	Z	AA						
	Line Name			From	LID	Logic Chart																	LID	To	Line Name								
1																												1					
2						10LAC30AP010XB01 MBFP MOT 1 RUN MV SWGR IODI-1 IO v DI q DDL QTY QTY 10LAC30AP010XB01 MBFP MOT 1 RUN QTY QTY																	Z1	TM100 TM320 TM330	MBFP MOT 1 RUN			2					
3																							11	TM921	MBFP MOT 1 RUN QB			3					
4						10LAC30AP010XB04 MBFP MOT 1 STPD MV SWGR IODI-2 IO v DI q DDL QTY QTY 10LAC30AP010XB04 MBFP MOT 1 STPD QTY QTY																	Z2	TM320 TM920	MBFP MOT 1 STPD			4					
5																							12	TM921	MBFP MOT 1 STPD QB			5					
6						10LAC30AP010XB41 MBFP MOT 1 NOT E-FAI L MV SWGR IODI-3 IO v DI q DDL QTY QTY 10LAC30AP010XB41 MBFP MOT 1 NOT E-FAI L																	Z6	TM320	MBFP MOT 1 NOT E-FAI L			6					
7																												7					
8						10LAC30AP010XB33 MBFP MOT 1 RMT SEL MV SWGR IODI-5 IO v DI q DDL QTY QTY 10LAC30AP010XB33 MBFP MOT 1 RMT SEL QTY QTY																	Z7	TM321	MBFP MOT 1 RMT SEL			8					
9																												9					
10						10LAC30AP010XB78 MBFP MOT 1 RDY/STRT MV SWGR IODI-4 IO v DI q DDL QTY QTY 10LAC30AP010XB78 MBFP MOT 1 RDY/STRT QTY QTY																	Z9	TM320	MBFP MOT 1 RDY/STRT			10					
11																												11					
12						10LAC30AP010XB50 MBFP MOT 1 MOT RESTR T INH MV SWGR IODI-6 IO v DI q DALM QTY QTY 10LAC30AP010XB50 MBFP MOT 1 MOT RESTR T INH																	ZA	TM321	MBFP MOT 1 MOT RESTR T INH			12					
13						ALM= 1																						13					
14																												14					
15																												15					
	Rev. No.	0	1																				(TSQ B)										
	DATE	2021/6/21	2021/12/15																				PROJECT Van Phong 1 BOT Thermal Power Plant Project 2×673MW										
	CONTENTS	1st Issue	Revised (0015, 0024, 0026)																				DRAWING No.					SH		REV. MARK			
																							4GCH01007					TM200		1			
																							Equipment No. : -										

	A	B	C	D	E	F	G	H	I	J	K	L	M	N	O	P	Q	R	S	T	U	V	W	X	Y	Z	AA									
	Line Name			From	LID	Logic Chart																			LID	To	Line Name									
1																													1							
2						10LAC30AP010XB02 MBFP MOT 2 RUN MV SWGR IODI-1 IO v DI q MBFP MOT 2 RUN DDL QTY QTY 10LAC30AP010XB02 MBFP MOT 2 RUN MV SWGR																			Z1	TM100 TM320 TM330	MBFP MOT 2 RUN		2							
3																									11	TM921	MBFP MOT 2 RUN QB		3							
4						10LAC30AP010XB05 MBFP MOT 2 STPD MV SWGR IODI-2 IO v DI q MBFP MOT 2 STPD DDL QTY QTY 10LAC30AP010XB05 MBFP MOT 2 STPD MV SWGR																			Z2	TM320 TM920	MBFP MOT 2 STPD		4							
5																									12	TM921	MBFP MOT 2 STPD QB		5							
6						10LAC30AP010XB51 MBFP MOT 2 NOT E-FAI L MV SWGR IODI-3 IO v DI q MBFP MOT 2 NOT E-FAI L DDL QTY QTY 10LAC30AP010XB51 MBFP MOT 2 NOT E-FAI L MV SWGR																			Z6	TM320	MBFP MOT 2 NOT E-FAI L		6							
7																													7							
8						10LAC30AP010XB35 MBFP MOT 2 RMT SEL MV SWGR IODI-5 IO v DI q MBFP MOT 2 RMT SEL DDL QTY QTY 10LAC30AP010XB35 MBFP MOT 2 RMT SEL MV SWGR																			Z7	TM321	MBFP MOT 2 RMT SEL		8							
9																													9							
10						10LAC30AP010XB79 MBFP MOT 2 RDY/STRT MV SWGR IODI-4 IO v DI q MBFP MOT 2 RDY/STRT DDL QTY QTY 10LAC30AP010XB79 MBFP MOT 2 RDY/STRT MV SWGR																			Z9	TM320	MBFP MOT 2 RDY/STRT		10							
11																													11							
12						10LAC30AP010XB52 MBFP MOT 2 MOT RESTR T INH MV SWGR IODI-6 IO v DI q MBFP MOT 2 MOT RESTR T INH DALM QTY QTY 10LAC30AP010XB52 MBFP MOT 2 MOT RESTR T INH MV SWGR																			ZA	TM321	MBFP MOT 2 MOT RESTR T INH		12							
13						ALM= 1																							13							
14																													14							
15																													15							
	Rev. No.	0	1																				(TSQ B)													
	DATE	2021/6/21	2021/12/15																				PROJECT													
																							Van Phong 1 BOT Thermal													
																							Power Plant Project 2×673MW													
	CONTENTS	1st Issue	Revised (0015, 0024, 0026)																				TITLE					DRAWING No.					SH	REV. MARK		
																							FIELD DI PROCESSING (2)					4GCH01007					TM201	1		
																							Equipment No. : -													

	A	B	C	D	E	F	G	H	I	J	K	L	M	N	O	P	Q	R	S	T	U	V	W	X	Y	Z	AA			
	Line Name			From	LID	Logic Chart																	LID	To	Line Name					
1						10LAB11AA001XB01 TBFP A BSTR PP I/L V LV OPN LOCAL IODI-5 IO V DI Q 10LAB12AA001XB01 TBFP B BSTR PP I/L V LV OPN LOCAL IODI-6 IO V DI Q 10LAB11AA001XB01 TBFP A BSTR PP I/L V LV OPN DDL QTY QTY 10LAB12AA001XB01 TBFP B BSTR PP I/L V LV OPN DDL QTY QTY																	Y5	TM190 TM447	TBFP A BSTR PP I/L V LV OPN	1				
2																										2				
3																										3				
4																										4				
5																										5				
6																										6				
7																										7				
8																										8				
9																										9				
10																										10				
11																										11				
12																										12				
13																										13				
14																										14				
15																										15				
Rev. No.			0	1	3										PROJECT			(TSQ B)												
DATE			2021/6/21	2021/12/15	2023/7/5										Van Phong 1 BOT Thermal Power Plant Project 2×673MW															
CONTENTS			1st Issue	Revised (0015)	Revised (0155)										TITLE			DRAWING No.					SH		REV. MARK					
															FIELD DI PROCESSING (4)			4GCH01007					TM203		3					
															Equipment No. : -															

	A	B	C	D	E	F	G	H	I	J	K	L	M	N	O	P	Q	R	S	T	U	V	W	X	Y	Z	AA																												
	Line Name			From	LID	Logic Chart																	LID	To	Line Name																														
1						10LAV30CP101XB55 MBFP LUBE OIL PRESS HI A LOCAL IODI-1 IO v DI q DDL QTY QTY 10LAV30CP102XB55 MBFP LUBE OIL PRESS HI B LOCAL IODI-2 IO v DI q DDL QTY QTY 10LAV30CP102XB56 MBFP LUBE OIL PRESS LO LOCAL IODI-3 IO v DI q DALM QTY QTY ALM= 1 10LAV30CP101XB56 MBFP LUBE OIL PRESS LO LO LOCAL IODI-4 IO v DI q DALM QTY QTY ALM= 1																			MBFP LUBE OIL PRESS HI A MBFP LUBE OIL PRESS HI A QB MBFP LUBE OIL PRESS HI B MBFP LUBE OIL PRESS HI B QB MBFP LUBE OIL PRESS LO MBFP LUBE OIL PRESS LO QB MBFP LUBE OIL PRESS LO LO MBFP LUBE OIL PRESS LO LO QB																														
2																							Y1																															2	
3																							11																																3
4																							Y2																																4
5																							21																																5
6																																																							6
7																							Y3																																7
8																							31																																8
9																							Y4																																9
10																							41																																10
11																																																							11
12																																																							12
13																																																							13
14																																																							14
15																																																							15
Rev. No.		0		1		2										PROJECT				(TSQ B)																																			
DATE		2021/6/21		2021/12/15		2022/11/8										Van Phong 1 BOT Thermal Power Plant Project 2×673MW																																							
CONTENTS		1st Issue		Revised (0015)		TUNING (0064)										TITLE				DRAWING No.					SH		REV. MARK																												
																FIELD DI PROCESSING (5)				4GCH01007					TM204		2																												
																Equipment No. : -																																							

	A	B	C	D	E	F	G	H	I	J	K	L	M	N	O	P	Q	R	S	T	U	V	W	X	Y	Z	AA																																																																																																																																																																																																																																																																																																																																																																																																																																																											
	Line Name			From	LID	Logic Chart																		LID	To	Line Name																																																																																																																																																																																																																																																																																																																																																																																																																																																												
1																												1																																																																																																																																																																																																																																																																																																																																																																																																																																																										
2																												2																																																																																																																																																																																																																																																																																																																																																																																																																																																										
3																												3																																																																																																																																																																																																																																																																																																																																																																																																																																																										
4																												4																																																																																																																																																																																																																																																																																																																																																																																																																																																										
5																												5																																																																																																																																																																																																																																																																																																																																																																																																																																																										
6																												6																																																																																																																																																																																																																																																																																																																																																																																																																																																										
7																												7																																																																																																																																																																																																																																																																																																																																																																																																																																																										
8																												8																																																																																																																																																																																																																																																																																																																																																																																																																																																										
9																												9																																																																																																																																																																																																																																																																																																																																																																																																																																																										
10																												10																																																																																																																																																																																																																																																																																																																																																																																																																																																										
11																												11																																																																																																																																																																																																																																																																																																																																																																																																																																																										
12																												12																																																																																																																																																																																																																																																																																																																																																																																																																																																										
13																												13																																																																																																																																																																																																																																																																																																																																																																																																																																																										
14																												14																																																																																																																																																																																																																																																																																																																																																																																																																																																										
15																												15																																																																																																																																																																																																																																																																																																																																																																																																																																																										
	Rev. No.		0	1	2																																																																																																																																																																																																																																																																																																																																																																																																																																																																																	

	A	B	C	D	E	F	G	H	I	J	K	L	M	N	O	P	Q	R	S	T	U	V	W	X	Y	Z	AA			
	Line Name			From	LID	Logic Chart																	LID	To	Line Name					
1																												1		
2						10LAC30CS101XB55 MBFP REV ROTN A DET LOCAL IODI-1 IO v DI Q DALM QTY QTY ALM= 1 10LAC30CS101XB55 MBFP REV ROTN B DET LOCAL IODI-2 IO v DI Q DALM QTY QTY ALM= 1 10LAB31CP105XB55 TBFP A BALANCING L/O LN DP HI IODI-3 IO v DI Q DALM QTY QTY ALM= 1 10LAB32CP105XB55 TBFP B BALANCING L/O LN DP HI IODI-4 IO v DI Q DALM QTY QTY ALM= 1 10LAB33CP105XB55 MBFP BALANCING L/O L N DP HI IODI-5 IO v DI Q DALM QTY QTY ALM= 1																			Y1		MBFP REV ROTN A DET			2
3																							11		MBFP REV ROTN A DET QB			3		
4																									Y2		MBFP REV ROTN B DET			4
5																							21		MBFP REV ROTN B DET QB			5		
6																												6		
7																									Y3		TBFP A BALANCING L/O			7
8																							31		TBFP A BALANCING L/O LN DP HI QB			8		
9																												9		
10																									Y4		TBFP B BALANCING L/O			10
11																							41		TBFP B BALANCING L/O LN DP HI QB			11		
12																							Y5		MBFP BALANCING L/O L			12		
13																							51		MBFP BALANCING L/O L N DP HI QB			13		
14																												14		
15																												15		

Rev. No.	0	1	2					PROJECT Van Phong 1 BOT Thermal Power Plant Project 2×673MW	(TSQ B)			
DATE	2021/6/21	2021/12/15	2022/11/8									
CONTENTS	1st Issue	Revised (0015,0016, 0026)	TUNING (0064)					TITLE	DRAWING No.	SH	REV. MARK	
								FIELD DI PROCESSING (7)	4GCH01007	TM206	2	
								Equipment No. : -				

	A	B	C	D	E	F	G	H	I	J	K	L	M	N	O	P	Q	R	S	T	U	V	W	X	Y	Z	AA			
	Line Name			From	LID	Logic Chart																		LID	To	Line Name				
1																													1	
2						10PGB30CF101XB55 MBFP BSTR PP CLG RTN SL WTR HDR FLW LO LOCAL IODI-1 IO v DI q 10PGB30CF101XB55 MBFP BSTR PP CLG RTN SL WTR HDR FLW LO ALM= 1 DALM QTY QTY																		Y1		MBFP BSTR PP CLG RTN SL WTR HDR FLW LO			2	
3																								11		MBFP BSTR PP CLG RTN SL WTR HDR FLW L QB			3	
4						10PGB30CF102XB55 MBFP CLG RTN SL WTR HDR FLW LO LOCAL IODI-2 IO v DI q 10PGB30CF102XB55 MBFP CLG RTN SL WTR HDR FLW LO ALM= 1 DALM QTY QTY																		Y2		MBFP CLG RTN SL WTR HDR FLW LO			4	
5																								21		MBFP CLG RTN SL WTR HDR FLW LO QB			5	
6						10PGB30CF103XB55 MBFP LUBE OIL CLG RT N WTR FLW LO LOCAL IODI-3 IO v DI q 10PGB30CF103XB55 MBFP LUBE OIL CLG RT N WTR FLW LO ALM= 1 DALM QTY QTY																		Y3		MBFP LUBE OIL CLG RT N WTR FLW LO			6	
7																								31		MBFP LUBE OIL CLG RT N WTR FLW LO QB			7	
8						10PGB30CF104XB55 MBFP WKG OIL RTN WTR FLW LO LOCAL IODI-4 IO v DI q 10PGB30CF104XB55 MBFP WKG OIL RTN WTR FLW LO ALM= 1 DALM QTY QTY																		Y4		MBFP WKG OIL RTN WTR FLW LO			8	
9																								41		MBFP WKG OIL RTN WTR FLW LO QB			9	
10						10PGB30CF105XB55 MBFP MOT 1 CLG RTN W TR FLW LO LOCAL IODI-5 IO v DI q 10PGB30CF105XB55 MBFP MOT 1 CLG RTN W TR FLW LO ALM= 1 DALM QTY QTY																		Y5		MBFP MOT 1 CLG RTN W TR FLW LO			10	
11																								51		MBFP MOT 1 CLG RTN W TR FLW LO QB			11	
12						10PGB30CF106XB55 MBFP MOT 2 CLG RTN W TR FLW LO LOCAL IODI-6 IO v DI q 10PGB30CF106XB55 MBFP MOT 2 CLG RTN W TR FLW LO ALM= 1 DALM QTY QTY																		Y6		MBFP MOT 2 CLG RTN W TR FLW LO			12	
13																								61		MBFP MOT 2 CLG RTN W TR FLW LO QB			13	
14																													14	
15																													15	
	Rev. No.	0	1	2																				(TSQ B)						
	DATE	2021/6/21	2021/12/15	2022/11/8																										
	CONTENTS	1st Issue	Revised (0015, 0026)	TUNING (0064)																				DRAWING No.		SH		REV. MARK		
																								4GCH01007		TM207		2		

	A	B	C	D	E	F	G	H	I	J	K	L	M	N	O	P	Q	R	S	T	U	V	W	X	Y	Z	AA	
	Line Name			From	LID	Logic Chart																	LID	To	Line Name			
1																												1
2																												2
3																												3
4																							A	TM300	BFPT A BKUP OVRSPD			4
5																												5
6																												6
7																												7
8																												8
9																							Y4	TM301	BFPT A BRG VIB HI HI A			9
10																							Y5	TM301	BFPT A BRG VIB HI HI B			10
11																												11
12																							Y6	TM301	BFPT A BRG VIB HI HI C			12
13																												13
14																												14
15																												15

Rev. No.	0	1	2					PROJECT	(TSQ B)						
DATE	2021/6/21	2021/12/15	2022/11/8					Van Phong 1 BOT Thermal Power Plant Project 2×673MW							
CONTENTS	1st Issue	Revised (0015, 0016, 0024, 0026)	Revised (0062)					FIELD DI PROCESSING (61)	DRAWING No.	SH	REV. MARK				
								Equipment No. : -	4GCH01007	TM260	2				

	A	B	C	D	E	F	G	H	I	J	K	L	M	N	O	P	Q	R	S	T	U	V	W	X	Y	Z	AA																																																																	
	Line Name			From	LID	Logic Chart																	LID	To	Line Name																																																																			
1						10CWA10EA008XB00 BFPT A MAN TRIP PB A CCR IODI-4 IO v DI Q DDL QTY QTY 10CWA10EA013XB00 BFPT A MAN TRIP PB B CCR IODI-5 IO v DI Q DDL QTY QTY 10CWA10EA014XB00 BFPT A MAN TRIP PB C CCR IODI-6 IO v DI Q DDL QTY QTY 2 Y1 Y2 Y3 Y4 TM503 <tr><td>2</td><td colspan="3">BFPT A MAN TRIP PB A</td><td></td></tr> <tr><td>3</td><td colspan="3"></td><td></td></tr> <tr><td>4</td><td colspan="3">BFPT A MAN TRIP PB B</td><td></td></tr> <tr><td>5</td><td colspan="3"></td><td></td></tr> <tr><td>6</td><td colspan="3">BFPT A MAN TRIP PB C</td><td></td></tr> <tr><td>7</td><td colspan="3"></td><td></td></tr> <tr><td>8</td><td colspan="3"></td><td></td></tr> <tr><td>9</td><td colspan="3">BFPT A MAN TRIP PB (CCR)</td><td></td></tr> <tr><td>10</td><td colspan="3"></td><td></td></tr> <tr><td>11</td><td colspan="3"></td><td></td></tr> <tr><td>12</td><td colspan="3"></td><td></td></tr> <tr><td>13</td><td colspan="3"></td><td></td></tr> <tr><td>14</td><td colspan="3"></td><td></td></tr> <tr><td>15</td><td colspan="3"></td><td></td></tr>																	2	BFPT A MAN TRIP PB A				3					4	BFPT A MAN TRIP PB B				5					6	BFPT A MAN TRIP PB C				7					8					9	BFPT A MAN TRIP PB (CCR)				10					11					12					13					14					15				
2																							BFPT A MAN TRIP PB A																																																																					
3																																																																																												
4																							BFPT A MAN TRIP PB B																																																																					
5																																																																																												
6																							BFPT A MAN TRIP PB C																																																																					
7																																																																																												
8																																																																																												
9																							BFPT A MAN TRIP PB (CCR)																																																																					
10																																																																																												
11																																																																																												
12																																																																																												
13																																																																																												
14																																																																																												
15																																																																																												

10CWA10EA014XB00

BFPT A MAN TRIP PB C

CCR

IODI-6

IO v

DI Q

DDL

QTY QTY

10CWA10EA008XB00

BFPT A MAN TRIP PB A

10CWA10EA013XB00

BFPT A MAN TRIP PB B

10CWA10EA014XB00

BFPT A MAN TRIP PB C

Y1

Y2

Y3

Y4

TM503

BFPT A MAN TRIP PB A

BFPT A MAN TRIP PB B

BFPT A MAN TRIP PB C

BFPT A MAN TRIP PB (CCR)

Rev. No.	0	1	2					PROJECT	(TSQ B)				
DATE	2021/6/21	2021/12/15	2022/11/8					Van Phong 1 BOT Thermal Power Plant Project 2×673MW					
CONTENTS	1st Issue	Revised (0015, 0026)	Revised (0064)					FIELD DI PROCESSING (62)	DRAWING No.	SH	REV. MARK		
								Equipment No. : -	4GCH01007	TM261	2		

	A	B	C	D	E	F	G	H	I	J	K	L	M	N	O	P	Q	R	S	T	U	V	W	X	Y	Z	AA		
	Line Name			From	LID	Logic Chart																		LID	To	Line Name			
1																													1
2						10XAA10AA601XB04 BFPT A MSV CLS LOCAL IODI-1 IO v DI Q 10XAA10AA601XB04 BFPT A MSV CLS LOCAL DDL QTY QTY Y1 <td>TM510</td> <td>TM579</td> <td colspan="3">BFPT A MSV CLS</td> <td>2</td>																		TM510	TM579	BFPT A MSV CLS			2
3																													3
4						10XAA10AA601XB01 BFPT A MSV OPN LOCAL IODI-2 IO v DI Q 10XAA10AA601XB01 BFPT A MSV OPN LOCAL DDL QTY QTY Y2 <td>TM510</td> <td></td> <td colspan="3">BFPT A MSV OPN</td> <td>4</td>																		TM510		BFPT A MSV OPN			4
5																													5
6						10XAX11CP110XB65 BFPT A LUBE OIL PRS LO SEC MOP STRT LOCAL IODI-3 IO v DI Q 10XAX11CP110XB65 BFPT A LUBE OIL PRS LO SEC MOP STRT LOCAL DDL QTY QTY Y3 <td>TM532</td> <td></td> <td colspan="3">BFPT A LUBE OIL PRS LO SEC MOP STRT</td> <td>6</td>																		TM532		BFPT A LUBE OIL PRS LO SEC MOP STRT			6
7																													7
8																													8
9																													9
10						10CFA10EA104XB00 BFPT A THRBRG POSN A BN TRIP A TSI IODI-5 IO v DI Q 10CFA10EA104XB00 BFPT A THRBRG POSN A BN TRIP A TSI DDL QTY QTY Y5 <td>TM301</td> <td></td> <td colspan="3">BFPT A THRBRG POSN A BN TRIP A</td> <td>10</td>																		TM301		BFPT A THRBRG POSN A BN TRIP A			10
11																													11
12						10CFA10EA105XB00 BFPT A THRBRG POSN A BN TRIP B TSI IODI-6 IO v DI Q 10CFA10EA105XB00 BFPT A THRBRG POSN A BN TRIP B TSI DDL QTY QTY Y6 <td>TM301</td> <td></td> <td colspan="3">BFPT A THRBRG POSN A BN TRIP B</td> <td>12</td>																		TM301		BFPT A THRBRG POSN A BN TRIP B			12
13																													13
14						10CFA10EA106XB00 BFPT A THRBRG POSN A BN TRIP C TSI IODI-7 IO v DI Q 10CFA10EA106XB00 BFPT A THRBRG POSN A BN TRIP C TSI DDL QTY QTY Y7 <td>TM301</td> <td></td> <td colspan="3">BFPT A THRBRG POSN A BN TRIP C</td> <td>14</td>																		TM301		BFPT A THRBRG POSN A BN TRIP C			14
15																													15
	Rev. No.	0	1	2							PROJECT				(TSQ B)														
	DATE	2021/6/21	2021/12/15	2022/11/8							Van Phong 1 BOT Thermal Power Plant Project 2×673MW																		
	CONTENTS	1st Issue	Revised (0015, 0024, 0026)	Revised (0064)							TITLE				DRAWING No.				SH		REV. MARK								
											FIELD DI PROCESSING (63)				4GCH01007				TM262		2								
											Equipment No. : -																		

	A	B	C	D	E	F	G	H	I	J	K	L	M	N	O	P	Q	R	S	T	U	V	W	X	Y	Z	AA	
	Line Name			From	LID	Logic Chart																	LID	To	Line Name			
1																												1
2						10XAA10AE001xB02 BFPT A T-GEAR CLU SO LV ENRGZ LOCAL	IODI-1 IO v DI q											10XAA10AE001xB02 BFPT A T-GEAR CLU SO LV ENRGZ	DDL QTY QTY	Y1	MG051 TM519 TM521	BFPT A T-GEAR CLU SO LV ENRGZ			2			
3																												3
4																												4
5						10CFA10EA011xB00 BFPT A ZERO SPD <2RP M TSI	IODI-2 IO v DI q											10CFA10EA011xB00 BFPT A ZERO SPD <2RP M	DDL QTY QTY	Y2	TM519 TM830	BFPT A ZERO SPD <2RP M			5			
6																												6
7																												7
8						10CGB10EA010XB00 BFPT A EHC HEAVY FAI L A BFPT EHC (TM506)	IODI-3 IO v DI q											10CGB10EA010XB00 BFPT A EHC HEAVY FAI L A	DDL QTY QTY	Y3	TM300	BFPT A EHC HEAVY FAI L A			9			
9																												10
10																												11
11						10CGB10EA003XB00 BFPT A EHC HEAVY FAI L B BFPT EHC (TM506)	IODI-4 IO v DI q											10CGB10EA003XB00 BFPT A EHC HEAVY FAI L B	DDL QTY QTY	Y4	TM300	BFPT A EHC HEAVY FAI L B			12			
12																												13
13																												14
14																												15

Y1

MG051

TM519

TM521

BFPT A T-GEAR CLU SO

LV ENRGZ

Rev. No.	0	1	3					PROJECT	(TSQ B)						
DATE	2021/6/21	2021/12/15	2023/7/5					Van Phong 1 BOT Thermal Power Plant Project 2×673MW							
CONTENTS	1st Issue	Revised (0007,0015, 0016)	Revised (0163)					FIELD DI PROCESSING (64)	DRAWING No.	SH	REV. MARK				
								Equipment No. : -	4GCH01007	TM263	3				

	A	B	C	D	E	F	G	H	I	J	K	L	M	N	O	P	Q	R	S	T	U	V	W	X	Y	Z	AA	
	Line Name			From	LID	Logic Chart																	LID	To	Line Name			
1						10LAC10CS101XB55 TBFP A REV ROTN A DE T LOCAL IODI-1 IO V DI Q 10LAC10CS101XB55 TBFP A REV ROTN A DE T DALM QTY QTY ALM= 1 Y1 11 10LAC10CS101XB56 TBFP A REV ROTN B DE T LOCAL IODI-2 IO V DI Q 10LAC10CS101XB56 TBFP A REV ROTN B DE T DALM QTY QTY ALM= 1 Y2 21																						
2																												
3																												
Rev. No.	0	1	2					PROJECT	(TSQ B)						
DATE	2021/6/21	2021/12/15	2022/11/8					Van Phong 1 BOT Thermal Power Plant Project 2×673MW							
CONTENTS	1st Issue	Revised (0015, 0026)	TUNING (0064)					FIELD DI PROCESSING (66)	DRAWING No.	SH	REV. MARK				
								Equipment No. : -	4GCH01007	TM265	2				

	A	B	C	D	E	F	G	H	I	J	K	L	M	N	O	P	Q	R	S	T	U	V	W	X	Y	Z	AA	
	Line Name			From	LID	Logic Chart																	LID	To	Line Name			
1																												1
2																												2
3																							Y1		TBFP A BP CLG RTN SL WTR HDR FLW LO			3
4																							11		TBFP A BP CLG RTN SL WTR HDR FLW LO QB			4
5																							Y2		TBFP A CLG RTN SL WT R HDR FLW LO			5
6																							21		TBFP A CLG RTN SL WT R HDR FLW LO QB			6
7																												7
8																												8
9																												9
10																												10
11																												11
12																												12
13																												13
14																												14
15																												15

Rev. No.	0	1	2					PROJECT	(TSQ B)			
DATE	2021/6/21	2021/12/15	2022/11/8					Van Phong 1 BOT Thermal Power Plant Project 2×673MW				
CONTENTS	1st Issue	Revised (0015)	Revised & Tuning (0044, 0064)					TITLE	DRAWING No.	SH	REV. MARK	
								FIELD DI PROCESSING (67)	4GCH01007	TM266	2	
								Equipment No. : -				

	A	B	C	D	E	F	G	H	I	J	K	L	M	N	O	P	Q	R	S	T	U	V	W	X	Y	Z	AA	
	Line Name			From	LID	Logic Chart																	LID	To	Line Name			
1																												1
2																												2
3																												3
4																							A	TM310	BFPT B BKUP OVRSPD			4
5																												5
6																												6
7																												7
8																												8
9																							Y4	TM311	BFPT B BRG VIB HI HI A			9
10																							Y5	TM311	BFPT B BRG VIB HI HI B			10
11																												11
12																							Y6	TM311	BFPT B BRG VIB HI HI C			12
13																												13
14																												14
15																												15

Rev. No.	0	1	2					PROJECT Van Phong 1 BOT Thermal Power Plant Project 2×673MW	(TSQ B)		
DATE	2021/6/21	2021/12/15	2022/11/8								
CONTENTS	1st Issue	Revised (0015, 0016, 0024, 0026)	Revised (0062)					TITLE	DRAWING No.	SH	REV. MARK
								FIELD DI PROCESSING (71)	4GCH01007	TM270	2
								Equipment No. :	-		

	A	B	C	D	E	F	G	H	I	J	K	L	M	N	O	P	Q	R	S	T	U	V	W	X	Y	Z	AA	
	Line Name			From	LID	Logic Chart																	LID	To	Line Name			
1																												1
2						10CWA10EA012XB00 BFPT B MAN TRIP PB A CCR IODI-4 IO v DI Q DDL QTY QTY 10CWA10EA018XB00 BFPT B MAN TRIP PB B CCR IODI-5 IO v DI Q DDL QTY QTY 10CWA10EA019XB00 BFPT B MAN TRIP PB C CCR IODI-6 IO v DI Q DDL QTY QTY																						

Y1

Y2

Y3

Y4

TM653

BFPT B MAN TRIP PB A

BFPT B MAN TRIP PB B

BFPT B MAN TRIP PB C

BFPT B MAN TRIP PB (CCR)

	A	B	C	D	E	F	G	H	I	J	K	L	M	N	O	P	Q	R	S	T	U	V	W	X	Y	Z	AA	
	Line Name			From	LID	Logic Chart																	LID	To	Line Name			
1																												1
2						10XAA20AA601XB04 BFPT B MSV CLS LOCAL IODI-1 IO v DI Q 10XAA20AA601XB04 BFPT B MSV CLS DDL QTY QTY Y1																	TM660 TM729	BFPT B MSV CLS			2	
3																												3
4						10XAA20AA601XB01 BFPT B MSV OPN LOCAL IODI-2 IO v DI Q 10XAA20AA601XB01 BFPT B MSV OPN DDL QTY QTY Y2																	TM660	BFPT B MSV OPN			4	
5																												5
6						10XAX21CP110XB65 BFPT B LUBE OIL PRS LO SEC MOP STRT LOCAL IODI-3 IO v DI Q 10XAX21CP110XB65 BFPT B LUBE OIL PRS LO SEC MOP STRT DDL QTY QTY Y3																	TM682	BFPT B LUBE OIL PRS LO SEC MOP STRT			6	
7																												7
8																												8
9																												9
10						10CFA10EA204XB00 BFPT B THRBRG POSN A BN TRIP A TSI IODI-5 IO v DI Q 10CFA10EA204XB00 BFPT B THRBRG POSN A BN TRIP A DDL QTY QTY Y5																	TM311	BFPT B THRBRG POSN A BN TRIP A			10	
11																												11
12						10CFA10EA205XB00 BFPT B THRBRG POSN A BN TRIP B TSI IODI-6 IO v DI Q 10CFA10EA205XB00 BFPT B THRBRG POSN A BN TRIP B DDL QTY QTY Y6																	TM311	BFPT B THRBRG POSN A BN TRIP B			12	
13																												13
14						10CFA10EA206XB00 BFPT B THRBRG POSN A BN TRIP C TSI IODI-7 IO v DI Q 10CFA10EA206XB00 BFPT B THRBRG POSN A BN TRIP C DDL QTY QTY Y7																	TM311	BFPT B THRBRG POSN A BN TRIP C			14	
15																												15
	Rev. No.	0	1	2										PROJECT				(TSQ B)										
	DATE	2021/6/21	2021/12/15	2022/11/8										Van Phong 1 BOT Thermal Power Plant Project 2×673MW														
	CONTENTS	1st Issue	Revised (0015, 0024, 0026)	Revised (0064)										TITLE				DRAWING No.				SH		REV. MARK				
														FIELD DI PROCESSING (73)				4GCH01007				TM272		2				
														Equipment No. : -														

	A	B	C	D	E	F	G	H	I	J	K	L	M	N	O	P	Q	R	S	T	U	V	W	X	Y	Z	AA	
	Line Name			From	LID	Logic Chart																	LID	To	Line Name			
1																												1
2						10XAA20AE001xB02 BFPT B T-GEAR CLU SO LV ENRGZ LOCAL			IODI-1 IO v DI q														Y1	MG101 TM669 TM671	BFPT B T-GEAR CLU SO LV ENRGZ			2
3																												3
4																												4
5						10CFA10EA007xB00 BFPT B ZERO SPD <2RP M TSI			IODI-2 IO v DI q														Y2	TM669 TM840	BFPT B ZERO SPD <2RP M			5
6																												6
7																												7
8						10CGB20EA010xB00 BFPT B EHC HEAVY FAI L A BFPT EHC (TM656)			IODI-3 IO v DI q														Y3	TM310	BFPT B EHC HEAVY FAI L A			9
10																												10
11																												11
12						10CGB20EA003xB00 BFPT B EHC HEAVY FAI L B BFPT EHC (TM656)			IODI-4 IO v DI q														Y4	TM310	BFPT B EHC HEAVY FAI L B			12
13																												13
14																												14
15																												15

Y1

MG101
TM669
TM671BFPT B T-GEAR CLU SO
LV ENRGZ

Rev. No.	0	1	3					PROJECT Van Phong 1 BOT Thermal Power Plant Project 2×673MW	(TSQ B)		
DATE	2021/6/21	2021/12/15	2023/7/5								
CONTENTS	1st Issue	Revised (0007, 0015, 0016)	Revised (0163)					TITLE	DRAWING No.	SH	REV. MARK
								FIELD DI PROCESSING (74)	4GCH01007	TM273	3
								Equipment No. :	-		

	A	B	C	D	E	F	G	H	I	J	K	L	M	N	O	P	Q	R	S	T	U	V	W	X	Y	Z	AA				
	Line Name			From	LID	Logic Chart																	LID		To	Line Name					
1						10XAY21EZ031XB65 BFPT B MAN TRIP PB F ROM LCL A CCR IODI-4 IO v DI q DDL QTY QTY																			Y1			BFPT B MAN TRIP PB F ROM LCL A			2
2						10XAY21EZ031XB66 BFPT B MAN TRIP PB F ROM LCL B CCR IODI-5 IO v DI q DDL QTY QTY																			Y2			BFPT B MAN TRIP PB F ROM LCL B			4
3						10XAY21EZ031XB67 BFPT B MAN TRIP PB F ROM LCL C CCR IODI-6 IO v DI q DDL QTY QTY																			Y3			BFPT B MAN TRIP PB F ROM LCL C			6
4						10XAY21EZ031XB67 BFPT B MAN TRIP PB F ROM LCL C CCR IODI-6 IO v DI q DDL QTY QTY																			Y3			BFPT B MAN TRIP PB F ROM LCL C			7
5						10XAY21EZ031XB67 BFPT B MAN TRIP PB F ROM LCL C CCR IODI-6 IO v DI q DDL QTY QTY																			Y3			BFPT B MAN TRIP PB F ROM LCL C			7
Rev. No.	0	1	2					PROJECT	(TSQ B)						
DATE	2021/6/21	2021/12/15	2022/11/8					Van Phong 1 BOT Thermal Power Plant Project 2×673MW							
CONTENTS	1st Issue	Revised (0015)	Revised (0064, 0071)					FIELD DI PROCESSING (75)	DRAWING No.	SH	REV. MARK				
								Equipment No. : -	4GCH01007	TM274	2				

	A	B	C	D	E	F	G	H	I	J	K	L	M	N	O	P	Q	R	S	T	U	V	W	X	Y	Z	AA	
	Line Name			From	LID	Logic Chart																	LID	To	Line Name			
1						10LAC20CS101XB55 TBFP B REV ROTN A DE T LOCAL IODI-1 IO v DI Q 10LAC20CS101XB55 TBFP B REV ROTN A DE T LOCAL IODI-2 IO v DI Q 10LAC20CS101XB55 TBFP B REV ROTN A DE T LOCAL IODI-1 IO v DI Q 10LAC20CS101XB56 TBFP B REV ROTN B DE T LOCAL IODI-2 IO v DI Q 10LAC20CS101XB56 TBFP B REV ROTN B DE T LOCAL IODI-2 IO v DI Q 10LAC20CS101XB56 TBFP B REV ROTN B DE T LOCAL IODI-2 IO v DI Q 10LAC20CS101XB56 TBFP B REV ROTN B DE T LOCAL IODI-2 IO v DI Q 10LAC20CS101XB56 TBFP B REV ROTN B DE T LOCAL IODI-2 IO v DI Q																						

10LAC20CS101XB55

TBFP B REV ROTN B DE

T

LOCAL

IODI-1

IO V

DI Q

10LAC20CS101XB56

TBFP B REV ROTN B DE

T

LOCAL

IODI-2

IO V

DI Q

DALM

QTY QTY

ALM= 1

DALM

QTY QTY

ALM= 1

Y1

11

Y2

21

	A	B	C	D	E	F	G	H	I	J	K	L	M	N	O	P	Q	R	S	T	U	V	W	X	Y	Z	AA		
	Line Name			From	LID	Logic Chart																	LID	To	Line Name				
1						10PGB20CF101XB55 TBFP B BP CLG RTN SL WTR HDR FLW LO IODI-2 IO v DI Q DALM QTY QTY ALM= 1 10PGB20CF102XB55 TBFP B CLG RTN SL WT R HDR FLW LO IODI-1 IO v DI Q DALM QTY QTY ALM= 1																			TBFP B BP CLG RTN SL WTR HDR FLW LO TBFP B BP CLG RTN SL WTR HDR FLW LO QB TBFP B CLG RTN SL WT R HDR FLW LO TBFP B CLG RTN SL WT R HDR FLW LO QB				
2																													
3																							Y1						
4																													
5																							11						
6																													
7																													
8																													
9																													
10																													
11																							Y2						
12																													
13																													
14																							21						
15																													

Rev. No.	0	1	2					PROJECT	(TSQ B)						
DATE	2021/6/21	2021/12/15	2022/11/8					Van Phong 1 BOT Thermal Power Plant Project 2×673MW							
CONTENTS	1st Issue	Revised (0015)	Revised & Tuning (0044, 0064)					FIELD DI PROCESSING (77)	DRAWING No.	SH	REV. MARK				
								Equipment No. : -	4GCH01007	TM276	2				

	A	B	C	D	E	F	G	H	I	J	K	L	M	N	O	P	Q	R	S	T	U	V	W	X	Y	Z	AA	
	Line Name			From	LID	Logic Chart																	LID	To	Line Name			
1						10LAC20CP102XB55 TBFP B BSTR PP SL CL R FLTR NDE DP HI LOCAL IODI-2 IO v DI q 10LAC20CP102XB55 TBFP B BSTR PP SL CL R FLTR NDE DP HI DALM QTY QTY ALM= 1 10LAC20CP103XB55 TBFP B BSTR PP SL CL R FLTR DE DP HI LOCAL IODI-3 IO v DI q 10LAC20CP103XB55 TBFP B BSTR PP SL CL R FLTR DE DP HI DALM QTY QTY ALM= 1 10LAC20CP104XB55 TBFP B SL CLR FLTR N DE DP HI LOCAL IODI-4 IO v DI q 10LAC20CP104XB55 TBFP B SL CLR FLTR N DE DP HI DALM QTY QTY ALM= 1 10LAC20CP105XB55 TBFP B SL CLR FLTR D E DP HI LOCAL IODI-5 IO v DI q 10LAC20CP105XB55 TBFP B SL CLR FLTR D E DP HI DALM QTY QTY ALM= 1 Y2 21 Y3 31 Y4 41 Y5 51 <td colspan="3" rowspan="15">TBFP B BSTR PP SL CL R FLTR NDE DP HI TBFP B BSTR PP SL CL R FLTR NDE DP HI QB TBFP B BSTR PP SL CL R FLTR DE DP HI TBFP B BSTR PP SL CL R FLTR DE DP HI QB TBFP B SL CLR FLTR N DE DP HI TBFP B SL CLR FLTR N DE DP HI QB TBFP B SL CLR FLTR D E DP HI TBFP B SL CLR FLTR D E DP HI QB</td> <td>1</td>																	TBFP B BSTR PP SL CL R FLTR NDE DP HI TBFP B BSTR PP SL CL R FLTR NDE DP HI QB TBFP B BSTR PP SL CL R FLTR DE DP HI TBFP B BSTR PP SL CL R FLTR DE DP HI QB TBFP B SL CLR FLTR N DE DP HI TBFP B SL CLR FLTR N DE DP HI QB TBFP B SL CLR FLTR D E DP HI TBFP B SL CLR FLTR D E DP HI QB			1		
2																												
3																												
Rev.No.		0	1	2					PROJECT							(TSQ B)												
DATE		2021/6/21	2021/12/15	2022/11/8					Van Phong 1 BOT Thermal Power Plant Project 2×673MW																			
CONTENTS		1st Issue	Revised (0015, 0026)	TUNING (0064)					TITLE							DRAWING No.			SH	REV. MARK								
									FIELD DI PROCESSING (78)							4GCH01007			TM277	2								
									Equipment No. : -																			

	A	B	C	D	E	F	G	H	I	J	K	L	M	N	O	P	Q	R	S	T	U	V	W	X	Y	Z	AA																																																																																																																																																																																																																																																																																																																																																																																																																																																																																																																																																																																																																																																																																																																																																																																																																																																																																																																																																																																																																																																																																																																																																																							
	Line Name			From	LID	Logic Chart																	LID	To	Line Name																																																																																																																																																																																																																																																																																																																																																																																																																																																																																																																																																																																																																																																																																																																																																																																																																																																																																																																																																																																																																																																																																																																																																																									
1				JF360	A	10CJJ10EA051XB00 CONDR VAC LO LO A MT EHC IODI-1 IO v DI q OR Y1																	TM500	TM650	TM814	CONDR VAC LO LO			1																																																																																																																																																																																																																																																																																																																																																																																																																																																																																																																																																																																																																																																																																																																																																																																																																																																																																																																																																																																																																																																																																																																																																																					
2																																																																																																																																																																																																																																																																																																																																																																																																																																																																																																																																																																																																																																																																																																																																																																																																																																																																																																																																																																																																																																																																																																																																																																																																		
3																																																																																																																																																																																																																																																																																																																																																																																																																																																																																																																																																																																																																																																																																																																																																																																																																																																																																																																																																																																																																																																																																																																																																																																																		
4																																																																																																																																																																																																																																																																																																																																																																																																																																																																																																																																																																																																																																																																																																																																																																																																																																																																																																																																																																																																																																																																																																																																																																																																		
5																																																																																																																																																																																																																																																																																																																																																																																																																																																																																																																																																																																																																																																																																																																																																																																																																																																																																																																																																																																																																																																																																																																																																																																																		
6						10CJJ10EA052XB00 CONDR VAC LO LO B MT EHC IODI-2 IO v DI q																	Y1	TM500	TM650	TM814	CONDR VAC LO LO			2																																																																																																																																																																																																																																																																																																																																																																																																																																																																																																																																																																																																																																																																																																																																																																																																																																																																																																																																																																																																																																																																																																																																																																				
3																																																																																																																																																																																																																																																																																																																																																																																																																																																																																																																																																																																																																																																																																																																																																																																																																																																																																																																																																																																																																																																																																																																																																																																																		
4																																																																																																																																																																																																																																																																																																																																																																																																																																																																																																																																																																																																																																																																																																																																																																																																																																																																																																																																																																																																																																																																																																																																																																																																		
5																																																																																																																																																																																																																																																																																																																																																																																																																																																																																																																																																																																																																																																																																																																																																																																																																																																																																																																																																																																																																																																																																																																																																																																																		
6						10CHA30EA076XB00 HLO / BSO (TSQ) BPS IODI-3 IO v DI q A OR Y2																	Y2	TB740	HLO/BSO/TURB LOAD REJ			6																																																																																																																																																																																																																																																																																																																																																																																																																																																																																																																																																																																																																																																																																																																																																																																																																																																																																																																																																																																																																																																																																																																																																																						
7																																																																																																																																																																																																																																																																																																																																																																																																																																																																																																																																																																																																																																																																																																																																																																																																																																																																																																																																																																																																																																																																																																																																																																																																		
8																																																																																																																																																																																																																																																																																																																																																																																																																																																																																																																																																																																																																																																																																																																																																																																																																																																																																																																																																																																																																																																																																																																																																																																																		
9																																																																																																																																																																																																																																																																																																																																																																																																																																																																																																																																																																																																																																																																																																																																																																																																																																																																																																																																																																																																																																																																																																																																																																																																		
8						10CHA30EA075XB00 HLO (TSQ B) BPS IODI-4 IO v DI q DTD Y3																	Y3	TM981	HLO			8																																																																																																																																																																																																																																																																																																																																																																																																																																																																																																																																																																																																																																																																																																																																																																																																																																																																																																																																																																																																																																																																																																																																																																						
9																																																																																																																																																																																																																																																																																																																																																																																																																																																																																																																																																																																																																																																																																																																																																																																																																																																																																																																																																																																																																																																																																																																																																																																																		
10																																																																																																																																																																																																																																																																																																																																																																																																																																																																																																																																																																																																																																																																																																																																																																																																																																																																																																																																																																																																																																																																																																																																																																																																		
9																																																																																																																																																																																																																																																																																																																																																																																																																																																																																																																																																																																																																																																																																																																																																																																																																																																																																																																																																																																																																																																																																																																																																																																																		
10	TURB LOAD REJ			JF360	A																																																																																																																																																																																																																																																																																																																																																																																																																																																																																																																																																																																																																																																																																																																																																																																																																																																																																																																																																																																																																																																																																																																																																																																													</

Rev. No.	0	1	3					PROJECT	(TSQ B)			
DATE	2021/6/21	2021/12/15	2023/7/5					Van Phong 1 BOT Thermal Power Plant Project 2×673MW				
CONTENTS	1st Issue	Revised (0007, 0015)	Revised (0170, 0181)					TITLE	DRAWING No.	SH	REV. MARK	
								FIELD DI PROCESSING (81)	4GCH01007	TM280	3	
								Equipment No. : -				

	A	B	C	D	E	F	G	H	I	J	K	L	M	N	O	P	Q	R	S	T	U	V	W	X	Y	Z	AA
	Line Name			From	LID	Logic Chart																	LID	To	Line Name		
1						10CHA30EA073xB00 MFT (TSQ CTLR B) BPS IODI-1 IO v DI q → DTD → y1																		MB201 MH101 MH501 MH551 TB740 TE559 TM500 TM650 TM920	MFT		
2																											
3																											
Rev. No.			0	1						PROJECT				(TSQ B)													
DATE			2021/6/21	2021/12/15						Van Phong 1 BOT Thermal Power Plant Project 2×673MW																	
CONTENTS	1st Issue	Revised (0007, 0015)							TITLE				DRAWING No.				SH		REV. MARK								
									FIELD DI PROCESSING (82)				4GCH01007				TM281		1								
									Equipment No. : -																		

	A	B	C	D	E	F	G	H	I	J	K	L	M	N	O	P	Q	R	S	T	U	V	W	X	Y	Z	AA	
	Line Name			From	LID	Logic Chart																	LID	To	Line Name			
1																												1
2						10CFA30EA010XB00 T-BFP A BRG VIB X DE SID HI HI VMAS	IODI-1	IO v DI q					DALM	QTY QTY									Y1	TM301	T-BFP A BRG VIB X DE SID HI HI			2
3														ALM= 1									11		T-BFP A BRG VIB X DE SID HI HI QB			3
4						10CFA30EA011XB00 T-BFP A BRG VIB X ND E SID HI HI VMAS	IODI-2	IO v DI q					DALM	QTY QTY									Y2	TM301	T-BFP A BRG VIB X ND E SID HI HI			4
5														ALM= 1									21		T-BFP A BRG VIB X ND E SID HI HI QB			5
6						10CFA30EA012XB00 T-BFP A BP BRG VIB X DE SID HI HI VMAS	IODI-3	IO v DI q					DALM	QTY QTY									Y3	TM301	T-BFP A BP BRG VIB X DE SID HI HI			6
7														ALM= 1									31		T-BFP A BP BRG VIB X DE SID HI HI QB			7
8						10CFA30EA013XB00 T-BFP A BP BRG VIB X NDE SID HI HI VMAS	IODI-4	IO v DI q					DALM	QTY QTY									Y4	TM301	T-BFP A BP BRG VIB X NDE SID HI HI			8
9														ALM= 1									41		T-BFP A BP BRG VIB X NDE SID HI HI QB			9
10						10CFA30EA014XB00 T-BFP A BRG VIB Y DE SID HI HI VMAS	IODI-5	IO v DI q					DALM	QTY QTY									Y5	TM301	T-BFP A BRG VIB Y DE SID HI HI			10
11														ALM= 1									51		T-BFP A BRG VIB Y DE SID HI HI QB			11
12						10CFA30EA015XB00 T-BFP A BRG VIB Y ND E SID HI HI VMAS	IODI-6	IO v DI q					DALM	QTY QTY									Y6	TM301	T-BFP A BRG VIB Y ND E SID HI HI			12
13														ALM= 1									61		T-BFP A BRG VIB Y ND E SID HI HI QB			13
14						10CFA30EA016XB00 T-BFP A BP BRG VIB Y DE SID HI HI VMAS	IODI-7	IO v DI q					DALM	QTY QTY									Y7	TM301	T-BFP A BP BRG VIB Y DE SID HI HI			14
15														ALM= 1									71		T-BFP A BP BRG VIB Y DE SID HI HI QB			15

Rev. No.	1	2	3					PROJECT	(TSQ B)			
DATE	2021/12/15	2022/11/8	2023/7/5					Van Phong 1 BOT Thermal Power Plant Project 2×673MW				
CONTENTS	Revised (0022, 0024, 0026)	TUNING (0064)	Revised (0109, 0109R)					TITLE	DRAWING No.	SH	REV. MARK	
								FIELD DI PROCESSING (83)	4GCH01007	TM282	3	
								Equipment No. : -				

	A	B	C	D	E	F	G	H	I	J	K	L	M	N	O	P	Q	R	S	T	U	V	W	X	Y	Z	AA	
	Line Name			From	LID	Logic Chart																		LID	To	Line Name		
1						10CFA30EA017XB00 T-BFP A BP BRG VIB Y NDE SID HI HI VMAS IODI-1 IO v DI q → → DALM QTY QTY ALM= 1 → → Y1																		Y1	TM301	T-BFP A BP BRG VIB Y NDE SID HI HI		1
2																												2
3																												3
4																												4
5																												5
6																												6
7																												7
8																												8
9																												9
10																												10
11																												11
12																												12
13																												13
14																												14
15																												15
Rev. No.		1	2	3					PROJECT					(TSQ B)														
DATE		2021/12/15	2022/11/8	2023/7/5					Van Phong 1 BOT Thermal Power Plant Project 2×673MW																			
CONTENTS		Revised (0022, 0024, 0026)	TUNING (0064)	Revised (0109, 0109R)					TITLE					DRAWING No.					SH	REV. MARK								
									FIELD DI PROCESSING (84)					4GCH01007					TM283	3								
									Equipment No. : -																			

	A	B	C	D	E	F	G	H	I	J	K	L	M	N	O	P	Q	R	S	T	U	V	W	X	Y	Z	AA	
	Line Name			From	LID	Logic Chart																		LID	To	Line Name		
1																												1
2						10CFA30EA034xB00 M-BFP BRG VIB Y DE S ID HI HI IODI-1 IO v DI q → → DALM QTY QTY → → Y1 TM331 M-BFP BRG VIB Y DE S ID HI HI																						2
3						10CFA30EA035xB00 M-BFP BRG VIB Y NDE SID HI HI IODI-2 IO v DI q → → DALM QTY QTY → → 11 TM331 M-BFP BRG VIB Y DE S ID HI HI QB																						3
4						10CFA30EA035xB00 M-BFP BRG VIB Y NDE SID HI HI IODI-2 IO v DI q → → DALM QTY QTY → → Y2 TM331 M-BFP BRG VIB Y NDE SID HI HI																						4
5						10CFA30EA036xB00 M-BFP BP BRG VIB Y D E SID HI HI IODI-3 IO v DI q → → DALM QTY QTY → → 21 TM331 M-BFP BRG VIB Y NDE SID HI HI QB																						5
6						10CFA30EA036xB00 M-BFP BP BRG VIB Y D E SID HI HI IODI-3 IO v DI q → → DALM QTY QTY → → Y3 TM331 M-BFP BP BRG VIB Y D E SID HI HI																						6
7						10CFA30EA037xB00 M-BFP BP BRG VIB Y N DE SID HI HI IODI-4 IO v DI q → → DALM QTY QTY → → 31 TM331 M-BFP BP BRG VIB Y D E SID HI HI QB																						7
8						10CFA30EA037xB00 M-BFP BP BRG VIB Y N DE SID HI HI IODI-4 IO v DI q → → DALM QTY QTY → → Y4 TM331 M-BFP BP BRG VIB Y N DE SID HI HI																						8
9						10CFA30EA038xB00 M-BFP MOT1 BRG VIB X MOT2 SID HI HI IODI-5 IO v DI q → → DALM QTY QTY → → 41 TM331 M-BFP BP BRG VIB Y N DE SID HI HI QB																						9
10						10CFA30EA038xB00 M-BFP MOT1 BRG VIB X MOT2 SID HI HI IODI-5 IO v DI q → → DALM QTY QTY → → Y5 TM331 M-BFP MOT1 BRG VIB X MOT2 SID HI HI																						10
11						10CFA30EA039xB00 M-BFP MOT1 BRG VIB X FLDCPL SID HI HI IODI-6 IO v DI q → → DALM QTY QTY → → 51 TM331 M-BFP MOT1 BRG VIB X MOT2 SID HI HI QB																						11
12						10CFA30EA039xB00 M-BFP MOT1 BRG VIB X FLDCPL SID HI HI IODI-6 IO v DI q → → DALM QTY QTY → → Y6 TM331 M-BFP MOT1 BRG VIB X FLDCPL SID HI HI																						12
13						10CFA30EA040xB00 M-BFP MOT2 BRG VIB X MOT1 SID HI HI IODI-7 IO v DI q → → DALM QTY QTY → → 61 TM331 M-BFP MOT1 BRG VIB X FLDCPL SID HI HI QB																						13
14						10CFA30EA040xB00 M-BFP MOT2 BRG VIB X MOT1 SID HI HI IODI-7 IO v DI q → → DALM QTY QTY → → Y7 TM331 M-BFP MOT2 BRG VIB X MOT1 SID HI HI																						14
15						10CFA30EA040xB00 M-BFP MOT2 BRG VIB X MOT1 SID HI HI IODI-7 IO v DI q → → DALM QTY QTY → → 71 TM331 M-BFP MOT2 BRG VIB X MOT1 SID HI HI QB																						15
	Rev. No.	1	2	3									PROJECT					(TSQ B)										
	DATE	2021/12/15	2022/11/8	2023/7/5									Van Phong 1 BOT Thermal Power Plant Project 2×673MW															
	CONTENTS	Revised (0022, 0024, 0026)	TUNING (0064)	Revised (0109, 0109R))									TITLE					DRAWING No.					SH		REV. MARK			
													FIELD DI PROCESSING (85)					4GCH01007					TM284		3			
													Equipment No. : -															

Rev. No.	1	2	3					PROJECT	(TSQ B)			
DATE	2021/12/15	2022/11/8	2023/7/5					Van Phong 1 BOT Thermal Power Plant Project 2×673MW				
CONTENTS	Revised (0022, 0024, 0026)	TUNING (0064)	Revised (0109, 0109R)					TITLE	DRAWING No.	SH	REV. MARK	
								FIELD DI PROCESSING (85)	4GCH01007	TM284	3	
								Equipment No. : -				

	A	B	C	D	E	F	G	H	I	J	K	L	M	N	O	P	Q	R	S	T	U	V	W	X	Y	Z	AA	
	Line Name			From	LID	Logic Chart																	LID	To	Line Name			
1																												1
2						10CFA30EA041xB00 M-BFP MOT2 BRG VIB X BP SID HI HI VMAS IODI-1 IO v DI q DALM QTY QTY ALM= 1 10CFA30EA041xB00 M-BFP MOT2 BRG VIB X BP SID HI HI																	Y1	TM331	M-BFP MOT2 BRG VIB X BP SID HI HI			2
3																							11		M-BFP MOT2 BRG VIB X BP SID HI HI QB			3
4						10CFA30EA042xB00 M-BFP MOT1 BRG VIB Y MOT2 SID HI HI VMAS IODI-2 IO v DI q DALM QTY QTY ALM= 1 10CFA30EA042xB00 M-BFP MOT1 BRG VIB Y MOT2 SID HI HI																	Y2	TM331	M-BFP MOT1 BRG VIB Y MOT2 SID HI HI			4
5																							21		M-BFP MOT1 BRG VIB Y MOT2 SID HI HI QB			5
6						10CFA30EA043xB00 M-BFP MOT1 BRG VIB Y FLDCPL SID HI HI VMAS IODI-3 IO v DI q DALM QTY QTY ALM= 1 10CFA30EA043xB00 M-BFP MOT1 BRG VIB Y FLDCPL SID HI HI																	Y3	TM331	M-BFP MOT1 BRG VIB Y FLDCPL SID HI HI			6
7																							31		M-BFP MOT1 BRG VIB Y FLDCPL SID HI HI QB			7
8						10CFA30EA044xB00 M-BFP MOT2 BRG VIB Y MOT1 SID HI HI VMAS IODI-4 IO v DI q DALM QTY QTY ALM= 1 10CFA30EA044xB00 M-BFP MOT2 BRG VIB Y MOT1 SID HI HI																	Y4	TM331	M-BFP MOT2 BRG VIB Y MOT1 SID HI HI			8
9																							41		M-BFP MOT2 BRG VIB Y MOT1 SID HI HI QB			9
10						10CFA30EA045xB00 M-BFP MOT2 BRG VIB Y BP SID HI HI VMAS IODI-5 IO v DI q DALM QTY QTY ALM= 1 10CFA30EA045xB00 M-BFP MOT2 BRG VIB Y BP SID HI HI																	Y5	TM331	M-BFP MOT2 BRG VIB Y BP SID HI HI			10
11																							51		M-BFP MOT2 BRG VIB Y BP SID HI HI QB			11
12						10CFA30EA046xB00 M-BFP FLD CPL HSE VI B INP SID HI HI VMAS IODI-6 IO v DI q DALM QTY QTY ALM= 1 10CFA30EA046xB00 M-BFP FLD CPL HSE VI B INP SID HI HI																	Y6	TM331	M-BFP FLD CPL HSE VI B INP SID HI HI			12
13																							61		M-BFP FLD CPL HSE VI B INP SID HI HI QB			13
14						10CFA30EA047xB00 M-BFP FLD CPL HSE VI B PRI SID HI HI VMAS IODI-7 IO v DI q DALM QTY QTY ALM= 1 10CFA30EA047xB00 M-BFP FLD CPL HSE VI B PRI SID HI HI																	Y7	TM331	M-BFP FLD CPL HSE VI B PRI SID HI HI			14
15																							71		M-BFP FLD CPL HSE VI B PRI SID HI HI QB			15
Rev. No.		1	2	3					PROJECT					(TSQ B)														
DATE		2021/12/15	2022/11/8	2023/7/5					Van Phong 1 BOT Thermal Power Plant Project 2×673MW																			
CONTENTS		Revised (0022, 0024, 0026)	TUNING (0064)	Revised (0109, 0109R))					TITLE					DRAWING No.					SH		REV. MARK							
									FIELD DI PROCESSING (86)					4GCH01007					TM285		3							
									Equipment No. : -																			

Y1

TM331

M-BFP MOT2 BRG VIB X

BP SID HI HI

2

Rev. No.	1	2	3						PROJECT	(TSQ B)				
DATE	2021/12/15	2022/11/8	2023/7/5						Van Phong 1 BOT Thermal Power Plant Project 2×673MW					
CONTENTS	Revised (0022, 0024, 0026)	TUNING (0064)	Revised (0109, 0109R)						FIELD DI PROCESSING (86)	DRAWING No.	4GCH01007		SH	REV. MARK
									Equipment No. : -				TM285	3

	A	B	C	D	E	F	G	H	I	J	K	L	M	N	O	P	Q	R	S	T	U	V	W	X	Y	Z	AA	
	Line Name			From	LID	Logic Chart																	LID	To	Line Name			
1																												1
2						10CFA30EA020XB00 T-BFP B BRG VIB X DE SID HI HI VMAS	IODI-1	IO v DI q					DALM	QTY QTY									Y1	TM311	T-BFP B BRG VIB X DE SID HI HI		2	
3														ALM= 1									11		T-BFP B BRG VIB X DE SID HI HI QB		3	
4						10CFA30EA021XB00 T-BFP B BRG VIB X ND E SID HI HI VMAS	IODI-2	IO v DI q					DALM	QTY QTY									Y2	TM311	T-BFP B BRG VIB X ND E SID HI HI		4	
5														ALM= 1									21		T-BFP B BRG VIB X ND E SID HI HI QB		5	
6						10CFA30EA022XB00 T-BFP B BP BRG VIB X DE SID HI HI VMAS	IODI-3	IO v DI q					DALM	QTY QTY									Y3	TM311	T-BFP B BP BRG VIB X DE SID HI HI		6	
7														ALM= 1									31		T-BFP B BP BRG VIB X DE SID HI HI QB		7	
8						10CFA30EA023XB00 T-BFP B BP BRG VIB X NDE SID HI HI VMAS	IODI-4	IO v DI q					DALM	QTY QTY									Y4	TM311	T-BFP B BP BRG VIB X NDE SID HI HI		8	
9														ALM= 1									41		T-BFP B BP BRG VIB X NDE SID HI HI QB		9	
10						10CFA30EA024XB00 T-BFP B BRG VIB Y DE SID HI HI VMAS	IODI-5	IO v DI q					DALM	QTY QTY									Y5	TM311	T-BFP B BRG VIB Y DE SID HI HI		10	
11														ALM= 1									51		T-BFP B BRG VIB Y DE SID HI HI QB		11	
12						10CFA30EA025XB00 T-BFP B BRG VIB Y ND E SID HI HI VMAS	IODI-6	IO v DI q					DALM	QTY QTY									Y6	TM311	T-BFP B BRG VIB Y ND E SID HI HI		12	
13														ALM= 1									61		T-BFP B BRG VIB Y ND E SID HI HI QB		13	
14						10CFA30EA026XB00 T-BFP B BP BRG VIB Y DE SID HI HI VMAS	IODI-7	IO v DI q					DALM	QTY QTY									Y7	TM311	T-BFP B BP BRG VIB Y DE SID HI HI		14	
15														ALM= 1									71		T-BFP B BP BRG VIB Y DE SID HI HI QB		15	

Rev. No.	1	2	3					PROJECT	(TSQ B)			
DATE	2021/12/15	2022/11/8	2023/7/5					Van Phong 1 BOT Thermal Power Plant Project 2×673MW				
CONTENTS	Revised (0022, 0024, 0026)	TUNING (0064)	Revised (0109, 0109R)					TITLE	DRAWING No.	SH	REV. MARK	
								FIELD DI PROCESSING (87)	4GCH01007	TM286	3	
								Equipment No. : -				

	A	B	C	D	E	F	G	H	I	J	K	L	M	N	O	P	Q	R	S	T	U	V	W	X	Y	Z	AA																					
	Line Name			From	LID	Logic Chart																	LID	To	Line Name																							
1						10CFA30EA027xB00 T-BFP B BP BRG VIB Y NDE SID HI HI IODI-1 IO v DI q DALM QTY QTY ALM= 1 10CFA30EA028xB00 T-BFP B GEAR BOX VIB BP SID HI HI IODI-2 IO v DI q DALM QTY QTY ALM= 1 10CFA30EA029xB00 T-BFP B GEAR BOX VIB BFP SID HI HI IODI-3 IO v DI q DALM QTY QTY ALM= 1 10LAC10AP060XB01 T-BFP A NOISE ECLSR FAN RUN TBFP A LCP IODI-4 IO v DI q DTD DTD 10LAC10AP060XB33 T-BFP A NOISE ECLSR FAN RMT SEL TBFP A LCP IODI-5 IO v DI q DTD 10LAC20AP060XB01 T-BFP B NOISE ECLSR FAN RUN TBFP B LCP IODI-6 IO v DI q DTD DTD 10LAC20AP060XB33 T-BFP B NOISE ECLSR FAN RMT SEL TBFP B LCP IODI-7 IO v DI q DTD																																										
2																							Y1	TM311	T-BFP B BP BRG VIB Y NDE SID HI HI	2																						
3																							11		T-BFP B BP BRG VIB Y NDE SID HI HI QB	3																						
4																							Y2	TM311	T-BFP B GEAR BOX VIB BP SID HI HI	4																						
5																							21		T-BFP B GEAR BOX VIB BP SID HI HI QB	5																						
6																							Y3	TM311	T-BFP B GEAR BOX VIB BFP SID HI HI	6																						
7																							31		T-BFP B GEAR BOX VIB BFP SID HI HI QB	7																						
8																							Y4	TM855	T-BFP A NOISE ECLSR FAN RUN	8																						
9																							41	TM855	T-BFP A NOISE ECLSR FAN RUN QB	9																						
10																							Y5	TM855	T-BFP A NOISE ECLSR FAN LCL SEL	10																						
11																							51		T-BFP A NOISE ECLSR FAN RMT SEL QB	11																						
12																							Y6	TM865	T-BFP B NOISE ECLSR FAN RUN	12																						
13																							61	TM865	T-BFP B NOISE ECLSR FAN RUN QB	13																						
14																							Y7	TM865	T-BFP B NOISE ECLSR FAN LCL SEL	14																						
15																							71		T-BFP B NOISE ECLSR FAN RMT SEL QB	15																						

Rev. No.	1	2	3						PROJECT	(TSQ B)			
DATE	2021/12/15	2022/11/8	2023/7/5						Van Phong 1 BOT Thermal Power Plant Project 2×673MW				
CONTENTS	Revised (0022, 0024, 0026)	Revised (0048, 0064)	Revised (0109, 0109R)						TITLE	DRAWING No.			
									FIELD DI PROCESSING (88)	4GCH01007		SH	REV. MARK
									Equipment No. :	-		TM287	3


	A	B	C	D	E	F	G	H	I	J	K	L	M	N	O	P	Q	R	S	T	U	V	W	X	Y	Z	AA	
	Line Name			From	LID	Logic Chart																	LID	To	Line Name			
1	BFPT A BKUP OVRSPD			TM260	A	10CGB10EA006ZV62 BFPT A BKUP OVRSPD DALM QTY QTY ALM= 1																	01	TM500	BFPT A BKUP OVRSPD			1
2																												2
3																												3
4																												4
5	BFPT A EHC HEAVY FAI			TM263	Y3	10CGB10EA001ZV62 BFPT A DEHC HEAVY FA IL DALM QTY QTY ALM= 1																	02	TM500	BFPT A DEHC HEAVY FA IL			5
6	BFPT A EHC HEAVY FAI			TM263	Y4																							6
7	BFPT A SPD NO SPD BFPT A CV CLS			TM515 TM374	05 01	10XAA10EE201 BFPT A STRT DDL QTY QTY																						7
8																												8
9																												9
10																												10
11																												11
12																												12
13																												13
14																												14
15																												15

Rev. No.	0	1	2					PROJECT	(TSQ B)			
DATE	2021/6/21	2021/12/15	2022/11/8					Van Phong 1 BOT Thermal Power Plant Project 2×673MW				
CONTENTS	1st Issue	Revised (0015)	Revised & Tuning (0064, 0084)					TITLE	DRAWING No.	SH	REV. MARK	
								BFPT A INPUT SIGNAL TRANSFER (1)	4GCH01007	TM300	2	
								Equipment No. : -				


	A	B	C	D	E	F	G	H	I	J	K	L	M	N	O	P	Q	R	S	T	U	V	W	X	Y	Z	AA					
	Line Name			From	LID	Logic Chart																	LID	To	Line Name							
1	BFPT B BKUP OVRSPD			TM270	A	10CGB20EA006ZV62 BFPT B BKUP OVRSPD DALM QTY QTY ALM= 1																	01	TM650	BFPT B BKUP OVRSPD			1				
2																												2				
3																												3				
4																												4				
5	BFPT B EHC HEAVY FAI L A			TM273	Y3	10CGB20EA001ZV62 BFPT B DEHC HEAVY FA IL DALM QTY QTY ALM= 1																	02	TM650	BFPT B DEHC HEAVY FA IL			5				
6	BFPT B EHC HEAVY FAI L B			TM273	Y4																							6				
7	BFPT B SPD NO SPD			TM665	05	10XAA20EE201 BFPT B STRT DDL QTY QTY																						7				
8																												8				
9	BFPT B CV CLS			TM384	01																							9				
10																												10				
11																												11				
12																												12				
13																												13				
14																												14				
15																												15				


Rev. No.	0	1	2					PROJECT	(TSQ B)			
DATE	2021/6/21	2021/12/15	2022/11/8					Van Phong 1 BOT Thermal Power Plant Project 2×673MW				
CONTENTS	1st Issue	Revised (0015)	Revised & Tuning (0064, 0084)					TITLE	DRAWING No.	SH	REV. MARK	
								BFPT B INPUT SIGNAL TRANSFER (1)	4GCH01007	TM310	2	
								Equipment No. : -				

	A	B	C	D	E	F	G	H	I	J	K	L	M	N	O	P	Q	R	S	T	U	V	W	X	Y	Z	AA		
	Line Name			From	LID	Logic Chart																	LID	To	Line Name				
1	BFPT B BRG VIB HI HI A			TM270	Y4	10CFA10EA201ZV62 BFPT B BRG VIB HI HI DALM QTY QTY ALM= 1 OR																	01	TM650	BFPT B BRG VIB HI HI			2	
2				TM270	Y5																		3						
3				TM270	Y6																		4						
4				TM286	Y1																		5						
5				TM286	Y5																		6						
6				TM286	Y2																		7						
7				TM286	Y6																		8						
8				TM286	Y3																		9						
9				TM286	Y7																		10						
10				TM286	Y4																		11						
11	BFPT B BRG VIB HI HI B			TM286	Y1	10CFA10EA204ZV62 BFPT B THRBRG POSN A BN TRIP DALM QTY QTY ALM= 1 OR ○																	02	TM650	BFPT B THRBRG POSN A BN TRIP			12	
12				TM286	Y5																		13						
13				TM286	Y6																		14						
14				TM286	Y7																		15						
15				TM156	12																		16						
16	BFPT B BRG 1 OIL DRN TEMP HI			TM156	22																		A	BFPEHC	BFPT B LUBE OIL TEMP NORMAL			17	
17				TM156	32																		18						
18				TM156																			19						
19	BFPT B BRG 2 OIL DRN TEMP HI			TM156	32																							20	
Rev. No.				0	1	2	3					PROJECT				(TSQ B)													
DATE				2021/6/21	2021/12/15	2022/11/8	2023/7/5					Van Phong 1 BOT Thermal Power Plant Project 2×673MW																	
CONTENTS				1st Issue	Revised (0015, 0022)	Revised & Tuning (0032, 0064)	Revised (0110)					TITLE				DRAWING No.				SH		REV. MARK							
												BFPT B INPUT SIGNAL TRANSFER (2)				4GCH01007				TM311		3							
												Equipment No. : -																	

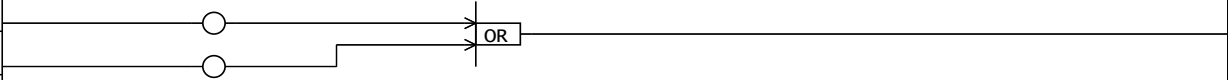	A	B	C	D	E	F	G	H	I	J	K	L	M	N	O	P	Q	R	S	T	U	V	W	X	Y	Z	AA	
	Line Name			From	LID	Logic Chart																	LID	To	Line Name			
1																												1
2																												2
3																												3
4																												4
5																												5
6																												6
7																												7
8																												8
9																												9
10	MBFP MOT 1 RMT SEL			TM200	Z7																		Z6	TM925	MBFP MOT LCL SEL			10
11	MBFP MOT 2 RMT SEL			TM201	Z7																							11
12	MBFP MOT 1 MOT RESTR T INH			TM200	ZA																		ZA	TM921	MBFP MOT RESTR T INH			12
13	MBFP MOT 2 MOT RESTR T INH			TM201	ZA																							13
14																												14
15																												15

Rev. No.	0	1						PROJECT	(TSQ B)			
DATE	2021/6/21	2021/12/15						Van Phong 1 BOT Thermal Power Plant Project 2×673MW				
CONTENTS	1st Issue	Revised (0015)						TITLE	DRAWING No.	SH	REV. MARK	
								M-BFP INPUT SIGNAL TRANSFER (2)	4GCH01007	TM321	1	
								Equipment No. : -				

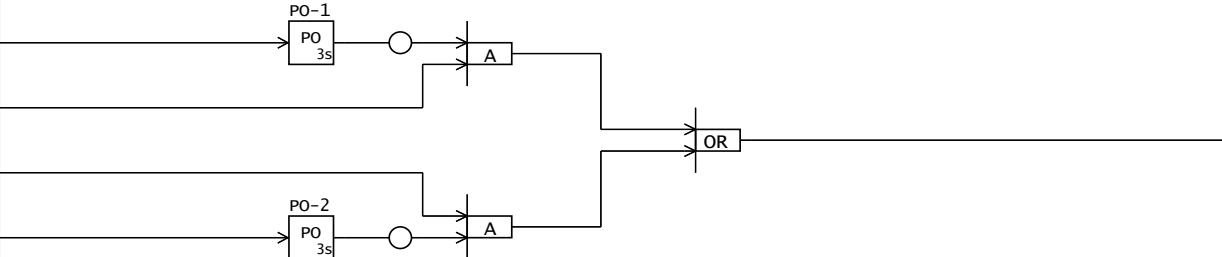	A	B	C	D	E	F	G	H	I	J	K	L	M	N	O	P	Q	R	S	T	U	V	W	X	Y	Z	AA				
	Line Name			From	LID	Logic Chart																	LID	To	Line Name						
1	MBFP MOT 1 RUN			TM200	Z1																		01	TM919	M-BFP MOT WTR LK			1			
2					Y1																		2								
3				TM202	Y2																		3								
4				TM201	Z1																		4								
5	M-BFP RUN			TM944	03																		A		BB907	ANY BFP RUN			5		
6				TM824	03																		6								
7				TM834	03																		7								
8	MBFP MOT STPD			TM320	02																		B				ALL BFP STPD			8	
9					01																		9								
10				TM501	01																		10								
11	BFPT B TRIP			TM651	01																										11
12																							12								
13																							13								
14																															14
15																							15								
	Rev. No.	0	1										PROJECT					(TSQ B)													
	DATE	2021/6/21	2021/12/15										Van Phong 1 BOT Thermal Power Plant Project 2×673MW																		
	CONTENTS	1st Issue	Revised (0015, 0026)										TITLE					DRAWING No.					SH				REV. MARK				
													M-BFP INPUT SIGNAL TRANSFER (3)					4GCH01007					TM330		1						
													Equipment No. : -																		

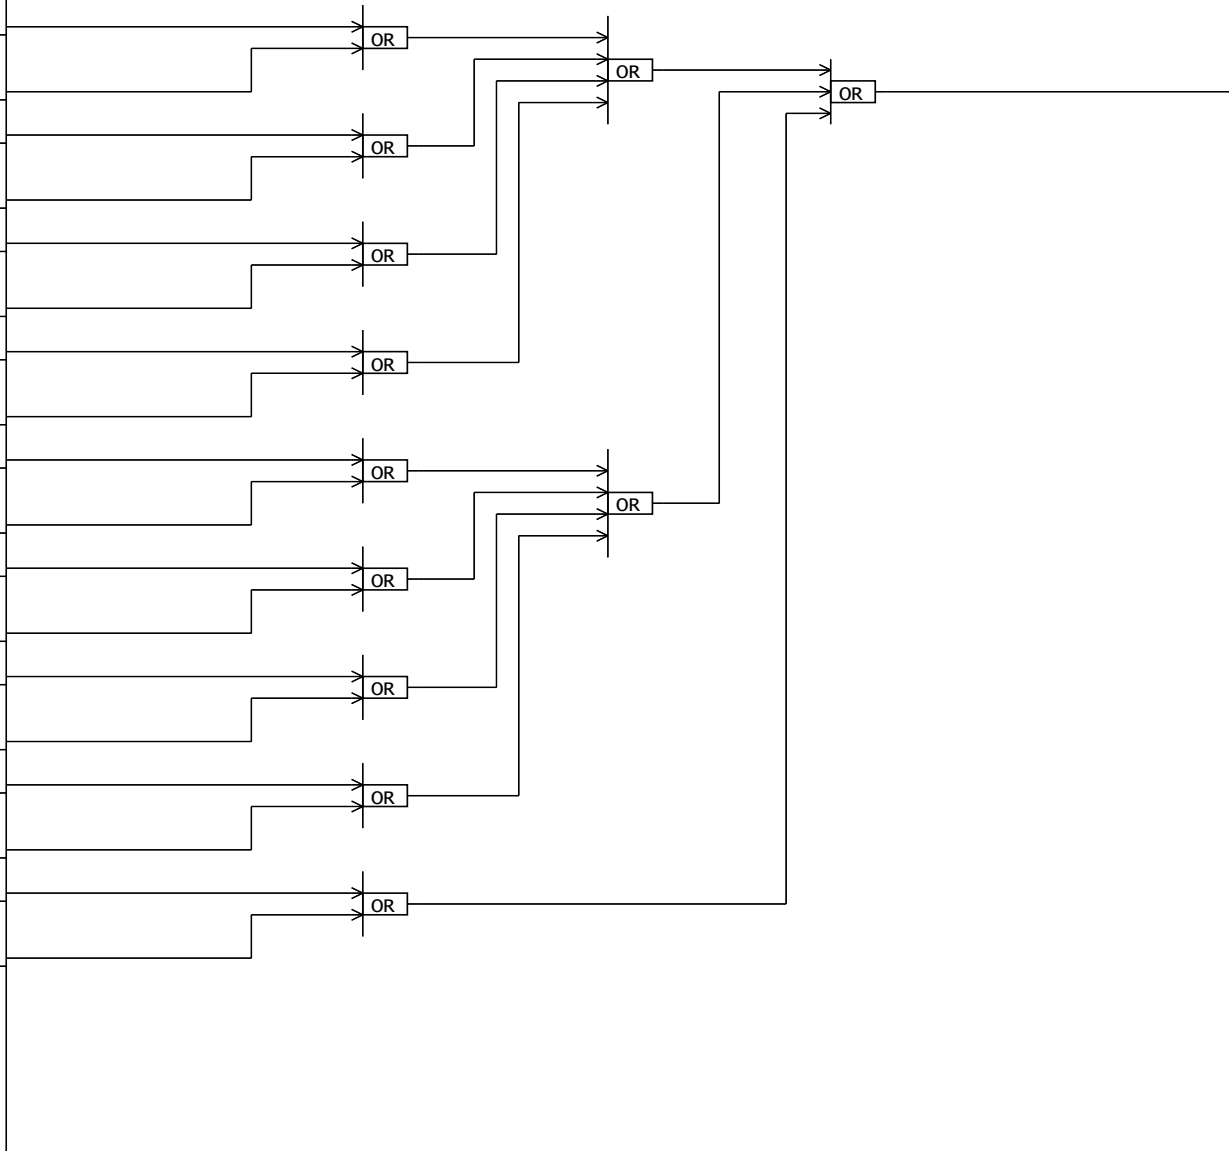	A	B	C	D	E	F	G	H	I	J	K	L	M	N	O	P	Q	R	S	T	U	V	W	X	Y	Z	AA	
	Line Name			From	LID	Logic Chart																	LID	To	Line Name			
1																												1
2	M-BFP BRG VIB X DE SID HI HI			TM283	Y4																		O1	TM920	M-BFP VIB HI HI			2
3	M-BFP BRG VIB Y DE SID HI HI			TM284	Y1																		3					
4	M-BFP BRG VIB X NDE SID HI HI			TM283	Y5																		4					
5	M-BFP BRG VIB Y NDE SID HI HI			TM284	Y2																		5					
6	M-BFP BP BRG VIB X DE SID HI HI			TM283	Y6																		6					
7	M-BFP BP BRG VIB Y DE SID HI HI			TM284	Y3																		7					
8	M-BFP BP BRG VIB X NDE SID HI HI			TM283	Y7																		8					
9	M-BFP BP BRG VIB Y NDE SID HI HI			TM284	Y4																		9					
10	M-BFP MOT1 BRG VIB X MOT2 SID HI HI			TM284	Y5																		10					
11	M-BFP MOT1 BRG VIB Y MOT2 SID HI HI			TM285	Y2																		11					
12	M-BFP MOT1 BRG VIB X FLDCPL SID HI HI			TM284	Y6																		12					
13	M-BFP MOT1 BRG VIB Y FLDCPL SID HI HI			TM285	Y3																		13					
14	M-BFP MOT2 BRG VIB X MOT1 SID HI HI			TM284	Y7																		14					
15	M-BFP MOT2 BRG VIB Y MOT1 SID HI HI			TM285	Y4																		15					
	M-BFP MOT2 BRG VIB X BP SID HI HI			TM285	Y1																							
	M-BFP MOT2 BRG VIB Y BP SID HI HI			TM285	Y5																							
	M-BFP FLD CPL HSE VIB INP SID HI HI			TM285	Y6																							
	M-BFP FLD CPL HSE VIB PRI SID HI HI			TM285	Y7																							
	Rev. No.	1												PROJECT				(TSQ B)										
	DATE	2021/12/15												Van Phong 1 BOT Thermal Power Plant Project 2×673MW														
	CONTENTS	Revised (0022)												TITLE				DRAWING No.				SH		REV. MARK				
														M-BFP INPUT SIGNAL TRANSFER (4)				4GCH01007				TM331		1				
														Equipment No. : -														

	A	B	C	D	E	F	G	H	I	J	K	L	M	N	O	P	Q	R	S	T	U	V	W	X	Y	Z	AA		
	Line Name			From	LID	Logic Chart																	LID		To	Line Name			
1	HPTB CV-A FULL CLS			HA265C	25	<																							

Rev. No.	0	1	2					PROJECT	(TSQ B)			
DATE	2021/6/21	2021/12/15	2022/11/8					Van Phong 1 BOT Thermal Power Plant Project 2×673MW				
CONTENTS	1st Issue	Revised (0015)	Revised (0032, 0065)					TITLE	DRAWING No.	SH	REV. MARK	
								SIGNAL TRANSFER (7)	4GCH01007	TM366	2	
								Equipment No. : -				

	A	B	C	D	E	F	G	H	I	J	K	L	M	N	O	P	Q	R	S	T	U	V	W	X	Y	Z	AA				
	Line Name			From	LID	Logic Chart																	LID	To	Line Name						
1	M-BFP SERV IN CMD			RT456	01	→ DTD																	01	TM441A	M-BFP SERV IN CMD	1					
2																										2					
3	M-BFP SERV IN MSTR PAS CMD			RD371	I	→ DTD																	02	TM441A	M-BFP SERV IN MSTR PAS CMD	3					
4	M-BFP SERV IN MSTR OPS CMD			RD383	I	→ DTD																	03	TM441A	M-BFP SERV IN MSTR OPS CMD	4					
5	1ST TBFP SERV IN MA CMD			RT456	02	→ DTD																	04	TM453	1ST TBFP SERV IN MA CMD	5					
6	1ST TBFP SERV IN MSTR PAS CMD			RD371	J	→ DTD																	05	TM453	1ST TBFP SERV IN MSTR PAS CMD	6					
7	1ST TBFP SERV IN MSTR OPS CMD			RD383	J	→ DTD																	06	TM453	1ST TBFP SERV IN MSTR OPS CMD	7					
8	MBFP SERV OUT CMD			RT670	A	→ DTD																	07	TM474A	MBFP SERV OUT CMD	8					
9	M-BFP SERV OUT MSTR PAS CMD			RD371	K	→ DTD																	08	TM474A	M-BFP SERV OUT MSTR PAS CMD	9					
10	M-BFP SERV OUT MSTR OPS CMD			RD383	K	→ DTD																	09	TM474A	M-BFP SERV OUT MSTR OPS CMD	10					
11	2ND TBFP SERV IN MA CMD			RT680	01	→ DTD																	10	TM455	2ND TBFP SERV IN MA CMD	11					
12	2ND TBFP SERV IN MSTR PAS CMD			RD371	L	→ DTD																	11	TM455	2ND TBFP SERV IN MSTR PAS CMD	12					
13	2ND TBFP SERV IN MSTR OPS CMD			RD383	L	→ DTD																	12	TM455	2ND TBFP SERV IN MSTR OPS CMD	13					
14																										14					
15																										15					
	Rev. No.	2													PROJECT					(TSQ B)											
	DATE	2022/11/8													Van Phong 1 BOT Thermal Power Plant Project 2×673MW																
	CONTENTS	Sheet Added (0065)													TITLE					DRAWING No.					SH	REV. MARK					
															SIGNAL TRANSFER (10)					4GCH01007					TM369					2	
	Equipment No. : -																														

	A	B	C	D	E	F	G	H	I	J	K	L	M	N	O	P	Q	R	S	T	U	V	W	X	Y	Z	AA				
	Line Name			From	LID	Logic Chart																	LID		To	Line Name					
1						0 DTD 0 DTD 0 DTD																	01		BFPT A NORM STP CMD	1					
2																							02			2					
3																							04			3					
4																										4					
5	HP BLOW SEL			RD403	01	OR																	21	TM436	HP CLNUP SEL	5					
6	HP RECIRC SEL			RD403	04																		6								
7				TE332	02	DTD																	11	TM421	START UP MODE SEL	12					
12																							13								
13	SHUT DOWN MODE SEL																						TE332			03	DTD				
14				14																											
15				15																											
Rev. No.		0		1		3										PROJECT					(TSQ B)										
DATE		2021/6/21		2021/12/15		2023/7/5										Van Phong 1 BOT Thermal Power Plant Project 2×673MW															
CONTENTS		1st Issue		Revised (0015)		Revised (0117, 0164)										TITLE					DRAWING No.					SH		REV. MARK			
																SIGNAL TRANSFER (11)					4GCH01007					TM370		3			
																Equipment No. : -															


	A	B	C	D	E	F	G	H	I	J	K	L	M	N	O	P	Q	R	S	T	U	V	W	X	Y	Z	AA	
	Line Name			From	LID	Logic Chart																	LID	To	Line Name			
1	BFP RNBK			HA111B	12	<																						

Rev. No.	0	1	2					PROJECT	(TSQ B)			
DATE	2021/6/21	2021/12/15	2022/11/8					Van Phong 1 BOT Thermal Power Plant Project 2×673MW				
CONTENTS	1st Issue	Revised (0007, 0015, 0026)	Revised (0032)					TITLE	DRAWING No.	SH	REV. MARK	
								SIGNAL TRANSFER (13)	4GCH01007	TM372	2	
								Equipment No. : -				

	A	B	C	D	E	F	G	H	I	J	K	L	M	N	O	P	Q	R	S	T	U	V	W	X	Y	Z	AA												
	Line Name			From	LID	Logic Chart																	LID	To	Line Name														
1	T-BFP-A SERV OUT COM PL			HA146E	26	→ DTD																	01	MD005 TM483B TM485B TM981	T-BFP A SERV OUT COM P				1										
2																													2										
3						T-BFP-B SERV OUT COM PL			HA150E	26	→ DTD																		02	MD055 TM483B TM485B TM981	T-BFP B SERV OUT COM P				3				
4																																			4				
5																																			5				
6																																			6				
7	M-BFP SERV OUT COMPL			HA154E	26	→ DTD																	06	MD105 TM474B	M-BFP SERV OUT COMPL				7										
8	T-BFP A SERV IN COM L			HA146C	11	→ DTD																	07	TM421 TM441C TM445 TM446 TM449 TM452 TM453G TM455G TM465A TM466A TM471 TM477C TM477D TM481C TM481D	T-BFP A SERV IN COM L				8										
9																													9										
10																													10										
11																													11										
12																													12										
13	T-BFP B SERV IN COM L			HA150C	11	→ DTD																	08	TM421 TM441C TM445 TM446 TM449 TM452 TM453G TM455G TM465A TM466A TM471 TM477C TM477D TM481C TM481D	T-BFP B SERV IN COM L				13										
14																													14										
15																													15										
	Rev. No.	0	1	2	3				PROJECT										(TSQ B)																				
	DATE	2021/6/21	2021/12/15	2022/11/8	2023/7/5				Van Phong 1 BOT Thermal Power Plant Project 2×673MW																														
	CONTENTS	1st Issue	Revised (0007, 0015, 0024)	Revised (0032, 0045, 0048)	Revised (0186)				TITLE										DRAWING No.					SH		REV. MARK													
									SIGNAL TRANSFER (13A)										4GCH01007					TM372A		3													
	Equipment No. : -																																						

	A	B	C	D	E	F	G	H	I	J	K	L	M	N	O	P	Q	R	S	T	U	V	W	X	Y	Z	AA														
	Line Name				From	LID	Logic Chart																	LID	To	Line Name															
1	T-BFP A EHC NOT AUTO CTRL				HA149A	21	→ DTD																	01	TM981	T-BFP A EHC NOT AUTO CTRL			1												
2						21	→ DTD																	02					2												
3						22	→ DTD																	03					TF312 TM437 TM472	M-BFP O/L FCV ABN			3								
4						22	→ DTD																	04									TF312 TM450 TM451 TM481A	T-BFP STARTUP FCV ABN			4				
5						10	→ DTD																	05													TF312 TM438 TM441D TM453F TM465A TM477D TM481D TM849	M-BFP SERV IN COMPL			5
6	T-BFP STARTUP FCV AUT TO				HA149B	05	→ DTD																	06	TF312 TM445 TM446 TM477A	T-BFP STARTUP FCV AUT TO			6												
7						09	→ DTD																	07					TF406 TM445 TM477A	T-BFP A EHC AUTO			7								
8						09	→ DTD																	08									TF406 TM446 TM477B	T-BFP B EHC AUTO			8				
9						20	→ DTD																	09													TF408 TM450 TM481A	T-BFP A EHC ABN			9
10						20	→ DTD																	10																	TF408 TM451 TM481B
11	T-BFP HDR ISOL VLV OPEN CMD				HA147BA	13	→ DTD																	11	TM849	T-BFP HDR ISOL VLV OPEN CMD							11								
12																														12											
13																														13											
14																														14											
15																														15											
	Rev. No.	0	1	2					PROJECT					(TSQ B)																											
	DATE	2021/6/21	2021/12/15	2022/11/8					Van Phong 1 BOT Thermal Power Plant Project 2×673MW																																
	CONTENTS	1st Issue	Revised (0015, 0026, 0030)	Revised (0032, 0045, 0064)					TITLE					DRAWING No.					SH	REV. MARK																					
									SIGNAL TRANSFER (13B)					4GCH01007					TM372B			2																			
	Equipment No. : -																																								

	A	B	C	D	E	F	G	H	I	J	K	L	M	N	O	P	Q	R	S	T	U	V	W	X	Y	Z	AA				
	Line Name			From	LID	Logic Chart																	LID	To	Line Name						
1	M-BFP SERV IN PRMT			HA154B	05	→ DTD																	01	TM441C	M-BFP SERV IN PRMT			1			
2				HA146B	05	→ DTD																	02	TM453F TM455F	T-BFP A SERV IN PRMT			2			
3				HA150B	05	→ DTD																	03	TM453F TM455F	T-BFP B SERV IN PRMT			3			
4				HA158A	10	→ DTD																	04	TM437 TM472 TM919	M-BFP HYDCPLG ABN			4			
5				HA159	09	→ DTD																	05	TM435 TM470	M-BFP HYDCPLG AUTO			5			
6				HA157	09	→ DTD																	06	TF312 TM435 TM470	M-BFP O/L FCV AUTO			6			
7				HA154D	22	→ DTD																	07	TM471	M-BFP SERV OUT PRMT			7			
8				HA146D	22	→ DTD																	08	TM479	T-BFP A SERV OUT PRMT			8			
8	T-BFP B SERV OUT PRMT			HA150D	22	→ DTD																	09	TM479	T-BFP B SERV OUT PRMT			8			
9																												9			
10																												10			
11																												11			
12																												12			
13																												13			
14																												14			
15																												15			
				Rev. No.	1	2										PROJECT					(TSQ B)										
				DATE	2021/12/15	2022/11/8										Van Phong 1 BOT Thermal Power Plant Project 2×673MW															
				CONTENTS	Revised (0015, 0024, 0030)	Revised (0032)										TITLE					DRAWING No.					SH	REV. MARK				
																SIGNAL TRANSFER (13C)					4GCH01007					TM372C	2				
													Equipment No. : -																		

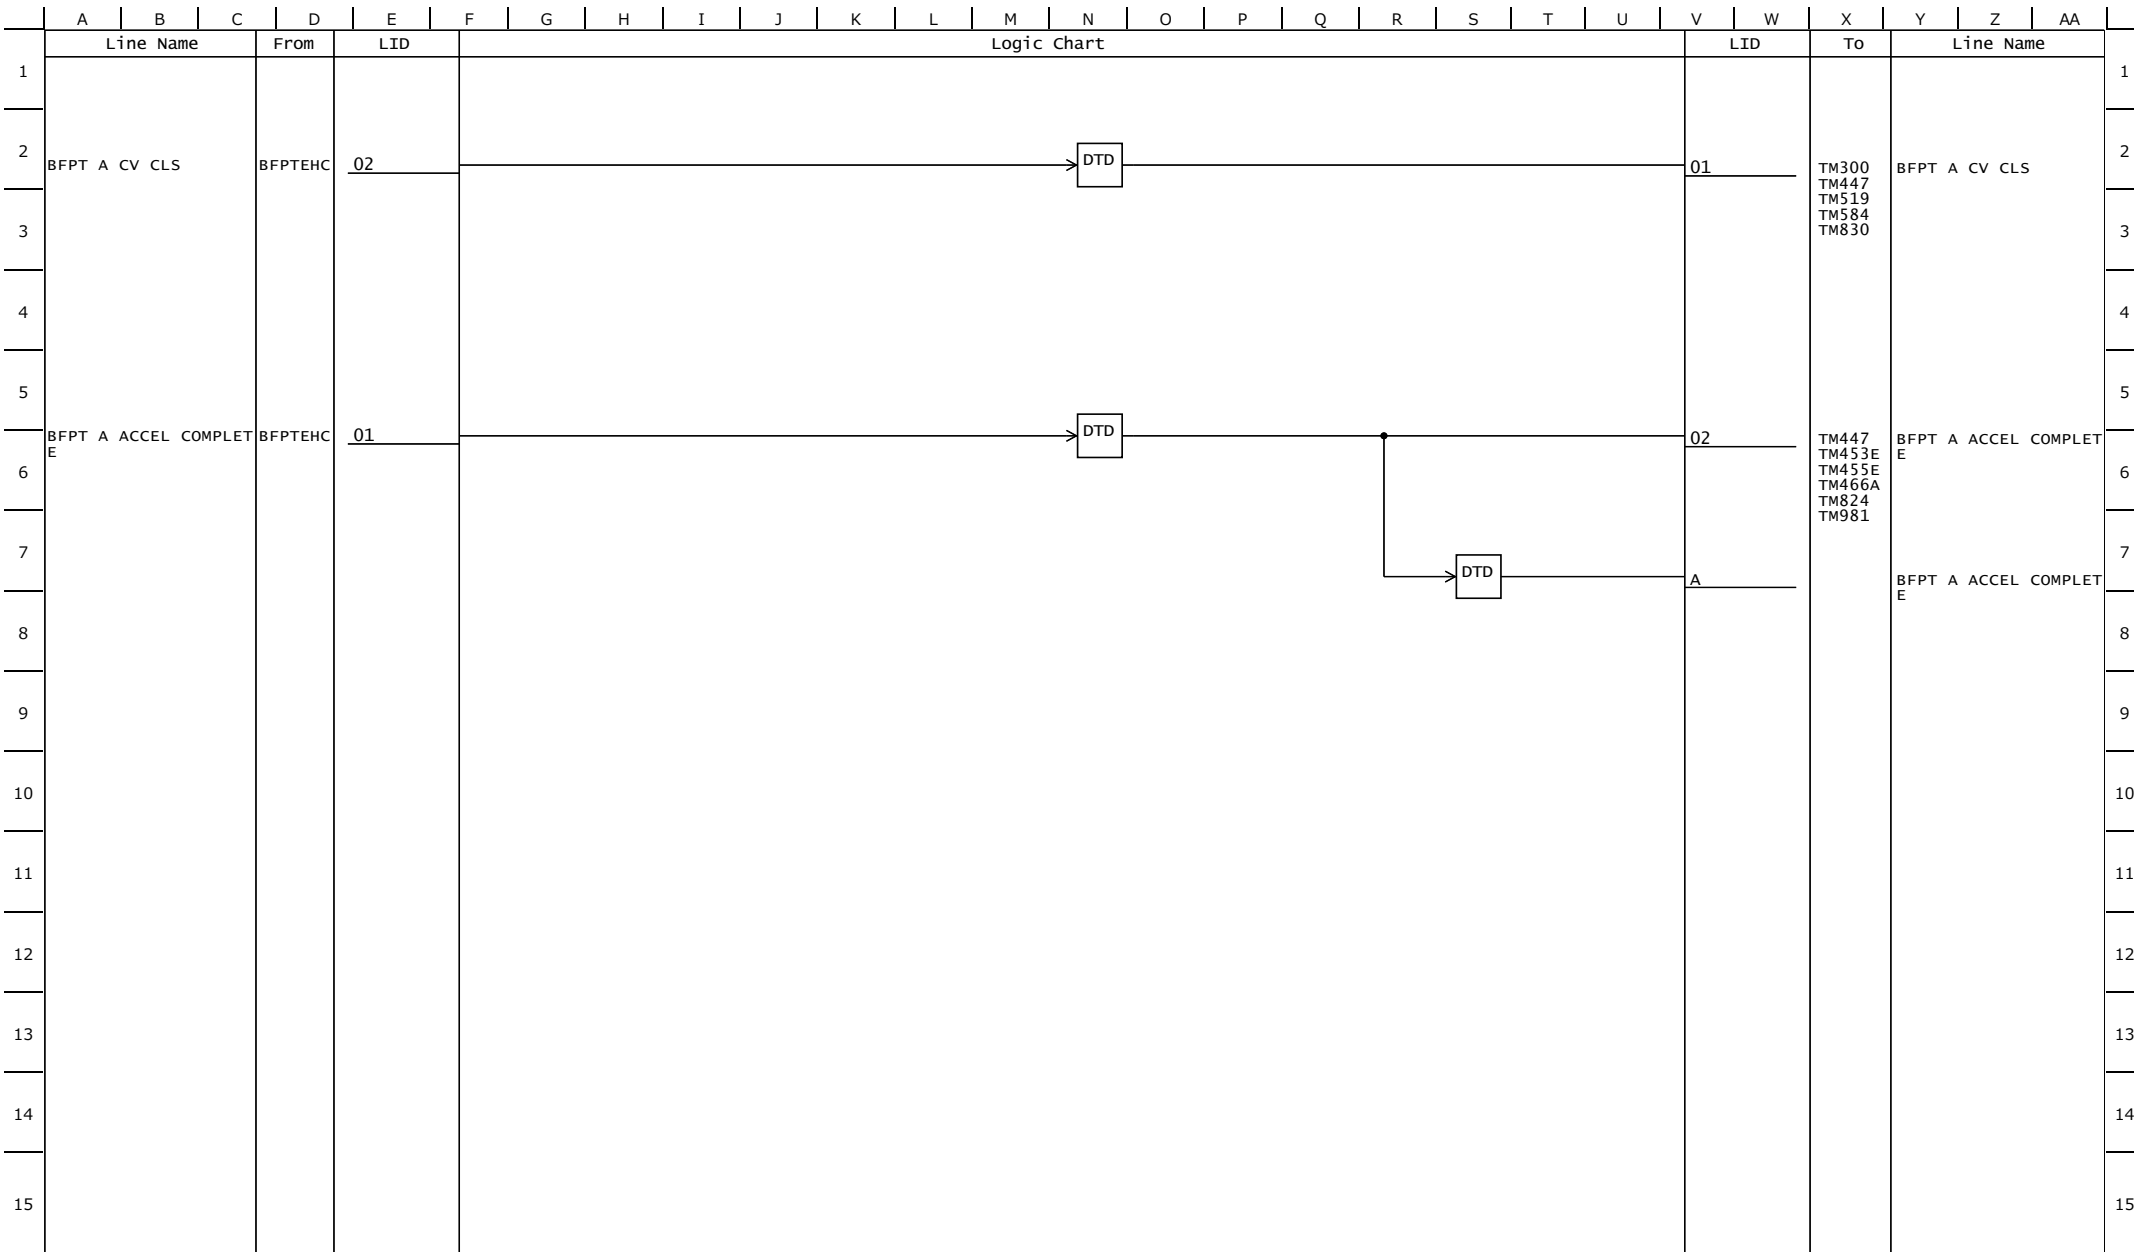


Rev. No.	0	1	2	3				PROJECT Van Phong 1 BOT Thermal Power Plant Project 2×673MW	(TSQ B)			
DATE	2021/6/21	2021/12/15	2022/11/8	2023/7/5								
CONTENTS	1st Issue	Revised (0015)	Revised (0032)	Revised (0163, 0164, 0170)				TITLE	DRAWING No.	SH	REV. MARK	
								SIGNAL TRANSFER (15)	4GCH01007	TM374	3	
								Equipment No. : -				

	A	B	C	D	E	F	G	H	I	J	K	L	M	N	O	P	Q	R	S	T	U	V	W	X	Y	Z	AA			
	Line Name			From	LID	Logic Chart																	LID	To	Line Name					
1	BFPT A CV POSN			BFPTEHC	03	ATA																	01	TM185 TM980 TM981	BFPT A CV POSN	1				
2																										2				
3																										3				
4																										4				
5	BFPT A CV POSN DMD			BFPTEHC	04	ATA																	02	MH153	BFPT A CV POSN DMD	5				
6																										6				
7																										7				
8																										8				
9																										9				
10																										10				
11																										11				
12																										12				
13																										13				
14																										14				
15																										15				
Rev. No.		0		1		2		3								PROJECT				(TSQ B)										
DATE		2021/6/21		2021/12/15		2022/11/8		2023/7/5								Van Phong 1 BOT Thermal Power Plant Project 2×673MW														
CONTENTS		1st Issue		Revised (0007, 0015)		Revised (0032)		Revised (0170)								TITLE				DRAWING No.				SH		REV. MARK				
																SIGNAL TRANSFER (16)				4GCH01007				TM375		3				
																Equipment No. : -														

	A	B	C	D	E	F	G	H	I	J	K	L	M	N	O	P	Q	R	S	T	U	V	W	X	Y	Z	AA		
	Line Name			From	LID	Logic Chart																	LID		To	Line Name			
1	BFPT B CV POSN			BFPTEHC	13	→ATA																	01	TM186 TM980 TM981	BFPT B CV POSN			1	
2																												2	
3																												3	
4																												4	
5	BFPT B CV POSN DMD			BFPTEHC	14	→ATA																	02	MH153	BFPT B CV POSN DMD			5	
6																												6	
7																												7	
8																												8	
9																												9	
10																												10	
11																												11	
12																												12	
13																												13	
14																												14	
15																												15	

Rev. No.	0	1	2					PROJECT	(TSQ B)			
DATE	2021/6/21	2021/12/15	2022/11/8					Van Phong 1 BOT Thermal Power Plant Project 2×673MW				
CONTENTS	1st Issue	Revised (0007, 0015)	Revised (0032)					TITLE	DRAWING No.	SH	REV. MARK	
								SIGNAL TRANSFER (22)	4GCH01007	TM381	2	
								Equipment No. : -				

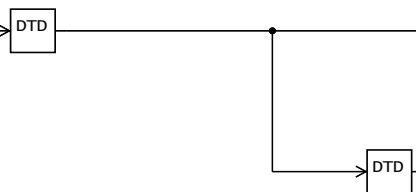	A	B	C	D	E	F	G	H	I	J	K	L	M	N	O	P	Q	R	S	T	U	V	W	X	Y	Z	AA	
	Line Name			From	LID	Logic Chart																	LID	To	Line Name			
1	BFPT B CV CLS			BFPTEHC	12																		01	TM310 TM448 TM669 TM734 TM840	BFPT B CV CLS			1
2																												2
3																												3
4																												4
5	BFPT B ACCEL COMPLET E			BFPTEHC	11																		02	TM448 TM453E TM455E TM466A TM834 TM981	BFPT B ACCEL COMPLET E			5
6																												6
7																												7
8																												8
9																												9
10																												10
11																												11
12																												12
13																												13
14																												14
15																												15

Rev. No.	0	1	2	3				PROJECT	(TSQ B)			
DATE	2021/6/21	2021/12/15	2022/11/8	2023/7/5				Van Phong 1 BOT Thermal Power Plant Project 2×673MW				
CONTENTS	1st Issue	Revised (0015)	Revised (0032)	Revised (0163, 0164)				TITLE	DRAWING No.	SH	REV. MARK	
								SIGNAL TRANSFER (25)	4GCH01007	TM384	3	
Equipment No. : -												

	A	B	C	D	E	F	G	H	I	J	K	L	M	N	O	P	Q	R	S	T	U	V	W	X	Y	Z	AA		
	Line Name			From	LID	Logic Chart																	LID	To	Line Name				
1	ST GEN LOAD (%MW)			TF337	03	0-100-105 %MW → ATA																	21	TM441C TM453F TM455F TM471 TM479 TM814 TM849	ST GEN LOAD (%MW)			1	
2																												2	
3																												3	
4																												4	
5	DFWT LVL LO LO			TF167	01	→ DTD																	01	TM500 TM650 TM920	DFWT LVL LO LO			5	
6																												6	
7	CONDR VAC <170mbara			TD103	10	→ DTD																	02	TM448 TM449 TM814	CONDR VAC <170mbara			7	
8																												8	
9	CONDR VAC A QB			TD103	11	→ DTD																	03	TM814	CONDR VAC A QB			9	
10																												10	
11	M-BFP MIN FCV AUTO			MD109	11	→ DTD																	04	TM435 TM470	M-BFP MIN FCV AUTO			11	
12																												12	
13	T-BFP A MIN FCV AUTO			MD009	11	→ DTD																	05	TM445 TM477A	T-BFP A MIN FCV AUTO			13	
14																												14	
15	T-BFP B MIN FCV AUTO			MD059	11	→ DTD																	06	TM446 TM477B	T-BFP B MIN FCV AUTO			15	
	Rev. No.	0	1											PROJECT					(TSQ B)										
	DATE	2021/6/21	2021/12/15											Van Phong 1 BOT Thermal Power Plant Project 2×673MW															
	CONTENTS	1st Issue	Revised (0015)											TITLE					DRAWING No.					SH		REV. MARK			
														SIGNAL TRANSFER (TSQ A) (26)					4GCH01007					TM385		1			
														Equipment No. : -															

	A	B	C	D	E	F	G	H	I	J	K	L	M	N	O	P	Q	R	S	T	U	V	W	X	Y	Z	AA	
	Line Name			From	LID	Logic Chart																	LID	To	Line Name			
1	BFPT A OIL TNK VAP E XTRCTR STRT CMD			JG416	.02	→ DTD																	01	TM550	BFPT A OIL TNK VAP E XTRCTR STRT CMD			1
2																												2
3	BFPT B OIL TNK VAP E XTRCTR STRT CMD			JG416	.03	→ DTD																	02	TM700	BFPT B OIL TNK VAP E XTRCTR STRT CMD			3
4																												4
5	GCB CLS			TC360	.07	→ DTD																	03	TM814 TY180 TY303	GCB CLS			5
6	BFPT A TGR AUTO CMD			JG415	.04	→ DTD																	04	TM520	BFPT A T-GEAR AUTO C MD			6
7																												7
8	BFPT B TGR AUTO CMD			JG415	.05	→ DTD																	05	TM670	BFPT B T-GEAR AUTO C MD			8
9																												9
10																												10
11																												11
12																												12
13																												13
14																												14
15																												15


Rev. No.	0	1	2					PROJECT Van Phong 1 BOT Thermal Power Plant Project 2×673MW	(TSQ B)		
DATE	2021/6/21	2021/12/15	2022/11/8								
CONTENTS	1st Issue	Revised (0015, 0026)	Revised (0032, 0047)					TITLE	DRAWING No.	SH	REV. MARK
								SIGNAL TRANSFER (ECS A) (27)	4GCH01007	TM386	2
								Equipment No. : -			

	A	B	C	D	E	F	G	H	I	J	K	L	M	N	O	P	Q	R	S	T	U	V	W	X	Y	Z	AA	
	Line Name			From	LID	Logic Chart																	LID	To	Line Name			
1	M-BFP I/S CMD			BB915	04	→DTD																	01	TM921	M-BFP STRT CMD(BSQ)			1
2																												2
3																												3
4																												4
5																												5
6																												6
7																												7
8																												8
9																												9
10																												10
11																												11
12																												12
13																												13
14																												14
15																												15
Rev. No.				0	1	2					PROJECT				(TSQ B)													
DATE				2021/6/21	2021/12/15	2022/11/8					Van Phong 1 BOT Thermal Power Plant Project 2×673MW																	
CONTENTS				1st Issue	Revised (0015)	Revised (0032)					TITLE				DRAWING No.						SH		REV. MARK					
											SIGNAL TRANSFER(BSQ B) (28)				4GCH01007						TM388		2					
											Equipment No. : -																	

	A	B	C	D	E	F	G	H	I	J	K	L	M	N	O	P	Q	R	S	T	U	V	W	X	Y	Z	AA		
	Line Name			From	LID	Logic Chart																	LID	To	Line Name				
1																												1	
2	BFPT A CSG DV OPN CMD (SP1)			TD411	03	→ DTD																	01	TM589	BFPT A CSG DV OPN CMD (SP1)			2	
3	CONDR HTWL LVL HI HI			TF153	03	→ DTD																	02	TM589 TM594 TM599 TM739 TM744 TM749	CONDR HTWL LVL HI HI			3	
4																												4	
5	BFPT A EXH HOOD DV OPN CMD (SP1)			TD411	04	→ DTD																	03	TM594	BFPT A EXH HOOD DV OPN CMD (SP1)			5	
6	BFPT A GLD STM DV OPN CMD (SP1)			TD411	05	→ DTD																	04	TM599	BFPT A GLD STM DV OPN CMD (SP1)			6	
7	BFPT B CSG DV OPN CMD (SP1)			TD411	06	→ DTD																	05	TM739	BFPT B CSG DV OPN CMD (SP1)			7	
8	BFPT B EXH HOOD DV OPN CMD (SP1)			TD411	07	→ DTD																	06	TM744	BFPT B EXH HOOD DV OPN CMD (SP1)			8	
9	BFPT B GLD STM DV OPN CMD (SP1)			TD411	08	→ DTD																	07	TM749	BFPT B GLD STM DV OPN CMD (SP1)			9	
10	ANY CEP RUN & OTL VL V OPN			TF505	02	→ DTD																	08	TM436	ANY CEP RUN & OTL VL V OPN			10	
11	ANY CBP RUN			TF565	02	→ DTD																	09	TM436	ANY CBP RUN			11	
12																												12	
13																												13	
14																												14	
15																												15	
	Rev. No.	0	1											PROJECT					(TSQ B)										
	DATE	2021/6/21	2021/12/15											Van Phong 1 BOT Thermal Power Plant Project 2×673MW															
	CONTENTS	1st Issue	Revised (0015)											TITLE					DRAWING No.					SH		REV. MARK			
														SIGNAL TRANSFER (TSQ A) (91)					4GCH01007					TM390		1			
													Equipment No. : -																

	A	B	C	D	E	F	G	H	I	J	K	L	M	N	O	P	Q	R	S	T	U	V	W	X	Y	Z	AA	
	Line Name			From	LID	Logic Chart																	LID	To	Line Name			
1																												1
2																												2
3																												3
4																												4
5																												5
6	M-BFP MOTOR 2 WDG TE MP U (D/E) HH			JL480	02																		04	TM920	M-BFP MOTOR 2 WDG TE MP U (D/E) HI HI			6
7	M-BFP MOTOR 2 WDG TE MP V (D/E) HH			JL480	03																		05	TM920	M-BFP MOTOR 2 WDG TE MP V (D/E) HI HI			7
8	M-BFP MOTOR 2 WDG TE MP W (D/E) HH			JL480	04																		06	TM920	M-BFP MOTOR 2 WDG TE MP W (D/E) HI HI			8
9																												9
10																												10
11																												11
12																												12
13																												13
14																												14
15																												15

Rev. No.	2	3						PROJECT	(TSQ B)			
DATE	2022/11/8	2023/7/5						Van Phong 1 BOT Thermal Power Plant Project 2×673MW				
CONTENTS	Sheet Added (5126)	Revised (5175)						TITLE	DRAWING No.	SH	REV. MARK	
								SIGNAL TRANSFER (ECS B) (1)	4GCH01007	TM395	3	
								Equipment No. : -				

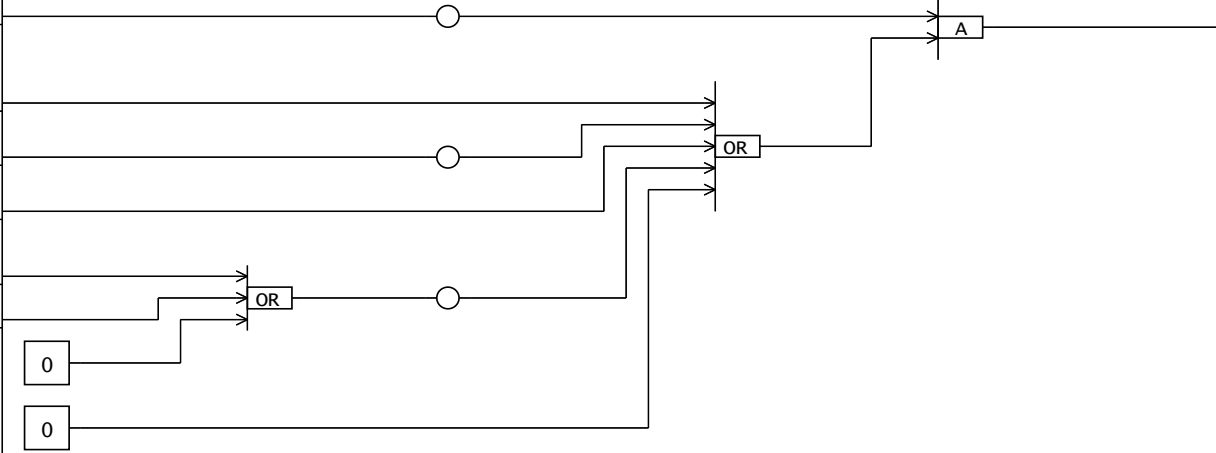	A	B	C	D	E	F	G	H	I	J	K	L	M	N	O	P	Q	R	S	T	U	V	W	X	Y	Z	AA	
	Line Name			From	LID	Logic Chart																	LID	To	Line Name			
1	EVER 0 BFPT A OIL TNK LVL L O BFPT A TRIP BFPT A T-GEAR I/S BFPT A MOP A SEL BFPT A MOP B SEL			TM404	01																		01	TM405	BFPT A OIL SYS STRT MSTR STRT INH			1
2																												2
3																												3
4																												4
5																												5
6																												6
7																												7
8	8																											
9	9																											
10	10																											
11	11																											
12	12																											
13	13																											
14	14																											
15	15																											

Rev. No.	0	1						PROJECT	(TSQ B)			
DATE	2021/6/21	2021/12/15						Van Phong 1 BOT Thermal Power Plant Project 2×673MW				
CONTENTS	1st Issue	Revised (0015)						TITLE	DRAWING No.	SH	REV. MARK	
								BFPT A OIL SYS STRT MSTR STRT INH	4GCH01007	TM401	1	
								Equipment No. : -				

	A	B	C	D	E	F	G	H	I	J	K	L	M	N	O	P	Q	R	S	T	U	V	W	X	Y	Z	AA	
	Line Name			From	LID	Logic Chart																	LID	To	Line Name			
1	BFPT A OIL TNK VAP EXTRCTR ABN BFPT A OIL CONDTR FL TRP ABN BFPT A MOP A ABN BFPT A MOP A LCK BFPT A MOP B ABN BFPT A MOP B LCK EVER 0			TM550 TM560 TM535 TM535 TM540 TM540 TM404	21 21 21 12 21 12 01																		01	TM405 TM406 TM407 TM408	BFPT A OIL SYS STRT MSTR AUX FAIL			1
2																												2
3																												3
4																												4
5																												5
6																												6
7																												7
8																												8
9																												9
10																												10
11																												11
12																												12
13																												13
14																												14
15																												15
Rev. No.				0	1								PROJECT					(TSQ B)										
DATE				2021/6/21	2021/12/15								Van Phong 1 BOT Thermal Power Plant Project 2×673MW															
CONTENTS				1st Issue	Revised (0007, 0015)								TITLE					DRAWING No.					SH	REV. MARK				
													BFPT A OIL SYS STRT MSTR AUX FAILURE					4GCH01007					TM402	1				
													Equipment No. : -															

	A	B	C	D	E	F	G	H	I	J	K	L	M	N	O	P	Q	R	S	T	U	V	W	X	Y	Z	AA	
	Line Name			From	LID	Logic Chart																	LID	To	Line Name			
1						0																	01	TM400 TM401 TM402	EVER 0	1		
2																										2		
3																										3		
4																										4		
5																										5		
6																										6		
7																										7		
8																										8		
9																										9		
10																										10		
11																										11		
12																										12		
13																										13		
14																										14		
15																										15		
Rev. No.				0	1							PROJECT					(TSQ B)											
DATE				2021/6/21	2021/12/15							Van Phong 1 BOT Thermal Power Plant Project 2×673MW																
CONTENTS				1st Issue	Revised (0015)							TITLE					DRAWING No.					SH		REV. MARK				
												BFPT A OIL SYS STRT MSTR SPARE					4GCH01007					TM404		1				
												Equipment No. : -																

	A	B	C	D	E	F	G	H	I	J	K	L	M	N	O	P	Q	R	S	T	U	V	W	X	Y	Z	AA	
	Line Name			From	LID	Logic Chart																	LID	To	Line Name			
1																												1
2																												2
3	BFPT A OIL SYS STRT MSTR M-COMP			TM403	01																							3
4																												4
5	BFPT A OIL SYS STRT MSTR AUX AUTO			TM400	01																							5
6	BFPT A OIL SYS STRT MSTR STRT INH			TM401	01																							6
7	BFPT A OIL SYS STRT MSTR AUX FAIL			TM402	01																							7
8	BFPT A OIL SYS STRT MSTR SP1 FLT			TM406	08																							8
	BFPT A OIL SYS STRT MSTR SP2 FLT			TM407	08																							
9	BFPT A OIL SYS STRT MSTR SP3 FLT			TM408	08																							9
10																												10
11																												11
12																												12
13																												13
14																												14
15																												15

10XAV11EC001

BFPT A OIL SYS STRT MSTR

SEQ-M

-

-

Start

Reset

Pause

ST DMD

PAS

PAS

OPS

M-COMP

AUX Auto

ST INH

Relative

AUX FAIL

SP Fault

PAS

OPS

Start

M-PRCD

S-PRCD

Reset

M-Fault

ST PRMT


ABN

OR


0

Rev. No.	0	1							PROJECT	(TSQ B)				
DATE	2021/6/21	2021/12/15							Van Phong 1 BOT Thermal Power Plant Project 2×673MW					
CONTENTS	1st Issue	Revised (0015)							TITLE	DRAWING No.	SH	REV. MARK		
									BFPT A OIL SYS STRT MSTR (SEQ-M1)	4GCH01007	TM405	1		
									Equipment No. : -					

	A	B	C	D	E	F	G	H	I	J	K	L	M	N	O	P	Q	R	S	T	U	V	W	X	Y	Z	AA																																																																																																																																																																																																																																																																																																																																																																																																																																																																																																																																																																																																																																																																																																																																																																																																																																																																																																																																																																																																																																																																																																																																																																																																																																								
	Line Name			From	LID	Logic Chart																	LID	To	Line Name																																																																																																																																																																																																																																																																																																																																																																																																																																																																																																																																																																																																																																																																																																																																																																																																																																																																																																																																																																																																																																																																																																																																																																																																																																										
1	BFPT A OIL SYS STRT MSTR M-PRCD BFPT A OIL SYS STRT MSTR S-PRCD BFPT A OIL SYS STRT MSTR AUX FAIL BFPT A OIL TNK VAP E XTRCTR RUN BFPT A OIL SYS STRT MSTR STRT BFPT A OIL SYS STRT MSTR RST BFPT A OIL SYS STRT MSTR M-COMP			TM405	02 03 01 Z1 01 04 01	10XAV11EC002 BFPT A OIL TNK VAP E XTRCTR STRT SEQ-S Bypass M-PRCD S-PRCD S-PRCD SP Fault PRE Step SP COMP ST INH AUX FAIL SP COMP Set=20 Start Time= Reset M-COMP DTD																	A	11	TM549	BFPT A OIL TNK VAP E XTRCTR STRT	BFPT A OIL TNK VAP E XTRCTR STRT CMD																																																																																																																																																																																																																																																																																																																																																																																																																																																																																																																																																																																																																																																																																																																																																																																																																																																																																																																																																																																																																																																																																																																																																																																																																																								
2																																																																																																																																																																																																																																																																																																																																																																																																																																																																																																																																																																																																																																																																																																																																																																																																																																																																																																																																																																																																																																																																																																																																																																																																																																																																			

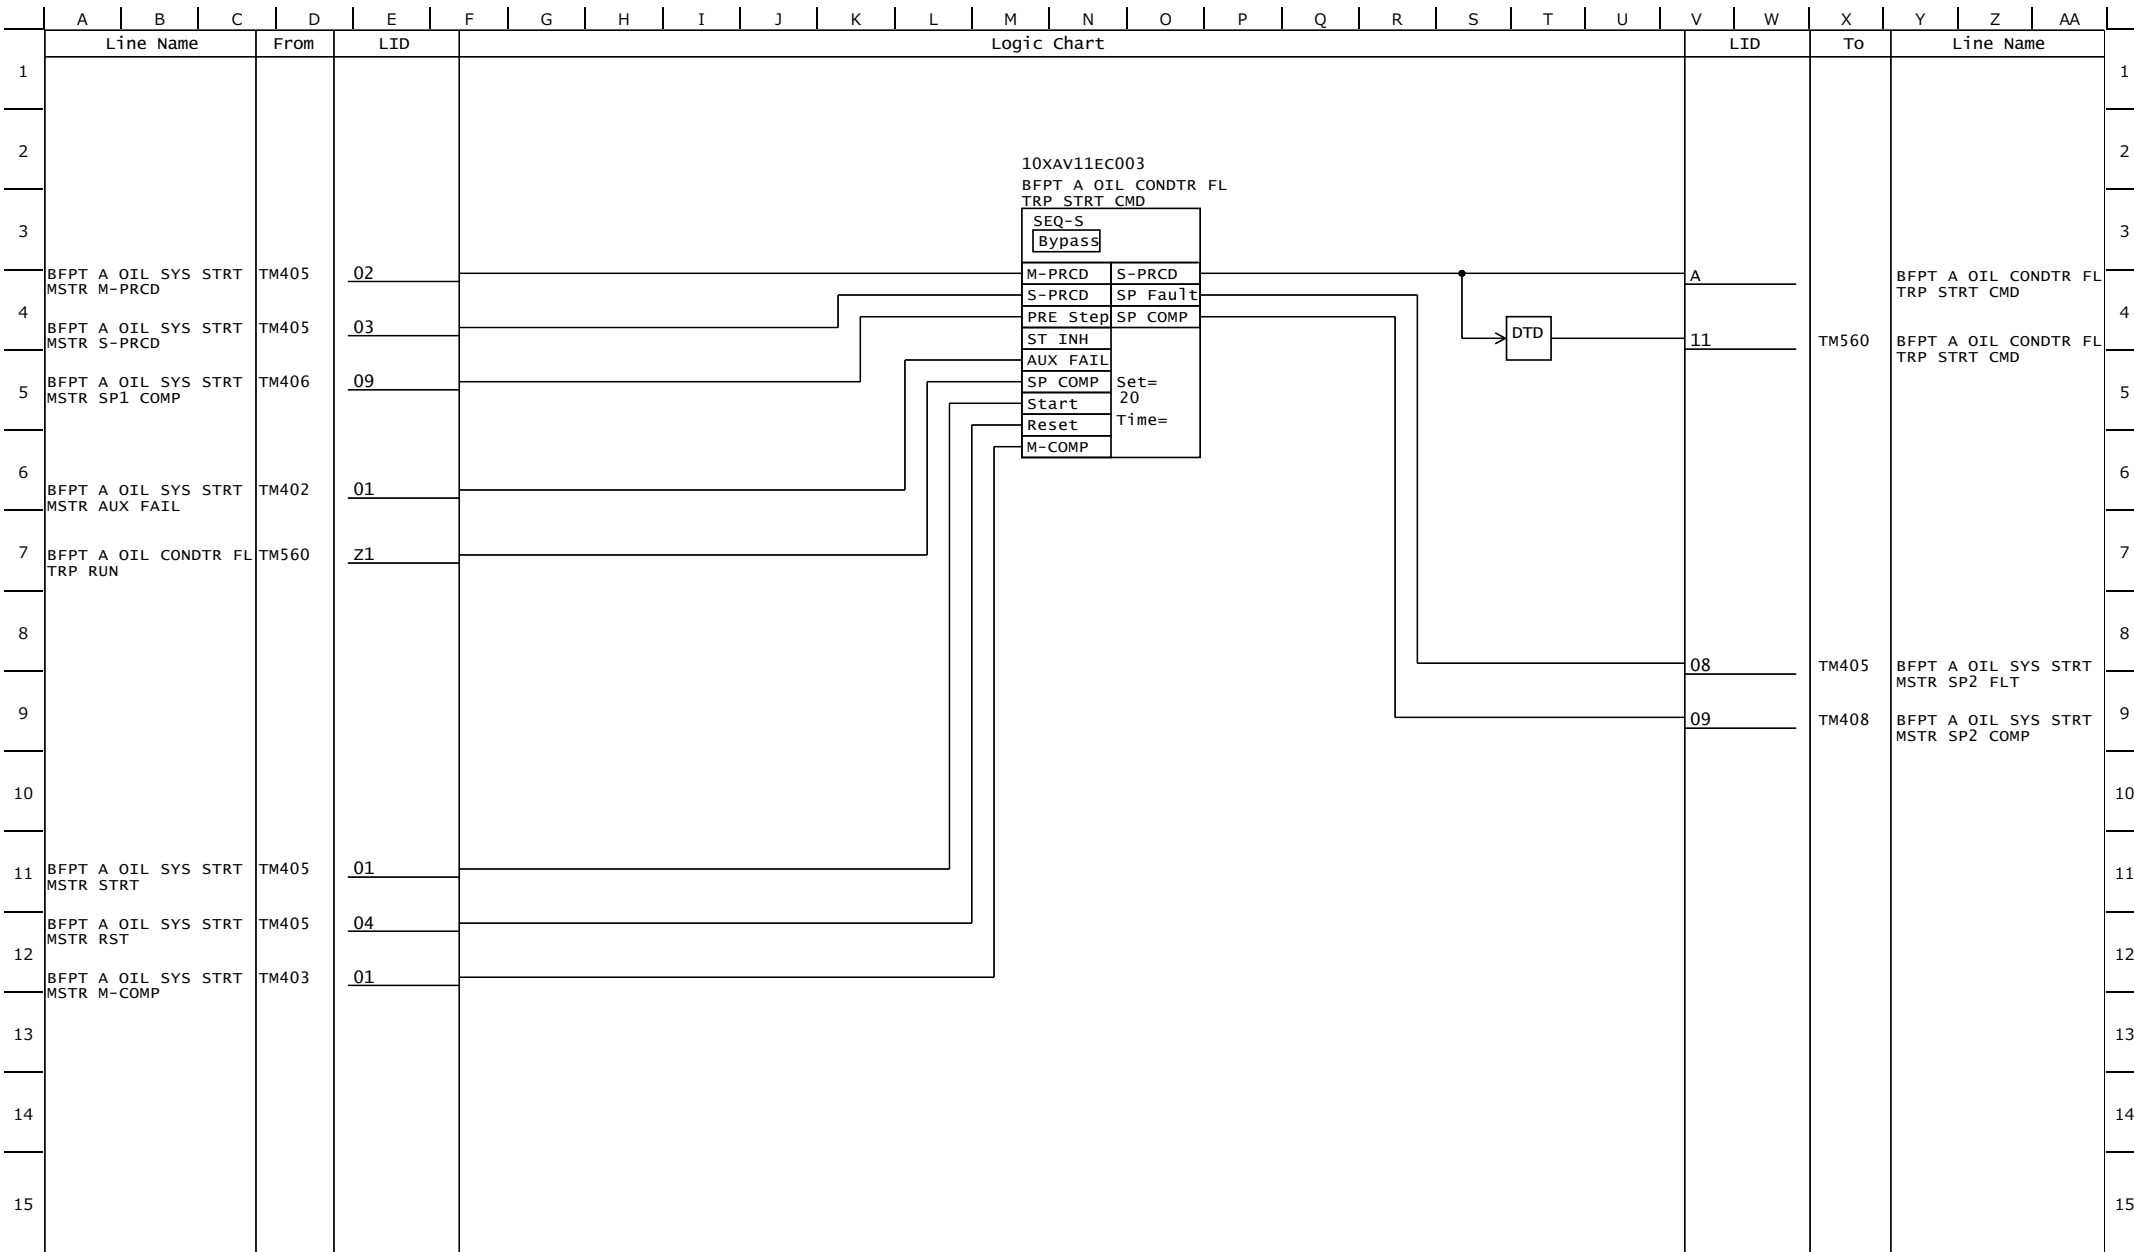


Rev. No.	0	1						PROJECT	(TSQ B)			
DATE	2021/6/21	2021/12/15						Van Phong 1 BOT Thermal Power Plant Project 2×673MW				
CONTENTS	1st Issue	Revised (0015, 0026)						TITLE	DRAWING No.	SH	REV. MARK	
								BFPT A OIL SYS STRT MSTR (SEQ-S2)	4GCH01007	TM407	1	
								Equipment No. : -				

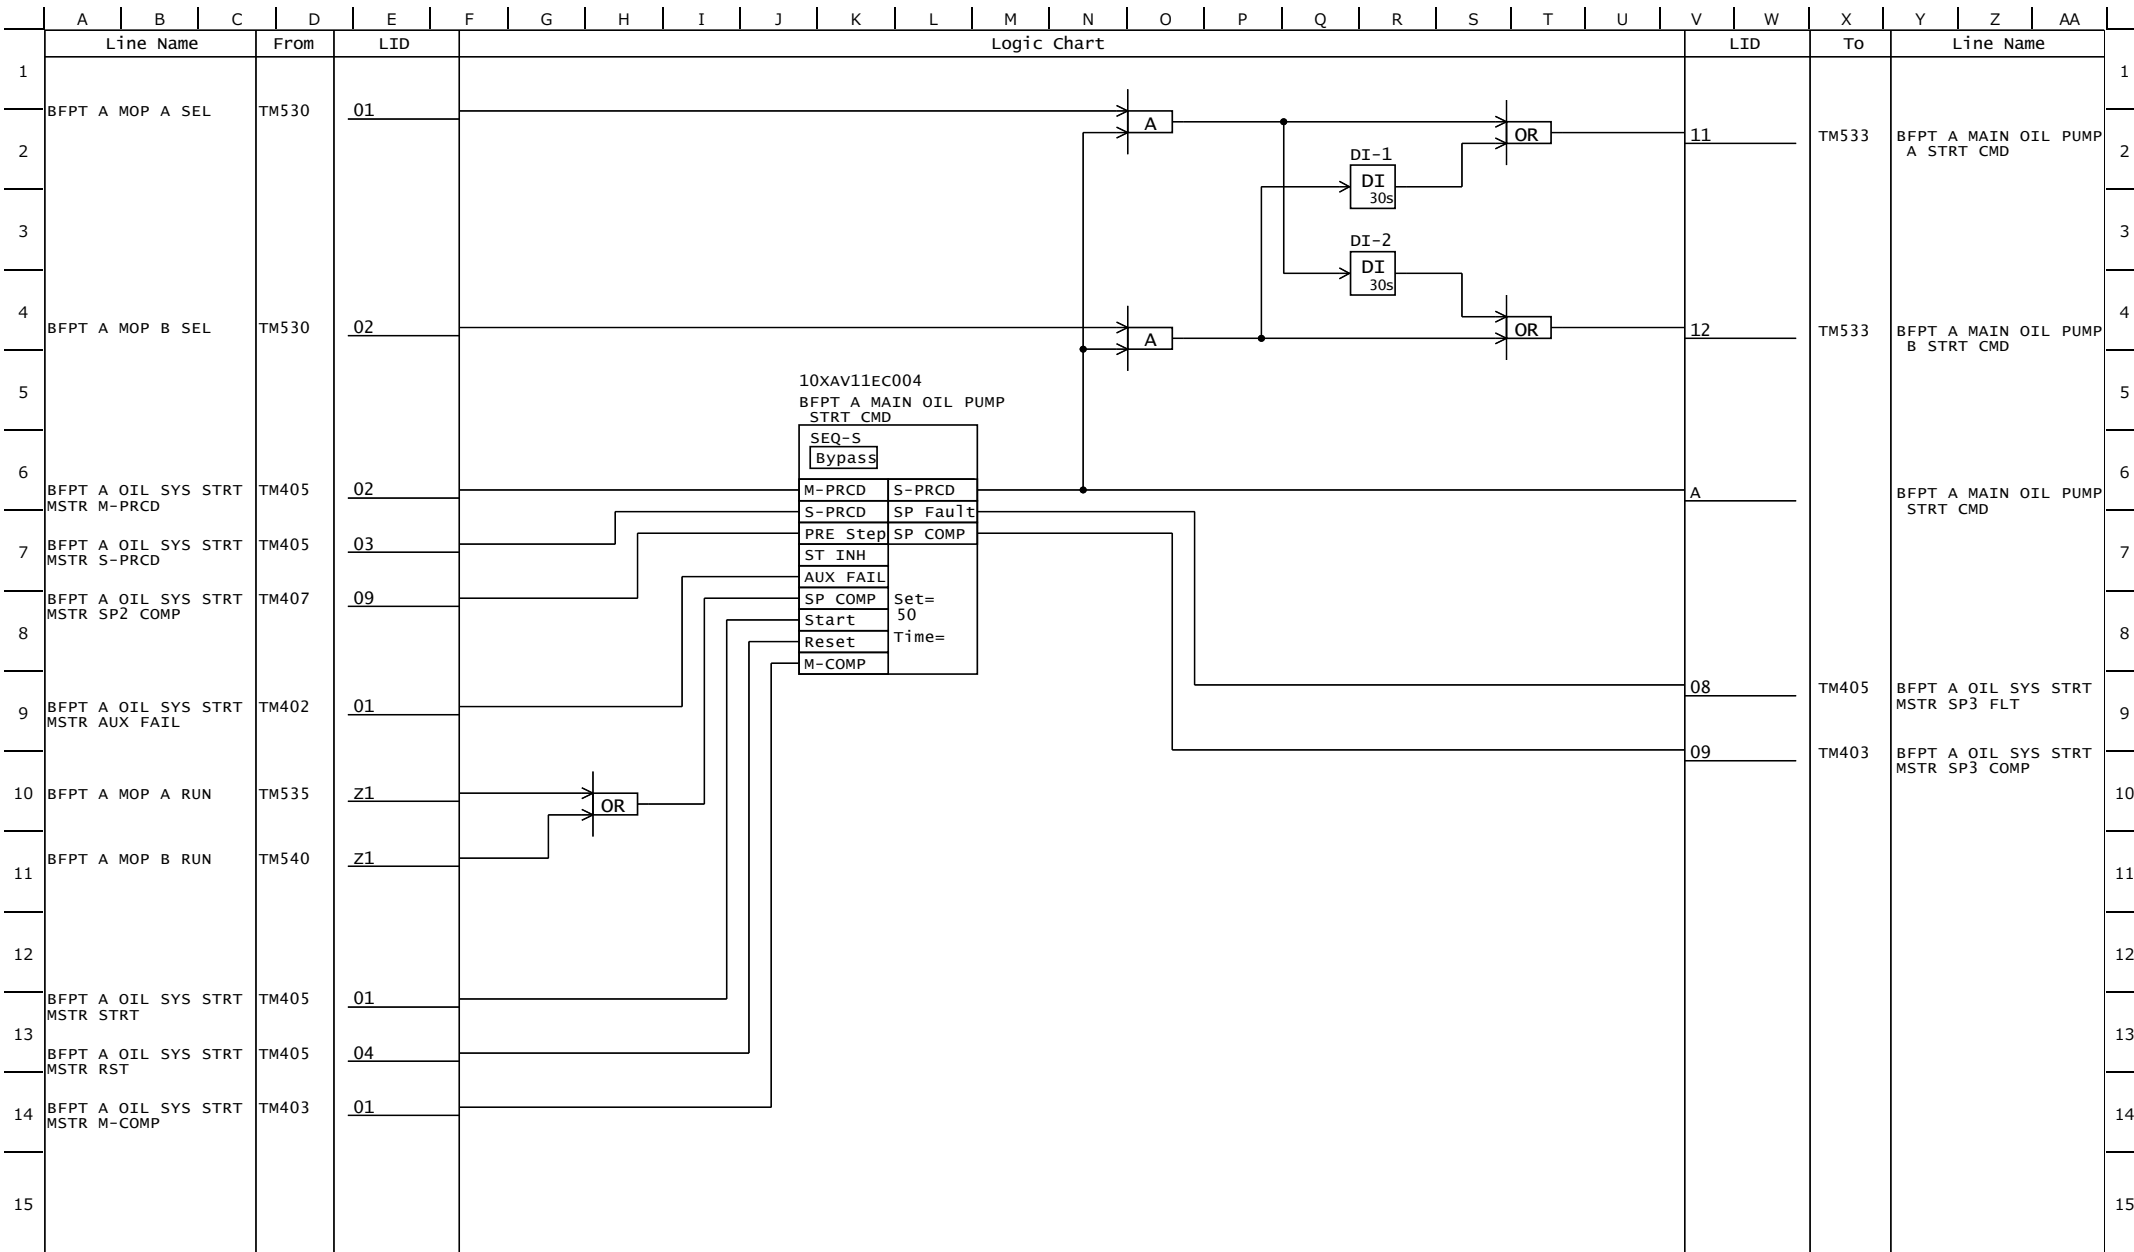

Rev. No.	0	1						PROJECT	(TSQ B)			
DATE	2021/6/21	2021/12/15						Van Phong 1 BOT Thermal Power Plant Project 2×673MW				
CONTENTS	1st Issue	Revised (0015, 0026)						TITLE	DRAWING No.	SH	REV. MARK	
								BFPT A OIL SYS STRT MSTR (SEQ-S3)	4GCH01007	TM408	1	
								Equipment No. : -				


	A	B	C	D	E	F	G	H	I	J	K	L	M	N	O	P	Q	R	S	T	U	V	W	X	Y	Z	AA	
	Line Name			From	LID	Logic Chart																	LID	To	Line Name			
1																												1
2	EVER 0			TM414	01																							2
3	BFPT B OIL TNK VAP E XTRCTR AUTO			TM700	11																							3
4	BFPT B OIL CONDTR FL TRP AUTO			TM710	11																							4
5	BFPT B MOP A AUTO			TM685	11																							5
6	BFPT B MOP B SEL			TM680	02																							6
7	BFPT B MOP A LCK			TM685	12																							7
8	BFPT B MOP B LCK			TM690	12																							8
9																												9
10	BFPT B MOP A SEL			TM680	01																							10
11	BFPT B MOP B AUTO			TM690	11																							11
12																												12
13																												13
14																												14
15																												15

Rev. No.	0	1						PROJECT	(TSQ B)			
DATE	2021/6/21	2021/12/15						Van Phong 1 BOT Thermal Power Plant Project 2×673MW				
CONTENTS	1st Issue	Revised (0015)						TITLE	DRAWING No.	SH	REV. MARK	
								BFPT B OIL SYS STRT MSTR AUX AUTO	4GCH01007	TM410	1	
								Equipment No. : -				

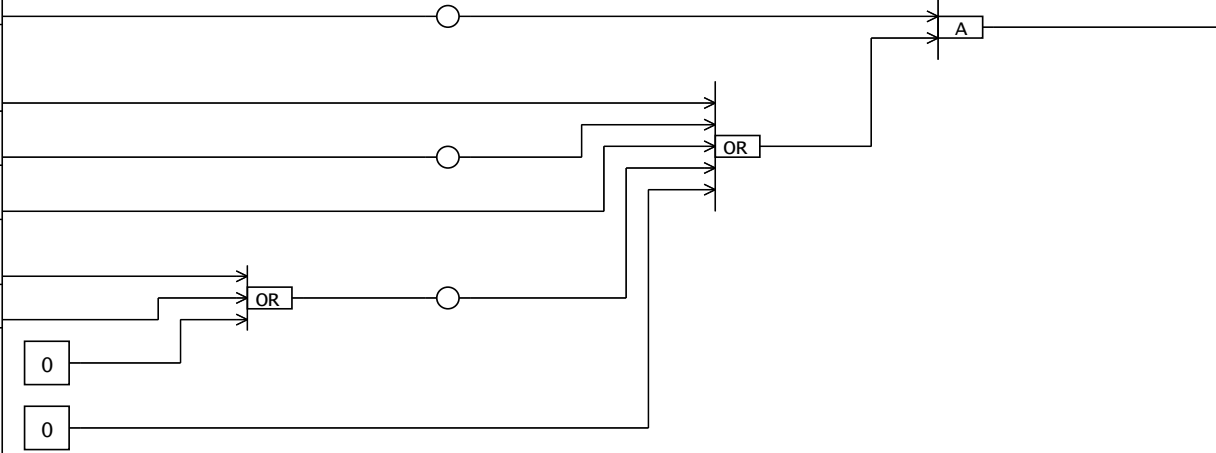	A	B	C	D	E	F	G	H	I	J	K	L	M	N	O	P	Q	R	S	T	U	V	W	X	Y	Z	AA	
	Line Name			From	LID	Logic Chart																	LID	To	Line Name			
1	EVER 0 BFPT B OIL TNK LVL L O BFPT B TRIP BFPT B T-GEAR I/S BFPT B MOP A SEL BFPT B MOP B SEL			TM414	01																		01	TM415	BFPT B OIL SYS STRT MSTR STRT INH			1
2																												2
3																												3
4																												4
5																												5
6																												6
7																												7
8	8																											
9	9																											
10	10																											
11	11																											
12	12																											
13	13																											
14	14																											
15	15																											

Rev. No.	0	1						PROJECT	(TSQ B)			
DATE	2021/6/21	2021/12/15						Van Phong 1 BOT Thermal Power Plant Project 2×673MW				
CONTENTS	1st Issue	Revised (0015)						TITLE	DRAWING No.	SH	REV. MARK	
								BFPT B OIL SYS STRT MSTR STRT INH	4GCH01007	TM411	1	
								Equipment No. : -				


	A	B	C	D	E	F	G	H	I	J	K	L	M	N	O	P	Q	R	S	T	U	V	W	X	Y	Z	AA	
	Line Name			From	LID	Logic Chart																	LID	To	Line Name			
1	BFPT B OIL TNK VAP EXTRCTR ABN BFPT B OIL CONDTR FLTRP ABN BFPT B MOP A ABN BFPT B MOP A LCK BFPT B MOP B ABN BFPT B MOP B LCK EVER 0			TM700	21																		01	TM415 TM416 TM417 TM418	BFPT B OIL SYS STRT MSTR AUX FAIL			1
2																												2
3					3																							
4					4																							
5					5																							
6					6																							
7					7																							
8					8																							
9																												9
10																												10
11																												11
12																												12
13																												13
14																												14
15																												15
Rev. No.				0	1								PROJECT				(TSQ B)											
DATE				2021/6/21	2021/12/15								Van Phong 1 BOT Thermal Power Plant Project 2×673MW															
CONTENTS				1st Issue	Revised (0015)								TITLE				DRAWING No.				SH		REV. MARK					
													BFPT B OIL SYS STRT MSTR AUX FAILURE				4GCH01007				TM412		1					
													Equipment No. : -															

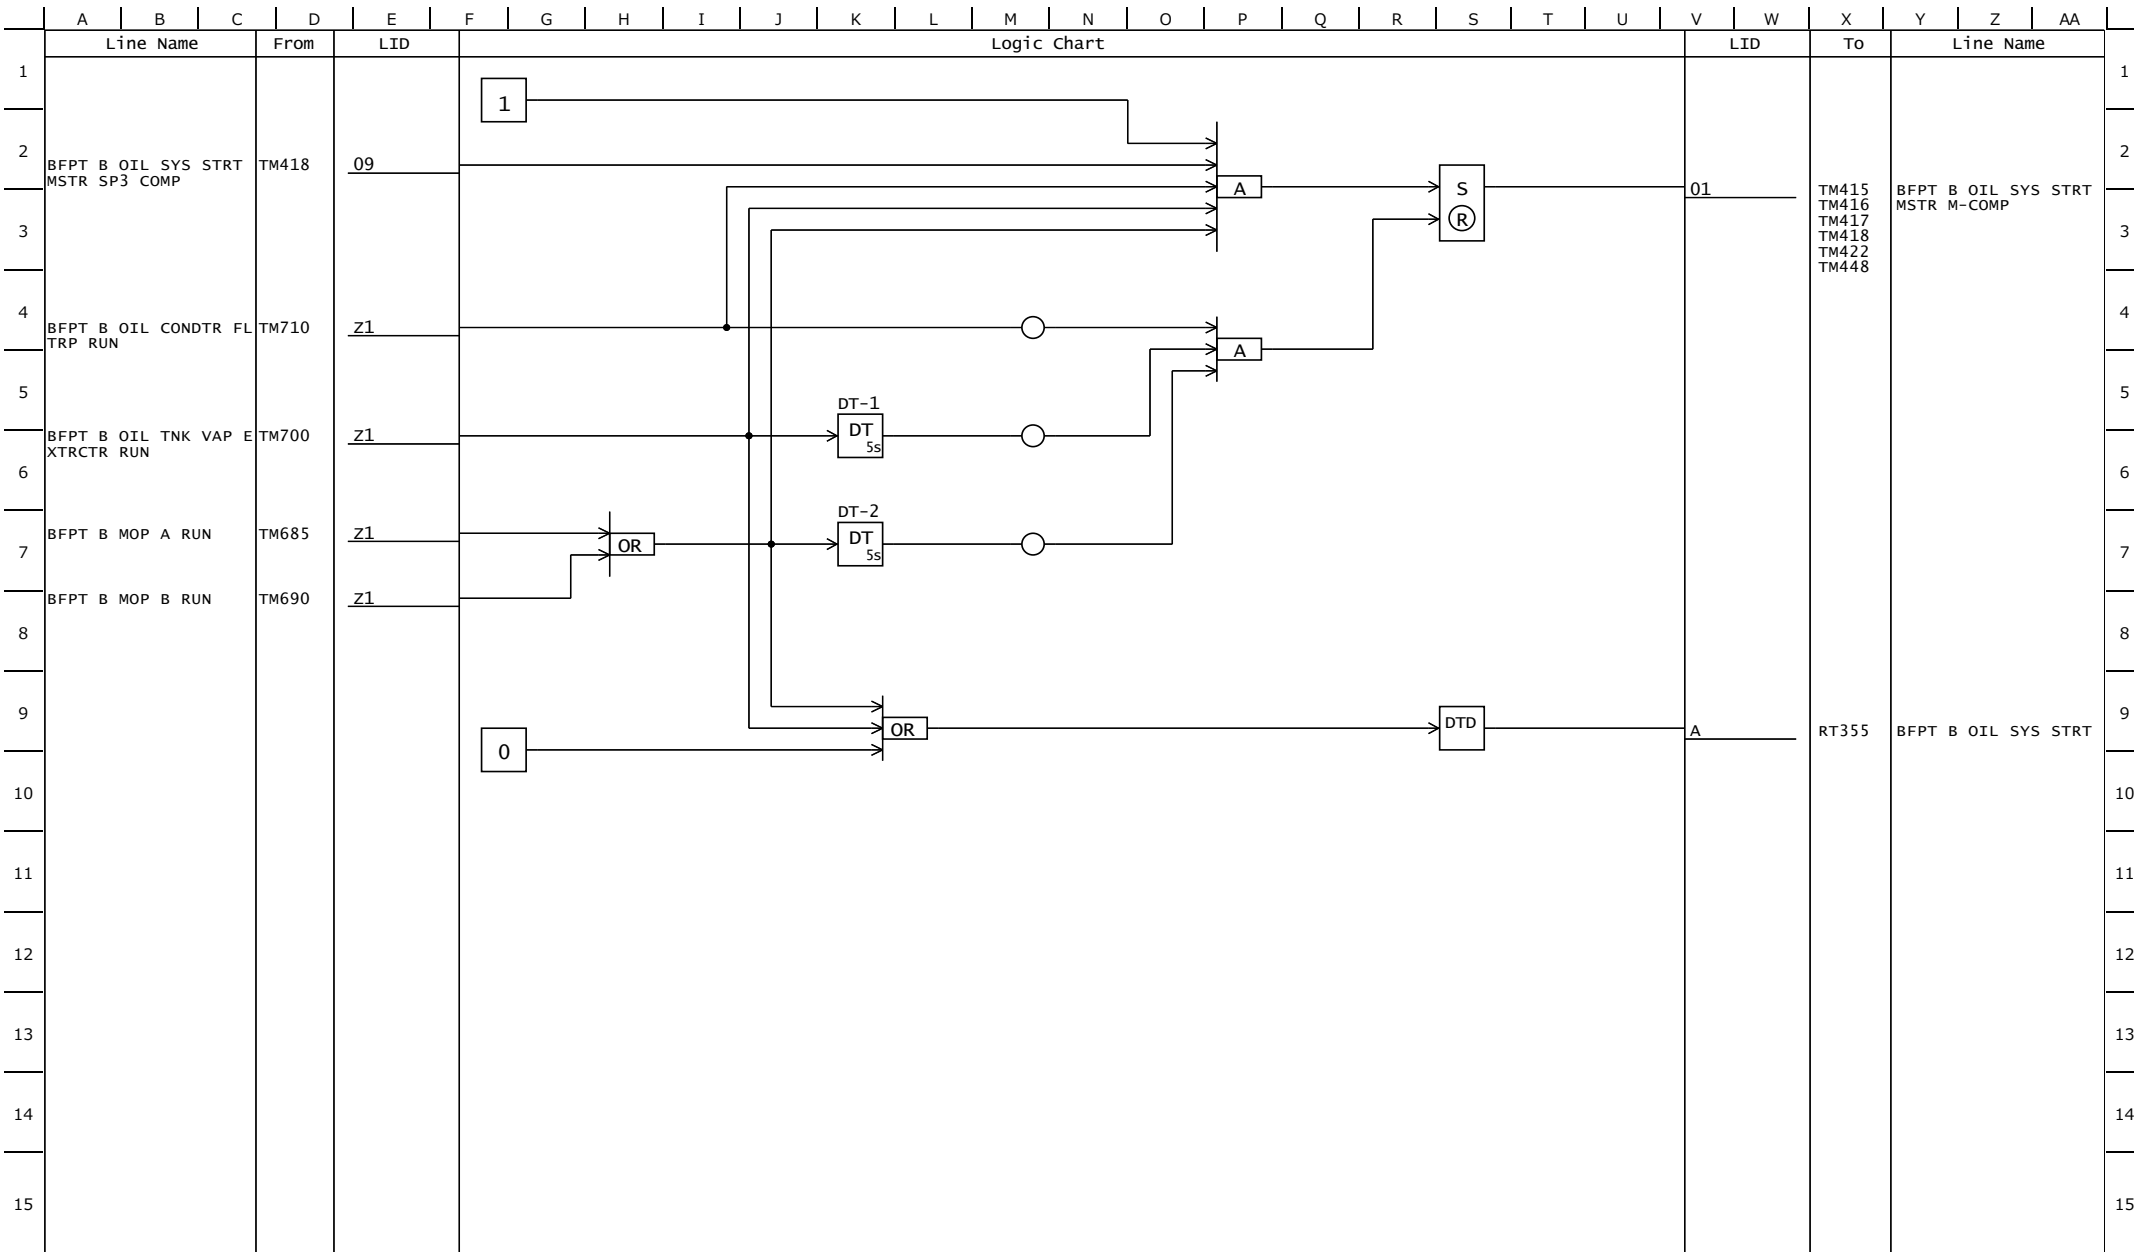


Rev. No.	0	1	2					PROJECT	(TSQ B)			
DATE	2021/6/21	2021/12/15	2022/11/8					Van Phong 1 BOT Thermal Power Plant Project 2×673MW				
CONTENTS	1st Issue	Revised (0015)	Revised (0065)					TITLE	DRAWING No.	SH	REV. MARK	
								BFPT B OIL SYS STRT MSTR COMPLETE	4GCH01007	TM413	2	
								Equipment No. : -				

	A	B	C	D	E	F	G	H	I	J	K	L	M	N	O	P	Q	R	S	T	U	V	W	X	Y	Z	AA
	Line Name			From	LID	Logic Chart																	LID	To	Line Name		
1						0																	01	TM410 TM411 TM412	EVER 0	1	
2																										2	
3																										3	
4																										4	
5																										5	
6																										6	
7																										7	
8																										8	
9																										9	
10																										10	
11																										11	
12																										12	
13																										13	
14																										14	
15																										15	
Rev. No.		0		1										PROJECT				(TSQ B)									
DATE		2021/6/21		2021/12/15										Van Phong 1 BOT Thermal Power Plant Project 2×673MW													
CONTENTS		1st Issue		Revised (0015)										TITLE				DRAWING No.				SH		REV. MARK			
														BFPT B OIL SYS STRT MSTR SPARE				4GCH01007				TM414		1			
														Equipment No. : -													


	A	B	C	D	E	F	G	H	I	J	K	L	M	N	O	P	Q	R	S	T	U	V	W	X	Y	Z	AA	
	Line Name			From	LID	Logic Chart																	LID	To	Line Name			
1	BFPT B OIL SYS STRT MSTR M-COMP			TM413	01	10XAV21EC001 BFPT B OIL SYS STRT MSTR SEQ-M - - Start Reset Pause ST DMD PAS PAS OPS OPS Start M-COMP M-PRCD AUX Auto S-PRCD ST INH Reset Relative M-Fault AUX FAIL ST PRMT SP Fault ABN																	01	TM416 TM417 TM418	BFPT B OIL SYS STRT MSTR STRT	1		
2																										2		
3																										3		
4																										4		
5																										5		
6																										6		
7																										7		
8																										8		
9																										9		
10	BFPT B OIL SYS STRT MSTR SP1 FLT			TM416	08	OR																	02	TM416 TM417 TM418	BFPT B OIL SYS STRT MSTR M-PRCD	10		
8	BFPT B OIL SYS STRT MSTR SP2 FLT			TM417	08																					8		
9	BFPT B OIL SYS STRT MSTR SP3 FLT			TM418	08																					9		
10																										10		
11						0																	03	TM416 TM417 TM418 TM699	BFPT B OIL SYS STRT MSTR S-PRCD	11		
12																										12		
13																										13		
14																										14		
15																										15		
Rev.No.		0		1										PROJECT				(TSQ B)										
DATE		2021/6/21		2021/12/15										Van Phong 1 BOT Thermal Power Plant Project 2×673MW														
CONTENTS		1st Issue		Revised (0015)										TITLE				DRAWING No.				SH		REV. MARK				
														BFPT B OIL SYS STRT MSTR (SEQ-M1)				4GCH01007				TM415		1				
														Equipment No. : -														

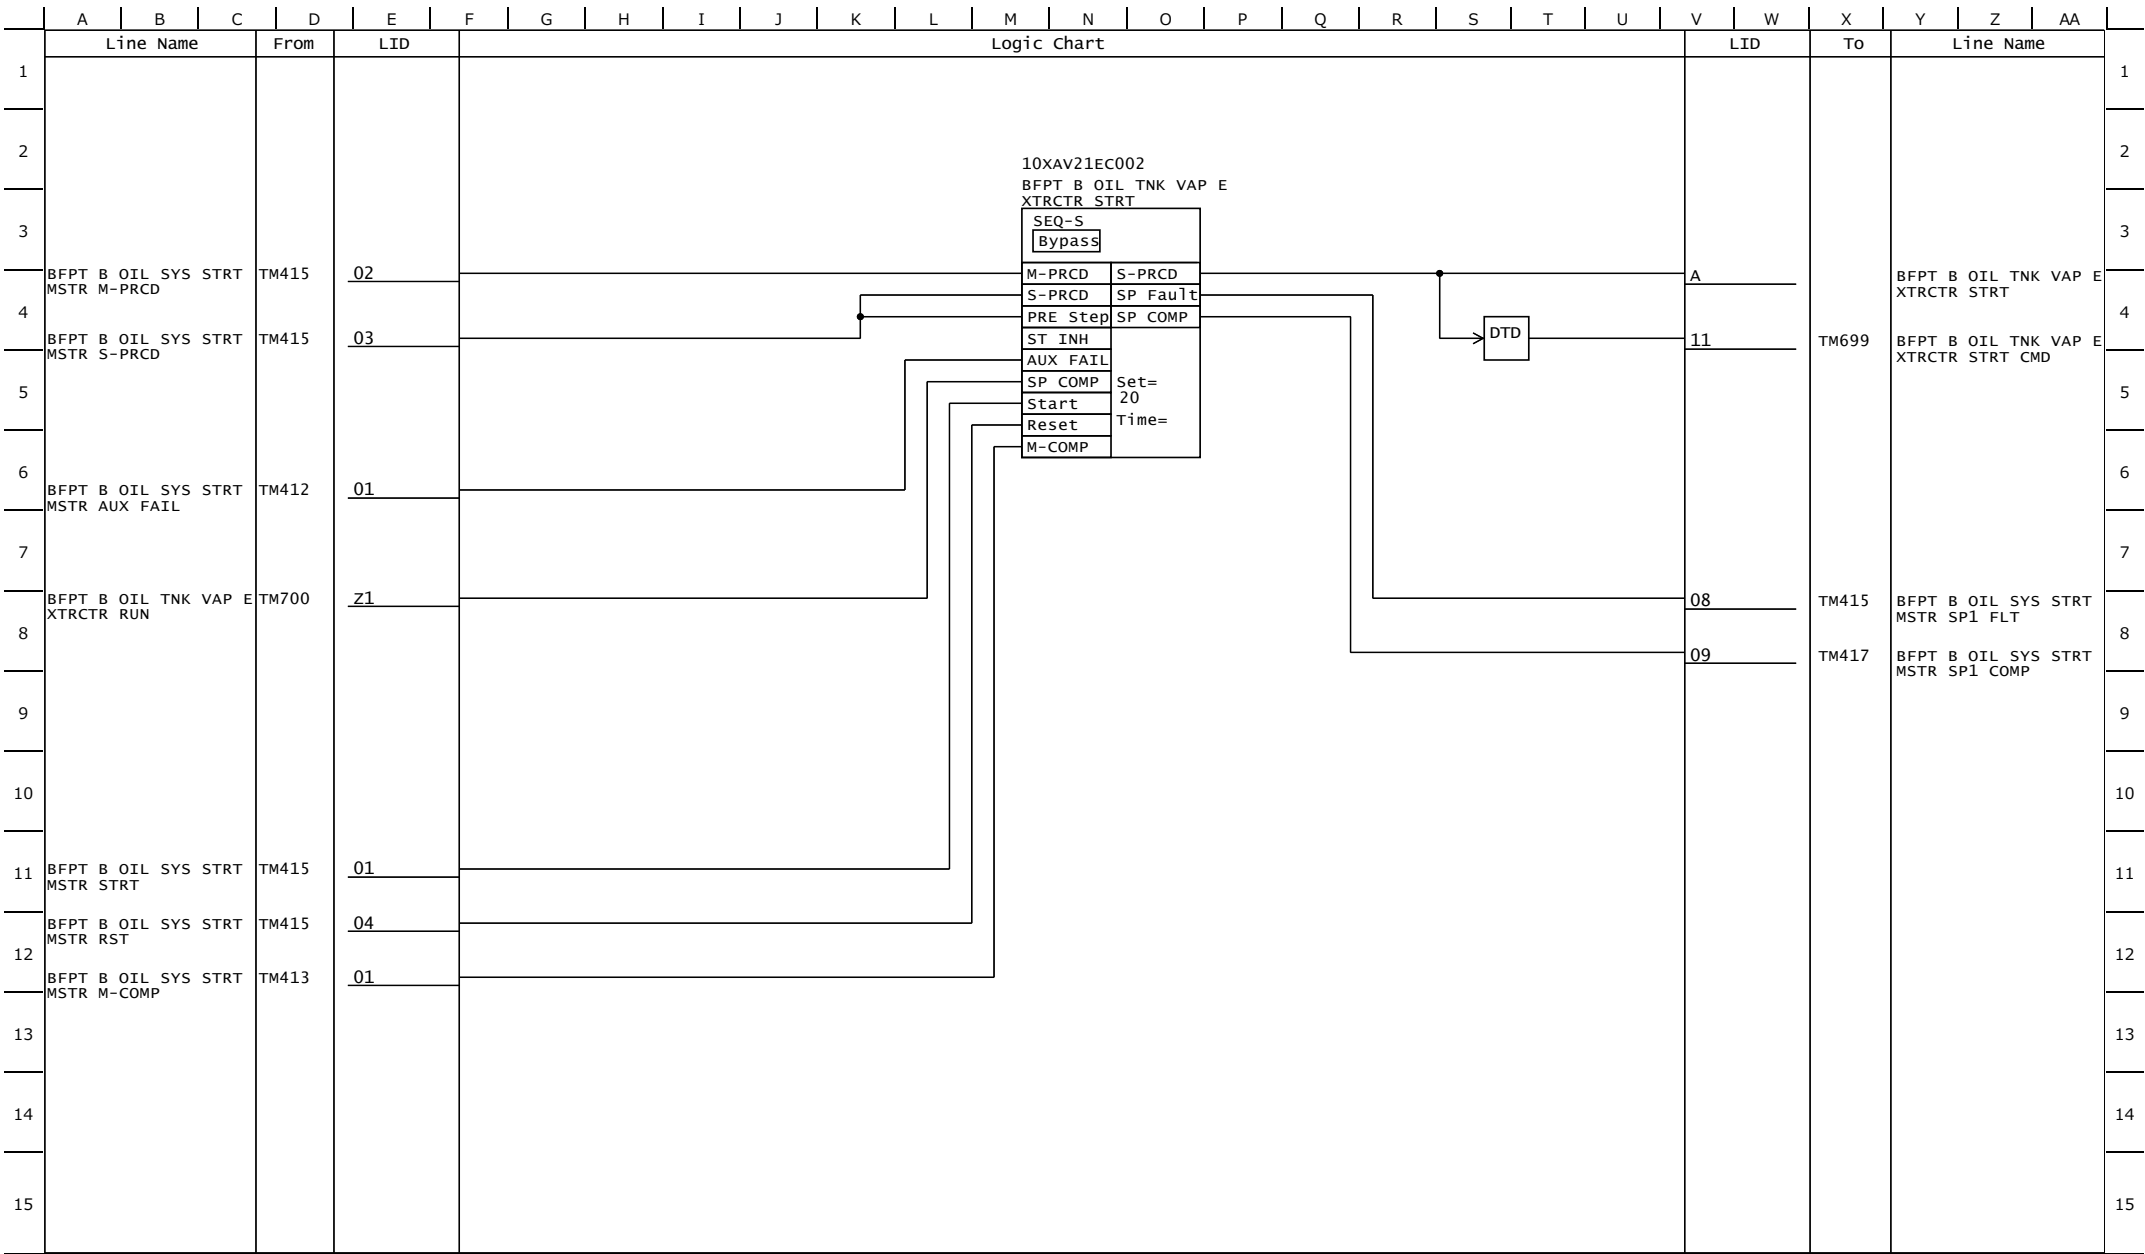


Rev. No.	0	1						PROJECT	(TSQ B)			
DATE	2021/6/21	2021/12/15						Van Phong 1 BOT Thermal Power Plant Project 2×673MW				
CONTENTS	1st Issue	Revised (0015, 0026)						TITLE	DRAWING No.	SH	REV. MARK	
								BFPT B OIL SYS STRT MSTR (SEQ-S1)	4GCH01007	TM416	1	
								Equipment No. : -				

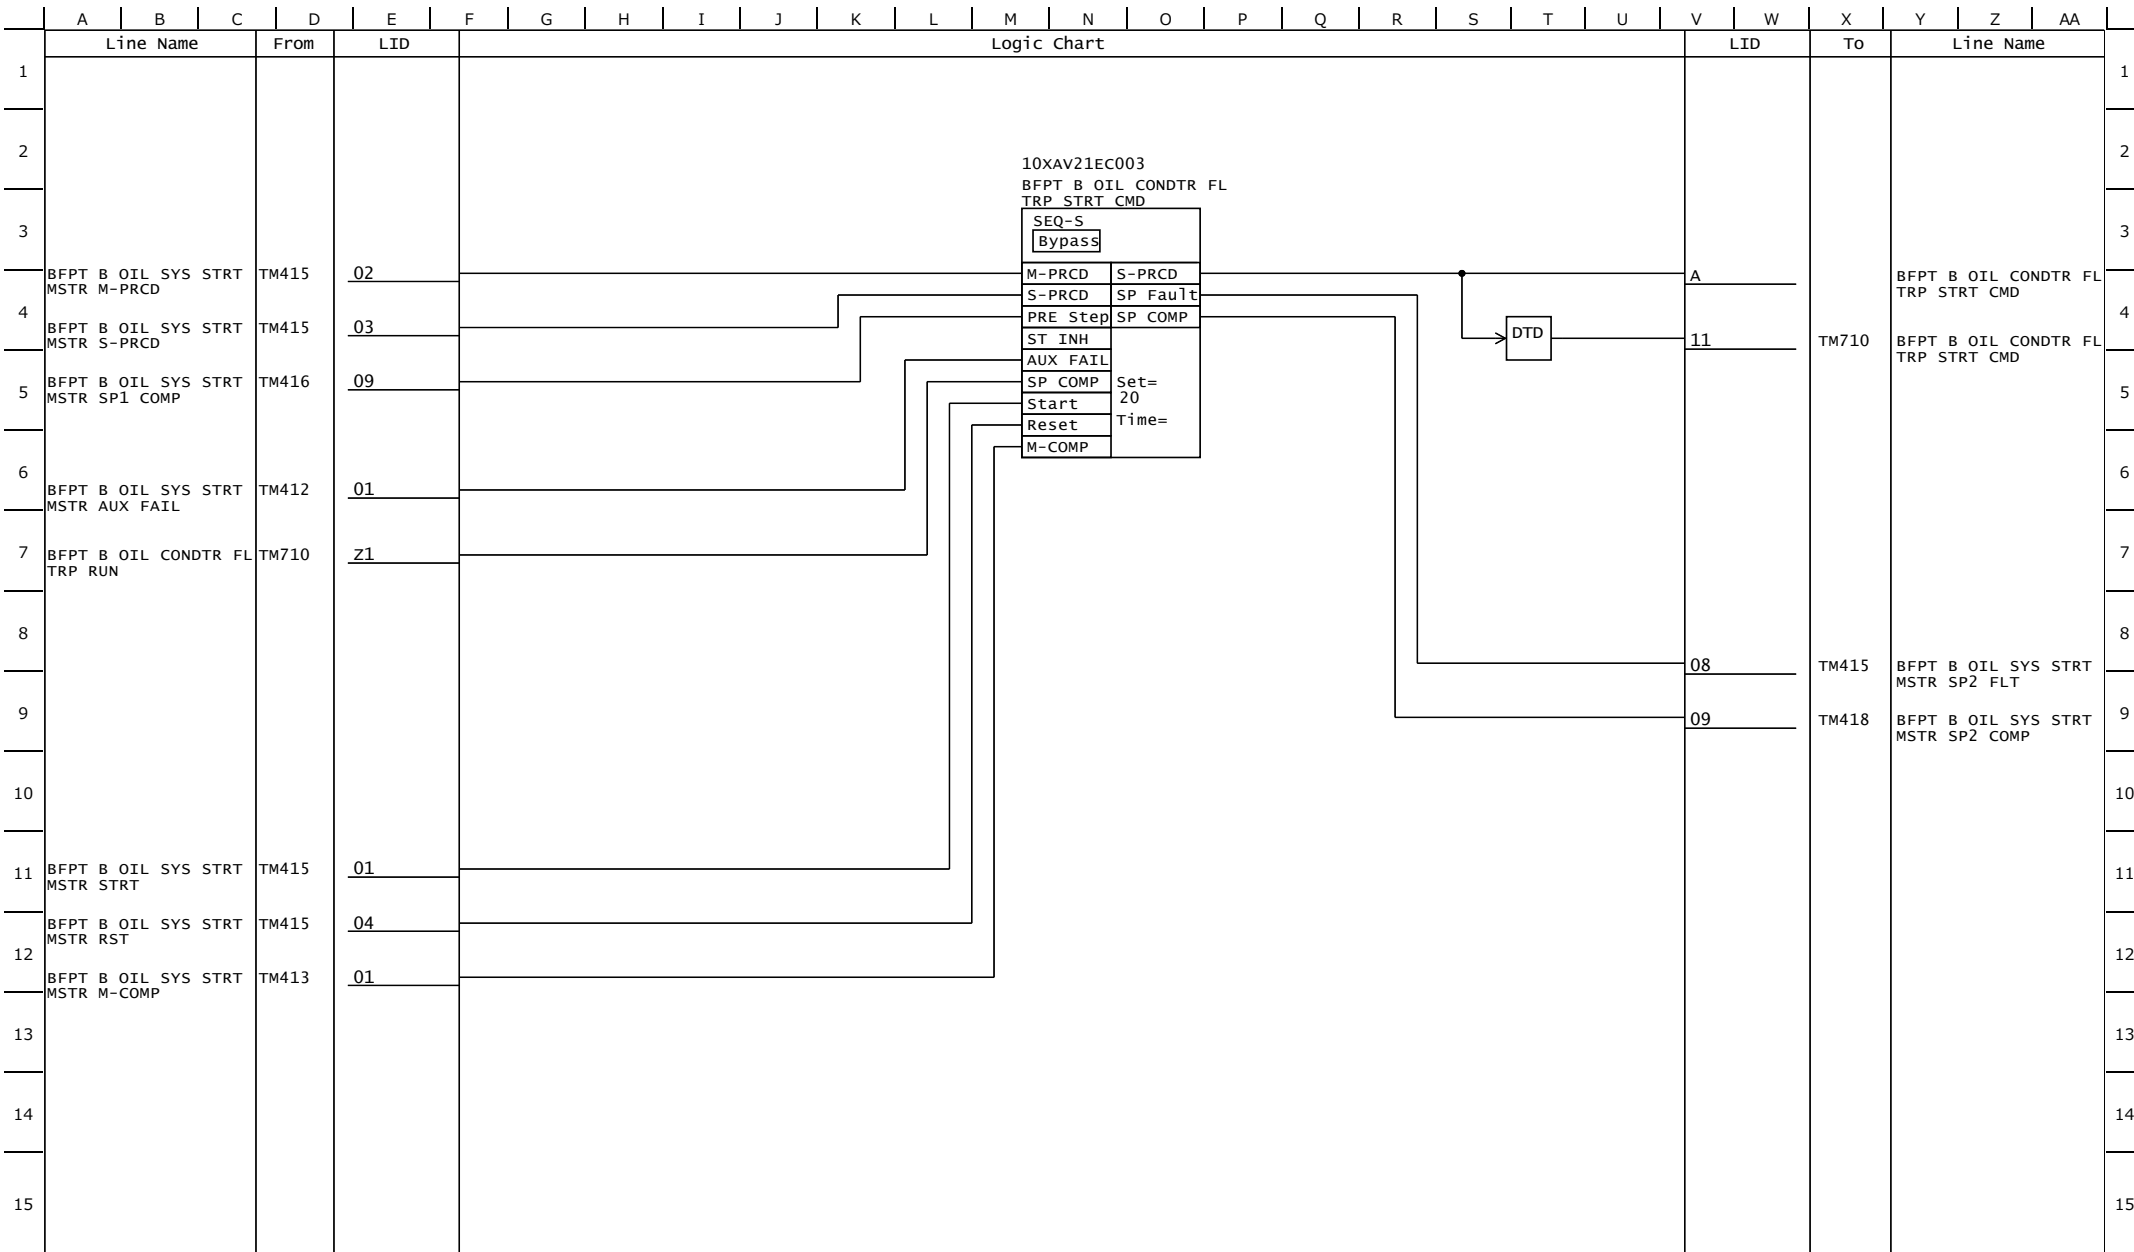

Rev. No.	0	1						PROJECT	(TSQ B)			
DATE	2021/6/21	2021/12/15						Van Phong 1 BOT Thermal Power Plant Project 2×673MW				
CONTENTS	1st Issue	Revised (0015, 0026)						TITLE	DRAWING No.	SH	REV. MARK	
								BFPT B OIL SYS STRT MSTR (SEQ-S2)	4GCH01007	TM417	1	
								Equipment No. : -				

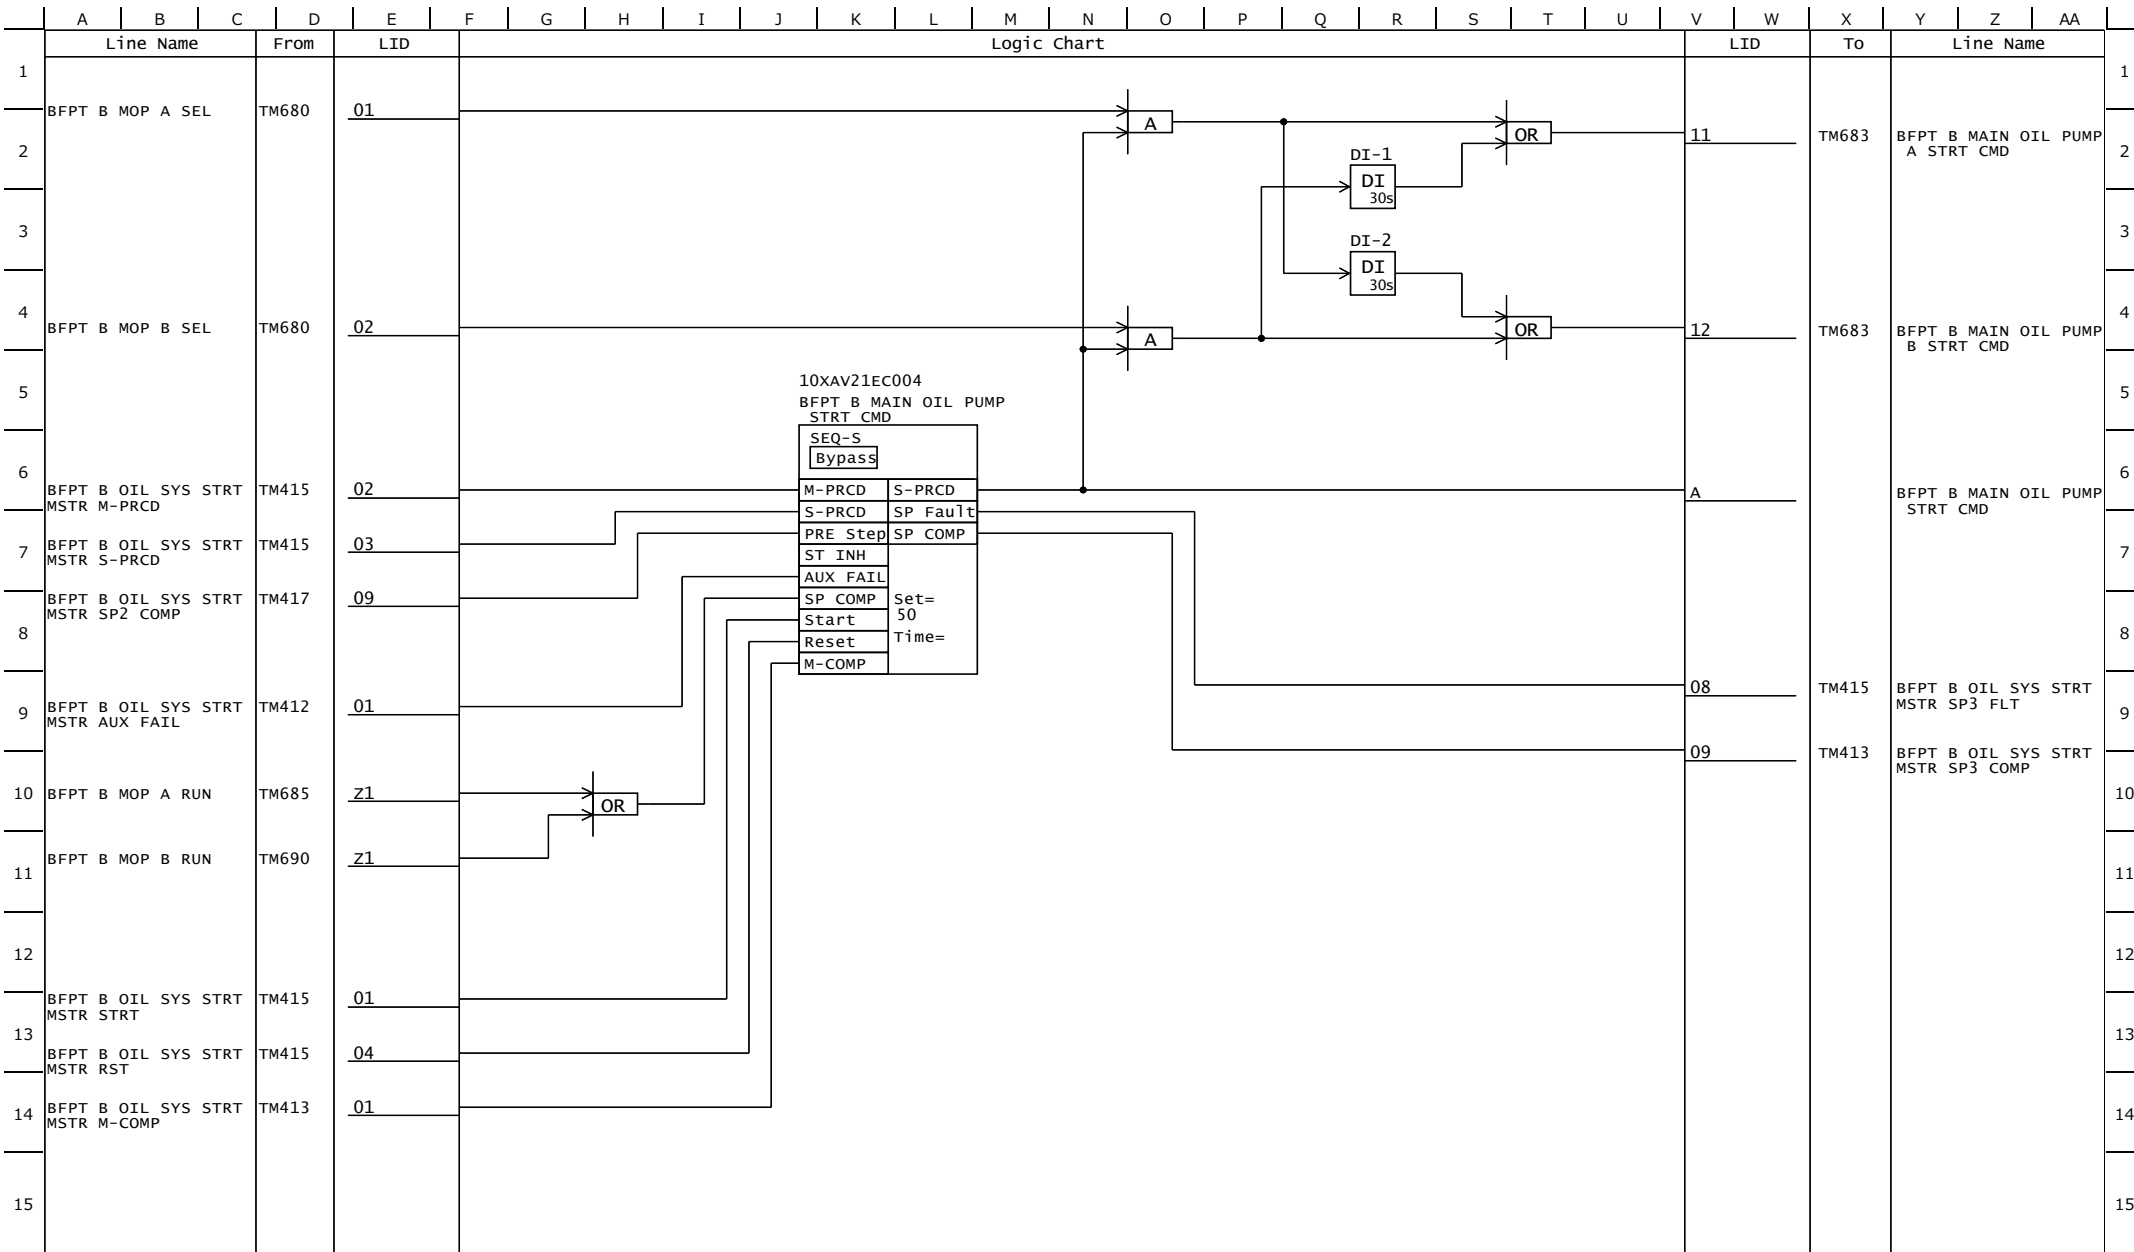



Rev. No.	0	1						PROJECT	(TSQ B)			
DATE	2021/6/21	2021/12/15						Van Phong 1 BOT Thermal Power Plant Project 2×673MW				
CONTENTS	1st Issue	Revised (0015, 0026)						TITLE	DRAWING No.	SH	REV. MARK	
								BFPT B OIL SYS STRT MSTR (SEQ-S3)	4GCH01007	TM418	1	
								Equipment No. : -				

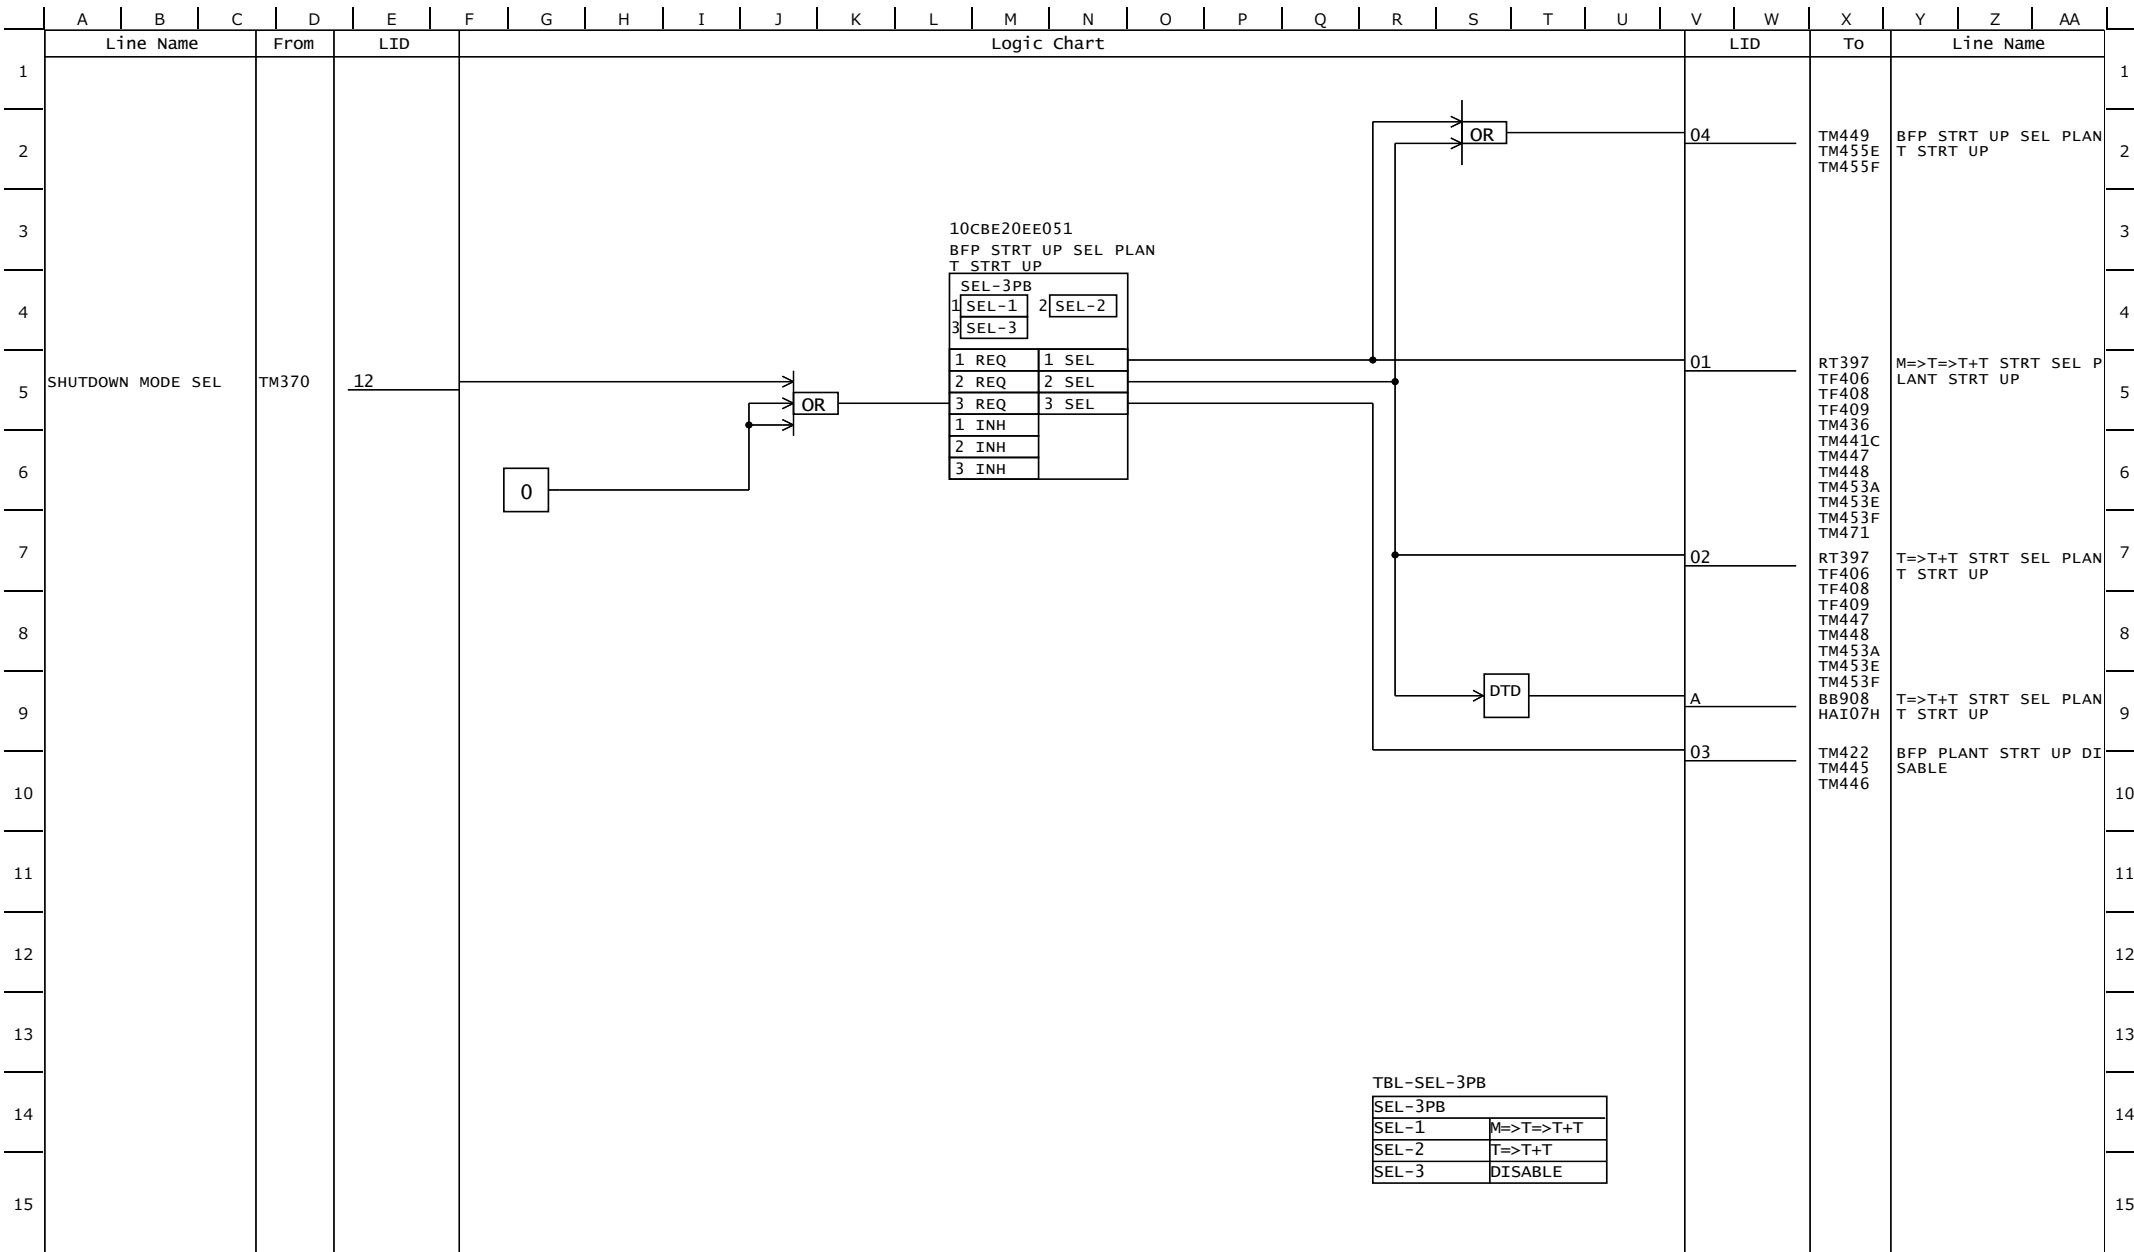

TBL-SEL-3PB	
SEL-3PB	
SEL-1	M=>T=>T+T
SEL-2	T=>T+T
SEL-3	DISABLE

Rev. No.	0	1	2	3				PROJECT	(TSQ B)						
DATE	2021/6/21	2021/12/15	2022/11/8	2023/7/5				Van Phong 1 BOT Thermal Power Plant Project 2×673MW							
CONTENTS	1st Issue	Revised (0015, 0024, 0030)	Revised (0037, 0048, 0064, 0065)	Revised (0135, 0164, 0186)				TITLE BFP STRT UP SEL PLANT SET UP	DRAWING No.	SH	REV. MARK				
								Equipment No. : -	4GCH01007	TM420	3				

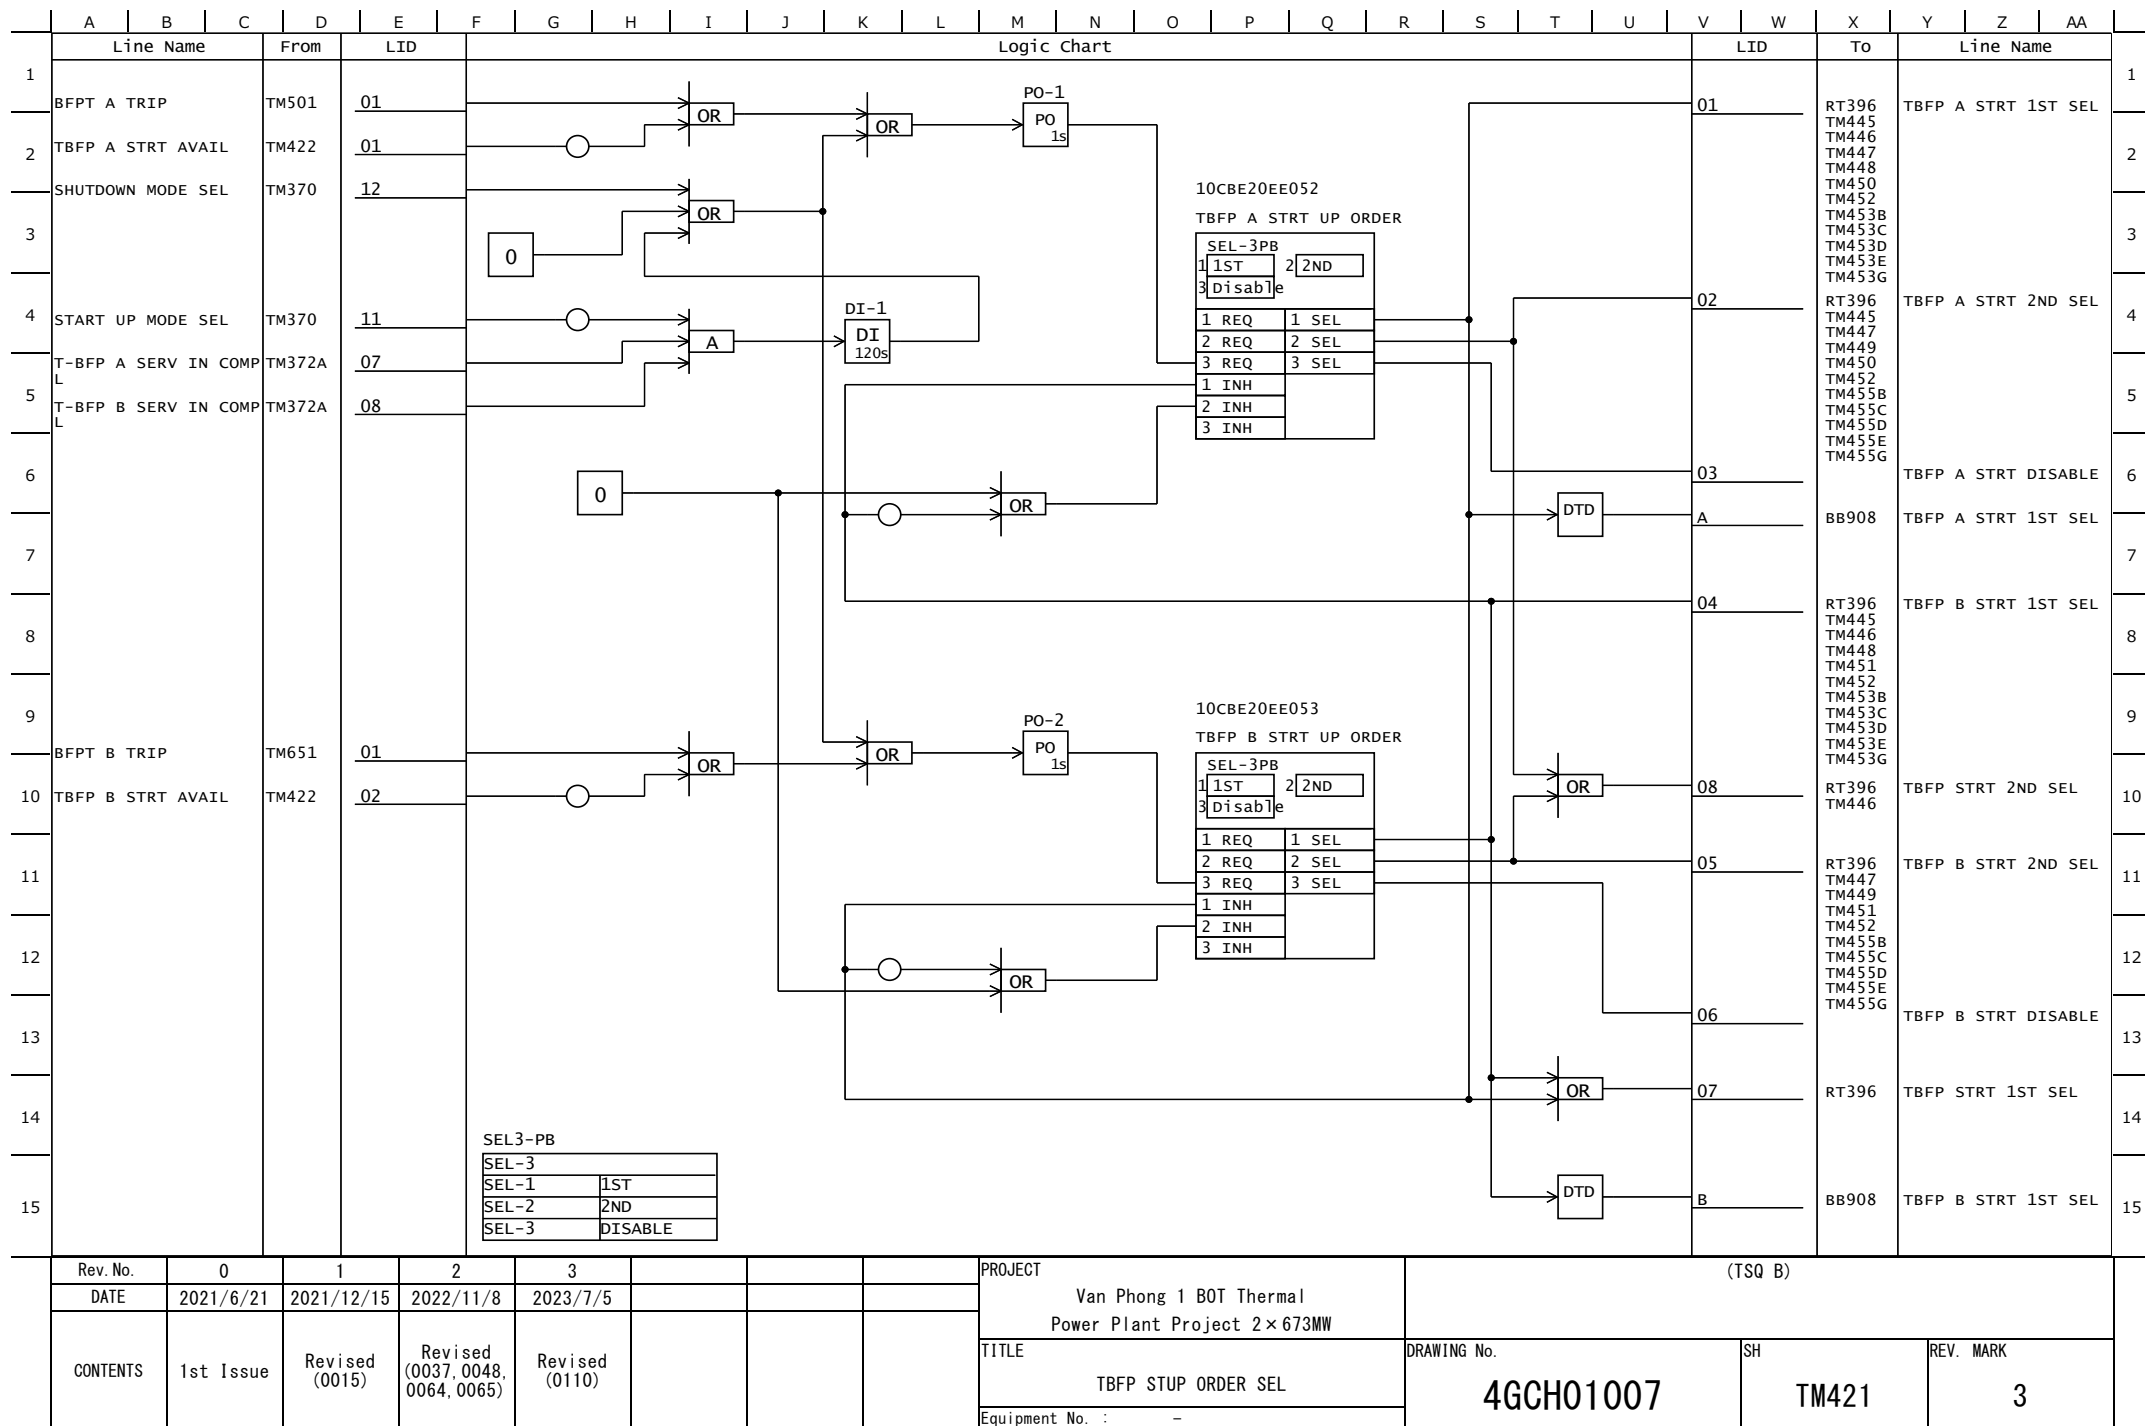

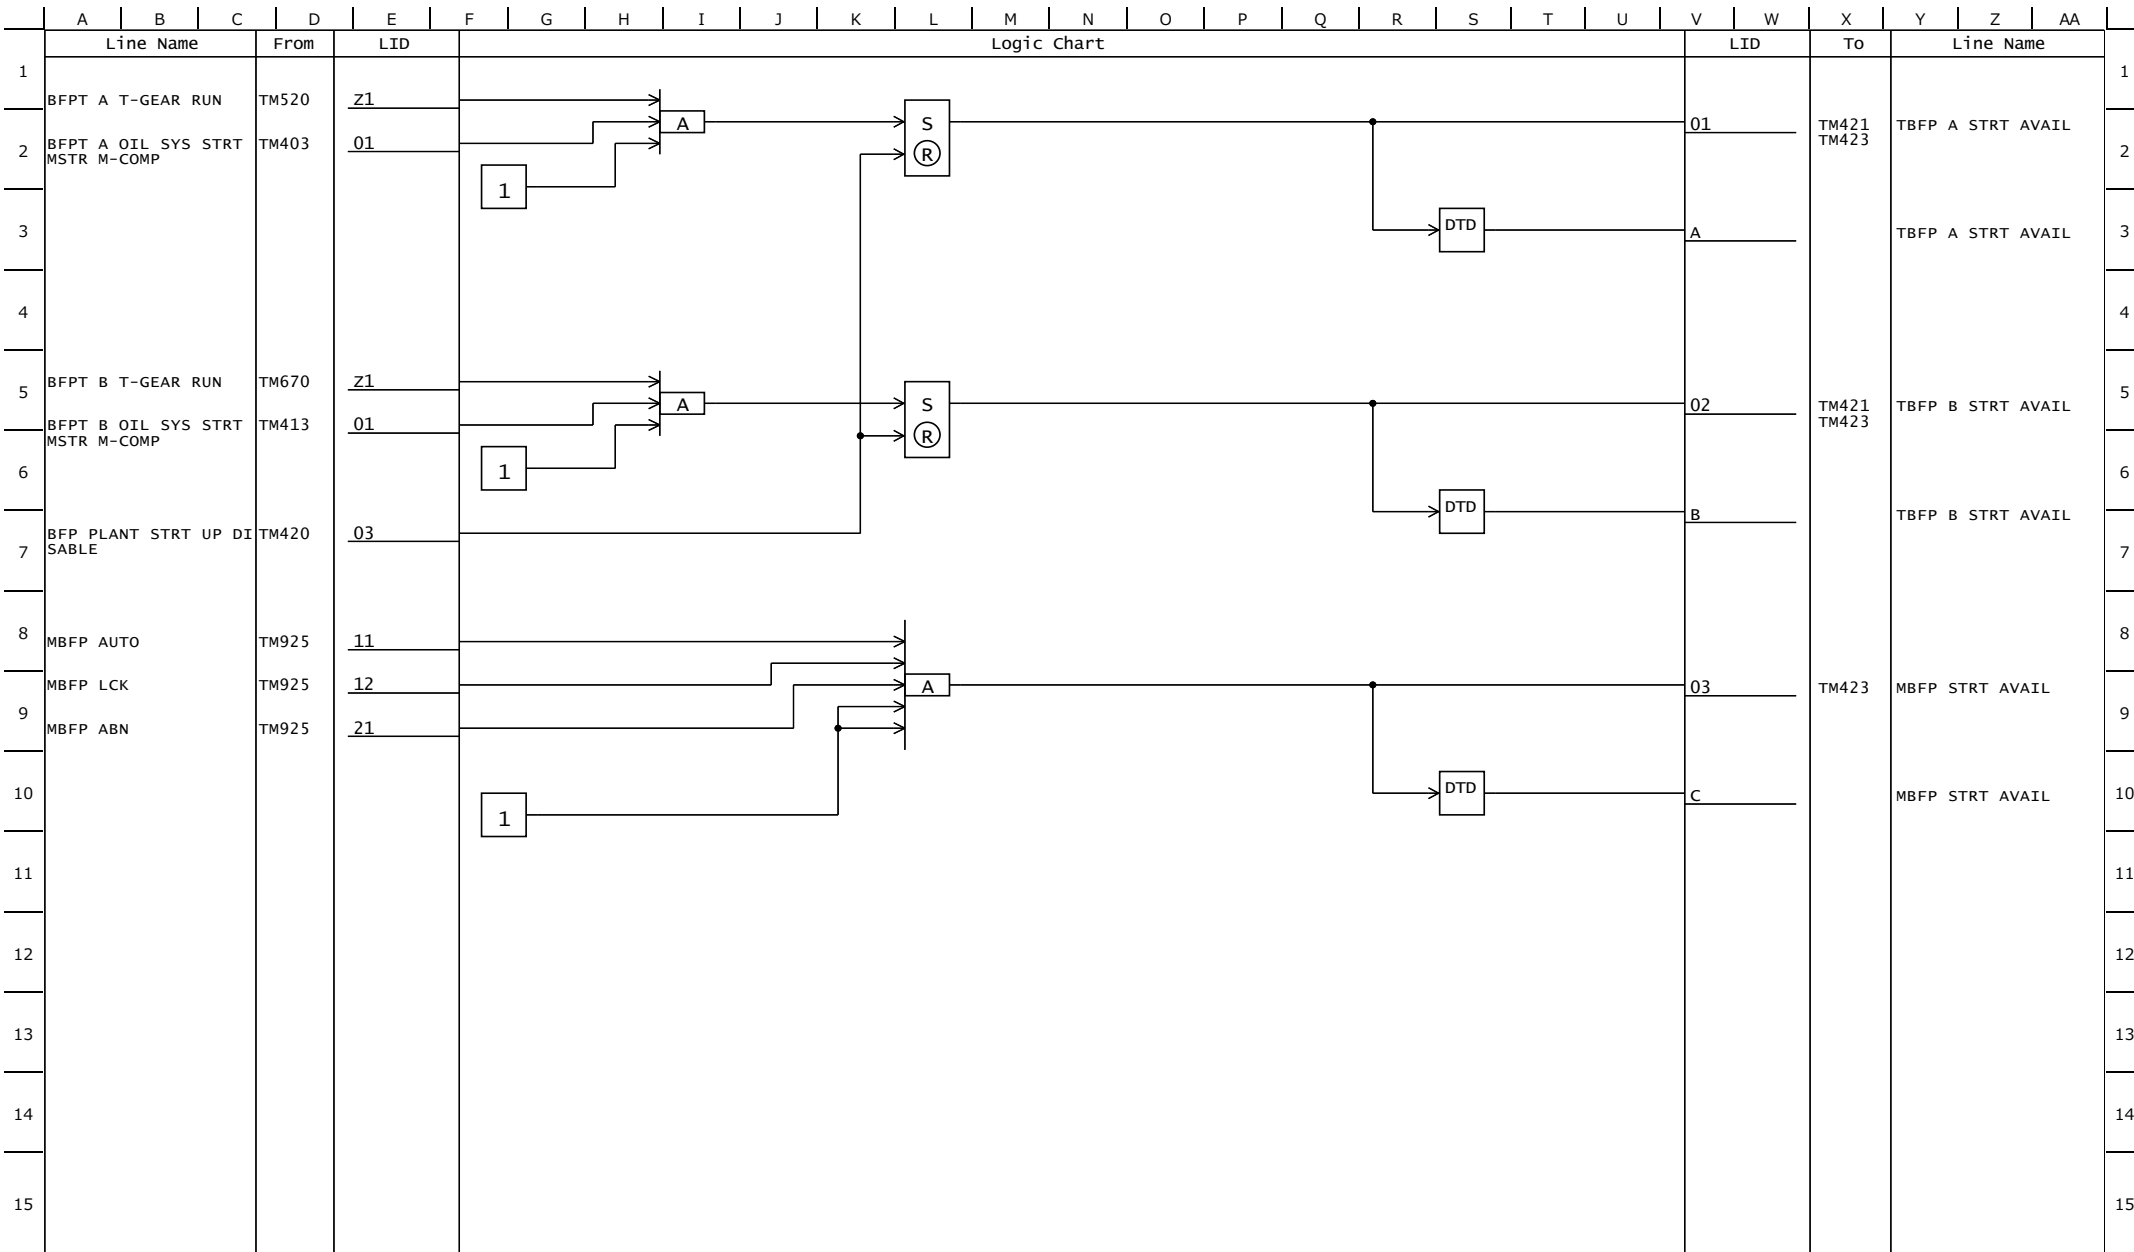


Rev. No.	0	1	3					PROJECT Van Phong 1 BOT Thermal Power Plant Project 2×673MW	(TSQ B)			
DATE	2021/6/21	2021/12/15	2023/7/5									
CONTENTS	1st Issue	Revised (0015)	Revised (0110)					TITLE	DRAWING No.	SH	REV. MARK	
								STRT AVAILABLE BFP INDICATION (1)	4GCH01007	TM422	3	
								Equipment No. : -				

	A	B	C	D	E	F	G	H	I	J	K	L	M	N	O	P	Q	R	S	T	U	V	W	X	Y	Z	AA																											
	Line Name			From	LID	Logic Chart																	LID	To	Line Name																													
1	MBFP STRT AVAIL			TM422	03	10CBE20EE055 STRT AVAIL BFP LPB-3 1 LPB-12 LPB-2 3 LPB-3 1 Lamp1 PB ON 2 Lamp2 PB ON 3 Lamp3 PB ON *INDICATION ONLY.																								1																								
2																																																						2
3																																																						3
4																																																						4
5																																																						5
6																												6																										
7																												7																										
8																												8																										
9																												9																										
10																												10																										
11																												11																										
12																												12																										
13																												13																										
14																												14																										
15																												15																										
Rev. No.		0		1										PROJECT		(TSQ B)																																						
DATE		2021/6/21		2021/12/15										Van Phong 1 BOT Thermal Power Plant Project 2×673MW																																								
CONTENTS		1st Issue		Revised (0015)										TITLE		DRAWING No.					SH		REV. MARK																															
														STRT AVAILABLE BFP INDICATION (2)		4GCH01007					TM423		1																															
														Equipment No. : -																																								

	A	B	C	D	E	F	G	H	I	J	K	L	M	N	O	P	Q	R	S	T	U	V	W	X	Y	Z	AA	
	Line Name			From	LID	Logic Chart																	LID	To	Line Name			
1																												1
2	MBFP AUTO			TM925	11																							2
	MBFP AUXOP AUTO			TM930	11																							
3	MBFP OTL VLV AUTO			TM945	11																							3
	MBFP NOISE ECLSR FAN A AUTO			TM965	11																							
4	MBFP NOISE ECLSR FAN B AUTO			TM970	11																							4
5	M-BFP HYDCPLG AUTO			TM372C	05																							5
	M-BFP O/L FCV AUTO			TM372C	06																							
6	M-BFP MIN FCV AUTO			TM385	04																							6
7																												7
8																												8
9																												9
10																												10
11																												11
12																												12
13																												13
14																												14
15																												15


	Rev. No.	0	1						PROJECT	(TSQ B)													
	DATE	2021/6/21	2021/12/15						Van Phong 1 BOT Thermal Power Plant Project 2×673MW														
	CONTENTS	1st Issue	Revised (0015)						TITLE	DRAWING No.					SH	REV. MARK							
									MBFP SERV IN MA AUX AUTO	4GCH01007					TM435	1							
	Equipment No. : -																						

	A	B	C	D	E	F	G	H	I	J	K	L	M	N	O	P	Q	R	S	T	U	V	W	X	Y	Z	AA	
	Line Name			From	LID	Logic Chart																	LID	To	Line Name			
1	MBFP ABN MBFP AUXOP ABN MBFP OTL VLV ABN MBFP NOISE ECLSR FAN A ABN MBFP NOISE ECLSR FAN B ABN M-BFP HYDCPLG ABN M-BFP O/L FCV ABN M-BFP MIN FCV ABN			TM925 TM930 TM945 TM965 TM970 TM372C TM372B MD109	21 21 21 21 21 04 03 14																		01	TM441A TM441B TM441C TM441D	MBFP SERV IN MA AUX FAIL			1
2																												2
3																												3
4																												4
5																												5
6																												6
7																												7
8																												8
9																												9
10																												10
11																												11
12																												12
13																												13
14																												14
15																												15
Rev.No.		0		1										PROJECT		(TSQ B)												
DATE		2021/6/21		2021/12/15										Van Phong 1 BOT Thermal Power Plant Project 2×673MW														
CONTENTS		1st Issue		Revised (0015)										TITLE		DRAWING No.				SH		REV. MARK						
														MBFP SERV IN MA AUX FAIL		4GCH01007				TM437		1						
														Equipment No. : -														

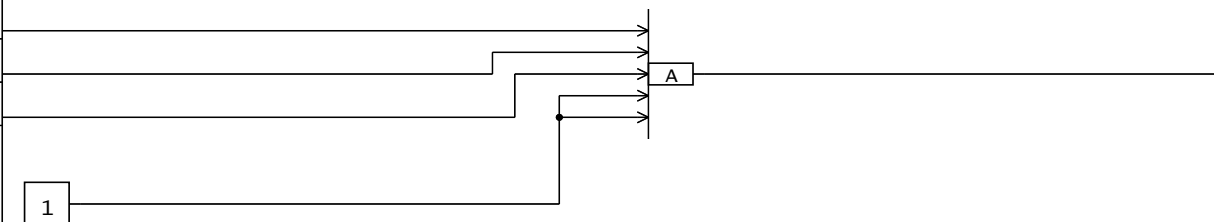	A	B	C	D	E	F	G	H	I	J	K	L	M	N	O	P	Q	R	S	T	U	V	W	X	Y	Z	AA		
	Line Name			From	LID	Logic Chart																	LID		To	Line Name			
1	MBFP MOT RUN MBFP OTL VLV OPN M-BFP SERV IN COMPL			TM320 TM945 TM372B	01																		01	RT394 TM441A TM441B TM441C TM441D	MBFP SERV IN MA M-CO MP		1		
2					Z1																					2			
3					05																					3			
4																										4			
5																										5			
6																										6			
7																										7			
8																										8			
9																										9			
10																										10			
11																										11			
12																										12			
13																										13			
14																										14			
15																										15			

Rev. No.	0	1	2					PROJECT	(TSQ B)			
DATE	2021/6/21	2021/12/15	2022/11/8					Van Phong 1 BOT Thermal Power Plant Project 2×673MW				
CONTENTS	1st Issue	Revised (0015)	Revised (0065)					TITLE	DRAWING No.	SH	REV. MARK	
								MBFP SERV IN MA COMPLETE	4GCH01007	TM438	2	
								Equipment No. : -				

	A	B	C	D	E	F	G	H	I	J	K	L	M	N	O	P	Q	R	S	T	U	V	W	X	Y	Z	AA																																																					
	Line Name			From	LID	Logic Chart																	LID	To	Line Name																																																							
1	M-BFP SERV IN CMD			TM369	01	10LAC30EB001 MBFP SERV IN MA SEQ-M PASStart OPSReset Pause ST DMDPAS PASOPS OPSStart M-COMP M-PRCD AUX AutoS-PRCD ST INHReset RelativeM-Fault AUX FAILST PRMT SP FaultABN <td>01</td> <td rowspan="21">TM441B TM441C TM441D</td> <td colspan="3">MBFP SERV IN MA PAS</td> <td>1</td>																					01	TM441B TM441C TM441D	MBFP SERV IN MA PAS			1																																																
2				TM369	02																						2																																																					
3				TM369	03																						3																																																					
4				TM438	01																						4																																																					
5				TM435	01																						5																																																					
6	1ST TBFP SERV IN MA S-PRCD			TM436	01																						OR 0																					03	TM441B TM441C TM441D	MBFP SERV IN MA M-PRCD			6																											
7				TM453	04																																											7																																
8																																																8																																
9																																																9																																
10																																																10																																
11	MBFP SERV IN MA AUX FAIL			TM437	01																																											OR 0																					05	TM441B TM441C TM441D	MBFP SERV IN MA RST			11						
12																																																																					12											
13				TM441B	08																																																																13											
14				TM441C	08																																																																14											
15				TM441D	08																																																																15											
16	MBFP SERV IN MA SP1 FLT			TM441B	08	OR 0																																																															06		RT394	MBFP SERV IN MA M-FL T			12					
17				TM441C	08																																																																13											
18				TM441D	08																																																																14											
19																																																																					15											
20																																																																					16											
Rev. No.		0	1	2	3																						PROJECT										(TSQ B)																																											
DATE		2021/6/21	2021/12/15	2022/11/8	2023/7/5																						Van Phong 1 BOT Thermal Power Plant Project 2×673MW																																																					
CONTENTS		1st Issue	Revised (0015, 0024)	Revised (0065)	Revised (0140)																						TITLE										DRAWING No.					SH		REV. MARK																																				
																											MBFP SERV IN MA (SEQ-M)										4GCH01007					TM441A		3																																				
																											Equipment No. : -																																																					

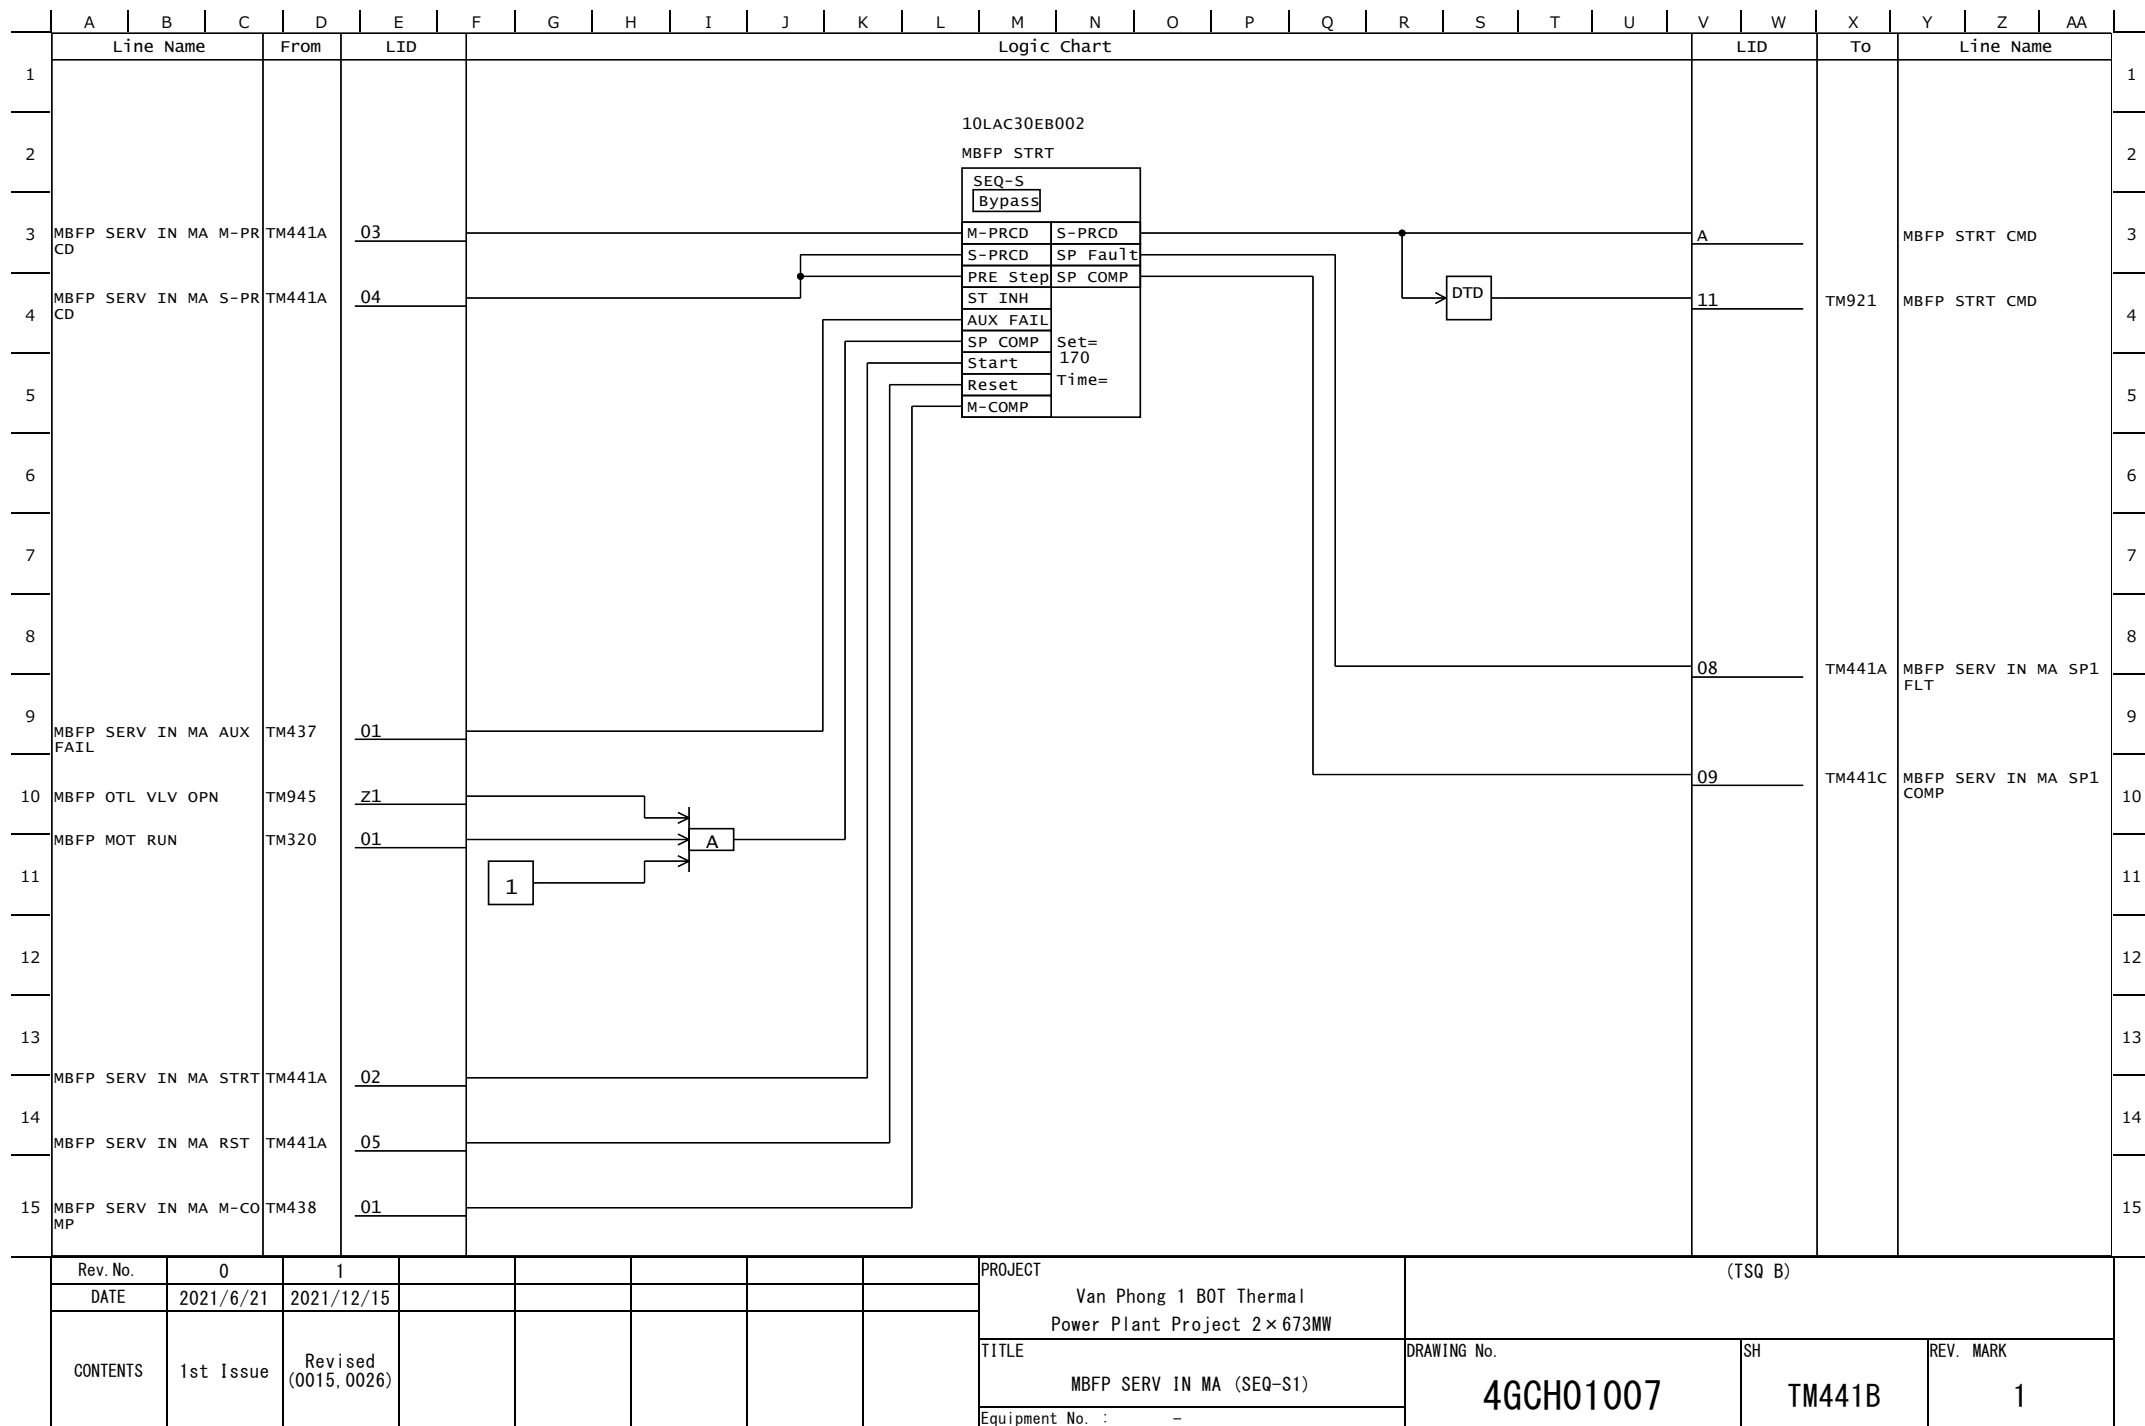

	A	B	C	D	E	F	G	H	I	J	K	L	M	N	O	P	Q	R	S	T	U	V	W	X	Y	Z	AA	
	Line Name			From	LID	Logic Chart																	LID	To	Line Name			
1																												1
2	MBFP SERV IN MA M-PRCD			TM441A	03																							2
3	MBFP SERV IN MA S-PRCD			TM441A	04																							3
4	MBFP SERV IN MA SP1 COMP			TM441B	09																							4
5	MBFP SERV IN MA AUX FAIL			TM437	01																							5
6	SHUTDOWN MODE SEL			TM370	12																							6
7	T-BFP A SERV IN COMPL			TM372A	07																							7
8	T-BFP B SERV IN COMPL			TM372A	08																							8
9	ST GEN LOAD (%MW)			TM385	21																							9
10	M-BFP SERV IN PRMT			TM372C	01																							10
11	M=>T=>T+T STRT SEL PLANT STRT UP			TM420	01																							11
12																												12
13																												13
14	MBFP SERV IN MA STRT			TM441A	02																							14
15	MBFP SERV IN MA RST			TM441A	05																							15
16	MBFP SERV IN MA M-COMP			TM438	01																							16

10LAC30EB003

MBFP SERV IN TIMING

SEQ-S

Bypass

M-PRCD

S-PRCD

S-PRCD

SP Fault

PRE Step

SP COMP

ST INH

AUX FAIL

SP COMP

Set=99999

Start

Time=

Reset

M-COMP

0-100-105%MW

L-1

/L

S= 29

R= 30

%MW

OR


A


OR


A

Rev. No.	0	1							PROJECT	Van Phong 1 BOT Thermal Power Plant Project 2×673MW			(TSQ B)			
DATE	2021/6/21	2021/12/15							TITLE	MBFP SERV IN MA (SEQ-S2)			DRAWING No.		SH	REV. MARK
CONTENTS	1st Issue	Revised (0015)							Equipment No. :	-			4GCH01007		TM441C	1

Rev. No.	0	1						PROJECT	(TSQ B)			
DATE	2021/6/21	2021/12/15						Van Phong 1 BOT Thermal Power Plant Project 2×673MW				
CONTENTS	1st Issue	Revised (0015)						TITLE	DRAWING No.	SH	REV. MARK	
								MBFP SERV IN MA (SEQ-S2)	4GCH01007	TM441C	1	
								Equipment No. : -				

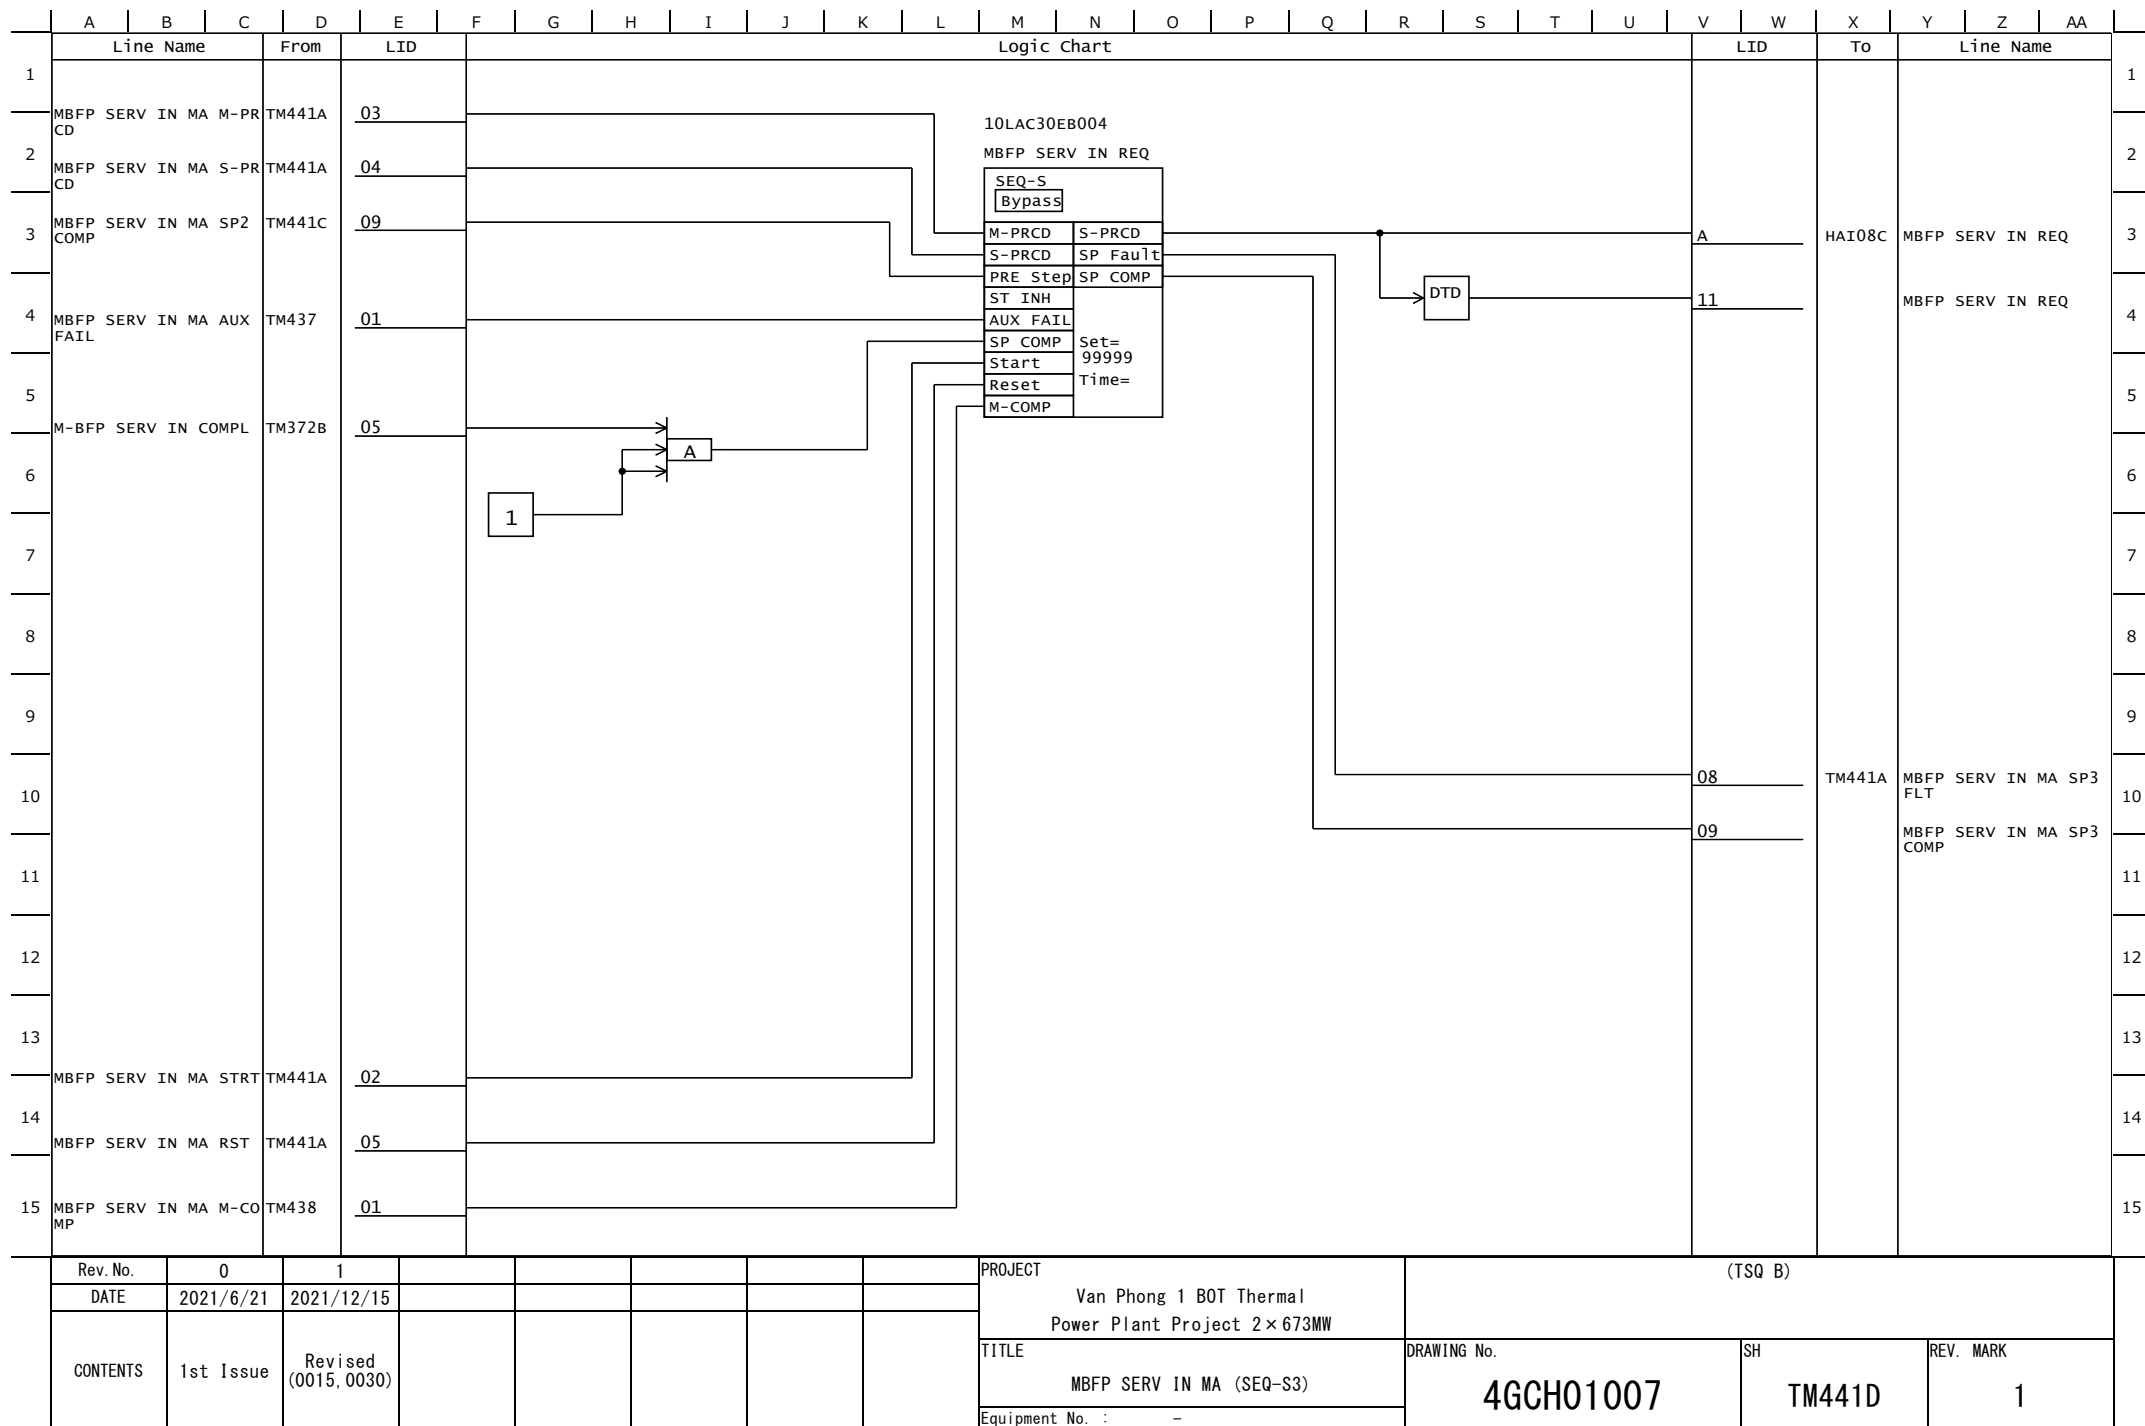

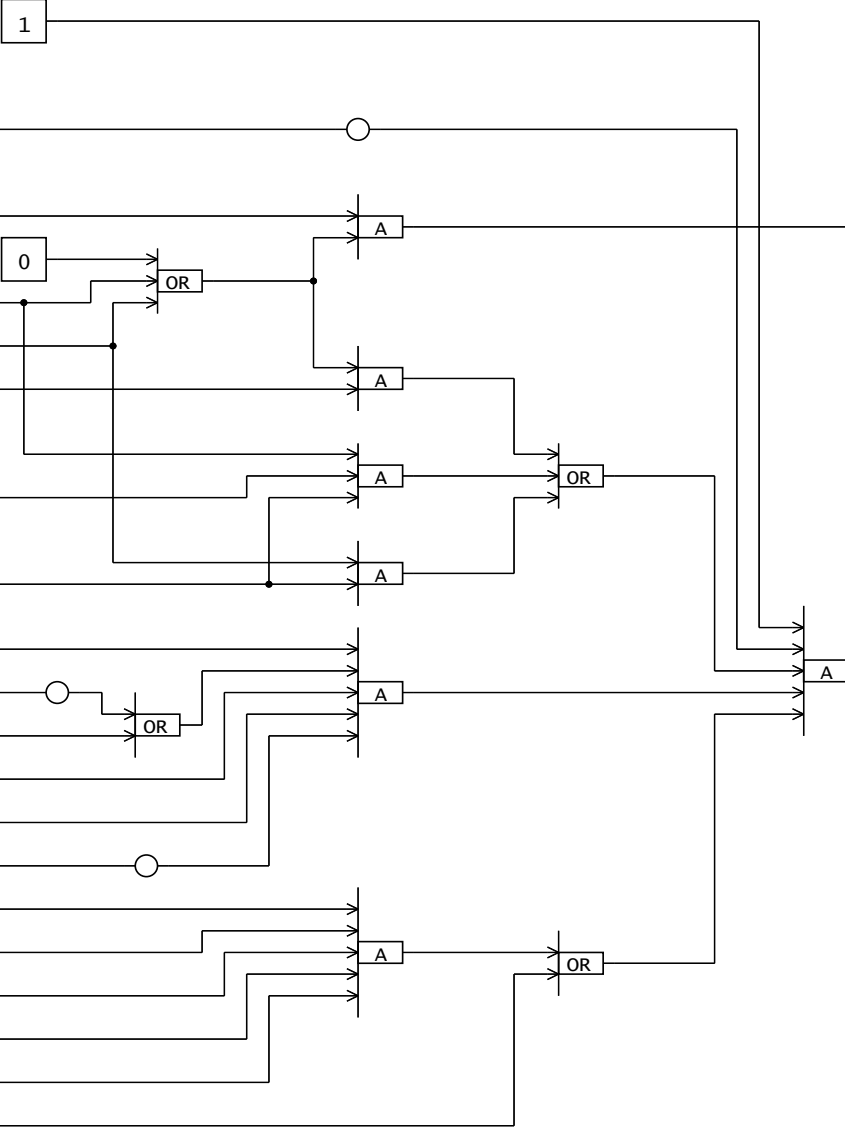	A	B	C	D	E	F	G	H	I	J	K	L	M	N	O	P	Q	R	S	T	U	V	W	X	Y	Z	AA	
	Line Name			From	LID	Logic Chart																	LID	To	Line Name			
1	BFPT A TRIP INITIATE D			TM500	01																		02	TM448	TBFP B SERV IN MA PR MT (PAS)	1		
2																										2		
3																										3		
4																										4		
5																										5		
6																										6		
7																										7		
8																										8		
9																										9		
10																										10		
11																										11		
12																										12		
13																										13		
14																										14		
15																										15		
Rev. No.			0	1	2	3							PROJECT			(TSQ B)												
DATE			2021/6/21	2021/12/15	2022/11/8	2023/7/5							Van Phong 1 BOT Thermal Power Plant Project 2×673MW															
CONTENTS			1st Issue	Revised (0015)	Revised (0048)	Revised (0164)							TITLE			DRAWING No.				SH		REV. MARK						
													TBFP SERV IN MA STRT INHIBIT (1)			4GCH01007				TM447		3						
													Equipment No. : -															

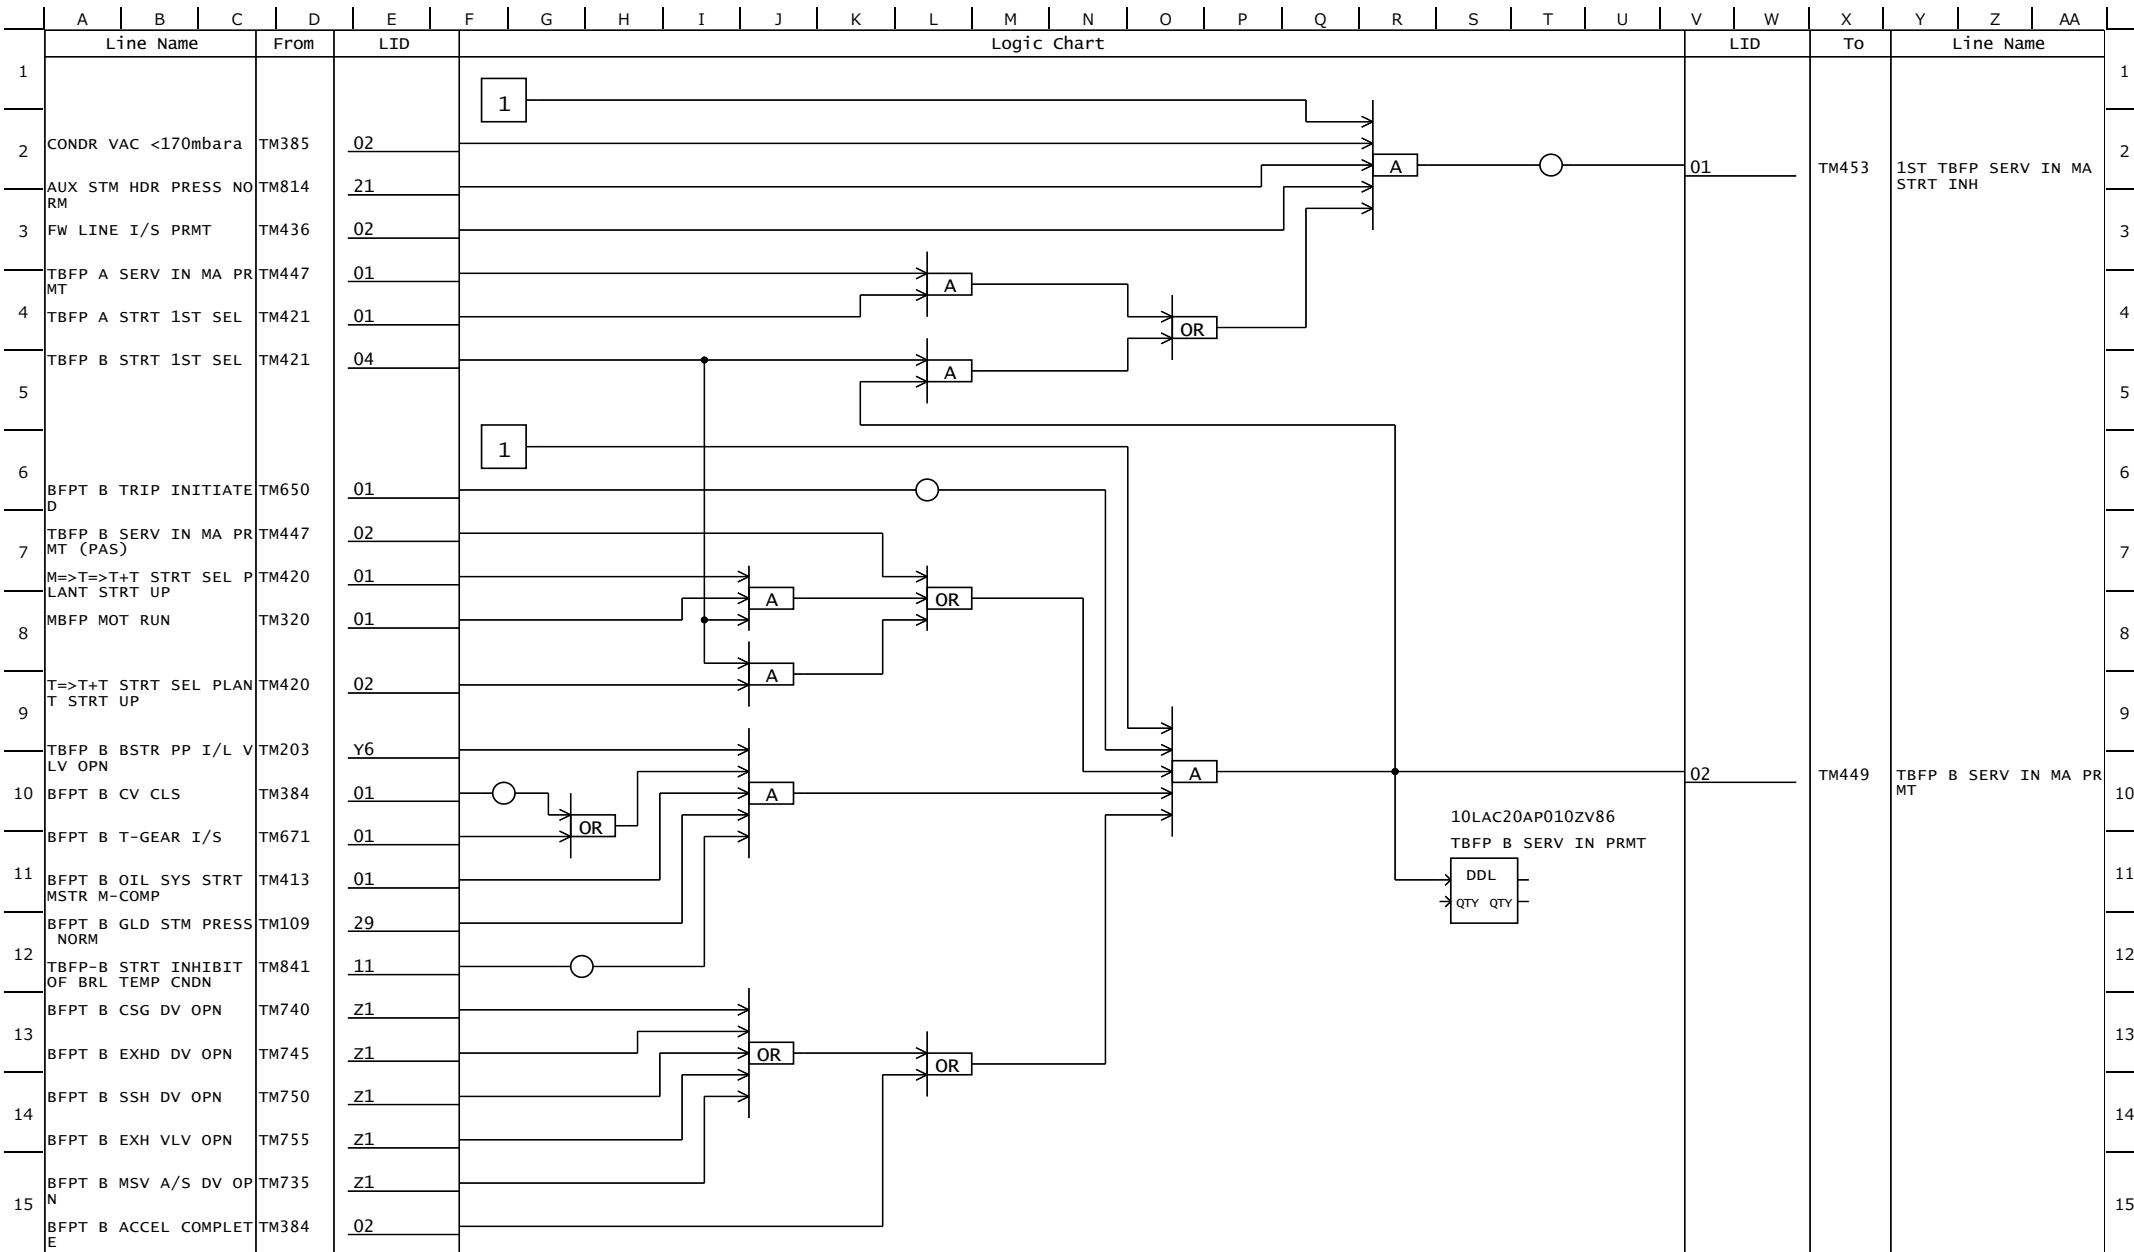

Rev. No.	0	1	2	3				PROJECT	(TSQ B)			
DATE	2021/6/21	2021/12/15	2022/11/8	2023/7/5				Van Phong 1 BOT Thermal Power Plant Project 2×673MW				
CONTENTS	1st Issue	Revised (0015)	Revised (0048)	Revised (0164)				TITLE	DRAWING No.	SH	REV. MARK	
								TBFP SERV IN MA STRT INHIBIT (2)	4GCH01007	TM448	3	
								Equipment No. : -				

	A	B	C	D	E	F	G	H	I	J	K	L	M	N	O	P	Q	R	S	T	U	V	W	X	Y	Z	AA	
	Line Name			From	LID	Logic Chart																	LID	To	Line Name			
1	TBFP A SERV IN MA PR MT TBFP A STRT 2ND SEL TBFP B SERV IN MA PR MT TBFP B STRT 2ND SEL T-BFP A SERV IN COMP L T-BFP B SERV IN COMP L 1ST TBFP SERV IN MA S-PRCD CONDV VAC <170mbara BFPT I/L STM HDR PRE SS NORM FW LINE I/S PRMT BFP STRT UP SEL PLAN T STRT UP			TM447	01	1 1 A OR 1 A A OR A 1 A OR A 1 OR A OR 1 OR A																						

	A	B	C	D	E	F	G	H	I	J	K	L	M	N	O	P	Q	R	S	T	U	V	W	X	Y	Z	AA			
	Line Name			From	LID	Logic Chart																	LID	To	Line Name					
1																											1ST TBFP A SERV IN MA AUX FAIL 2ND TBFP A SERV IN MA AUX FAIL T-BFP A ABN			1
2																														2
3																														3
4																														4
5																														5
6																														6
7																														7
8																														8
9	TBFP A STRT 1ST SEL			TM421	.01	01	TM451				9																			
10	TBFP A STRT 2ND SEL			TM421	.02			A	02	TM451	2ND TBFP A SERV IN MA AUX FAIL			10																
11														11																
12						A	BB909	T-BFP A ABN			12																			
13											13																			
14											14																			
15											15																			
Rev. No.		0	1	2					PROJECT				(TSQ B)																	
DATE		2021/6/21	2021/12/15	2022/11/8					Van Phong 1 BOT Thermal Power Plant Project 2×673MW																					
CONTENTS		1st Issue	Revised (0015, 0024)	Revised (0037, 0045, 0048)					TITLE				DRAWING No.				SH		REV. MARK											
									TBFP SERV IN MA AUX FAIL (1)				4GCH01007				TM450		2											
									Equipment No. : -																					

	A	B	C	D	E	F	G	H	I	J	K	L	M	N	O	P	Q	R	S	T	U	V	W	X	Y	Z	AA
	Line Name			From	LID	Logic Chart																	LID	To	Line Name		
1	T-BFP B NOISE ECLSR FAN ABN BFPT B MSV B/S DV ABN BFPT B MSV A/S DV ABN BFPT B CSG DV ABN T-BFP B EHC ABN T-BFP B OTL VLV ABN T-BFP B MIN FCV ABN BFPT B MSV I/L VLV ABN T-BFP HDR ISOL VLV ABN T-BFP STARTUP FCV ABN TBFP B STRT 1ST SEL TBFP B STRT 2ND SEL 1ST TBFP A SERV IN AUX FAIL 2ND TBFP A SERV IN AUX FAIL			TM865	21	0 0 OR																					

	A	B	C	D	E	F	G	H	I	J	K	L	M	N	O	P	Q	R	S	T	U	V	W	X	Y	Z	AA			
	Line Name			From	LID	Logic Chart																	LID	To	Line Name					
1	TBFP A STRT 1ST SEL			TM421	01																		01	RT394 TM453 TM453A TM453B TM453C TM453D TM453E TM453F TM453G TM455F	1ST TBFP SERV IN MA M-COMP				1	
2					2																									
3					3																									
4					4																									
5	T-BFP A SERV IN COMPL			TM372A	07																		01						5	
6					6																									
7					7																									
8					8																									
9	TBFP B STRT 1ST SEL			TM421	04																		02	RT395 TM455 TM455B TM455C TM455D TM455E TM455F TM455G	2ND TBFP SERV IN MA M-COMP				9	
10					10																									
11					11																									
12					12																									
13	T-BFP B SERV IN COMPL			TM372A	08																		02						13	
14					14																									
15					15																									
15	TBFP B STRT 2ND SEL			TM421	05																		05							
Rev. No.		0	1	2					PROJECT				(TSQ B)																	
DATE		2021/6/21	2021/12/15	2022/11/8					Van Phong 1 BOT Thermal Power Plant Project 2×673MW																					
CONTENTS		1st Issue	Revised (0015)	Revised (0065)					TITLE				DRAWING No.				SH				REV. MARK									
									TBFP SERV IN MA MA COMPLETE				4GCH01007				TM452				2									
									Equipment No. : -																					

	A	B	C	D	E	F	G	H	I	J	K	L	M	N	O	P	Q	R	S	T	U	V	W	X	Y	Z	AA			
	Line Name			From	LID	Logic Chart																	LID	To	Line Name					
1																												1		
2						10LAC11EB001 1ST TBFP SERV IN MA																			01		1ST TBFP SERV IN MA PAS			2
3	1ST TBFP SERV IN MA CMD			TM369	04																							3		
4	1ST TBFP SERV IN MA R PAS CMD			TM369	05																							4		
5	1ST TBFP SERV IN MA R OPS CMD			TM369	06																		02	TM453A TM453B TM453C TM453D TM453E TM453F TM453G	1ST TBFP SERV IN MA STRT			5		
6	1ST TBFP SERV IN MA M-COMP			TM452	01																							6		
7	1ST TBFP SERV IN MA AUX AUTO			TM446	01																							7		
8	1ST TBFP SERV IN MA STRT INH			TM448	01																		03	TM453A TM453B TM453C TM453D TM453E TM453F TM453G	1ST TBFP SERV IN MA M-PRCD			8		
9	MBFP SERV IN MA S-PRCD			TM441A	04																							9		
10						0 OR																		04	RT394 TM441A TM449 TM453A TM453B TM453C TM453D TM453E TM453F TM453G TM483A TM485A	1ST TBFP SERV IN MA S-PRCD			10	
11	1ST TBFP SERV IN MA SP2 FLT			TM451	01																							11		
12	1ST TBFP SERV IN MA SP3 FLT			TM453B	02																		05	TM453A TM453B TM453C TM453D TM453E TM453F TM453G	1ST TBFP SERV IN MA RST			12		
13	1ST TBFP SERV IN MA SP4 FLT			TM453C	02																							13		
14	1ST TBFP SERV IN MA SP5 FLT			TM453D	02																		06	RT394	1ST TBFP SERV IN MA M-FLT			14		
15	1ST TBFP SERV IN MA SP6 FLT			TM453E	02																							15		
16	1ST TBFP SERV IN MA SP7 FLT			TM453F	02																							16		
17	1ST TBFP SERV IN MA SP8 FLT			TM453G	02																		07	RT394	1ST TBFP SERV IN MA ST PRMT			17		
18	1ST TBFP SERV IN MA SP1 FLT			TM453A	02																							18		
19						0 OR																							19	

Rev. No.	0	1	2						PROJECT									(TSQ B)								
									Van Phong 1 BOT Thermal Power Plant Project 2×673MW																	
									TITLE									DRAWING No.			SH			REV. MARK		
									1ST TBFP SERV IN MA (SEQ-M)									4GCH01007			TM453			2		
CONTENTS	1st Issue	Revised (0015, 0024)	Revised (0065)							Equipment No. : -																

	A	B	C	D	E	F	G	H	I	J	K	L	M	N	O	P	Q	R	S	T	U	V	W	X	Y	Z	AA	
	Line Name			From	LID	Logic Chart																	LID	To	Line Name			
1																												1
2	1ST TBFP SERV IN MA M-PRCD			TM453	.03																							2
3	1ST TBFP SERV IN MA S-PRCD			TM453	.04																							3
4	1ST TBFP SERV IN AUX FAIL			TM451	.01																							4
5																												5
6	M=>T=>T+T STRT SEL P LANT STRT UP			TM420	.01																							6
7	BFPT AUXS PCV I/L VL V OPN			TM815	.Z1																							7
8	BFPT I/L STM HDR PRE SS NORM			TM103	.31																							8
9	T=>T+T STRT SEL PLAN T STRT UP			TM420	.02																							9
10																												10
11																												11
12																												12
13	1ST TBFP SERV IN MA STRT			TM453	.02																							13
14	1ST TBFP SERV IN MA RST			TM453	.05																							14
15	1ST TBFP SERV IN MA M-COMP			TM452	.01																							15

10LAC11EB002

BFP SPLY STM FROM AU

X STM

SEQ-S

Bypass

M-PRCD

S-PRCD

S-PRCD

SP Fault

PRE Step

SP COMP

ST INH

AUX FAIL

SP COMP

Start

Reset

M-COMP

Set=999999

Time=

DI-1

DI

120s

A

A

OR

DTD

Rev. No.

0

1

3

PROJECT

Van Phong 1 BOT Thermal

Power Plant Project 2×673MW

TITLE

1ST TBFP SERV IN MA (SEQ-S1)

Equipment No. : -

(TSQ B)

DRAWING No.

4GCH01007


SH

TM453A


REV. MARK

3


Rev. No.	0	1	3					PROJECT	(TSQ B)			
DATE	2021/6/21	2021/12/15	2023/7/5					Van Phong 1 BOT Thermal Power Plant Project 2×673MW				
CONTENTS	1st Issue	Revised (0015, 0024)	Revised (0164)					TITLE	DRAWING No.	SH	REV. MARK	
								1ST TBFP SERV IN MA (SEQ-S1)	4GCH01007	TM453A	3	
								Equipment No. : -				

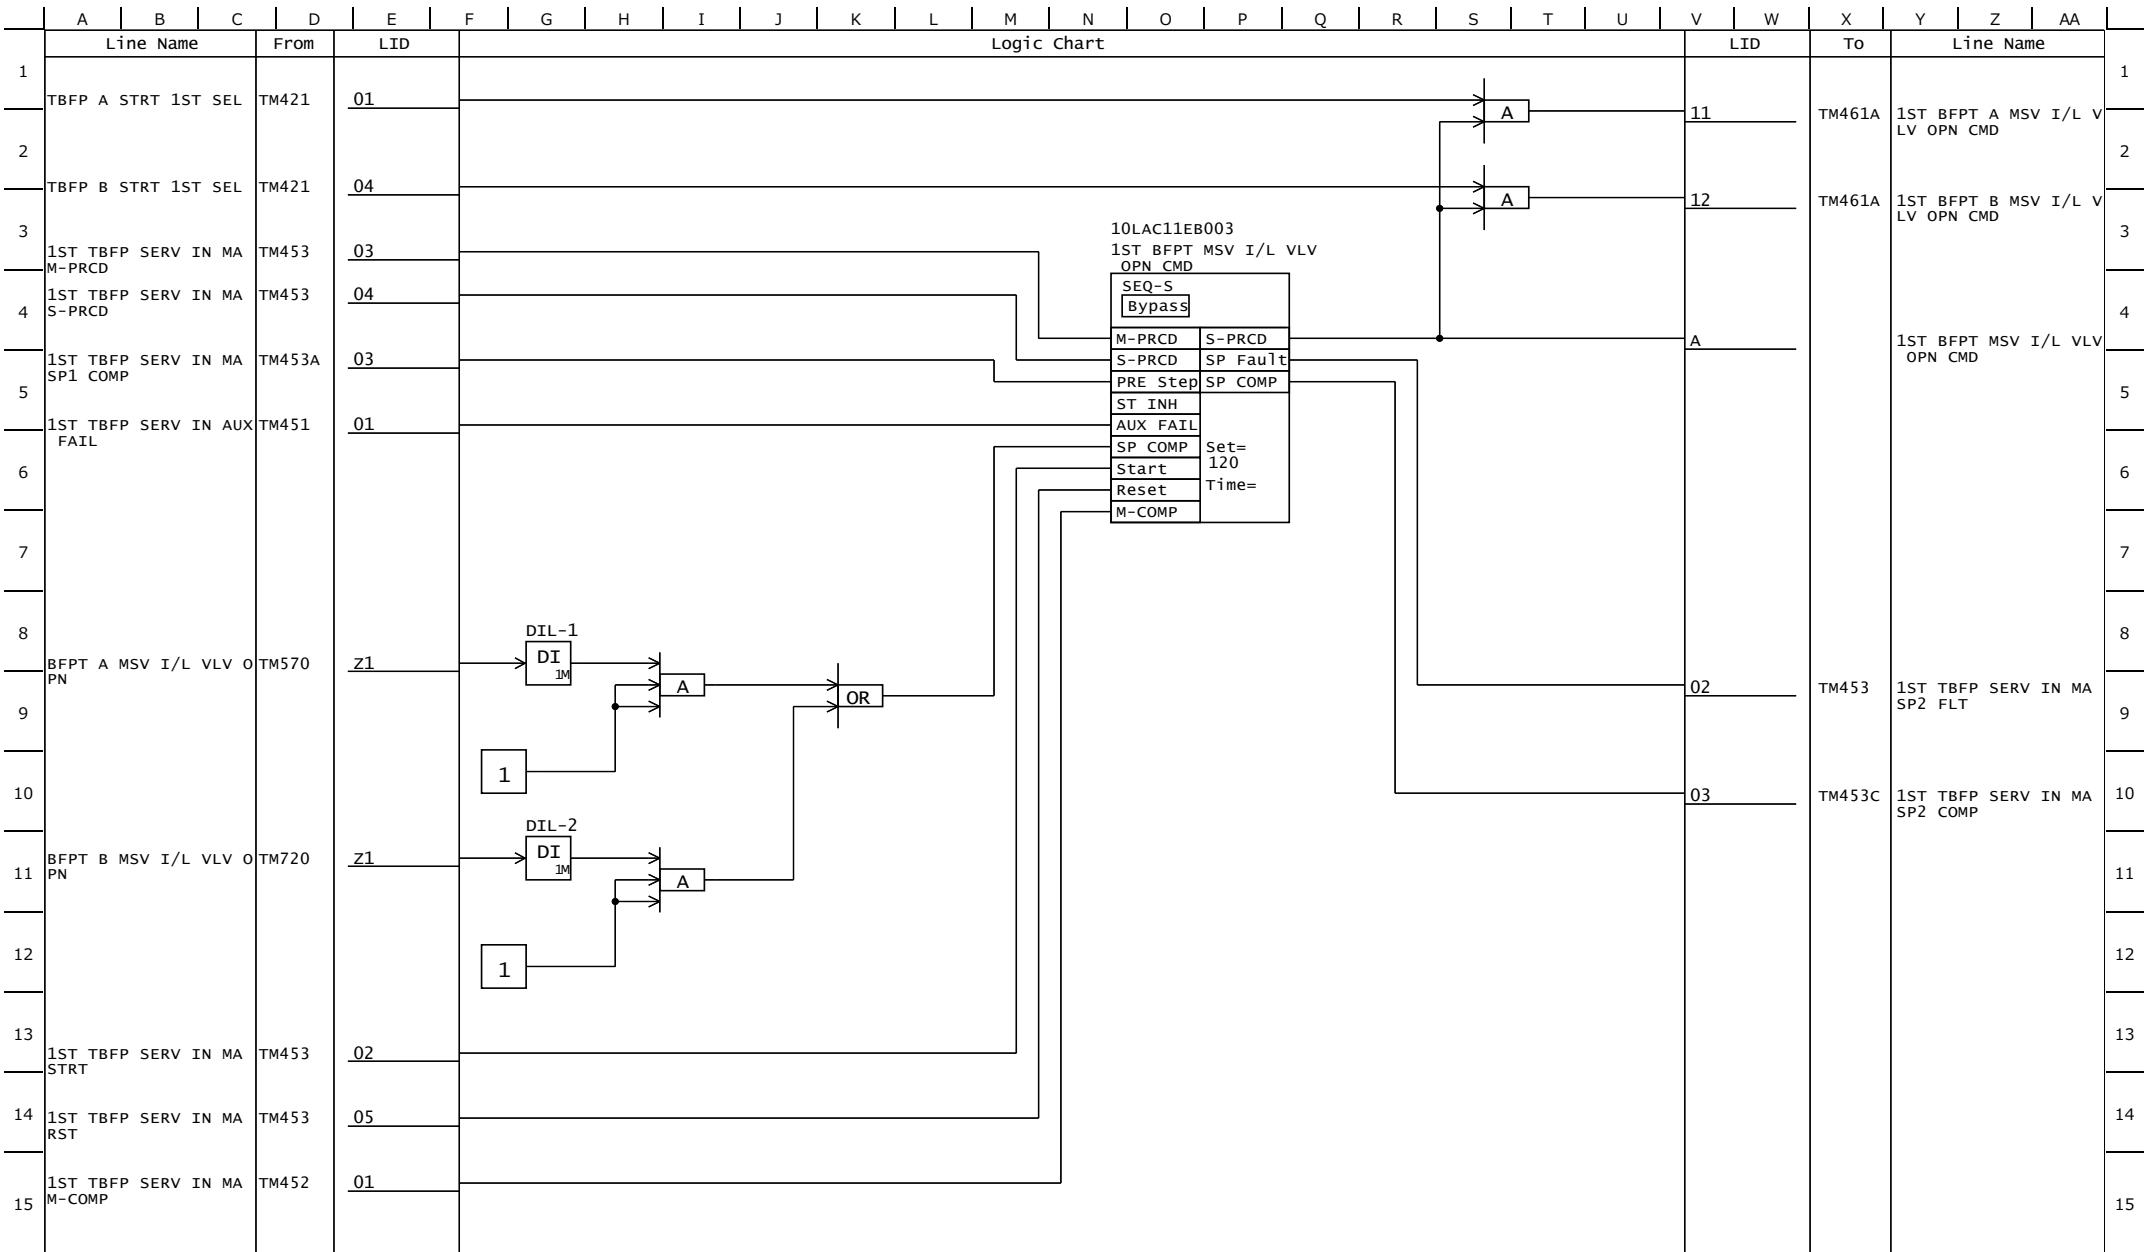


Rev. No.	0	1	2	3				PROJECT	(TSQ B)						
DATE	2021/6/21	2021/12/15	2022/11/8	2023/7/5				Van Phong 1 BOT Thermal Power Plant Project 2×673MW							
CONTENTS	1st Issue	Revised (0015, 0026)	Revised (0048)	Revised (0164)				TITLE	DRAWING No.	SH	REV. MARK				
								1ST TBFP SERV IN MA (SEQ-S2)	4GCH01007	TM453B	3				
								Equipment No. :							

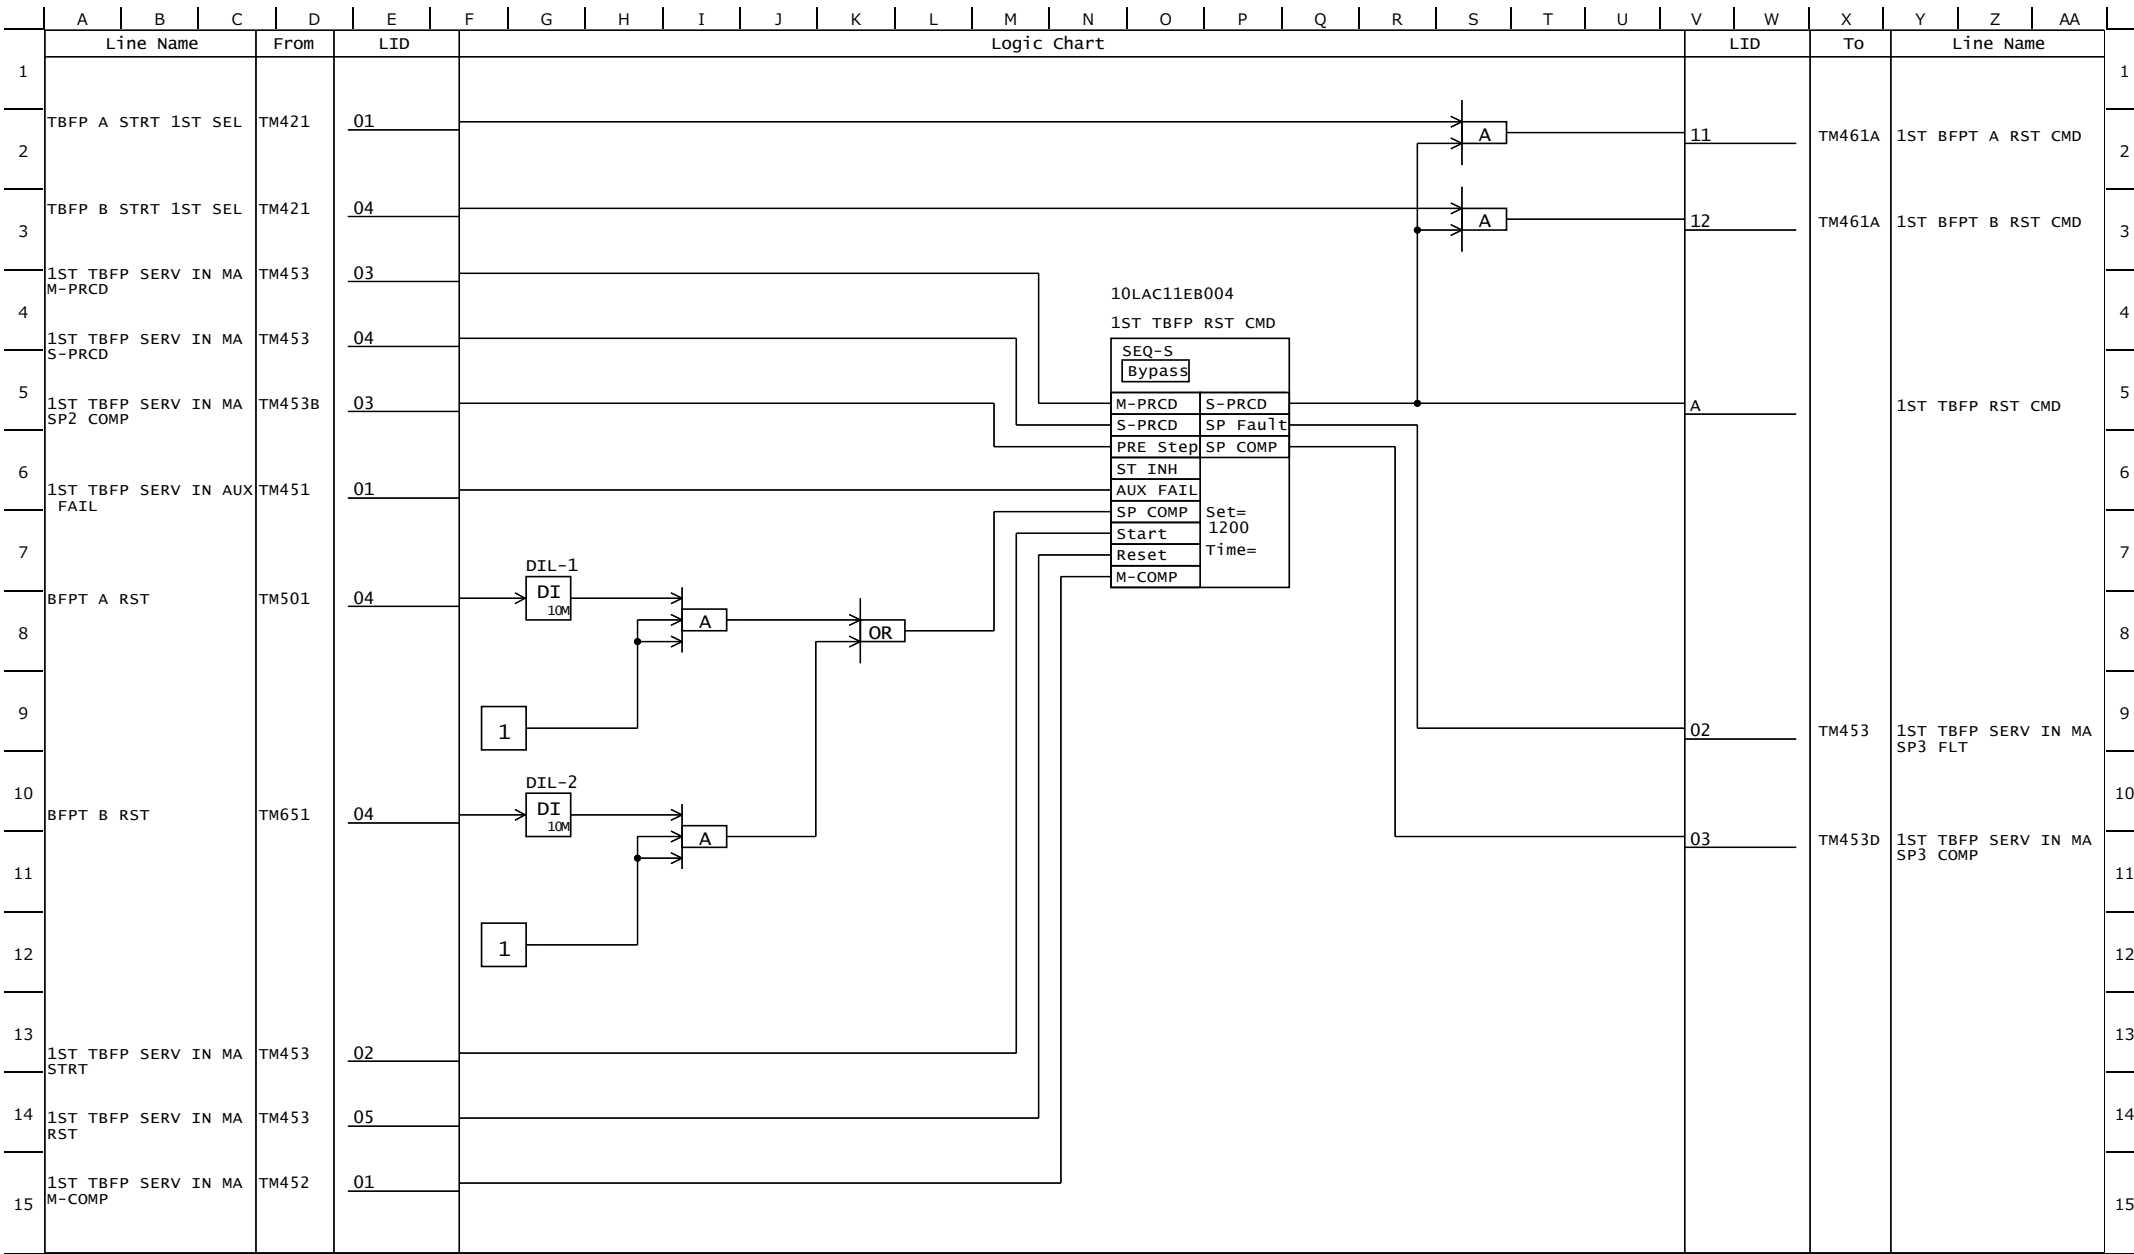


Rev. No.	0	1	2	3				PROJECT	(TSQ B)			
DATE	2021/6/21	2021/12/15	2022/11/8	2023/7/5				Van Phong 1 BOT Thermal Power Plant Project 2×673MW				
CONTENTS	1st Issue	Revised (0015, 0026)	Revised (0048)	Revised (0164)				TITLE	DRAWING No.	SH	REV. MARK	
								1ST TBFP SERV IN MA (SEQ-S3)	4GCH01007	TM453C	3	
Equipment No. : -												

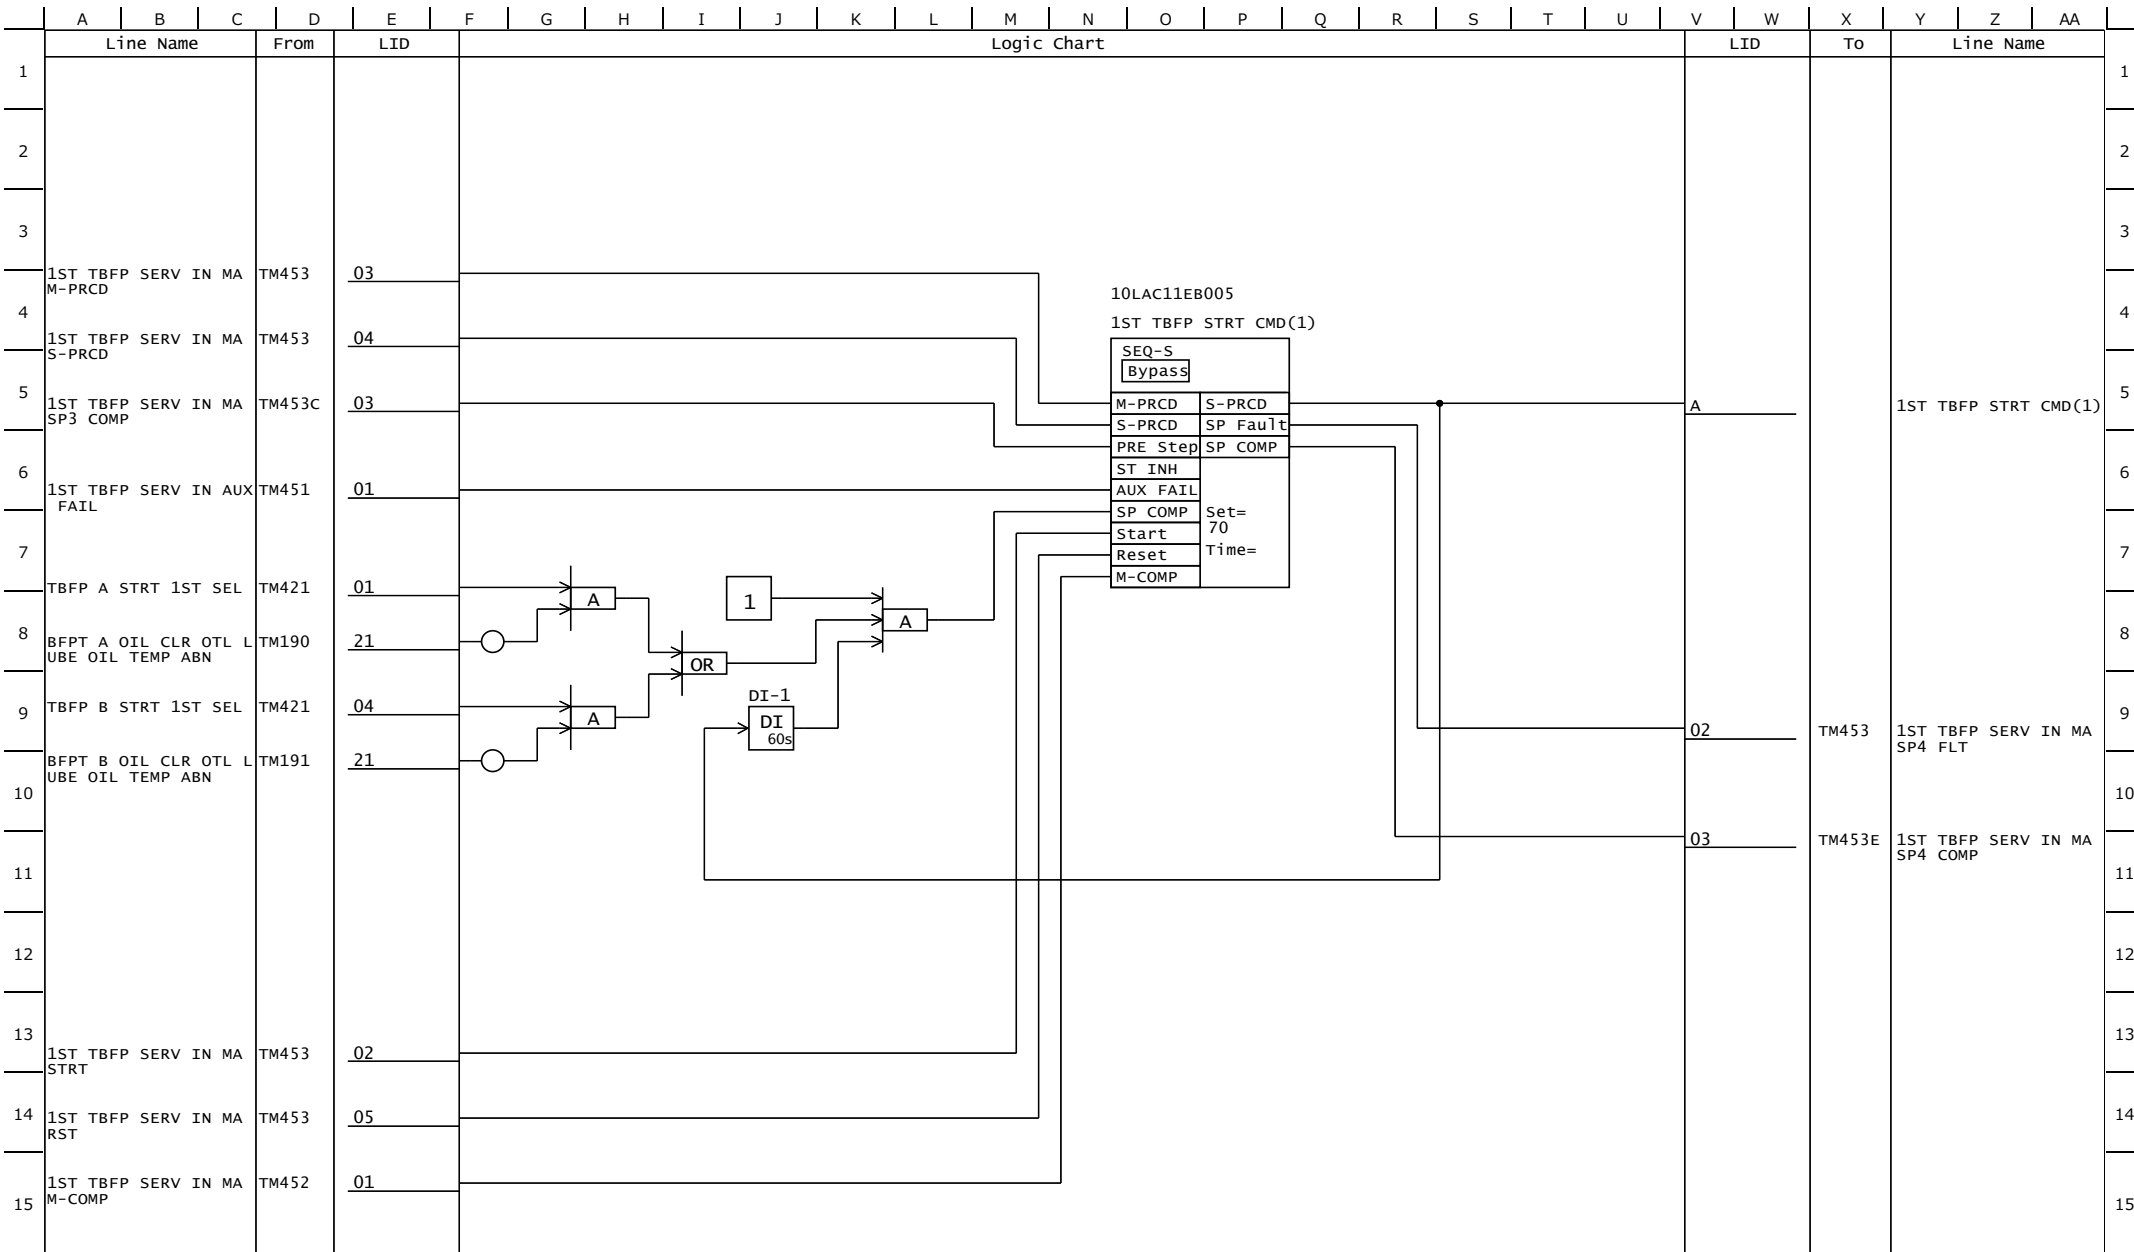

Rev. No.	0	1	3					PROJECT	(TSQ B)			
DATE	2021/6/21	2021/12/15	2023/7/5					Van Phong 1 BOT Thermal Power Plant Project 2×673MW				
CONTENTS	1st Issue	Revised (0015, 0026)	Revised (0110)					TITLE	DRAWING No.	SH	REV. MARK	
								1ST TBFP SERV IN MA (SEQ-S4)	4GCH01007	TM453D	3	
								Equipment No. : -				

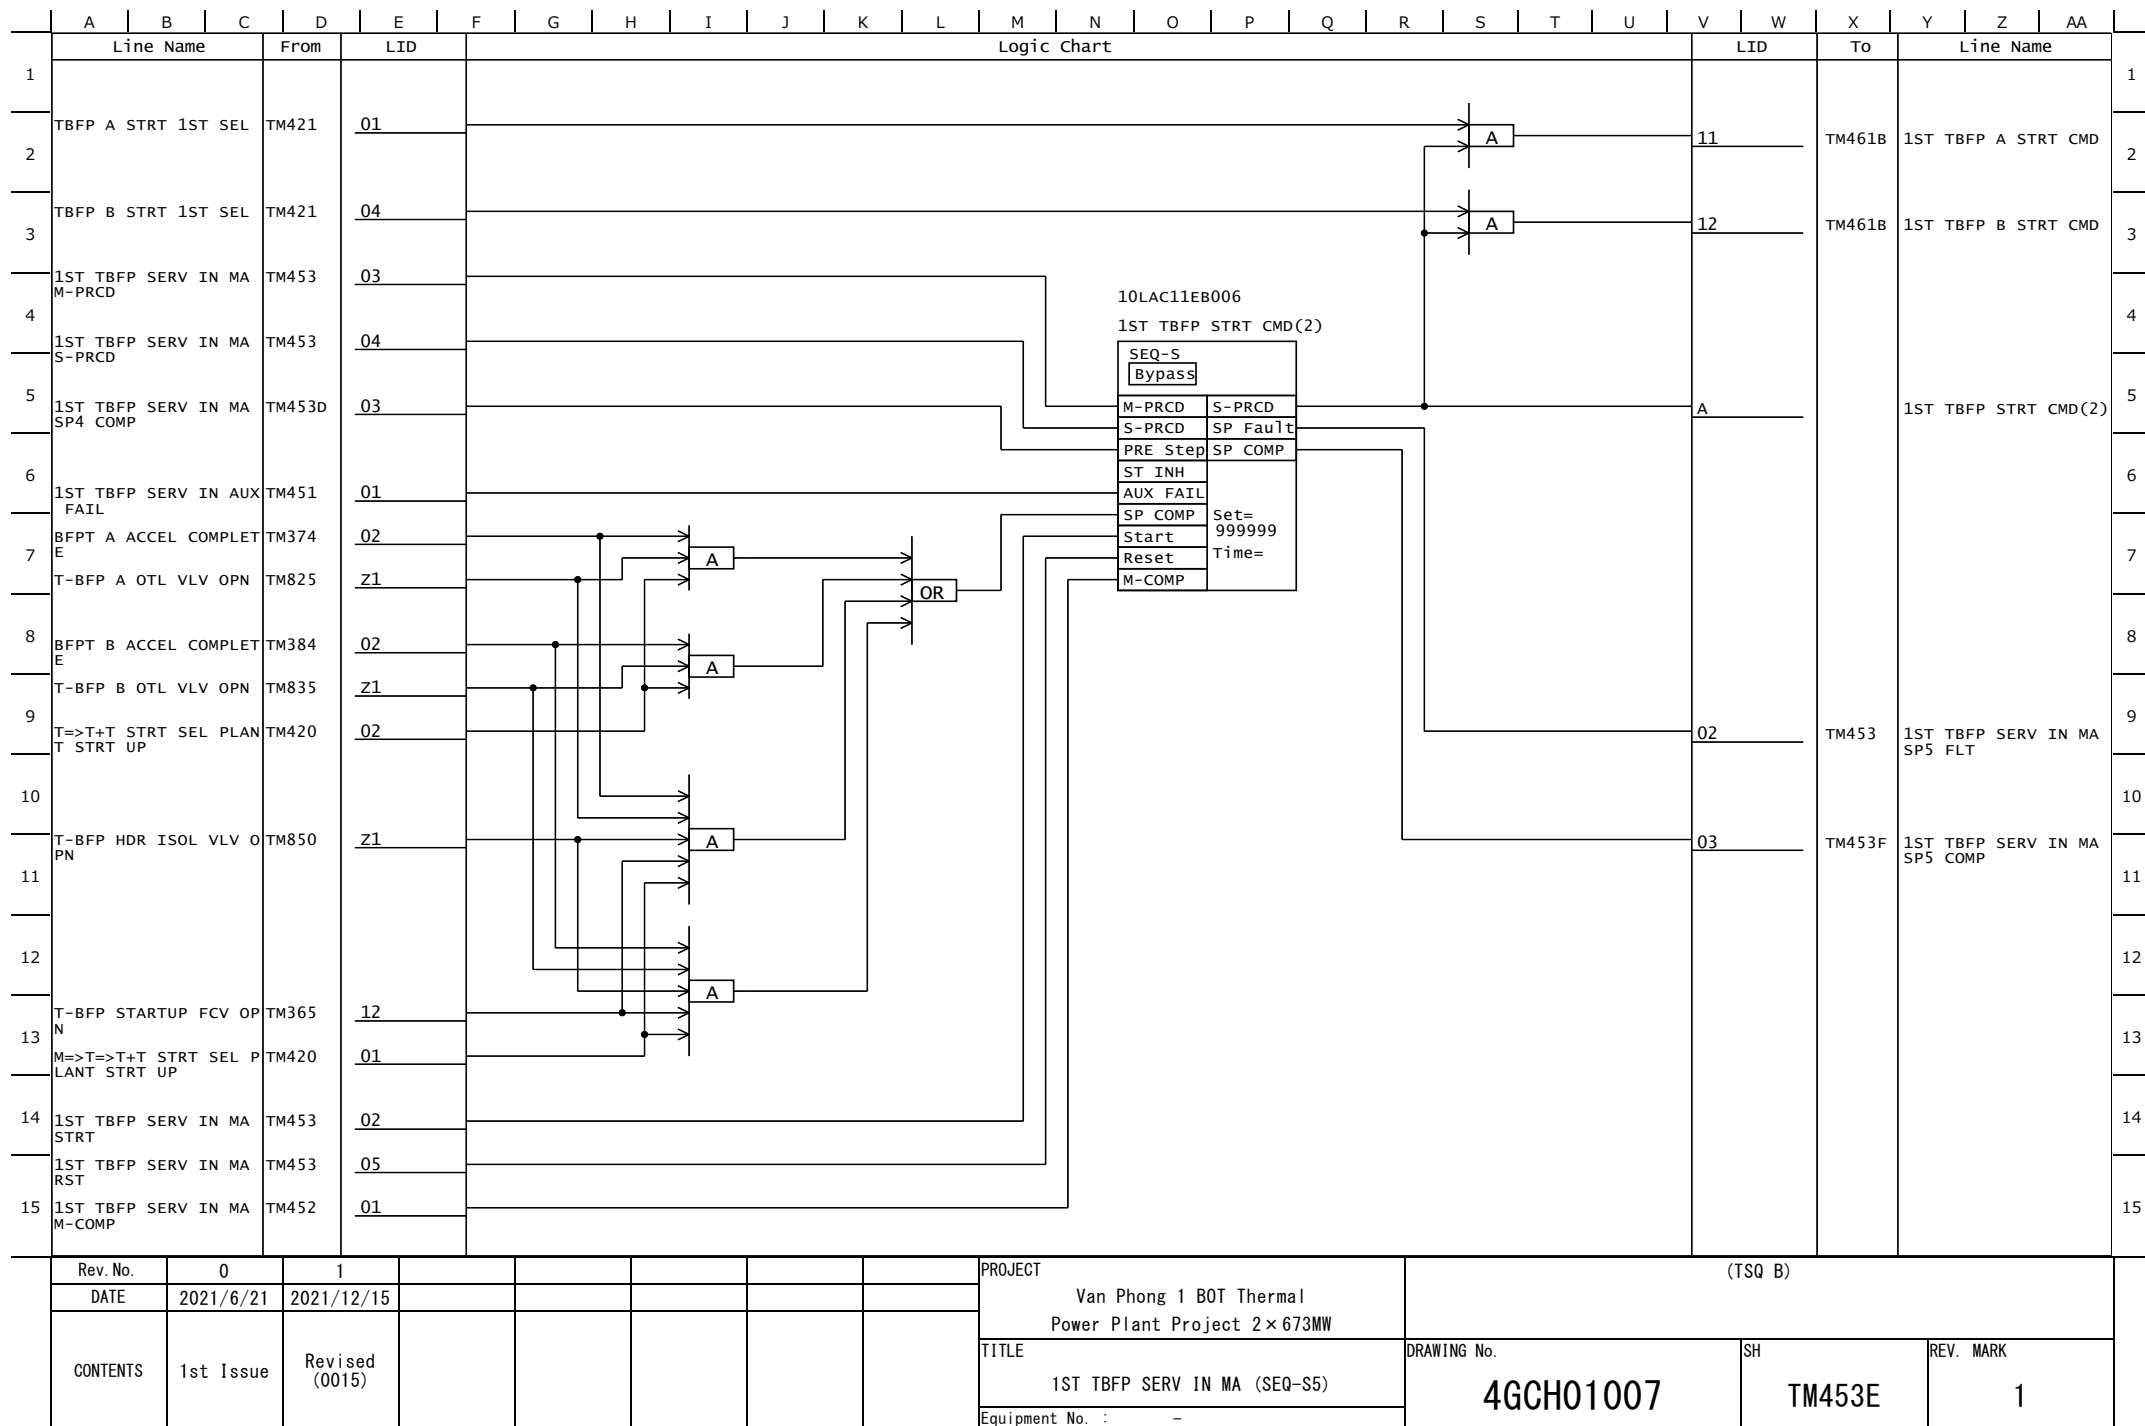


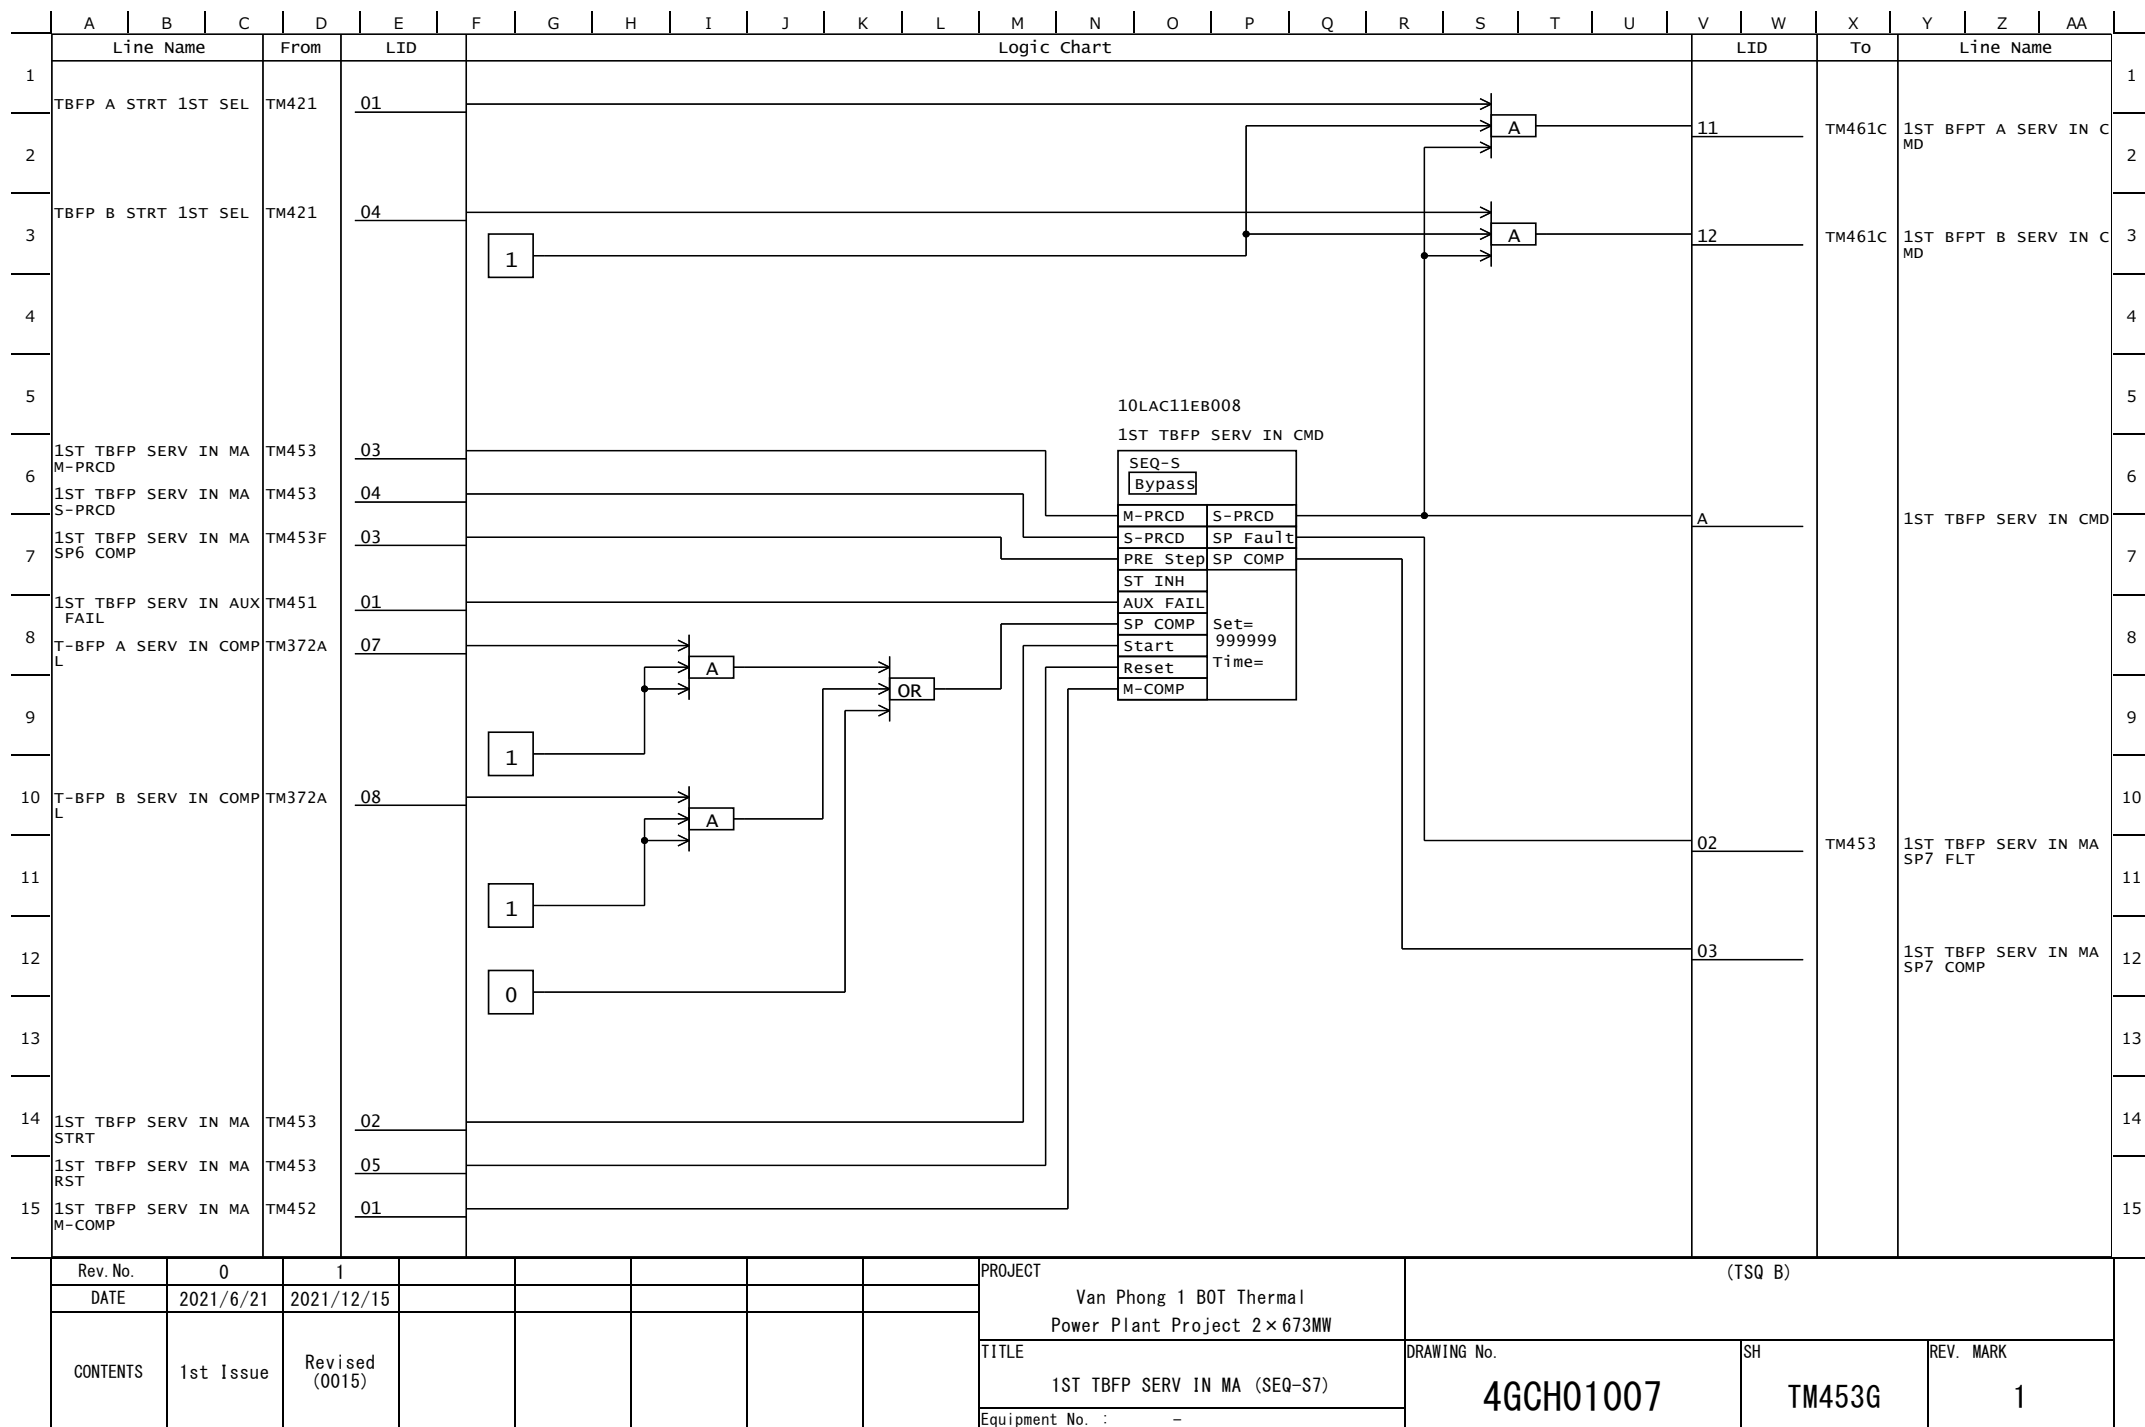


	A	B	C	D	E	F	G	H	I	J	K	L	M	N	O	P	Q	R	S	T	U	V	W	X	Y	Z	AA										
	Line Name			From	LID	Logic Chart																	LID	To	Line Name												
1	TBFP A STRT 2ND SEL			TM421	.02	10LAC12EB002 2ND BFPT MSV I/L VLV OPN CMD SEQ-S Bypass M-PRCD S-PRCD S-PRCD SP Fault PRE Step SP COMP ST INH AUX FAIL SP COMP Start Reset M-COMP Set=120 Time= DIL-1 DI 1M A A 1 DIL-2 DI 1M A 1																		TM461A	2ND BFPT A MSV I/L VLV OPN CMD	1											
2	TBFP B STRT 2ND SEL			TM421	.05																					11	TM461A	2ND BFPT B MSV I/L VLV OPN CMD	2								
3																										12			3								
4	2ND TBFP SERV IN MA M-PRCD			TM455	.03																								A	2ND BFPT MSV I/L VLV OPN CMD	4						
5	2ND TBFP SERV IN MA S-PRCD			TM455	.04																										5						
6																															6						
7	2ND TBFP SERV IN AUX FAIL			TM451	.02																											7					
8	BFPT A MSV I/L VLV O PN			TM570	.Z1																										02	TM455	2ND TBFP SERV IN MA SP1 FLT	8			
9																															03			TM455C	2ND TBFP SERV IN MA SP1 COMP	9	
10	BFPT B MSV I/L VLV O PN			TM720	.Z1																															10	
11																																				11	
12																																				12	
13																																				13	
14	2ND TBFP SERV IN MA STRT			TM455	.02																																14
	2ND TBFP SERV IN MA RST			TM455	.05																																
15	2ND TBFP SERV IN MA M-COMP			TM452	.02						15																										
Rev. No.					0	1	3					PROJECT					(TSQ B)																				
DATE					2021/6/21	2021/12/15	2023/7/5					Van Phong 1 BOT Thermal Power Plant Project 2×673MW																									
CONTENTS					1st Issue	Revised (0015, 0026)	Revised (0164)					TITLE					DRAWING No.					SH			REV. MARK												
												2ND TBFP SERV IN MA (SEQ-S1)					4GCH01007					TM455B			3												
												Equipment No. : -																									

	A	B	C	D	E	F	G	H	I	J	K	L	M	N	O	P	Q	R	S	T	U	V	W	X	Y	Z	AA					
	Line Name			From	LID	Logic Chart																	LID	To	Line Name							
1	TBFP A STRT 2ND SEL			TM421	.02	10LAC12EB003 2ND BFPT RST CMD SEQ-S Bypass M-PRCD S-PRCD S-PRCD SP Fault PRE Step SP COMP ST INH AUX FAIL SP COMP Start Reset M-COMP Set=1200 Time=																					11	TM461A	2ND BFPT A RST CMD			1
2	TBFP B STRT 2ND SEL			TM421	.05	12	TM461A	2ND BFPT B RST CMD			2																					
3											3																					
4	2ND TBFP SERV IN MA M-PRCD			TM455	.03						4																					
5	2ND TBFP SERV IN MA S-PRCD			TM455	.04						5																					
6	2ND TBFP SERV IN MA SP1 COMP			TM455B	.03	A		2ND BFPT RST CMD			6																					
7	2ND TBFP SERV IN AUX FAIL			TM451	.02						7																					
8	BFPT A RST			TM501	.04	02	TM455	2ND TBFP SERV IN MA SP2 FLT			8																					
9						03	TM455D	2ND TBFP SERV IN MA SP2 COMP			9																					
10	BFPT B RST			TM651	.04						10																					
11											11																					
12											12																					
13											13																					
14	2ND TBFP SERV IN MA STRT			TM455	.02						14																					
15	2ND TBFP SERV IN MA RST			TM455	.05						15																					
	2ND TBFP SERV IN MA M-COMP			TM452	.02																											


Rev. No.	0	1	3					PROJECT	(TSQ B)			
DATE	2021/6/21	2021/12/15	2023/7/5					Van Phong 1 BOT Thermal Power Plant Project 2×673MW				
CONTENTS	1st Issue	Revised (0015, 0026)	Revised (0164)					TITLE	DRAWING No.	SH	REV. MARK	
								2ND TBFP SERV IN MA (SEQ-S2)	4GCH01007	TM455C	3	
								Equipment No. : -				

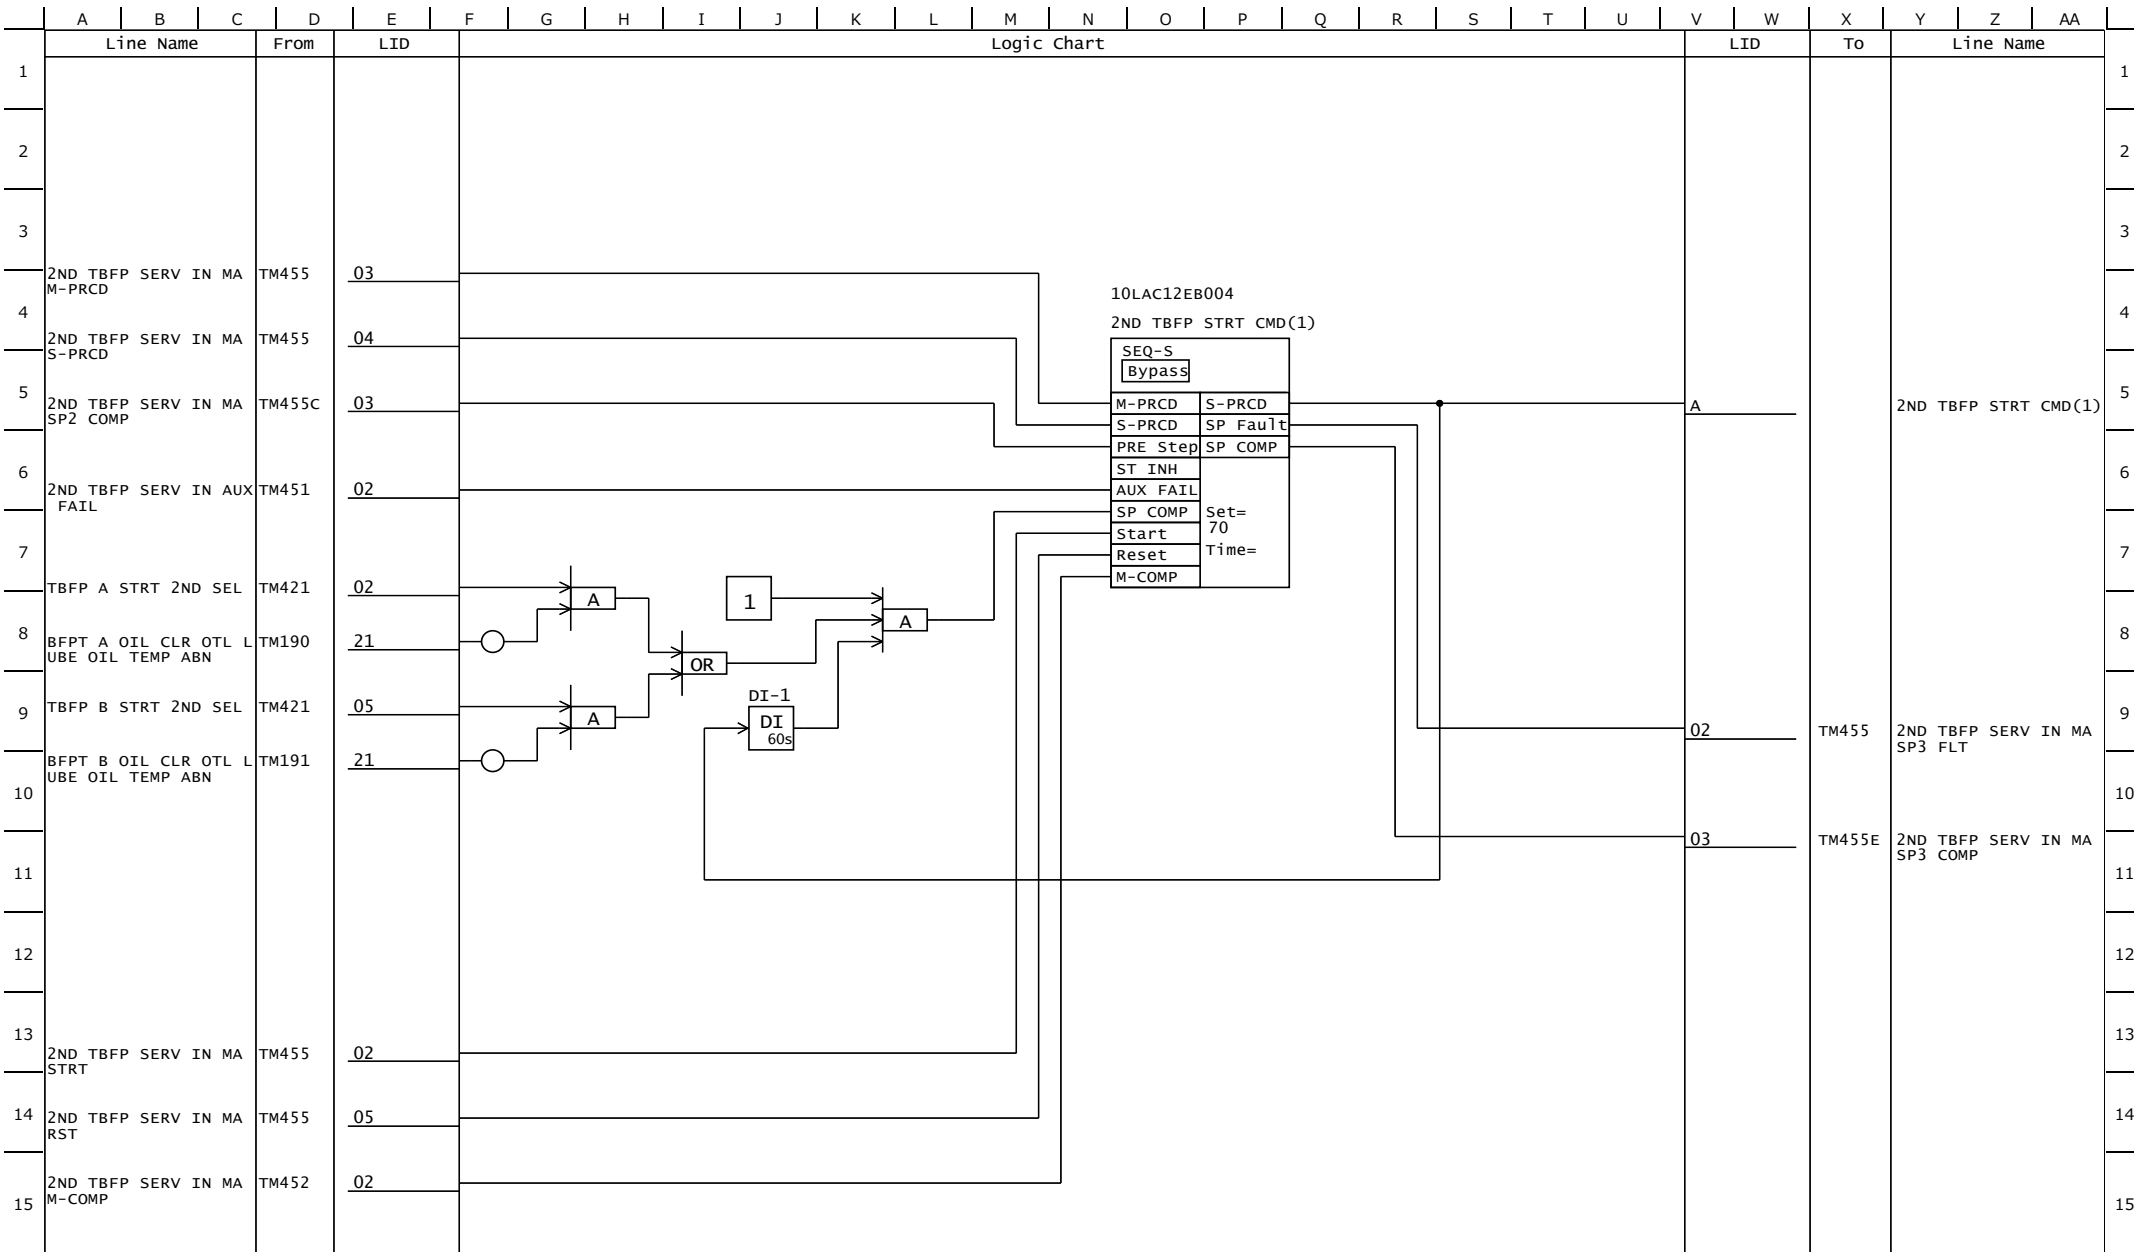

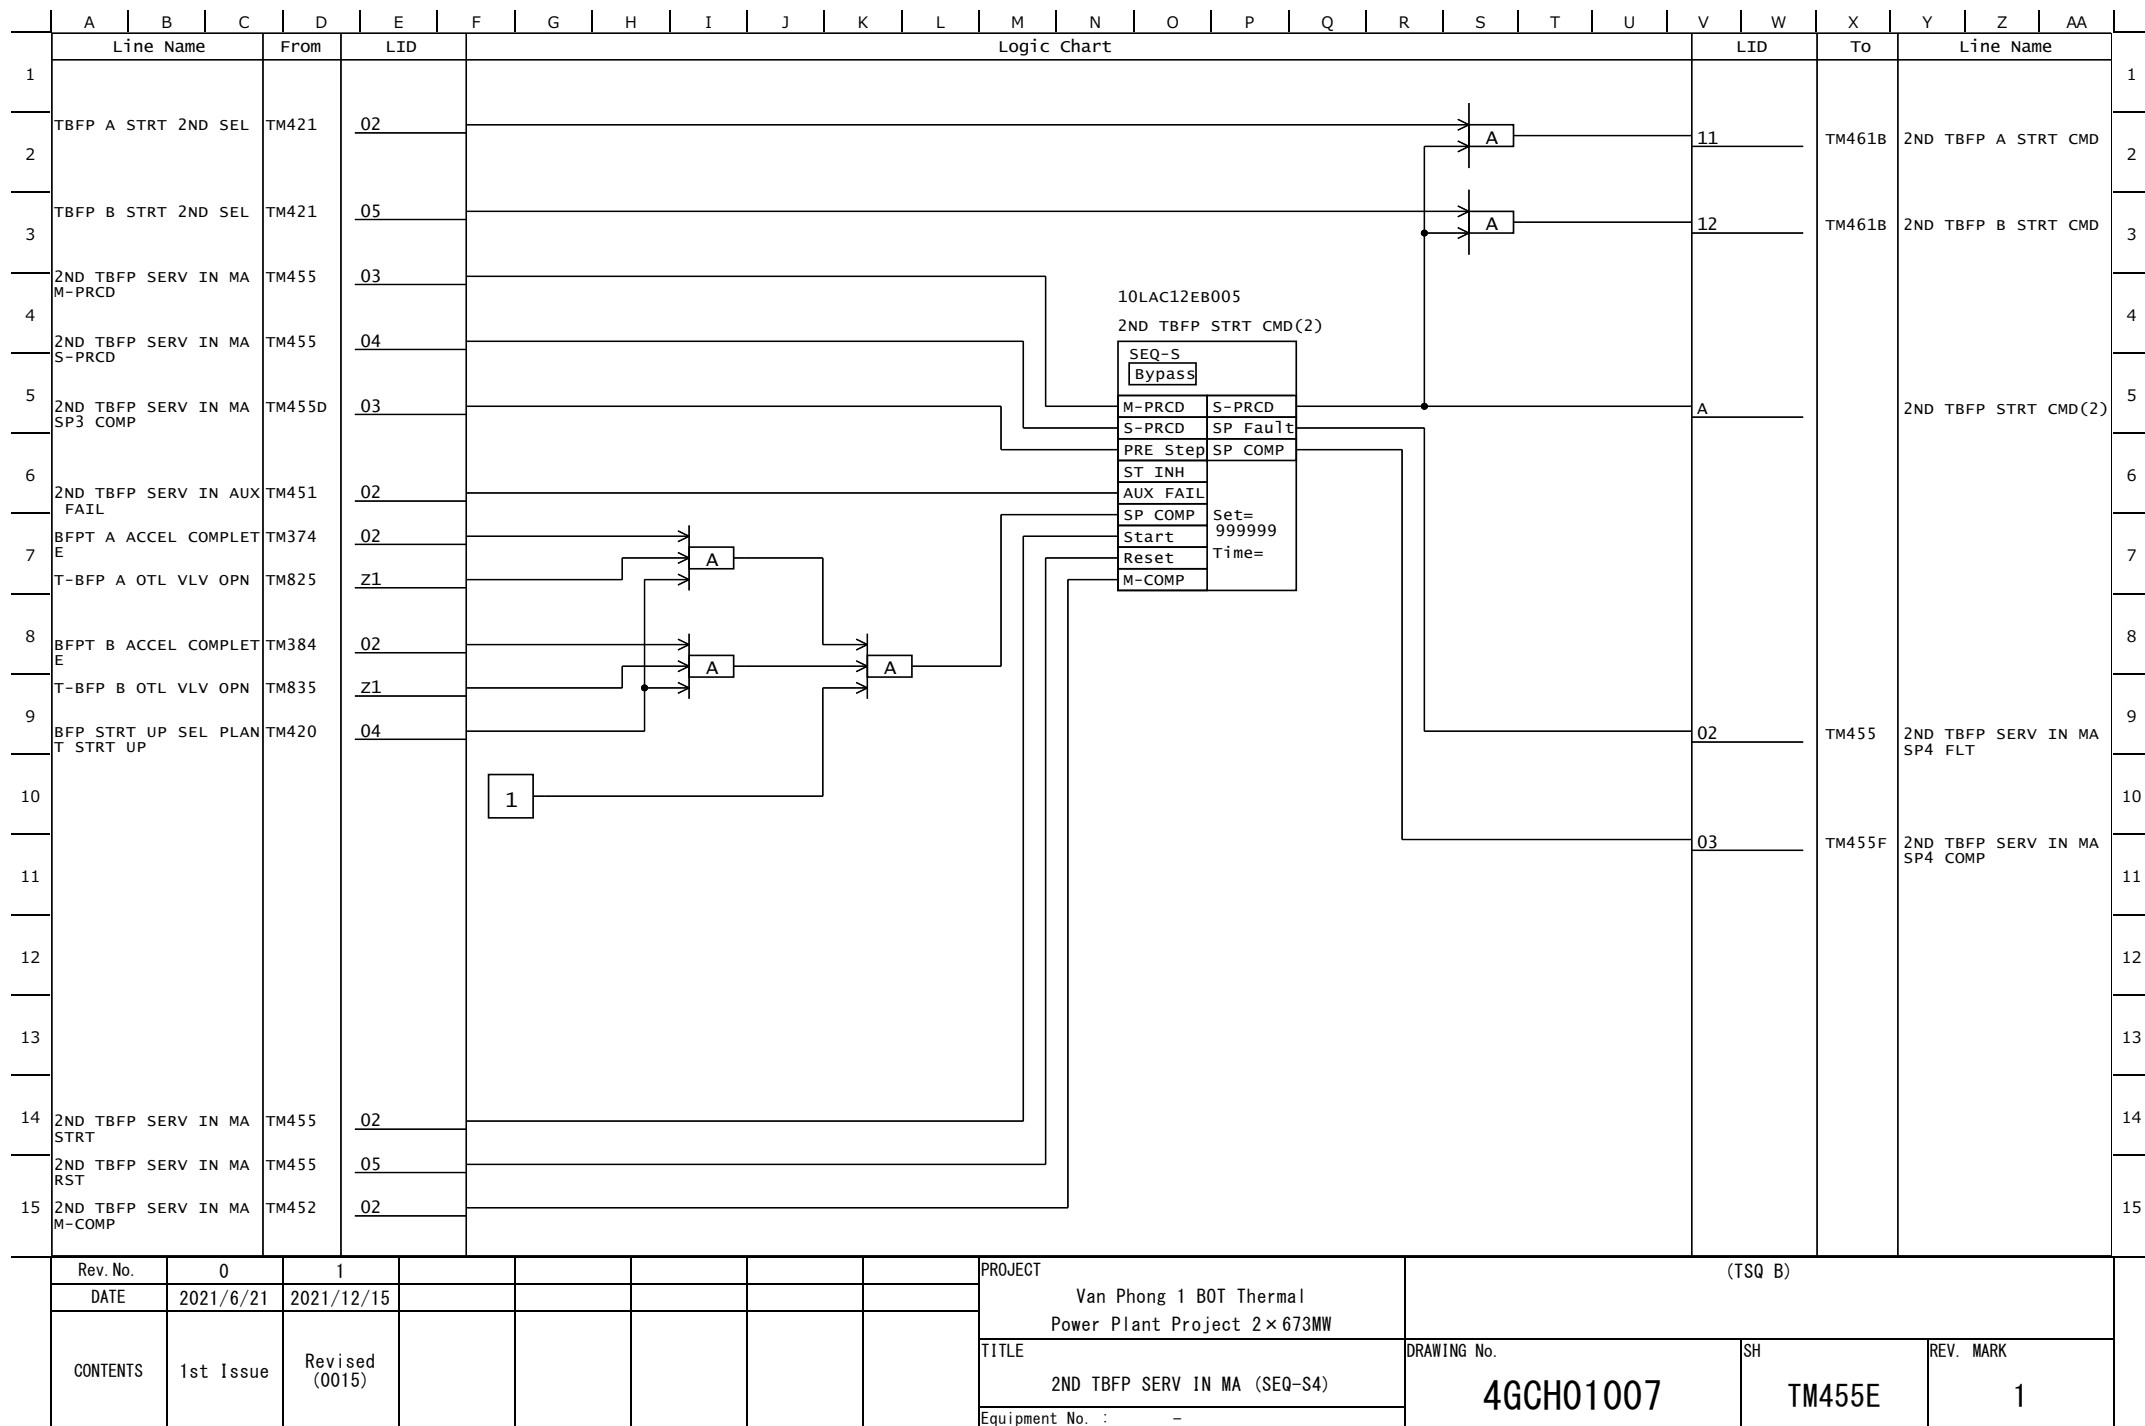

	A	B	C	D	E	F	G	H	I	J	K	L	M	N	O	P	Q	R	S	T	U	V	W	X	Y	Z	AA	
	Line Name				From	LID	Logic Chart																	LID	To	Line Name		
1	2ND TBFP SERV IN MA M-PRCD				TM455	03	10LAC12EB006 2ND TBFP SERV IN (1) SEQ-S Bypass M-PRCD S-PRCD S-PRCD SP Fault PRE Step SP COMP ST INH AUX FAIL SP COMP Set= 999999 Start Reset M-COMP Time=																	A	TM455	2ND TBFP SERV IN MA SP5 FLT	3	
2					TM455	04																		02				
3					TM455E	03																		03				
4					TM451	02																		03				
5	2ND TBFP SERV IN MA SP4 COMP				TM455E	03	1 H-1 H/ 0-100-105%MW S= 25 R= 23 %MW A 1 OR OR 0																	02	TM455G	2ND TBFP SERV IN MA SP5 COMP	4	
6	2ND TBFP SERV IN AUX FAIL				TM451	02																		03				
7	ST GEN LOAD (%MW)				TM385	21																		03				
8	BFP STRT UP SEL PLANT STRT UP				TM420	04																		03				
9	1ST TBFP SERV IN MA M-COMP				TM452	01	1 H-1 H/ 0-100-105%MW S= 25 R= 23 %MW A 1 OR OR 0																	02	TM455G	2ND TBFP SERV IN MA SP5 COMP	5	
10	T-BFP A SERV IN PRMT				TM372C	02																		03				
11	T-BFP B SERV IN PRMT				TM372C	03																		03				
12																								03				
13	2ND TBFP SERV IN MA STRT				TM455	02	1 H-1 H/ 0-100-105%MW S= 25 R= 23 %MW A 1 OR OR 0																	02	TM455G	2ND TBFP SERV IN MA SP5 COMP	6	
14	2ND TBFP SERV IN MA RST				TM455	05																		03				
15	2ND TBFP SERV IN MA M-COMP				TM452	02																		03				
																								03				
Rev. No.		0	1	3	PROJECT										(TSQ B)													
DATE		2021/6/21	2021/12/15	2023/7/5	Van Phong 1 BOT Thermal Power Plant Project 2×673MW																							
CONTENTS		1st Issue	Revised (0015)	Revised (0186)	TITLE										DRAWING No.					SH		REV. MARK						
					2ND TBFP SERV IN MA (SEQ-S5)										4GCH01007					TM455F		3						
					Equipment No. : -																							


Rev. No.	0	1	3					PROJECT	(TSQ B)			
DATE	2021/6/21	2021/12/15	2023/7/5					Van Phong 1 BOT Thermal Power Plant Project 2×673MW				
CONTENTS	1st Issue	Revised (0015)	Revised (0186)					TITLE	DRAWING No.	SH	REV. MARK	
								2ND TBFP SERV IN MA (SEQ-S5)	4GCH01007	TM455F	3	
								Equipment No. : -				



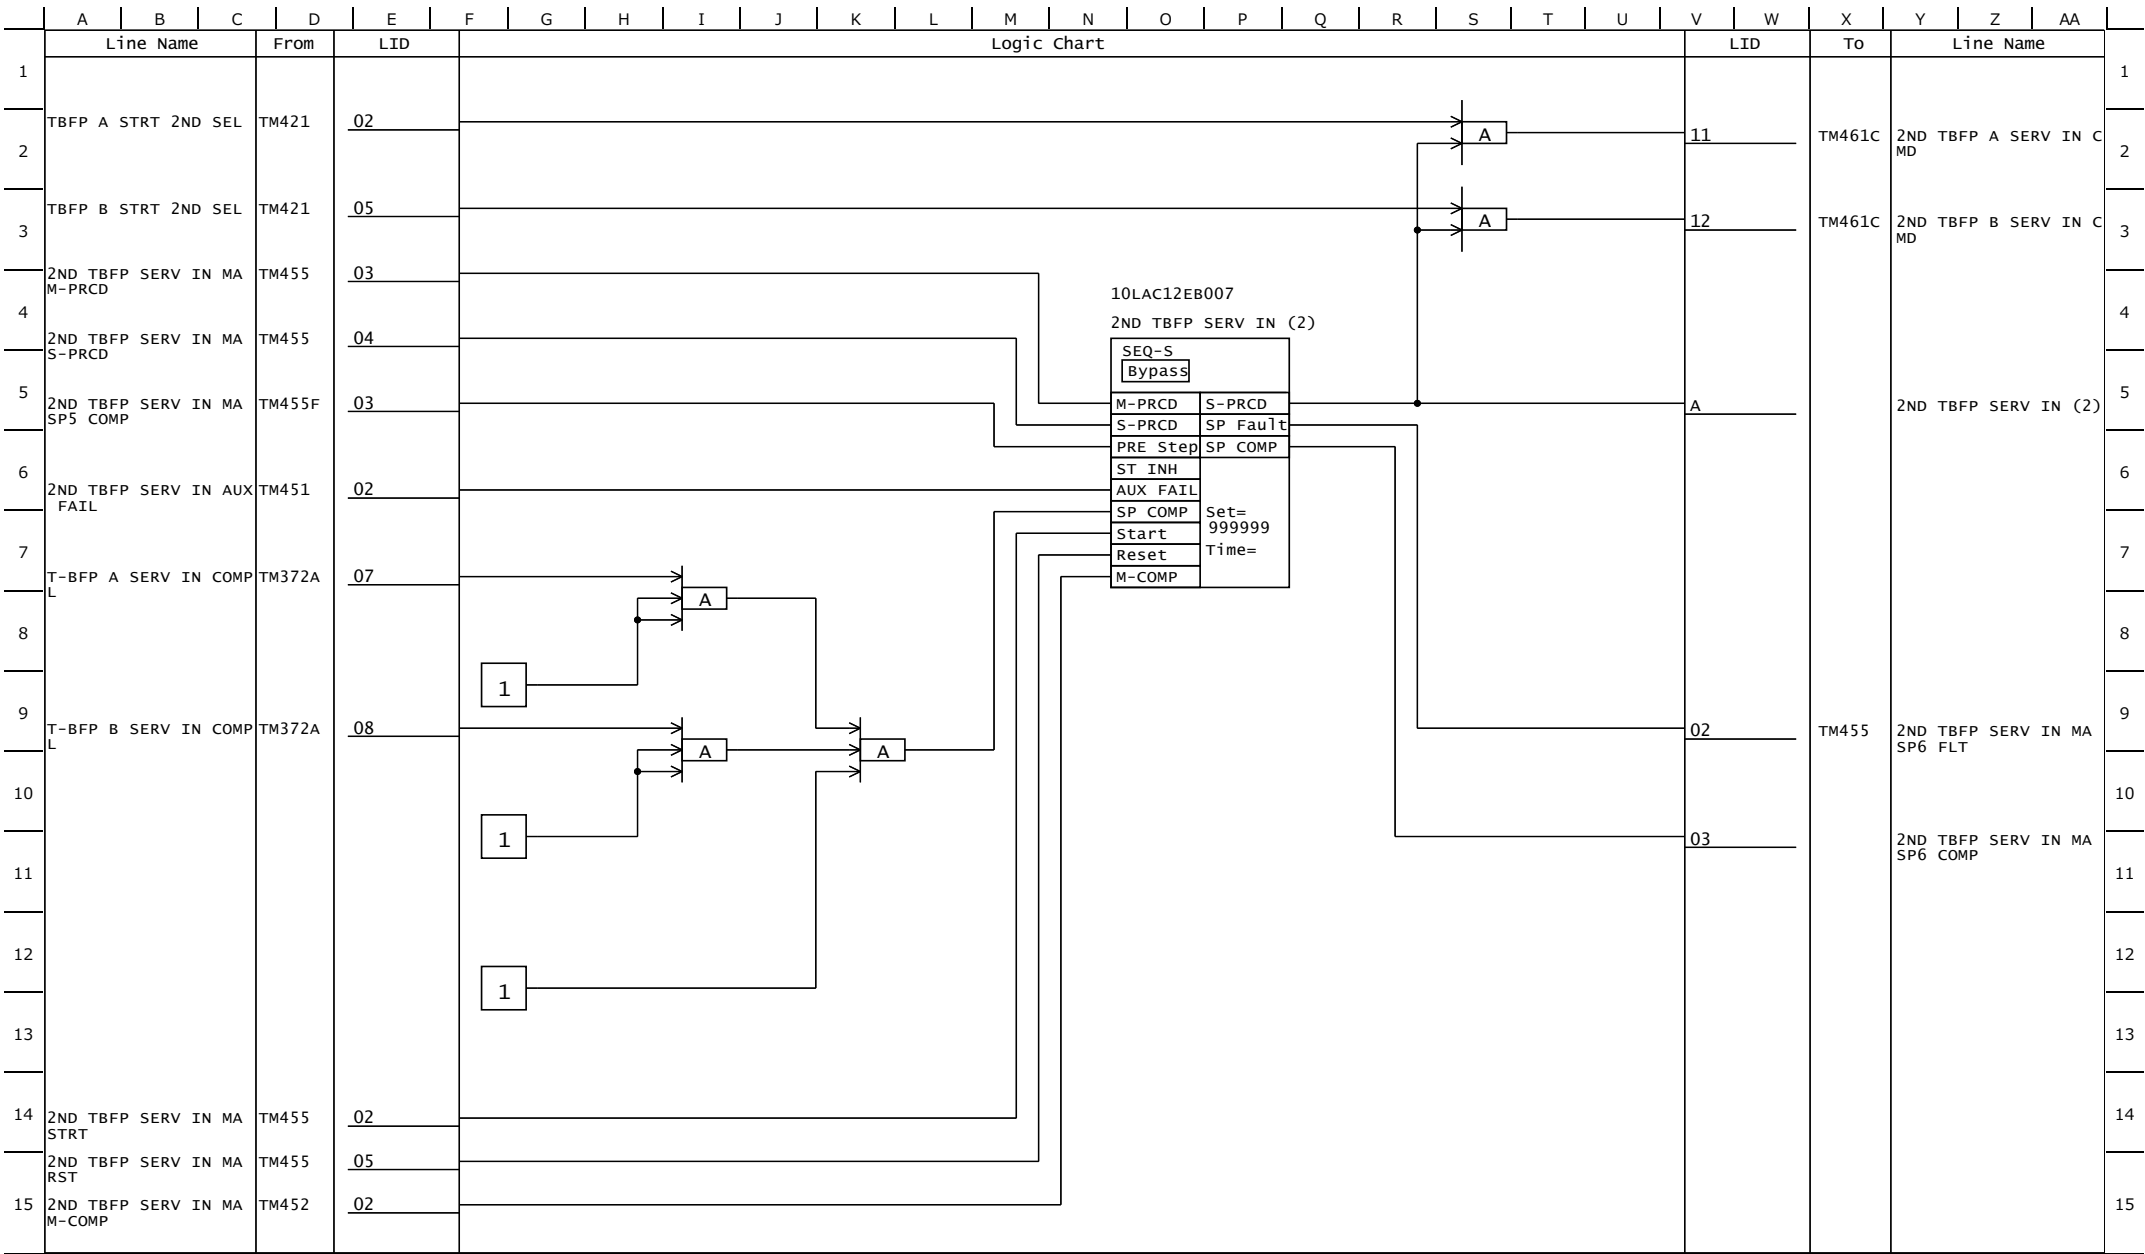


Rev. No.	0	1						PROJECT	(TSQ B)			
DATE	2021/6/21	2021/12/15						Van Phong 1 BOT Thermal Power Plant Project 2×673MW				
CONTENTS	1st Issue	Revised (0015)						TITLE	DRAWING No.	SH	REV. MARK	
								2ND TBFP SERV IN MA (SEQ-S6)	4GCH01007	TM455G	1	
								Equipment No. : -				

	A	B	C	D	E	F	G	H	I	J	K	L	M	N	O	P	Q	R	S	T	U	V	W	X	Y	Z	AA	
	Line Name			From	LID	Logic Chart																	LID	To	Line Name			
1						10CBE20EE065 TBFP PRIORITY SET FOR SERV OUT SEL-3PB 1 TBFP A 2 TBFP B 3 - 1 REQ 2 REQ 3 REQ 1 INH 2 INH 3 INH 1 SEL 2 SEL 3 SEL 0 1 SEL 2 SEL 3 SEL A B																	HAI07H	T-BFP A PRIORITY SET FOR SERV OUT	T-BFP B PRIORITY SET FOR SERV OUT	1		
2																										2		
3																										3		
4																										4		
5																										5		
6																										6		
7																										7		
8																										8		
9																										9		
10																										10		
11																										11		
12																										12		
13																										13		
14																										14		
15																										15		
Rev. No.		2												PROJECT		(TSQ B)												
DATE		2022/11/8												Van Phong 1 BOT Thermal Power Plant Project 2×673MW														
CONTENTS		Sheet Added (0075)												TITLE		DRAWING No.				SH		REV. MARK						
														TBFP PRIORITY SET FOR SERV OUT		4GCH01007				TM465		2						
														Equipment No. : -														

	A	B	C	D	E	F	G	H	I	J	K	L	M	N	O	P	Q	R	S	T	U	V	W	X	Y	Z	AA
	Line Name			From	LID	Logic Chart																	LID	To	Line Name		
1	M-BFP SERV IN COMPL T-BFP A SERV IN COMPL T-BFP B SERV IN COMPL			TM372B	05	Logic Chart 0 OR PO-1 PO1s 10CBE20EE061 BFP SHUTDOWN SEL SEL-3PB 1SEL-1 2SEL-2 3SEL-3 1REQ 2REQ 3REQ 1INH 2INH 3INH 1SEL 2SEL 3SEL 02 01 04																	02	RT397 TM436 TM477A TM477D TM479 TM480 TM481D	BFP SHUTDOWN T+T=>T=>M SEL		
2																											
3																											
Rev. No.			0	1	2											PROJECT			(TSQ B)								
DATE			2021/6/21	2021/12/15	2022/11/8											Van Phong 1 BOT Thermal Power Plant Project 2×673MW											
CONTENTS			1st Issue	Revised (0015)	Revised (0048, 0065)											TITLE			DRAWING No.		SH	REV. MARK					
																PLANT SD MD SEL			4GCH01007		TM465A	2					
																Equipment No. : -											

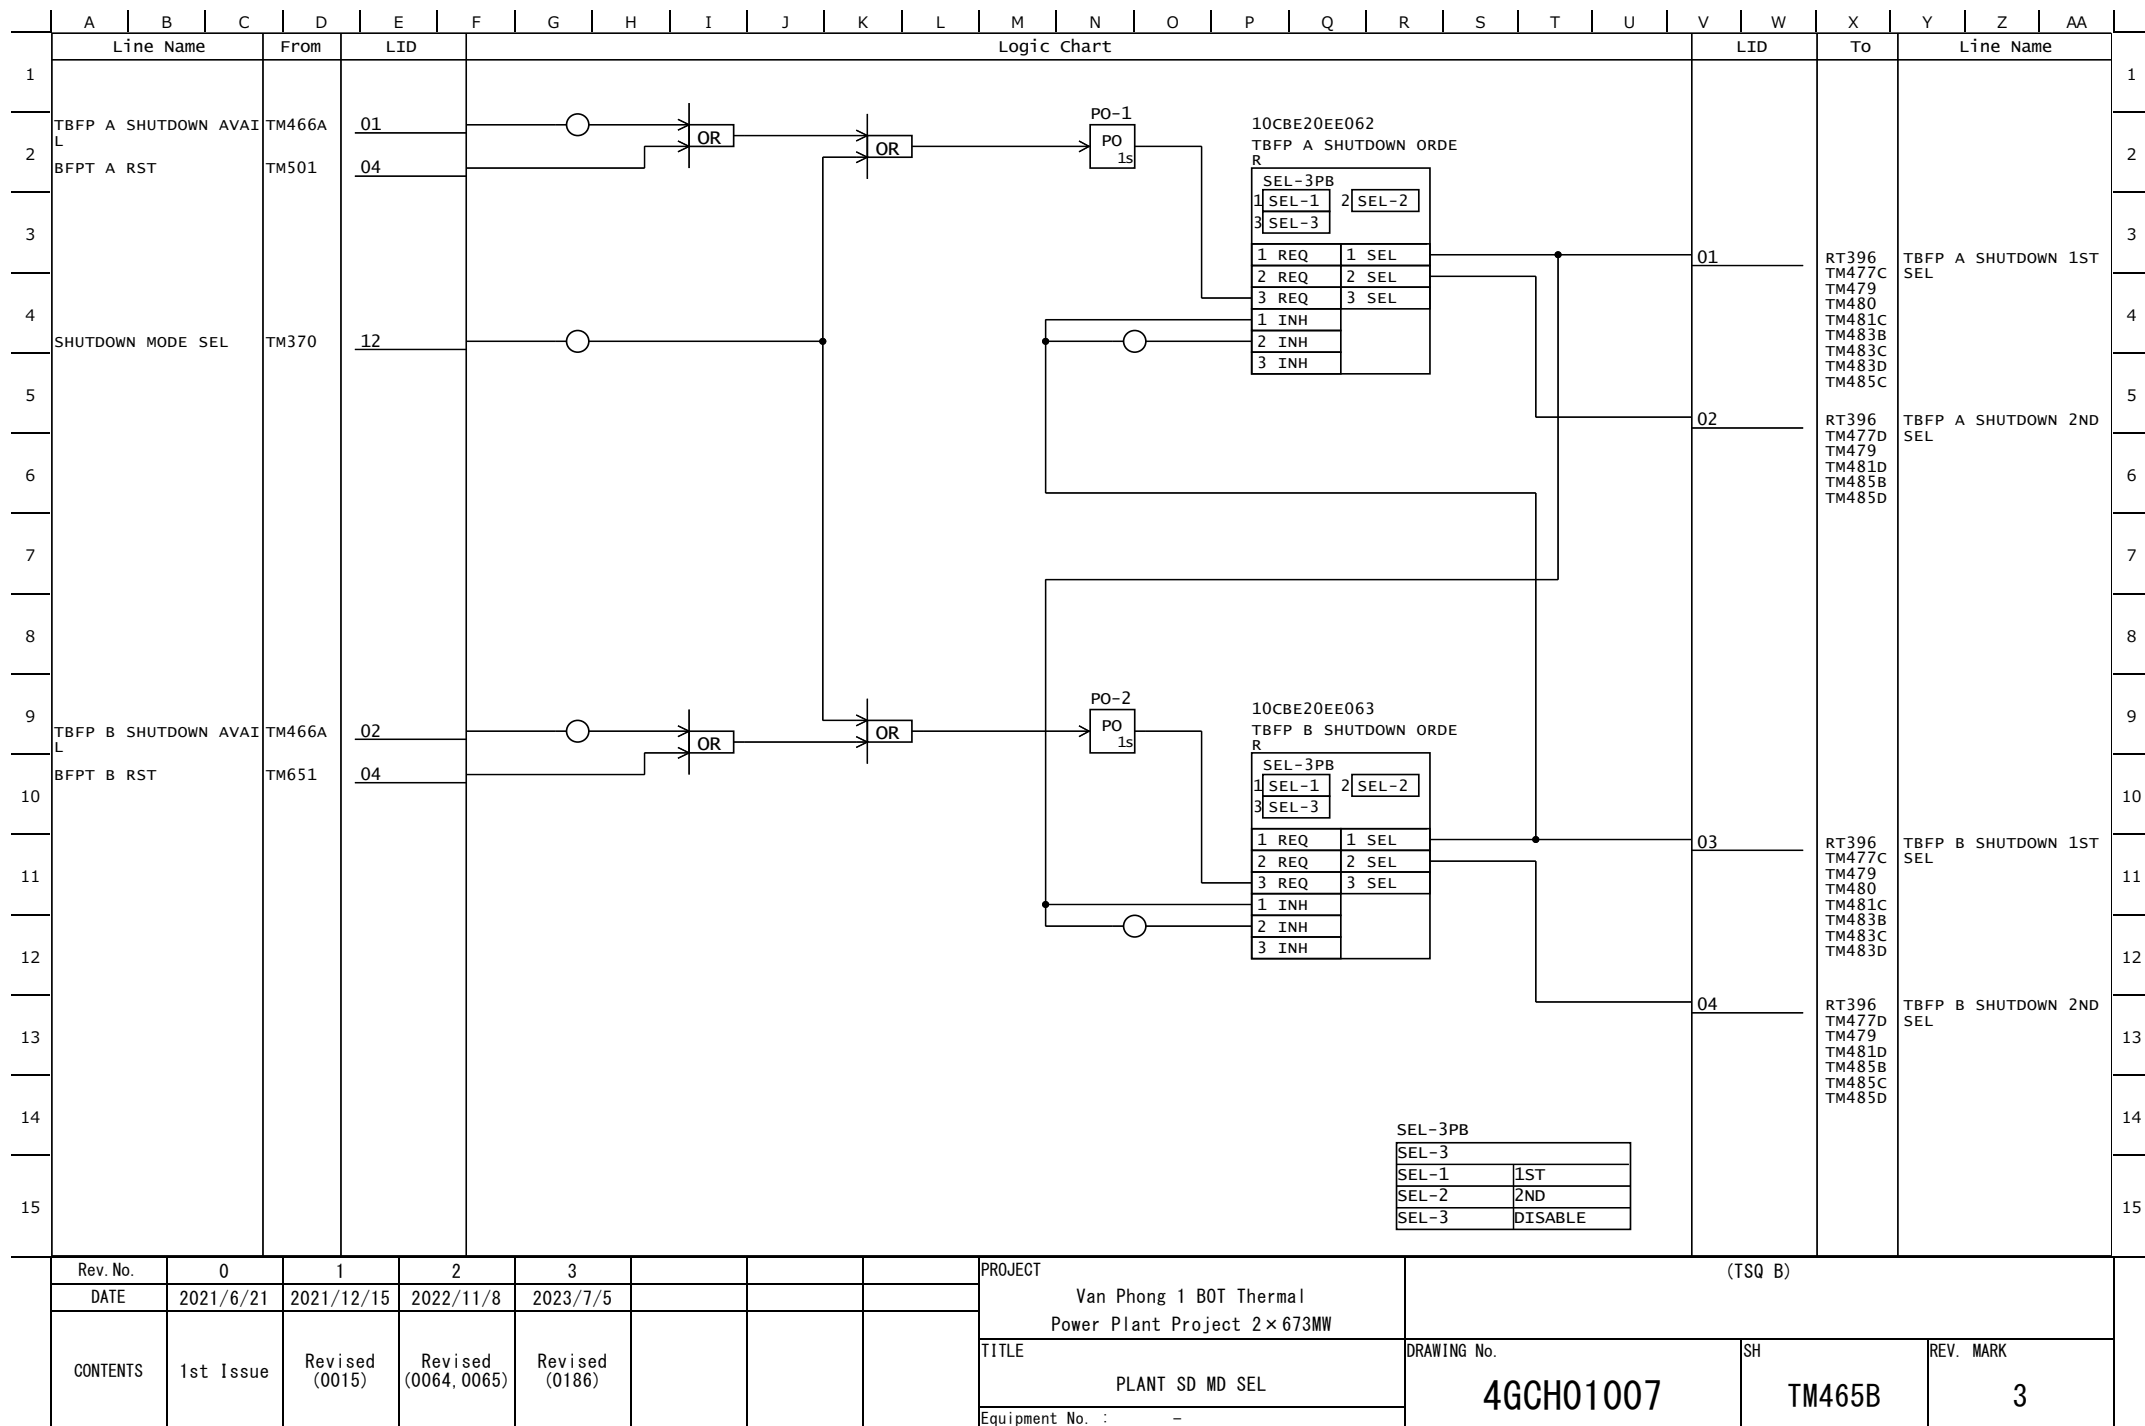

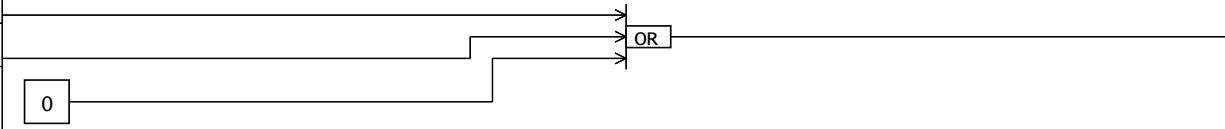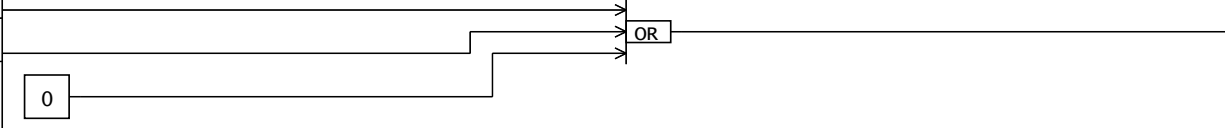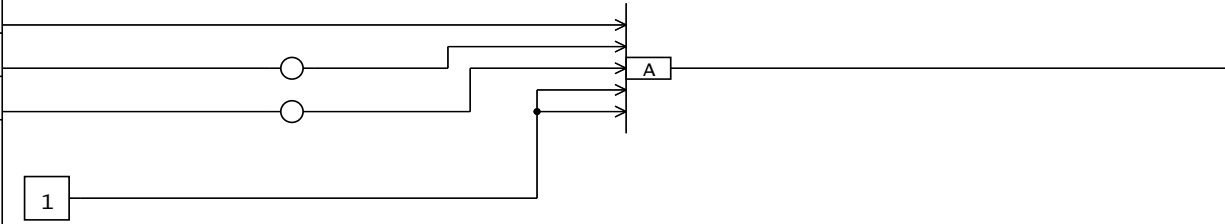	A	B	C	D	E	F	G	H	I	J	K	L	M	N	O	P	Q	R	S	T	U	V	W	X	Y	Z	AA		
	Line Name			From	LID	Logic Chart																	LID	To	Line Name				
1	BFPT A ACCEL COMPLET E T-BFP A SERV IN COMP L			TM374 TM372A	<u>02</u>																		01	TM465B TM466B	TBFP A SHUTDOWN AVAIL L				1
2					<u>07</u>																		2						
3																							3						
4	BFPT B ACCEL COMPLET E T-BFP B SERV IN COMP L			TM384 TM372A	<u>02</u>																		02	TM465B TM466B	TBFP B SHUTDOWN AVAIL L				4
5					<u>08</u>																		5						
6																							6						
7	MBFP AUTO MBFP LCK MBFP ABN			TM925	<u>11</u>																		03	TM466B	MBFP SHUTDOWN AVAIL				7
8					<u>12</u>																		8						
9					<u>21</u>																		9						
10																													10
11																													11
12																													12
13																													13
14																													14
15																													15

Rev. No.	0	1						PROJECT	(TSQ B)			
DATE	2021/6/21	2021/12/15						Van Phong 1 BOT Thermal Power Plant Project 2×673MW				
CONTENTS	1st Issue	Revised (0015)						TITLE	DRAWING No.	SH	REV. MARK	
								SD AVAILABLE BFP INDICATION (1)	4GCH01007	TM466A	1	
								Equipment No. : -				


	A	B	C	D	E	F	G	H	I	J	K	L	M	N	O	P	Q	R	S	T	U	V	W	X	Y	Z	AA					
	Line Name			From	LID	Logic Chart																	LID	To	Line Name							
1	MBFP SHUTDOWN AVAIL			TM466A	03	10CBE20EE064 SHUTDOWN AVAIL BFP LPB-3 1 LPB-1 2 LPB-2 3 LPB-3 1 Lamp 2 Lamp 3 Lamp 1 PB ON 2 PB ON 3 PB ON *INDICATION ONLY.																						1				
2																																
3																																
4																																
5																																
4	TBFP A SHUTDOWN AVAIL			TM466A	01																							4				
5	TBFP B SHUTDOWN AVAIL			TM466A	02																							5				
6																												6				
7																												7				
8																												8				
9																												9				
10																												10				
11																												11				
12																												12				
13																												13				
14																												14				
15																												15				
	Rev. No.		0		1										PROJECT				(TSQ B)													
	DATE		2021/6/21		2021/12/15										Van Phong 1 BOT Thermal Power Plant Project 2×673MW																	
	CONTENTS		1st Issue		Revised (0015)										TITLE				DRAWING No.					SH			REV. MARK					
															SD AVAILABLE BFP INDICATION (2)				4GCH01007					TM466B			1					
															Equipment No. :				-													

	A	B	C	D	E	F	G	H	I	J	K	L	M	N	O	P	Q	R	S	T	U	V	W	X	Y	Z	AA	
	Line Name			From	LID	Logic Chart																	LID	To	Line Name			
1																												1
2	MBFP AUTO			TM925	11																							2
	MBFP AUXOP AUTO			TM930	11																							
3	MBFP OTL VLV AUTO			TM945	11																							3
4																												4
5	M-BFP HYDCPLG AUTO			TM372C	05																							5
6	M-BFP O/L FCV AUTO			TM372C	06																							6
	M-BFP MIN FCV AUTO			TM385	04																							
7																												7
8																												8
9																												9
10																												10
11																												11
12																												12
13																												13
14																												14
15																												15

CONTENTS	Rev. No.	0	1						PROJECT	Van Phong 1 BOT Thermal Power Plant Project 2×673MW						(TSQ B)						SH	REV. MARK	
	DATE	2021/6/21	2021/12/15																					
	1st Issue	Revised (0015)							TITLE	DRAWING No.						4GCH01007		TM470		1				
										Equipment No. : -														


	A	B	C	D	E	F	G	H	I	J	K	L	M	N	O	P	Q	R	S	T	U	V	W	X	Y	Z	AA																														
	Line Name			From	LID	Logic Chart																	LID	To	Line Name																																
1	MBFP ABN			TM925	21																		01	TM474A TM474B TM474C	MBFP SERV OUT MA AUX FAIL			1																													
2				TM930	21																							2																													
3				TM945	21																							3																													
4	M-BFP HYDCPLG ABN			TM372C	04																							4																													
5					5																																																				
6					6																																																				
6	M-BFP O/L FCV ABN			TM372B	03																							7																													
7				MD109	14																							8																													
8																												9																													
10	M-BFP MIN FCV ABN																											10																													
11																												11																													
12																												12																													
13																												13																													
14																												14																													
15																												15																													

Rev. No.	0	1						PROJECT	(TSQ B)			
DATE	2021/6/21	2021/12/15						Van Phong 1 BOT Thermal Power Plant Project 2×673MW				
CONTENTS	1st Issue	Revised (0015)						TITLE	DRAWING No.	SH	REV. MARK	
								MBFP SERV OUT MA AUX FAIL	4GCH01007	TM472	1	
								Equipment No. : -				

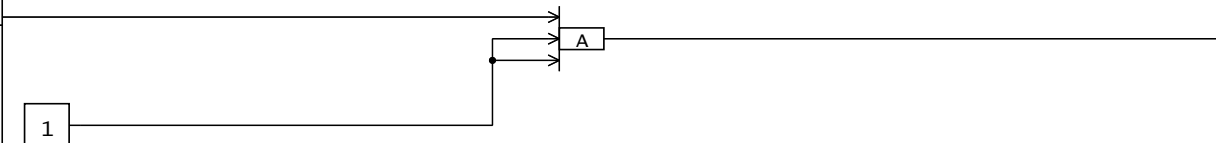	A	B	C	D	E	F	G	H	I	J	K	L	M	N	O	P	Q	R	S	T	U	V	W	X	Y	Z	AA				
	Line Name			From	LID	Logic Chart																	LID	To	Line Name						
1	MBFP MOT STPD			TM320	02																		01	RT395 TM474A TM474B TM474C	MBFP SERV OUT MA M-C OMP						
2																															
3																															
Rev. No.		0		1		2										PROJECT						(TSQ B)									
DATE		2021/6/21		2021/12/15		2022/11/8										Van Phong 1 BOT Thermal Power Plant Project 2×673MW															
CONTENTS		1st Issue		Revised (0015)		Revised (0065)										TITLE						DRAWING No.				SH		REV. MARK			
																MBFP SERV OUT MA COMPLETE						4GCH01007				TM473		2			
																Equipment No. : -															

	A	B	C	D	E	F	G	H	I	J	K	L	M	N	O	P	Q	R	S	T	U	V	W	X	Y	Z	AA		
	Line Name			From	LID	Logic Chart																	LID	To	Line Name				
1	MBFP SERV OUT MA (SEQ-M) 10LAC30EB010 MBFP SERV OUT MA SEQ-M PAS OPS Start Reset Pause ST DMD PAS PAS OPS OPS Start M-COMP M-PRCD AUX Auto S-PRCD ST INH Reset Relative M-Fault AUX FAIL ST PRMT SP Fault ABN																											1	
2				MBFP SERV OUT CMD	TM369	07																		01		MBFP SERV OUT MA PAS			2
3				M-BFP SERV OUT MSTR PAS CMD	TM369	08																							3
4				M-BFP SERV OUT MSTR OPS CMD	TM369	09																		02					4
5				MBFP SERV OUT MA M-COMP	TM473	01																			TM474B TM474C	MBFP SERV OUT MA STRT			5
6				MBFP SERV OUT MA AUX AUTO	TM470	01																							6
7				MBFP SERV OUT MA (T+M->T) STRT INH	TM471	01																		03	TM474B TM474C	MBFP SERV OUT MA M-PRCD			7
8				MBFP SERV IN MA S-PRCD	TM441A	04																		04	RT395 TM471 TM474B TM474C	MBFP SERV OUT MA S-PRCD			8
9																								05	TM474B TM474C	MBFP SERV OUT MA RST			9
10																								06	RT395	MBFP SERV OUT MA M-FLT			10
11				MBFP SERV OUT MA AUX FAIL	TM472	01																		07	RT395	MBFP SERV OUT MA ST PRMT			11
12																													12
13				MBFP SERV OUT MA SP1 FLT	TM474B	02																							13
14				MBFP SERV OUT MA (T+M->T) SP2 FLT	TM474C	02																							14
15																													15

Rev. No.	0	1	2						PROJECT										(TSQ B)														
									Van Phong 1 BOT Thermal																								
									Power Plant Project 2×673MW																								
DATE	2021/6/21	2021/12/15	2022/11/8							TITLE										DRAWING No.										SH		REV. MARK	
CONTENTS	1st Issue	Revised (0015)	Revised (0065)							MBFP SERV OUT MA (SEQ-M)										4GCH01007										TM474A		2	
Equipment No. :										-																							

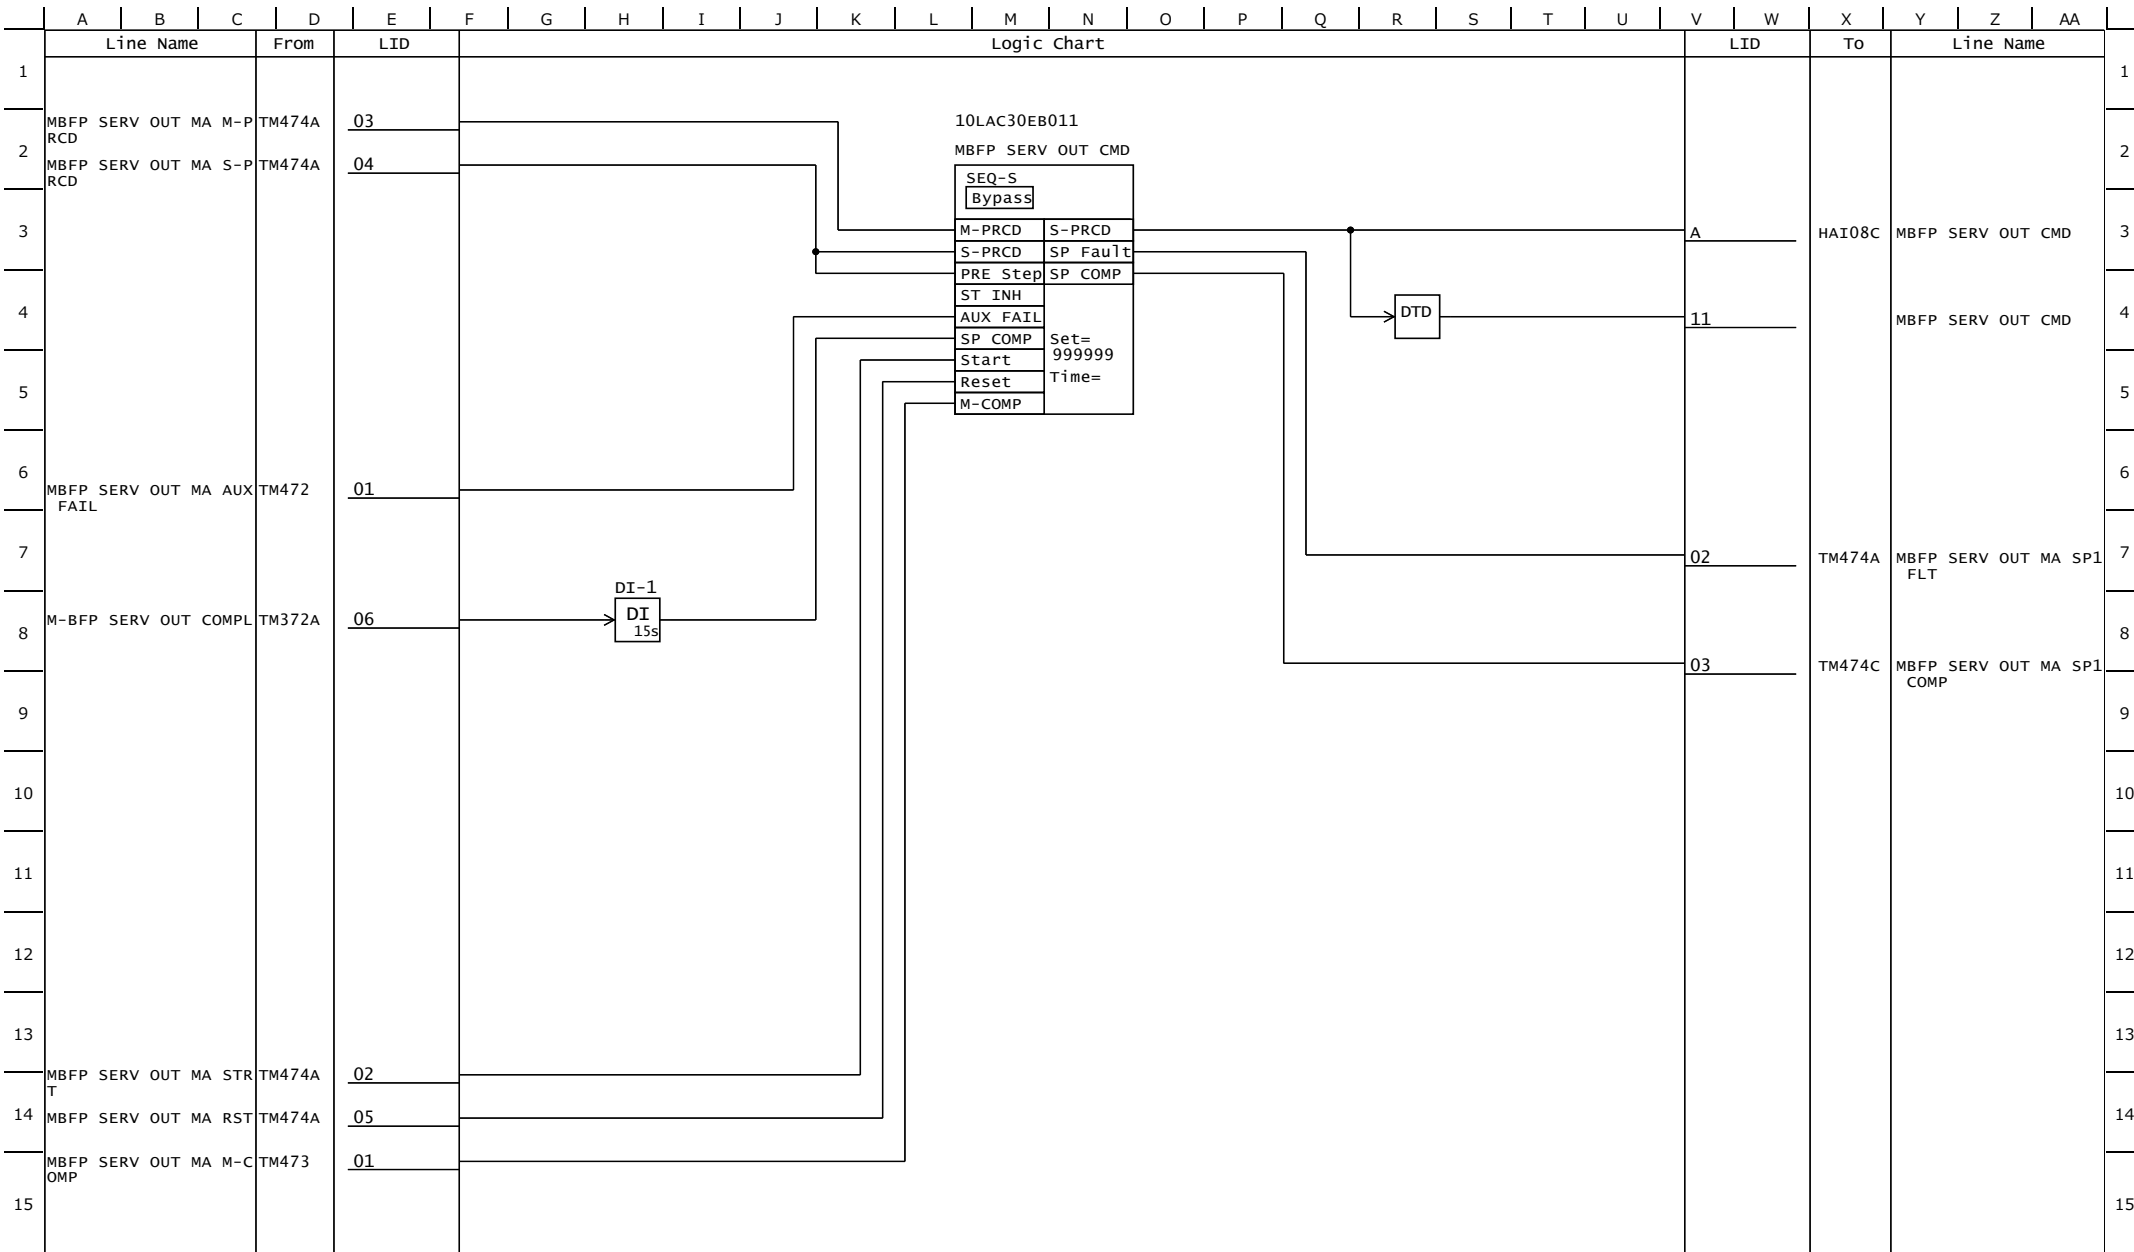



Rev. No.	0	1	3					PROJECT	(TSQ B)		
DATE	2021/6/21	2021/12/15	2023/7/5					Van Phong 1 BOT Thermal Power Plant Project 2×673MW			
CONTENTS	1st Issue	Revised (0015, 0030)	Revised (0186)					TITLE	DRAWING No.	SH	REV. MARK
								MBFP SERV OUT MA (SEQ-S1)	4GCH01007	TM474B	3
								Equipment No. : -			

	A	B	C	D	E	F	G	H	I	J	K	L	M	N	O	P	Q	R	S	T	U	V	W	X	Y	Z	AA																			
	Line Name			From	LID	Logic Chart																	LID	To	Line Name																					
1																																1														
2	T-BFP A NOISE ECLSR FAN AUTO			TM855	11						2																																			
3	BFPT A T-GEAR AUTO			TM520	11						3																																			
	BFPT A MSV B/S DV AUTO			TM580	11						4																																			
4	BFPT A MSV A/S DV AUTO			TM585	11						4																																			
	BFPT A CSG DV AUTO			TM590	11						5																																			
5	T-BFP A EHC AUTO			TM372B	07						5																																			
6	T-BFP A OTL VLV AUTO			TM825	11	01	TM477C TM477D	TBFP A SERV OUT AUX AUTO			6																																			
	T-BFP A MIN FCV AUTO			TM385	05						6																																			
7	BFPT A MSV I/L VLV AUTO			TM570	11						7																																			
8											8																																			
9	BFP SHUTDOWN T+T=>T=>M SEL			TM465A	02						9																																			
10											10																																			
11	BFP SHUTDOWN T+T=>T SEL			TM465A	01						11																																			
12	T-BFP HDR ISOL VLV AUTO			TM850	11						12																																			
13	T-BFP STARTUP FCV AUTO			TM372B	06						13																																			
14											14																																			
15											15																																			
Rev. No.				0	1	2																				PROJECT														(TSQ B)						
DATE				2021/6/21	2021/12/15	2022/11/8																				Van Phong 1 BOT Thermal Power Plant Project 2×673MW																				
CONTENTS				1st Issue	Revised (0015, 0024)	Revised (0045)																				TITLE						DRAWING No.						SH			REV. MARK					
																										TBFP SERV OUT MA AUX AUTO (1)						4GCH01007						TM477A			2					
																										Equipment No. : -																				


	A	B	C	D	E	F	G	H	I	J	K	L	M	N	O	P	Q	R	S	T	U	V	W	X	Y	Z	AA						
	Line Name			From	LID	Logic Chart																	LID	To	Line Name								
1					01																		01	TM485A	TBFP SERV OUT MA (T+M->M) AUX AUTO			1					
2																												2					
3	TBFP A SERV OUT AUX AUTO			TM477A																								3					
4	TBFP B SERV OUT AUX AUTO			TM477B																								4					
5					01																							5					
6	TBFP SERV OUT MA (T+M->M) S-PRCD																											6					
7	T-BFP A SERV IN COMPL			TM372A																								7					
8	T-BFP B SERV IN COMPL			TM372A																								8					
9	BFP SHUTDOWN T+T=>T=>M SEL			TM465A																								9					
	SHUTDOWN MODE SEL			TM370																								10					
10	TBFP A SHUTDOWN 2ND SEL			TM465B																								10					
11	M-BFP SERV IN COMPL			TM372B																								11					
12					04																							12					
13	TBFP B SHUTDOWN 2ND SEL																											13					
14																												14					
15																												15					
	Rev. No.	0	1	2										PROJECT				(TSQ B)															
	DATE	2021/6/21	2021/12/15	2022/11/8										Van Phong 1 BOT Thermal Power Plant Project 2×673MW																			
	CONTENTS	1st Issue	Revised (0015)	Revised (0047, 0048)										TITLE				DRAWING No.				SH				REV. MARK							
														TBFP SERV OUT MA AUX AUTO (4)				4GCH01007				TM477D				2							
														Equipment No. : -																			

	A	B	C	D	E	F	G	H	I	J	K	L	M	N	O	P	Q	R	S	T	U	V	W	X	Y	Z	AA					
	Line Name			From	LID	Logic Chart																	LID	To	Line Name							
1	ST GEN LOAD (%MW)			TM385	21																				TBFP SERV OUT MA (T+T->T) STRT INH			1				
2	TBFP SERV OUT MA (T+T->T) S-PRCD			TM483A	04																							2				
3	T-BFP A SERV OUT PRM T			TM372C	08																							3				
4	SHUTDOWN MODE SEL			TM370	12																							4				
5	BFP SHUTDOWN T+T=>T SEL			TM465A	01																							5				
6	TBFP A SHUTDOWN 1ST SEL			TM465B	01																							6				
7	BFP SHUTDOWN T+T=>T=>M SEL			TM465A	02																							7				
8	TBFP A SHUTDOWN 2ND SEL			TM465B	02																							8				
9	T-BFP B SERV OUT PRM T			TM372C	09																							9				
10	TBFP B SHUTDOWN 1ST SEL			TM465B	03																							10				
11																												11				
12																												12				
13	TBFP B SHUTDOWN 2ND SEL			TM465B	04																							13				
14	TBFP SERV OUT MA (T+M->M) S-PRCD			TM485A	04																							14				
15																												15				
	Rev. No.	0	1	2									PROJECT					(TSQ B)														
	DATE	2021/6/21	2021/12/15	2022/11/8									Van Phong 1 BOT Thermal Power Plant Project 2×673MW																			
	CONTENTS	1st Issue	Revised (0015)	Revised (0047)									TITLE					DRAWING No.					SH					REV. MARK				
													TBFP SERV OUT MA STRT INHIBIT					4GCH01007					TM479					2				
													Equipment No. : -																			

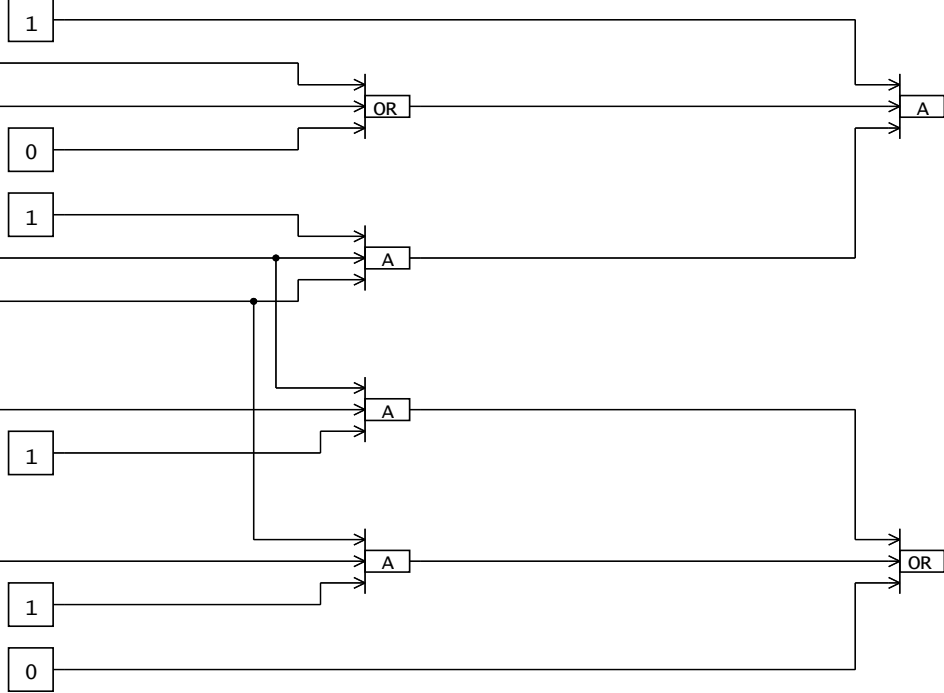	A	B	C	D	E	F	G	H	I	J	K	L	M	N	O	P	Q	R	S	T	U	V	W	X	Y	Z	AA										
	Line Name			From	LID	Logic Chart																	LID	To	Line Name												
1	BFP SHUTDOWN T+T=>T=>M SEL SHUTDOWN MODE SEL BFPT A TRIP BFPT B TRIP TBFP A SHUTDOWN 1ST SEL TBFP B SHUTDOWN 1ST SEL			TM465A	02																		01	RT398 TM485A TM485B TM485C TM485D	TBFP SERV OUT MA (T+M->M) M-COMP			1									
2																												2									
3					12																							3									
4				TM501	01	01	RT398 TM485A TM485B TM485C TM485D	TBFP SERV OUT MA (T+M->M) M-COMP			4																										
5					01						5																										
6				TM465B	01	01	RT398 TM485A TM485B TM485C TM485D	TBFP SERV OUT MA (T+M->M) M-COMP			6																										
7											7																										
8					03	02	RT395 TM483A TM483B TM483C TM483D	TBFP SERV OUT MA (T+T->T) M-COMP			8																										
9				TM465B							9																										
10											10																										
11											11																										
12											12																										
13											13																										
14											14																										
15											15																										
Rev. No.					0						1	2						PROJECT					(TSQ B)														
DATE					2021/6/21						2021/12/15	2022/11/8						Van Phong 1 BOT Thermal Power Plant Project 2×673MW																			
CONTENTS					1st Issue		Revised (0015)	Revised (0065)						TITLE					DRAWING No.					SH		REV. MARK											
														TBFP SERV OUT MA MA COMPLETE					4GCH01007					TM480		2											
														Equipment No. : -																							

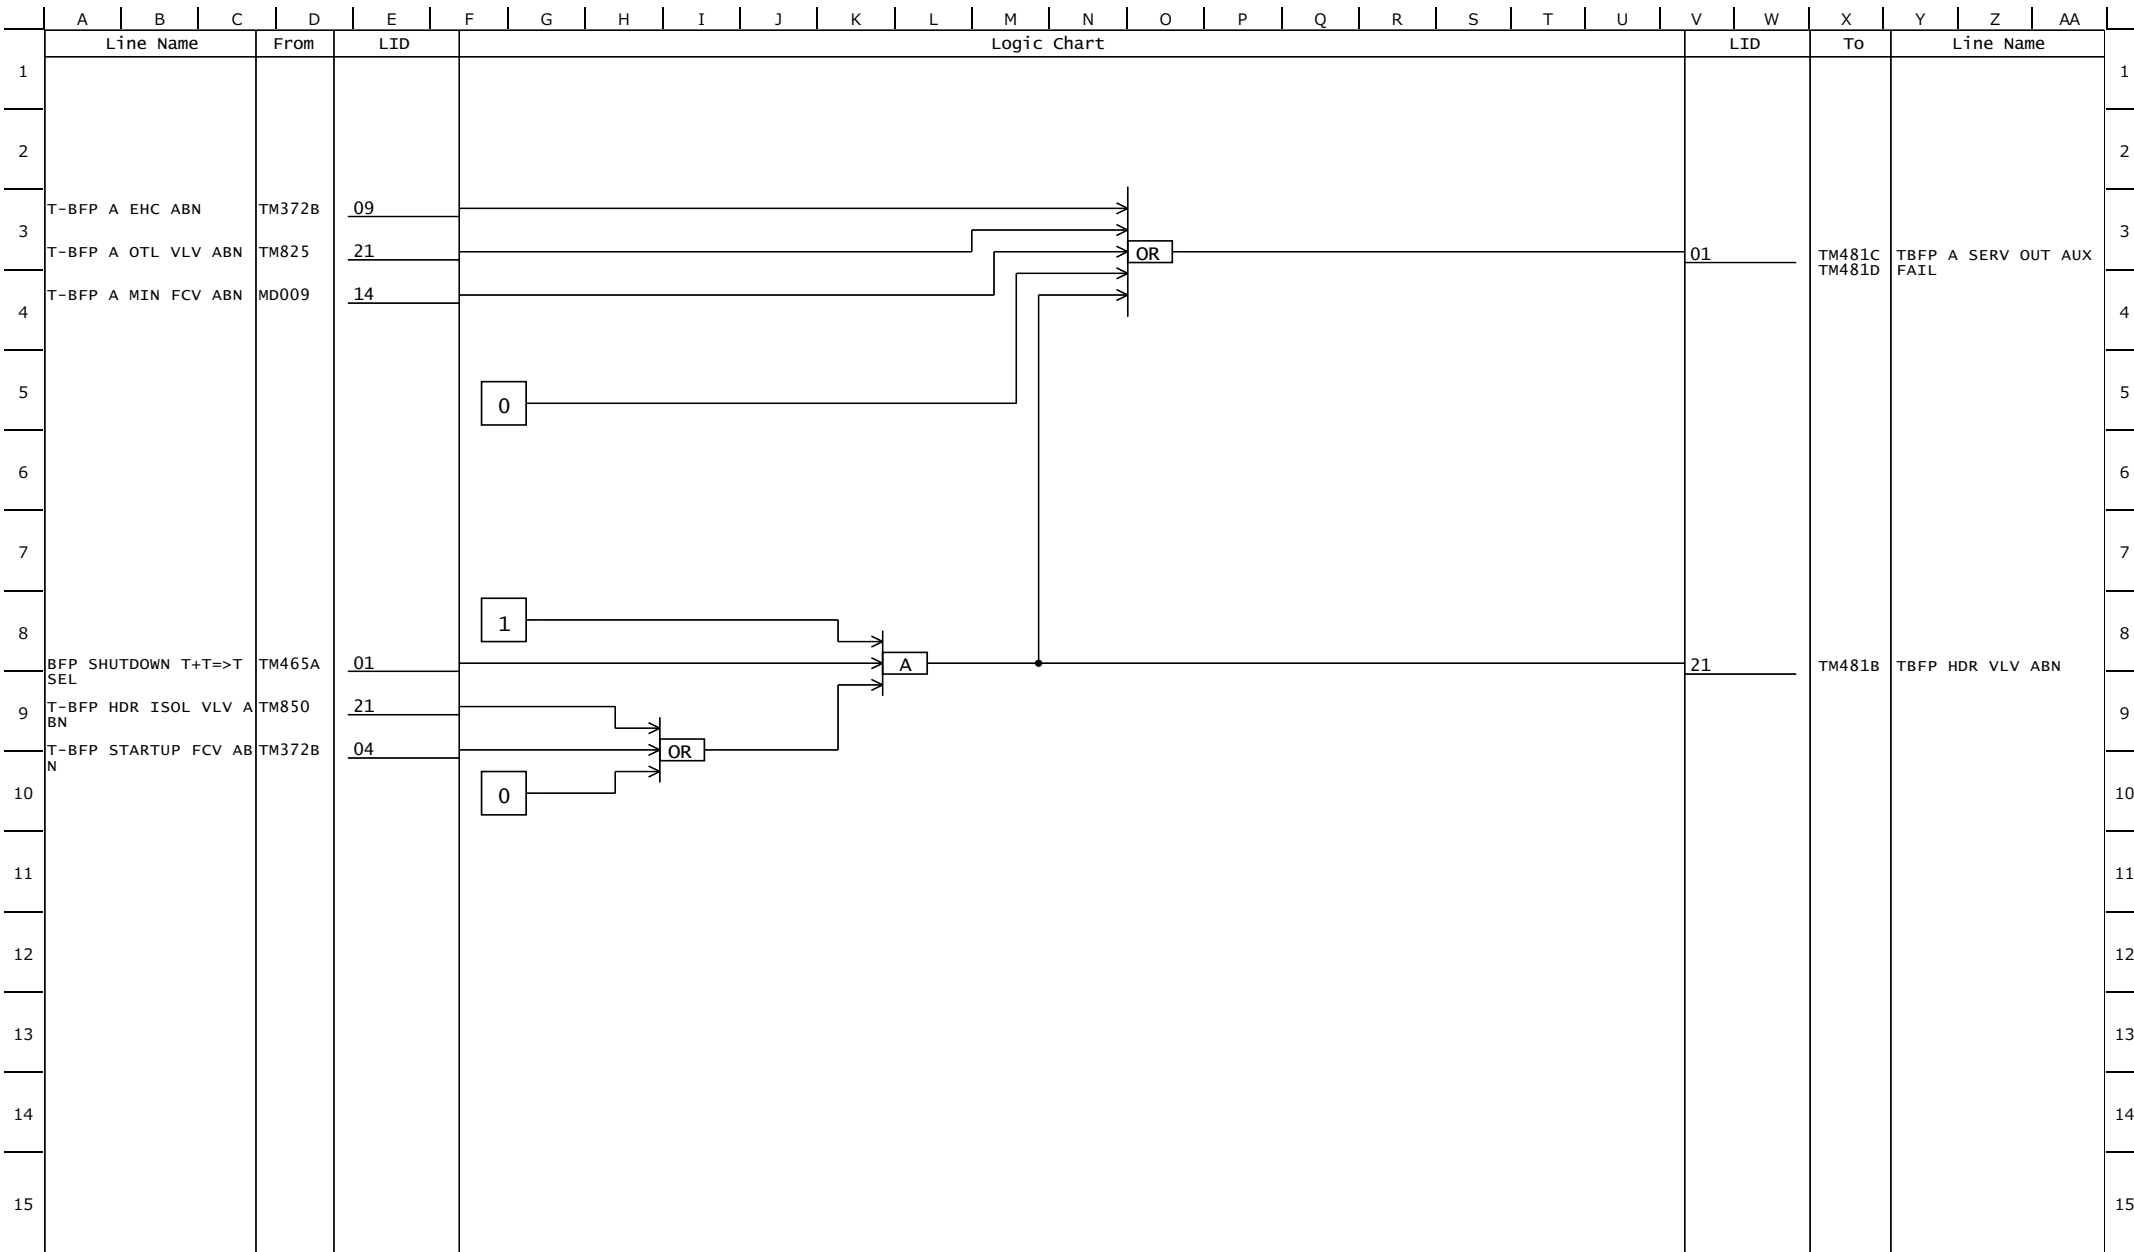


Rev. No.	0	1						PROJECT Van Phong 1 BOT Thermal Power Plant Project 2×673MW	(TSQ B)		
DATE	2021/6/21	2021/12/15									
CONTENTS	1st Issue	Revised (0015)						TITLE	DRAWING No.	SH	REV. MARK
								TBFP SERV OUT MA AUX FAIL (1)	4GCH01007	TM481A	1
								Equipment No. : -			

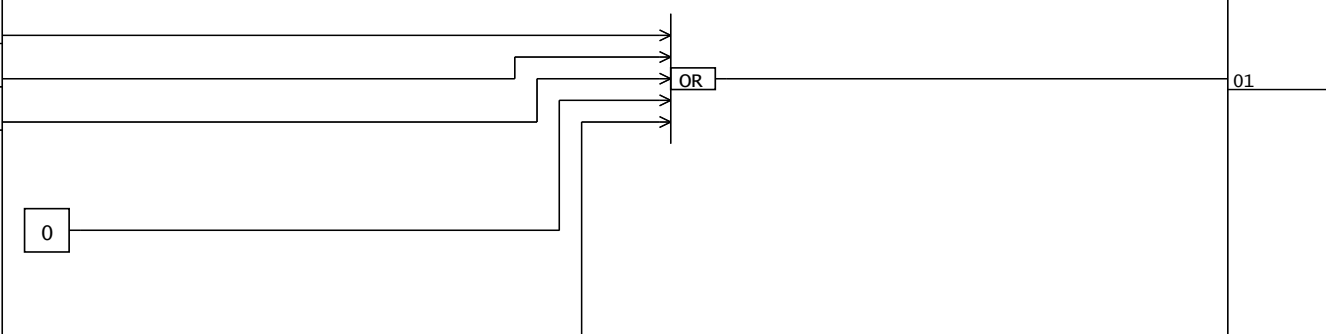
	A	B	C	D	E	F	G	H	I	J	K	L	M	N	O	P	Q	R	S	T	U	V	W	X	Y	Z	AA			
	Line Name			From	LID	Logic Chart																	LID	To	Line Name					
1	T-BFP B EHC ABN			TM372B	10																		01	TM481C TM481D	TBFP B SERV OUT AUX FAIL			1		
2																												2		
3					21																							3		
4					14																							4		
5	TBFP HDR VLV ABN			TM481A																			01	TM481C TM481D	TBFP B SERV OUT AUX FAIL			5		
6																												6		
7					21																							7		
8																												8		
9																												9		
10																												10		
11																												11		
12																												12		
13																												13		
14																												14		
15																												15		
Rev. No.		0		1										PROJECT		(TSQ B)														
DATE		2021/6/21		2021/12/15										Van Phong 1 BOT Thermal Power Plant Project 2×673MW																
CONTENTS		1st Issue		Revised (0015)										TITLE		DRAWING No.				SH		REV. MARK								
														TBFP SERV OUT MA AUX FAIL (2)		4GCH01007				TM481B		1								
														Equipment No. : -																

	A	B	C	D	E	F	G	H	I	J	K	L	M	N	O	P	Q	R	S	T	U	V	W	X	Y	Z	AA	
	Line Name			From	LID	Logic Chart																	LID	To	Line Name			
1	TBFP A SERV OUT AUX FAIL			TM481A	_01																		01	TM485A TM485B TM485C TM485D	TBFP SERV OUT MA (T+M->M) AUX FAIL			1
2																												2
3																												3
4	TBFP B SERV OUT AUX FAIL			TM481B	_01																		01	TM485A TM485B TM485C TM485D	TBFP SERV OUT MA (T+M->M) AUX FAIL			4
5	TBFP SERV OUT MA (T+M->M) S-PRCD			TM485A	_04																							5
6	T-BFP A SERV IN COMPL			TM372A	_07																							6
7	T-BFP B SERV IN COMPL			TM372A	_08																		08	TM485A TM485B TM485C TM485D	TBFP SERV OUT MA (T+M->M) AUX FAIL			7
8	M-BFP SERV IN COMPL			TM372B	_05																							8
9	TBFP A SHUTDOWN 2ND SEL			TM465B	_02																							9
10																							04	TM485A TM485B TM485C TM485D	TBFP SERV OUT MA (T+M->M) AUX FAIL			10
11																												11
12																												12
13	TBFP B SHUTDOWN 2ND SEL			TM465B	_04																		04	TM485A TM485B TM485C TM485D	TBFP SERV OUT MA (T+M->M) AUX FAIL			13
14	BFP SHUTDOWN T+T=>T=>M SEL			TM465A	_02																							14
15	SHUTDOWN MODE SEL			TM370	_12																							15
Rev. No.					0	1	2						PROJECT					(TSQ B)										
DATE					2021/6/21	2021/12/15	2022/11/8						Van Phong 1 BOT Thermal Power Plant Project 2×673MW															
CONTENTS					1st Issue	Revised (0015)	Revised (0047)						TITLE					DRAWING No.					SH			REV. MARK		
													TBFP SERV OUT MA AUX FAIL (4)					4GCH01007					TM481D			2		
													Equipment No. : -															


	A	B	C	D	E	F	G	H	I	J	K	L	M	N	O	P	Q	R	S	T	U	V	W	X	Y	Z	AA						
	Line Name			From	LID	Logic Chart																	LID	To	Line Name								
1																											1						
2																							01		TBFP SERV OUT MA (T+T->T) PAS		2						
3	TBFP SERV OUT MA (T+T->T) M-COMP			TM480	02																						3						
4																							02	TM483B TM483C TM483D	TBFP SERV OUT MA (T+T->T) STRT		4						
5	TBFP SERV OUT MA (T+T->T) AUX AUTO			TM477C	01																						5						
6	TBFP SERV OUT MA (T+T->T) STRT INH			TM479	01																		03	TM483B TM483C TM483D	TBFP SERV OUT MA (T+T->T) M-PRCD		6						
7	1ST TBFP SERV IN MA S-PRCD			TM453	04																		04	RT395 TM455 TM477C TM479 TM481C TM483B TM483C TM483D TM485A	TBFP SERV OUT MA (T+T->T) S-PRCD		7						
8	2ND TBFP SERV IN MA S-PRCD			TM455	04																						8						
8	TBFP SERV OUT MA (T+M->M) S-PRCD			TM485A	04																						8						
9																											9						
10																							05	TM483B TM483C TM483D	TBFP SERV OUT MA (T+T->T) RST		10						
11	TBFP SERV OUT MA (T+T->T) AUX FAIL			TM481C	01																						11						
12	TBFP SERV OUT MA (T+T->T) SP1 FLT			TM483B	02																		06	RT395	TBFP SERV OUT MA (T+T->T) M-FLT		12						
	TBFP SERV OUT MA (T+T->T) SP2 FLT			TM483C	02																												
13	TBFP SERV OUT MA (T+T->T) SP3 FLT			TM483D	02																						13						
14																							07	RT395	TBFP SERV OUT MA (T+T->T) ST PRMT		14						
15																											15						
	Rev. No.	0	1	2									PROJECT					(TSQ B)															
	DATE	2021/6/21	2021/12/15	2022/11/8									Van Phong 1 BOT Thermal Power Plant Project 2×673MW																				
	CONTENTS	1st Issue	Revised (0015)	Revised (0047, 0065)									TITLE					DRAWING No.					SH		REV. MARK								
													TBFP SERV OUT MA (T+T->T) (SEQ-M)					4GCH01007					TM483A		2								
	Equipment No. : -																																

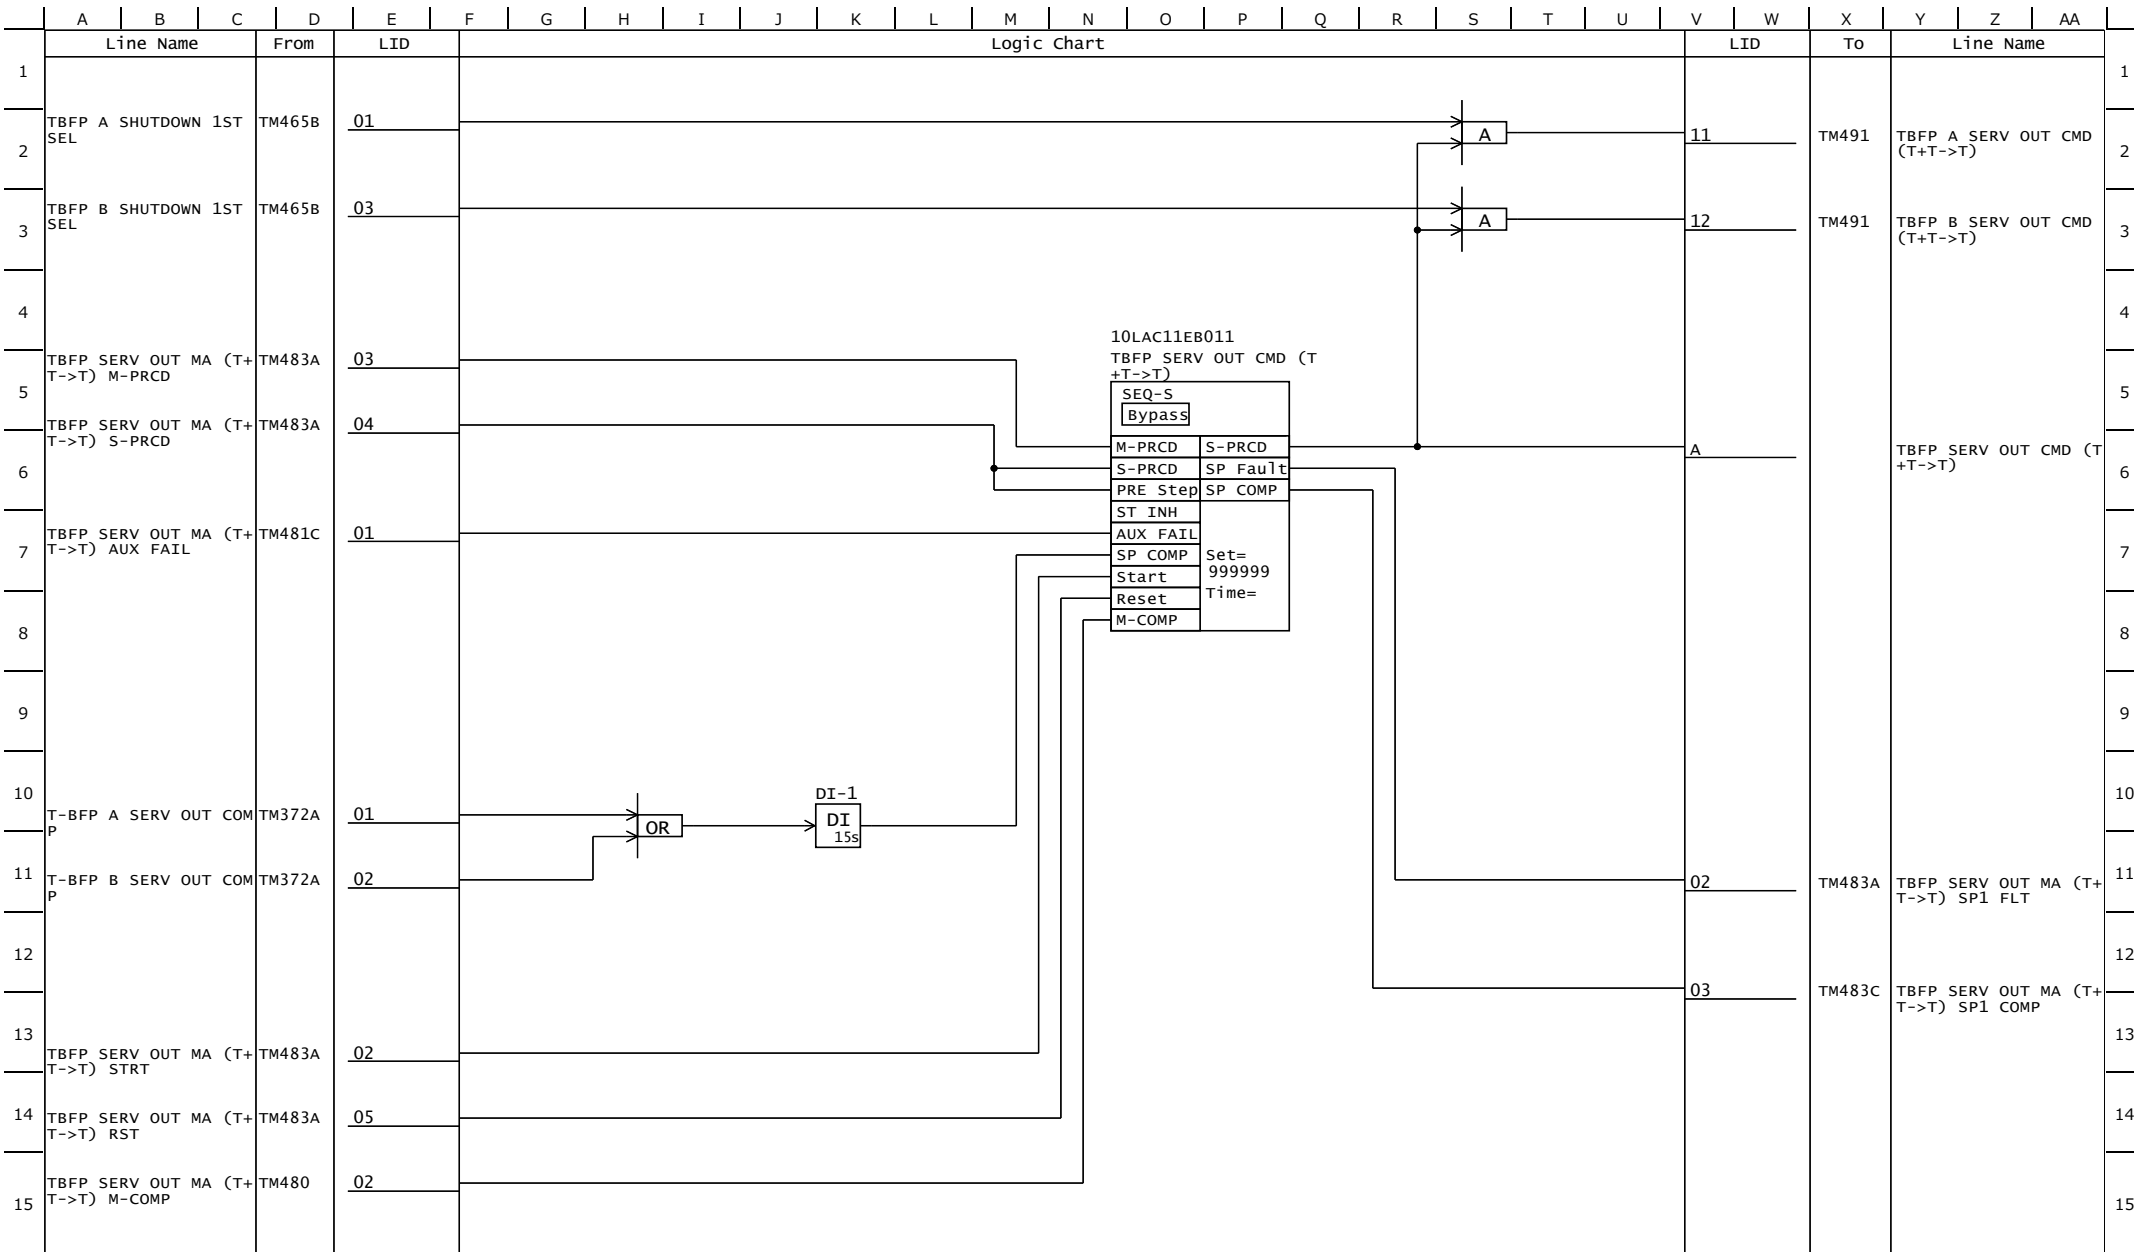


Rev. No.	0	1						PROJECT Van Phong 1 BOT Thermal Power Plant Project 2×673MW	(TSQ B)		
DATE	2021/6/21	2021/12/15									
CONTENTS	1st Issue	Revised (0015, 0024)						TITLE	DRAWING No.	SH	REV. MARK
								TBFP SERV OUT MA (T+T->T) (SEQ-S1)	4GCH01007	TM483B	1
								Equipment No. : -			

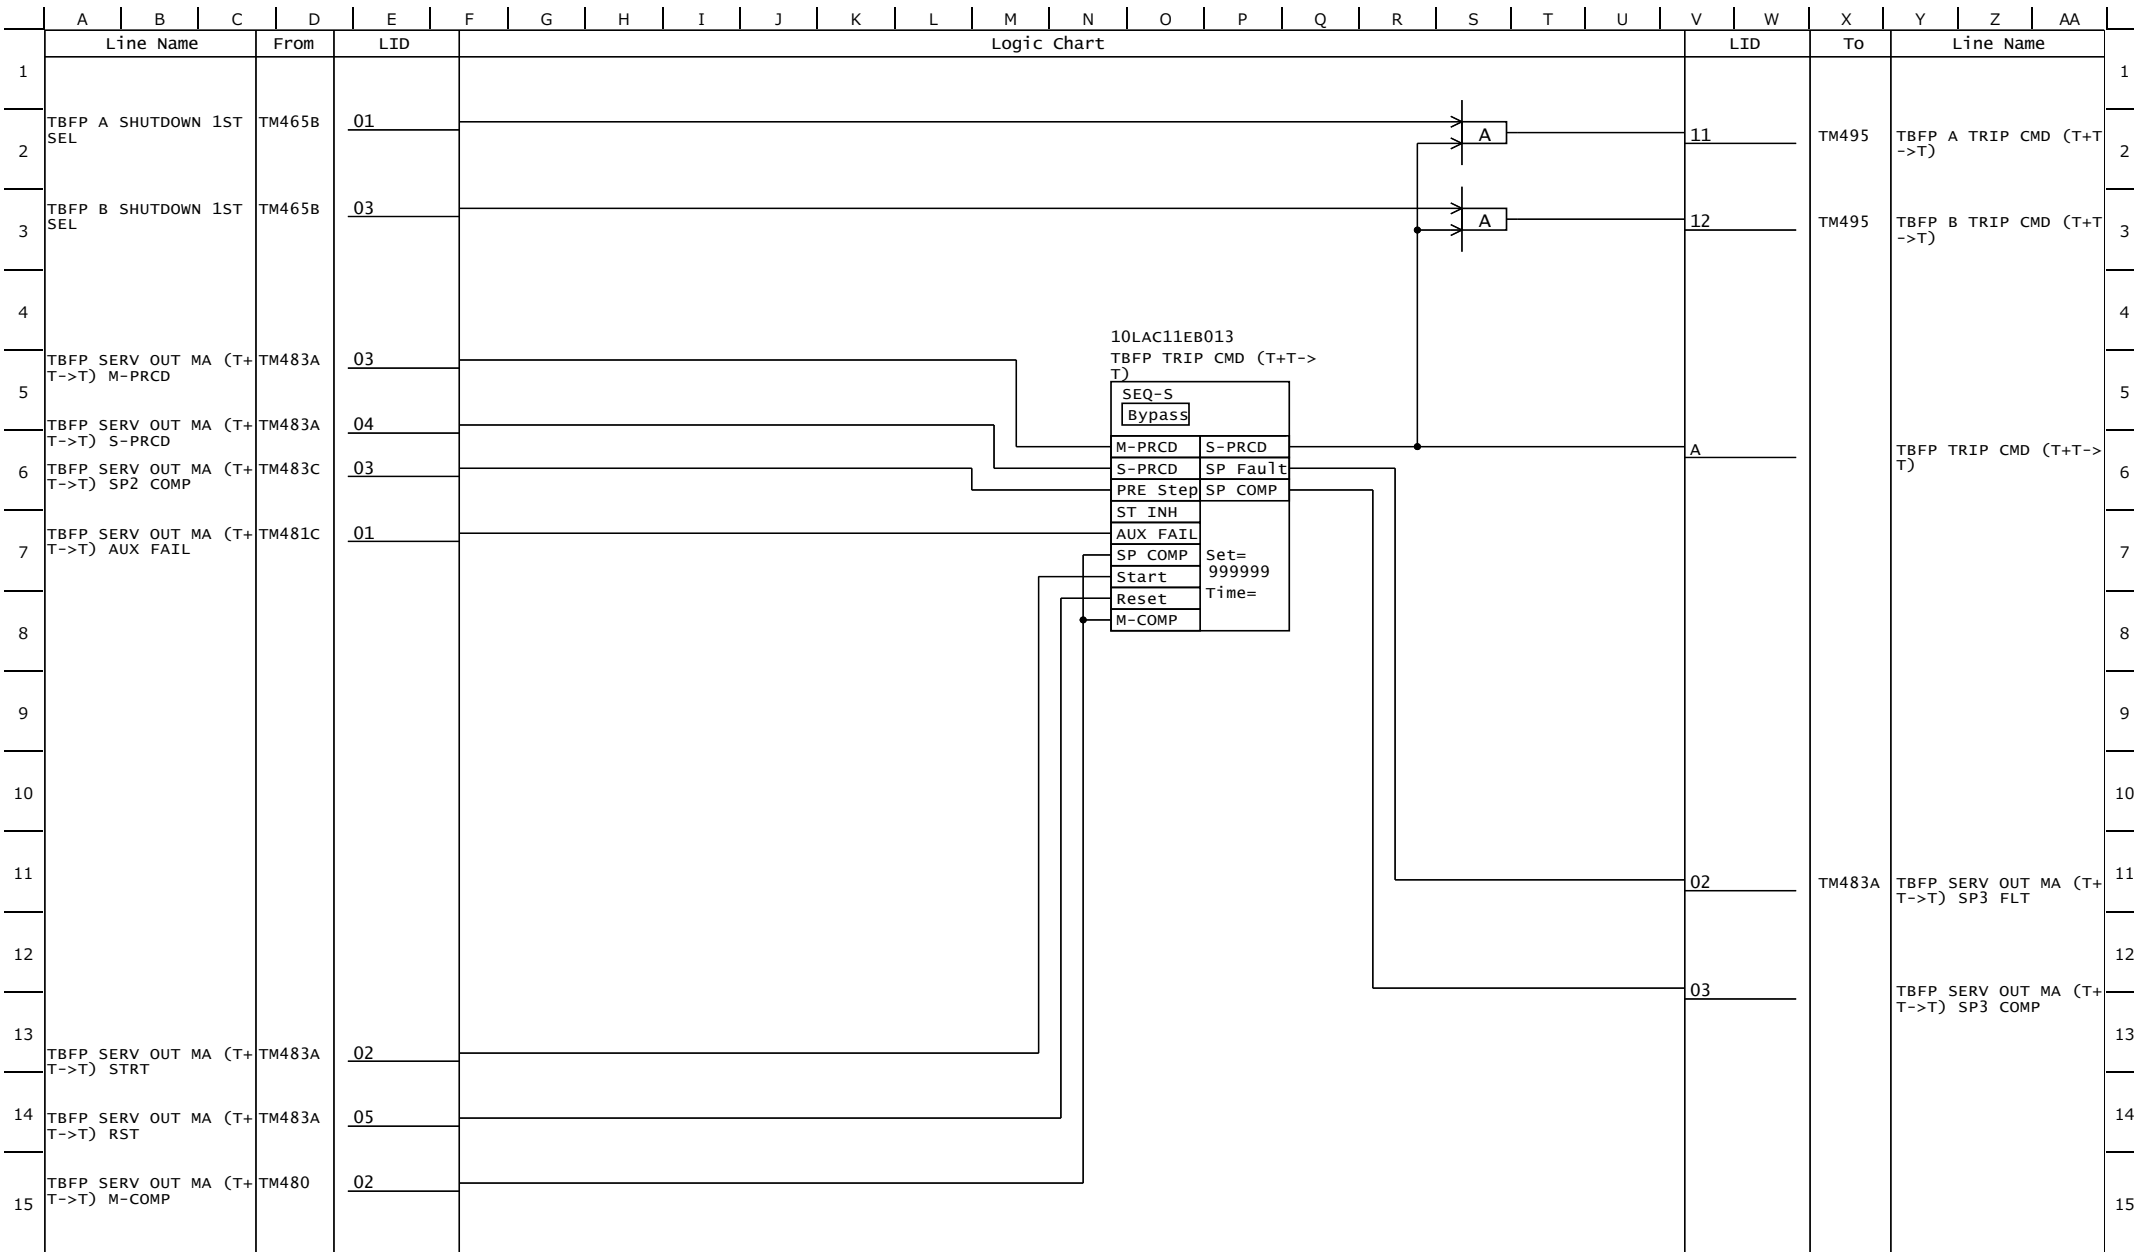

Rev. No.	0	1						PROJECT Van Phong 1 BOT Thermal Power Plant Project 2×673MW	(TSQ B)		
DATE	2021/6/21	2021/12/15									
CONTENTS	1st Issue	Revised (0015)						TITLE	DRAWING No.	SH	REV. MARK
								TBFP SERV OUT MA (T+T->T) (SEQ-S3)	4GCH01007	TM483D	1
								Equipment No. : -			

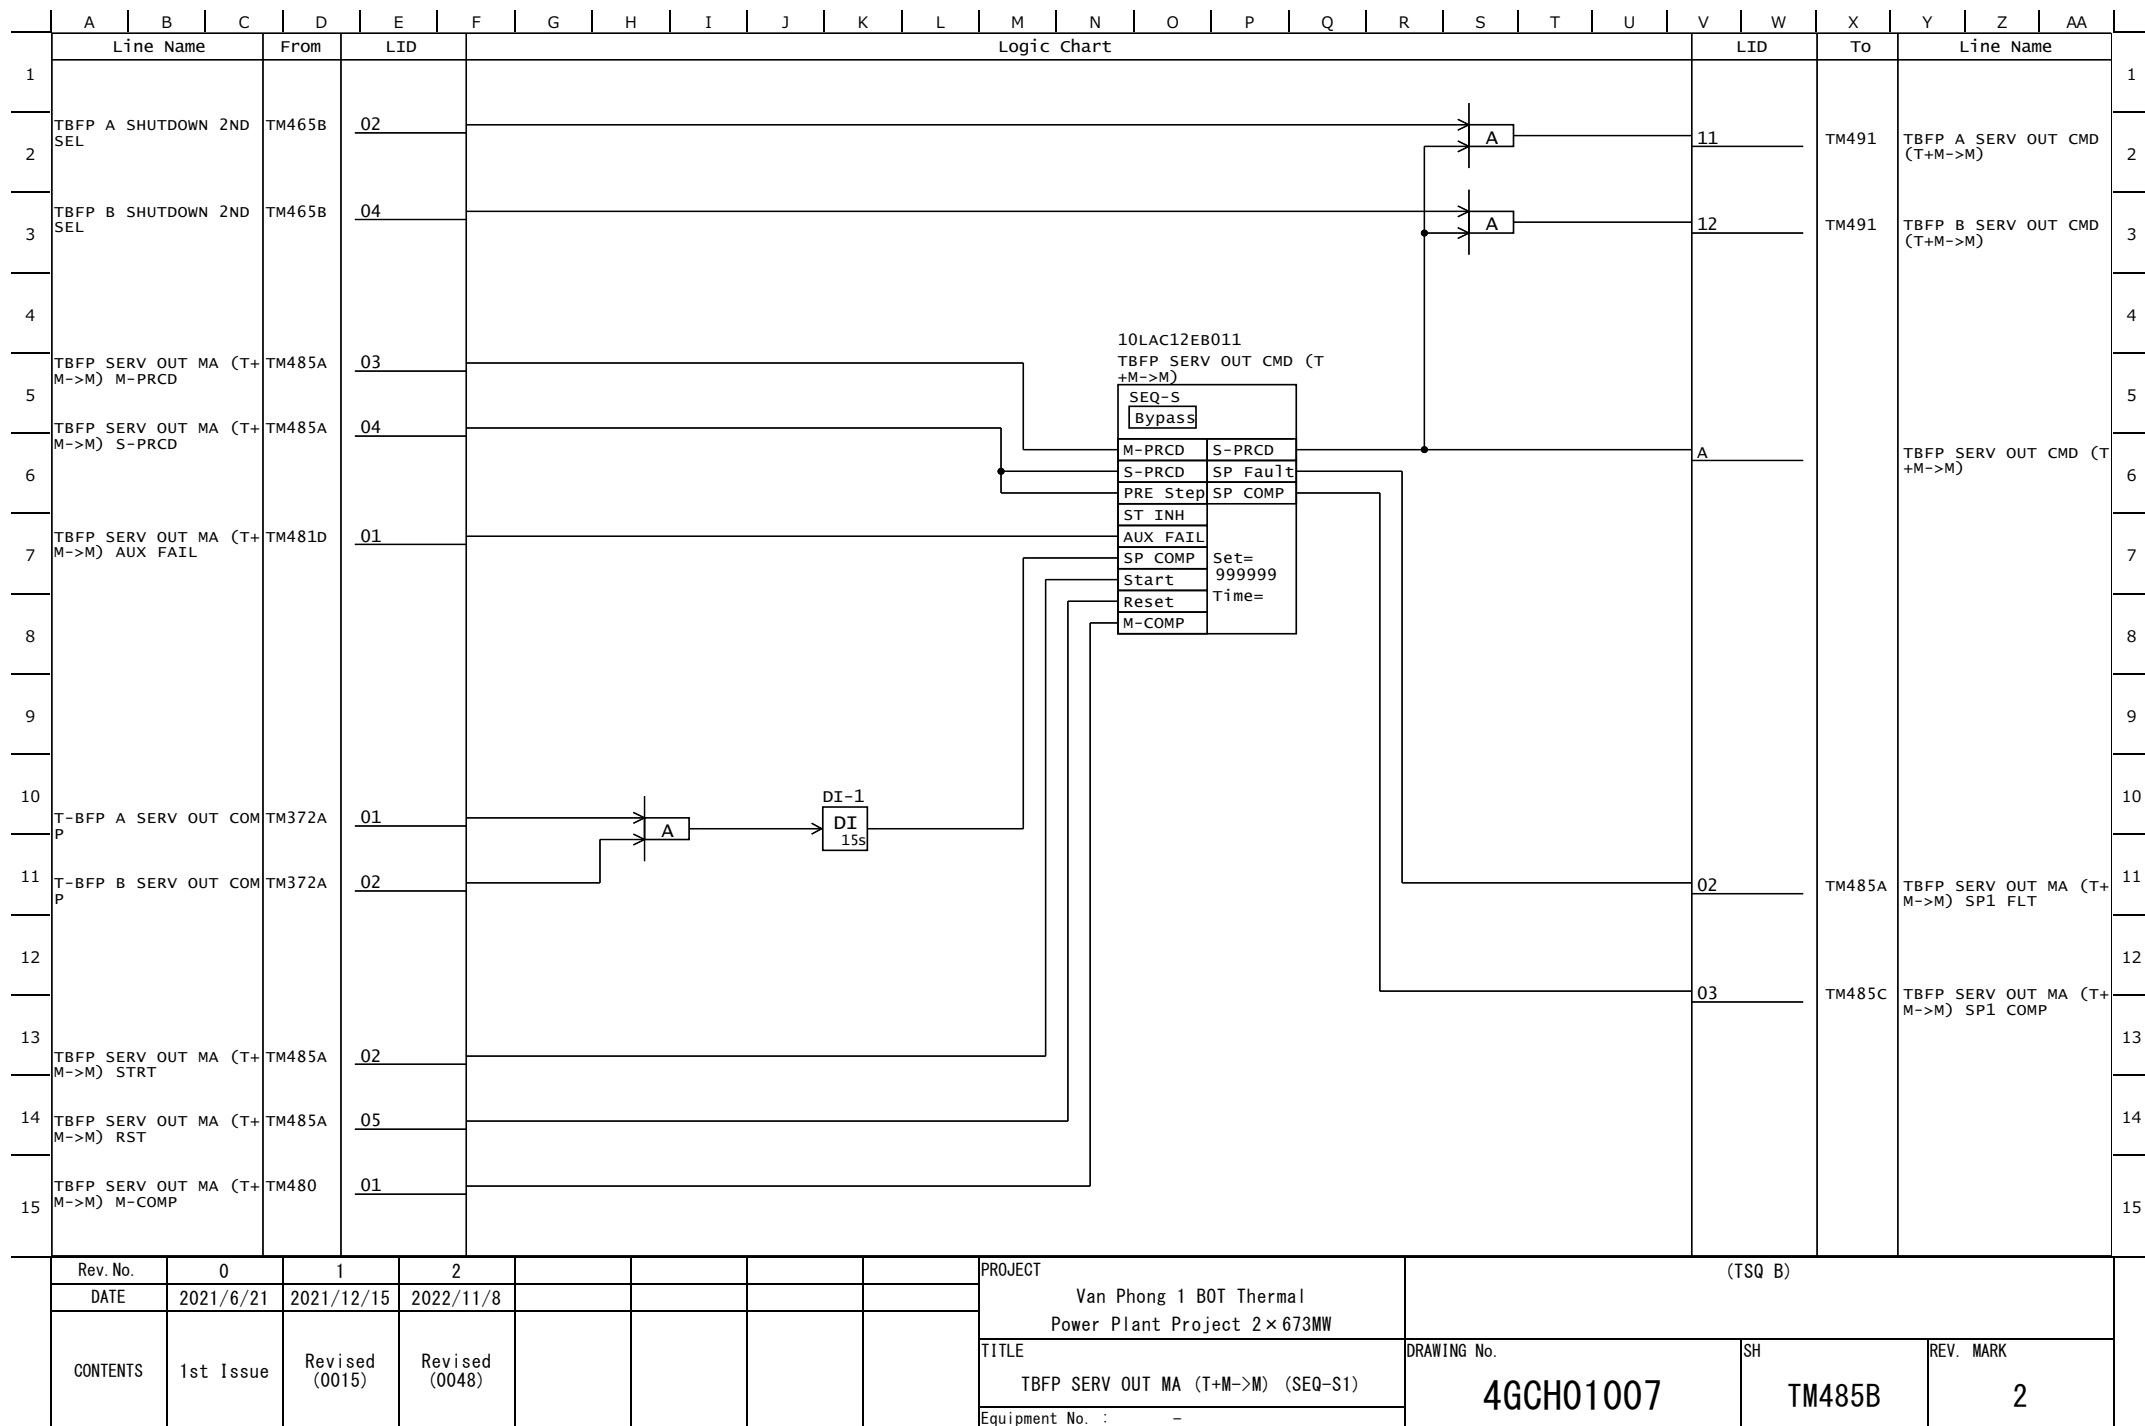


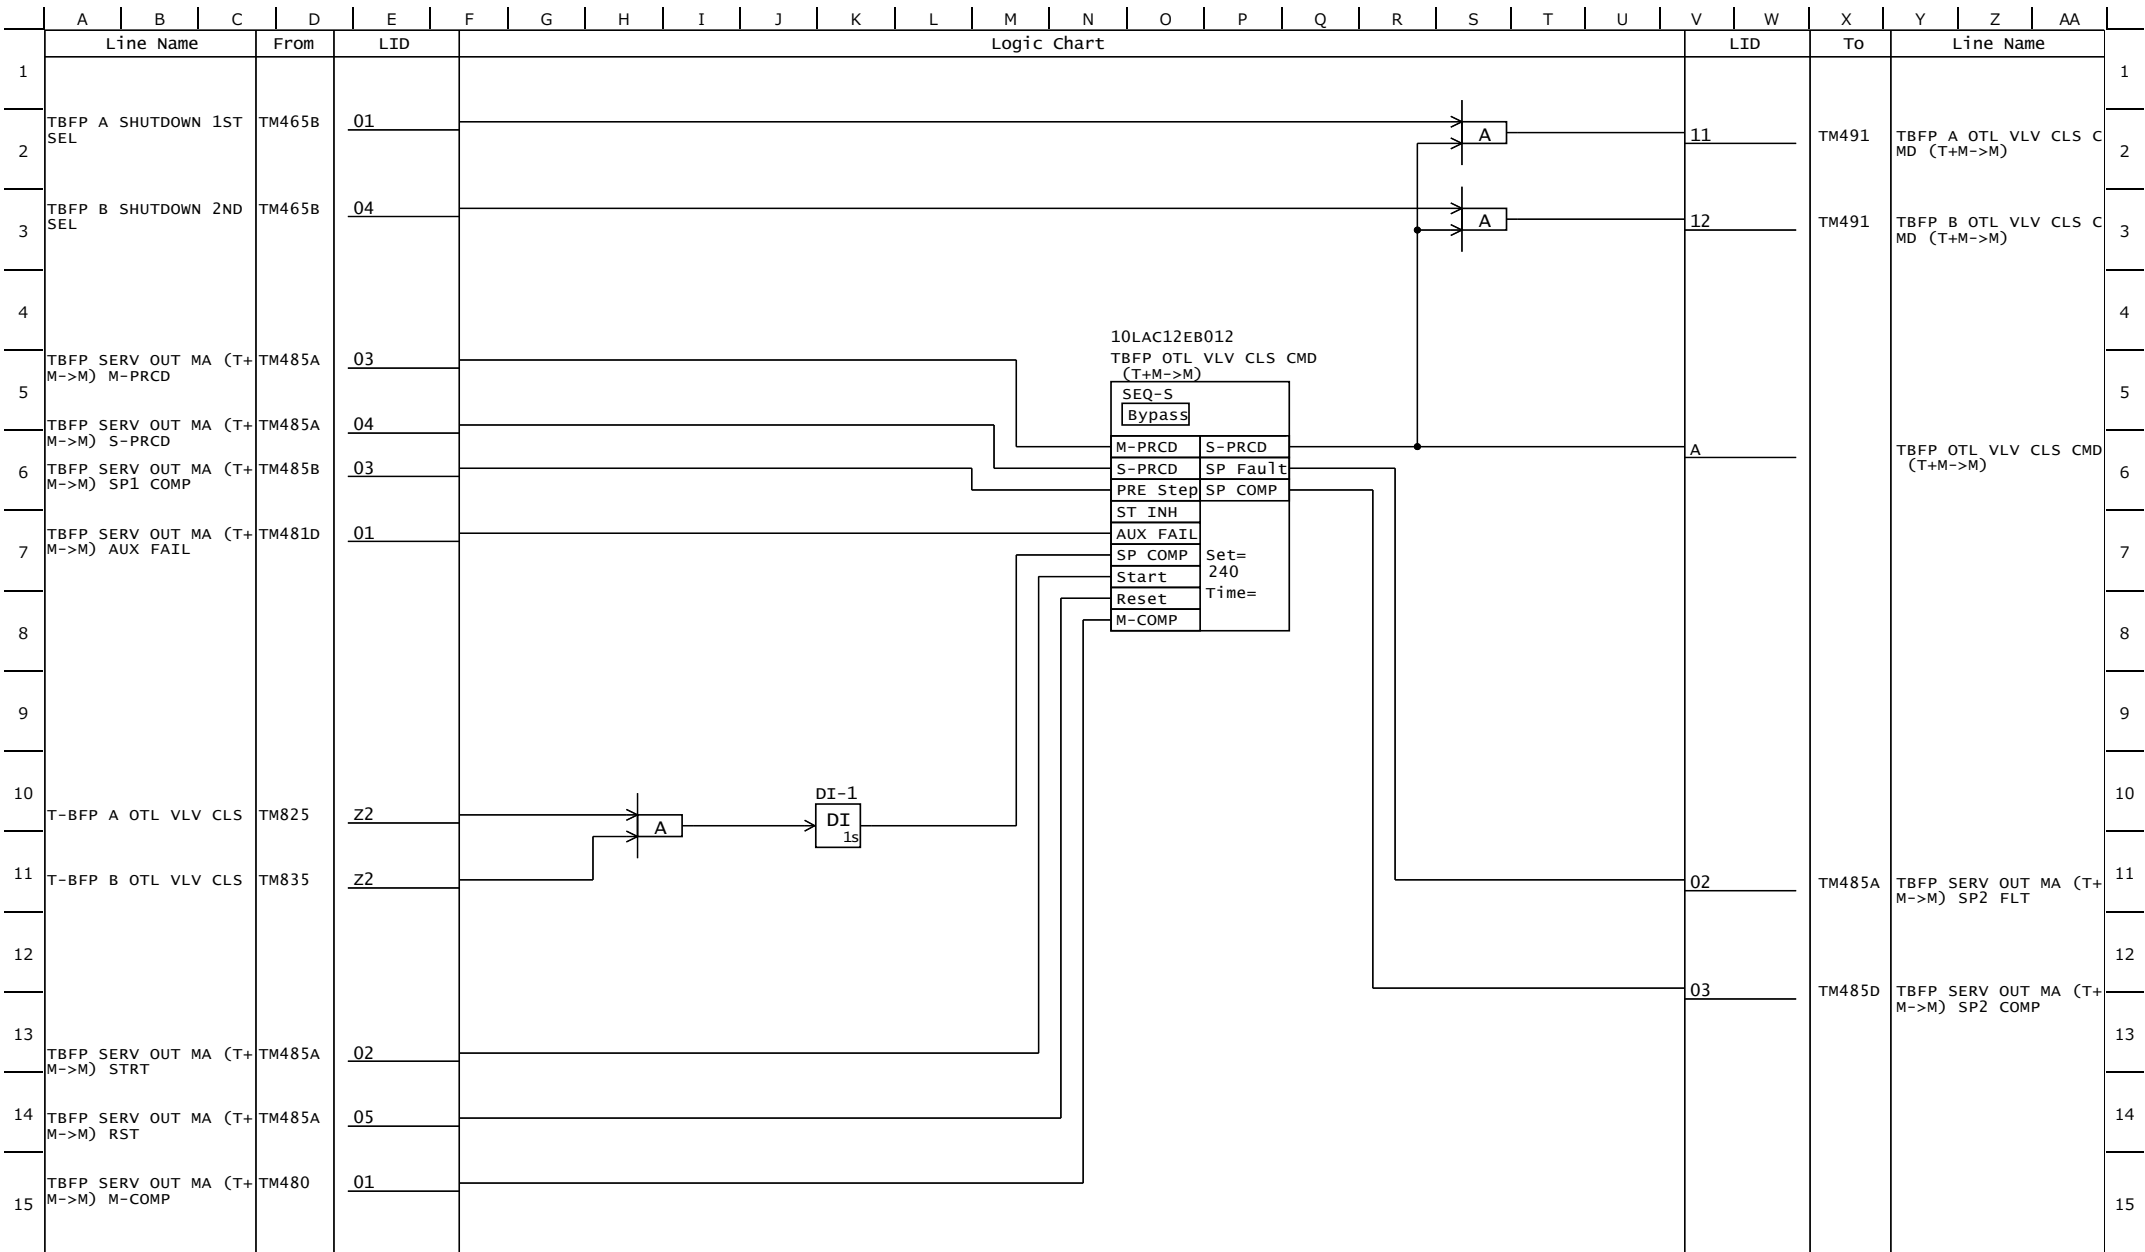



Rev. No.	0	1							PROJECT	Van Phong 1 BOT Thermal Power Plant Project 2×673MW				(TSQ B)			
DATE	2021/6/21	2021/12/15							TITLE	TBFP SERV OUT MA (T+M->M) (SEQ-S2)				DRAWING No.			
CONTENTS	1st Issue	Revised (0015, 0026)							Equipment No. :	-				4GCH01007			
														SH		REV. MARK	
														TM485C		1	


	A	B	C	D	E	F	G	H	I	J	K	L	M	N	O	P	Q	R	S	T	U	V	W	X	Y	Z	AA	
	Line Name			From	LID	Logic Chart																	LID	To	Line Name			
1																												1
2	TBFP A SHUTDOWN 2ND SEL			TM465B	02																		11	TM495	TBFP A TRIP CMD (T+M->M)			2
3	TBFP B SHUTDOWN 2ND SEL			TM465B	04																		12	TM495	TBFP B TRIP CMD (T+M->M)			3
4																												4
5	TBFP SERV OUT MA (T+M->M) M-PRCD			TM485A	03																							5
6	TBFP SERV OUT MA (T+M->M) S-PRCD			TM485A	04																							6
7	TBFP SERV OUT MA (T+M->M) SP2 COMP			TM485C	03																							7
8	TBFP SERV OUT MA (T+M->M) AUX FAIL			TM481D	01																							8
9																												9
10																												10
11																							02	TM485A	TBFP SERV OUT MA (T+M->M) SP3 FLT			11
12																							03		TBFP SERV OUT MA (T+M->M) SP3 COMP			12
13	TBFP SERV OUT MA (T+M->M) STRT			TM485A	02																							13
14	TBFP SERV OUT MA (T+M->M) RST			TM485A	05																							14
15	TBFP SERV OUT MA (T+M->M) M-COMP			TM480	01																							15

Rev. No.	0	1							PROJECT					(TSQ B)									
									Van Phong 1 BOT Thermal														
									Power Plant Project 2×673MW														
CONTENTS	1st Issue	Revised (0015)							TITLE					DRAWING No.					SH		REV. MARK		
									TBFP SERV OUT MA (T+M->M) (SEQ-S3)					4GCH01007					TM485D		1		
									Equipment No. : -														

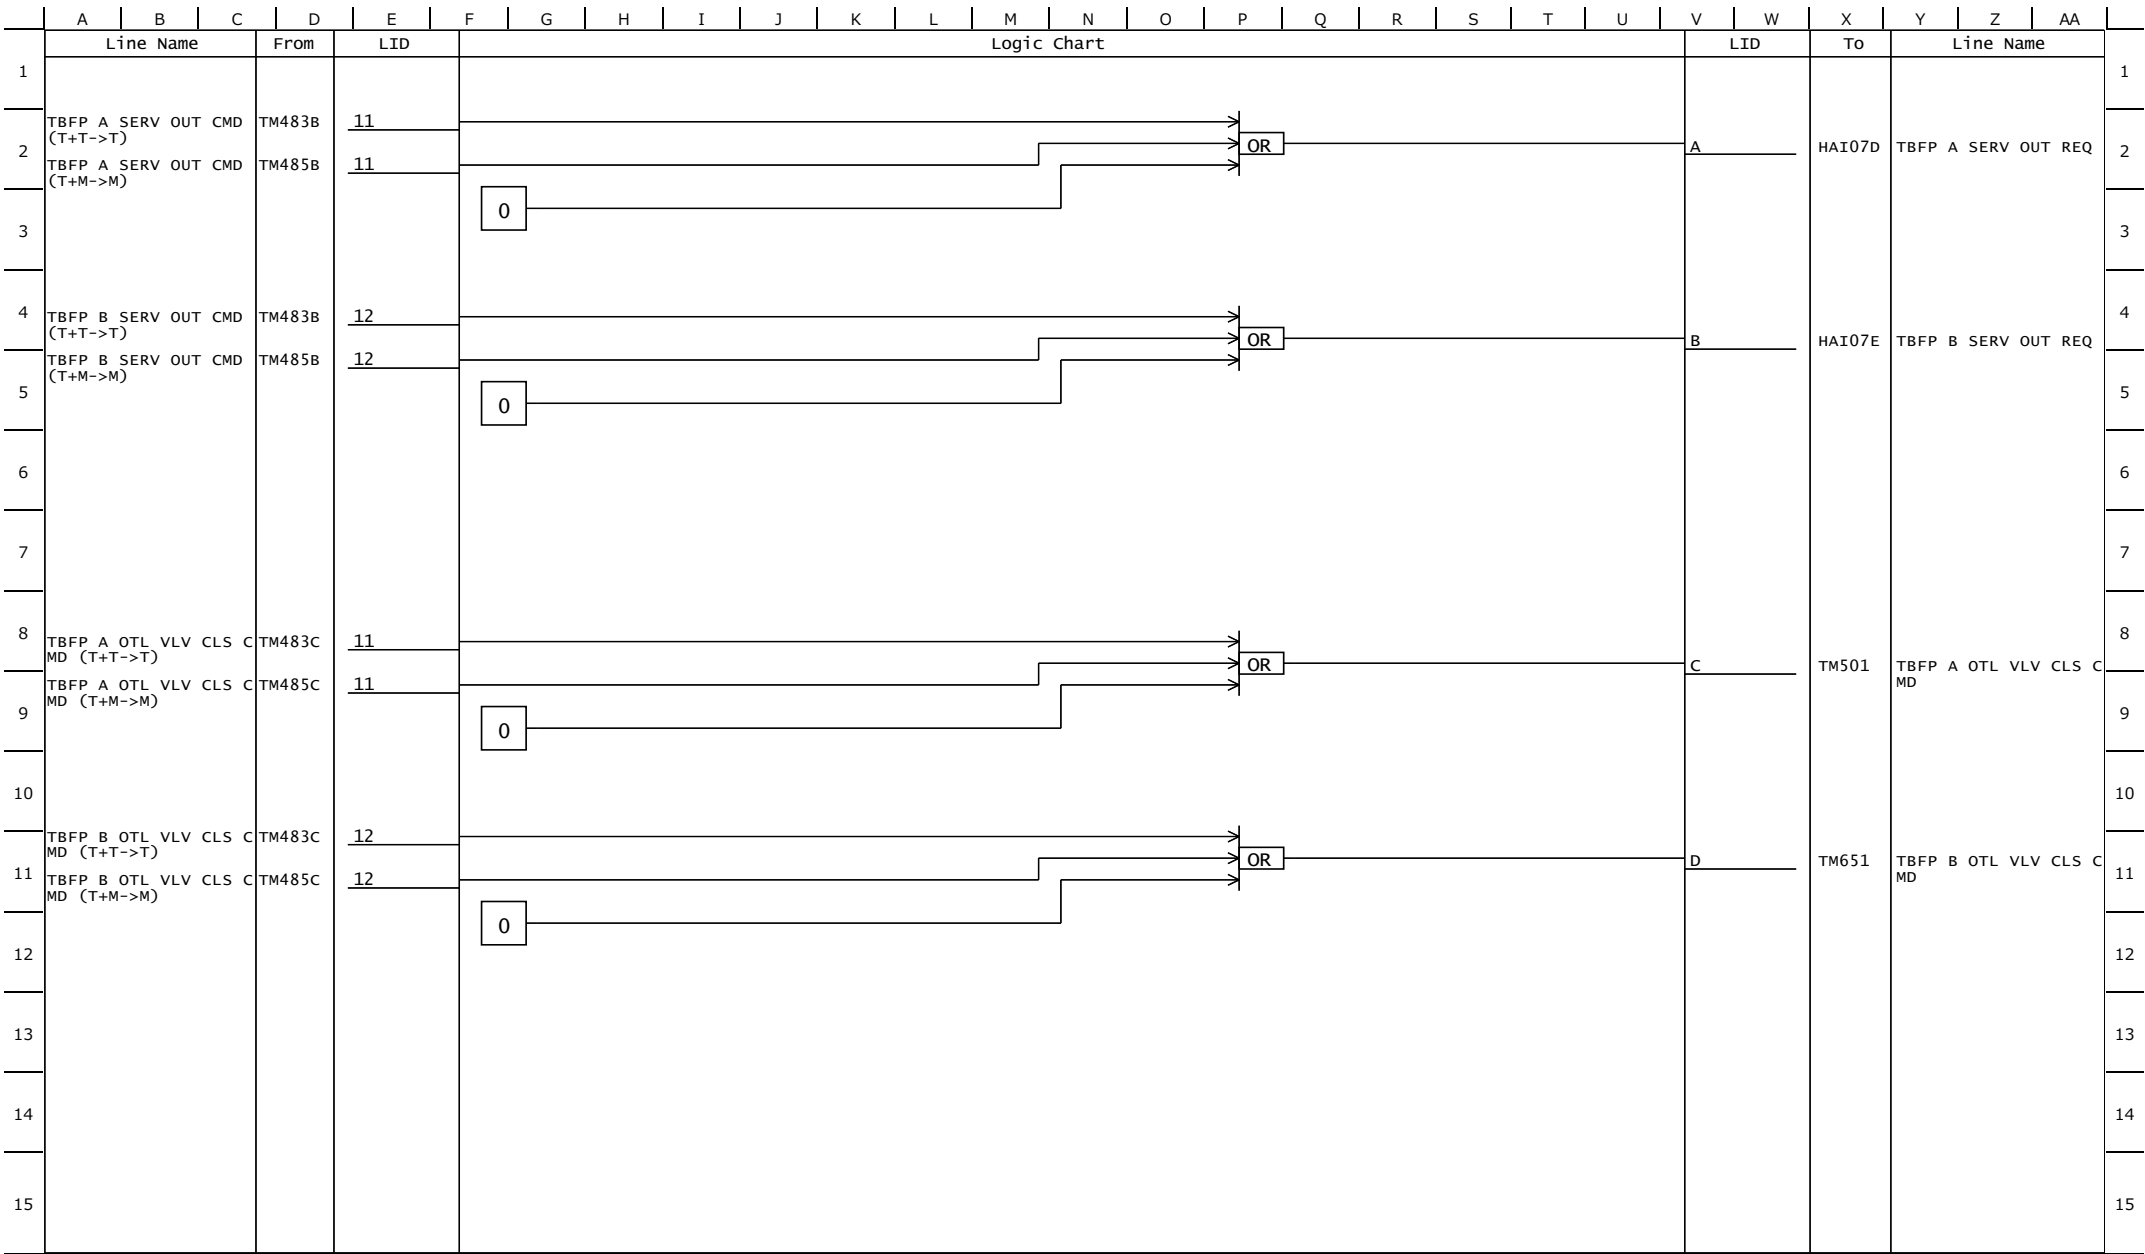

Rev. No.	0	1						PROJECT	(TSQ B)			
DATE	2021/6/21	2021/12/15						Van Phong 1 BOT Thermal Power Plant Project 2×673MW				
CONTENTS	1st Issue	Revised (0015)						TITLE	DRAWING No.	SH	REV. MARK	
								TBFP SERV OUT CMD	4GCH01007	TM491	1	
								Equipment No. : -				

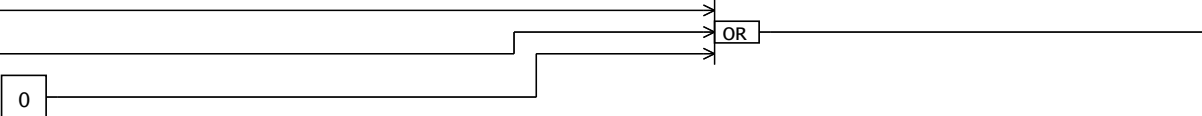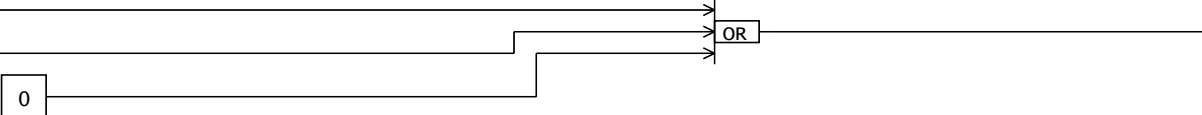	A	B	C	D	E	F	G	H	I	J	K	L	M	N	O	P	Q	R	S	T	U	V	W	X	Y	Z	AA	
	Line Name			From	LID	Logic Chart																	LID	To	Line Name			
1																												1
2	TBFP A TRIP CMD (T+T->T) TBFP A TRIP CMD (T+M->M)			TM483D	11																		01	TM501	BFPT A NORM STP CMD			2
3																							0					
4	TBFP B TRIP CMD (T+T->T) TBFP B TRIP CMD (T+M->M)			TM483D	12																		02	TM651	BFPT B NORM STP CMD			4
5																							0					
6																												6
7																												7
8																												8
9																												9
10																												10
11																												11
12																												12
13																												13
14																												14
15																												15
Rev. No.		0		1										PROJECT		(TSQ B)												
DATE		2021/6/21		2021/12/15										Van Phong 1 BOT Thermal Power Plant Project 2×673MW														
CONTENTS		1st Issue		Revised (0015)										TITLE BFPT TRIP CMD		DRAWING No.				SH		REV. MARK						
														Equipment No. : -		4GCH01007				TM495		1						

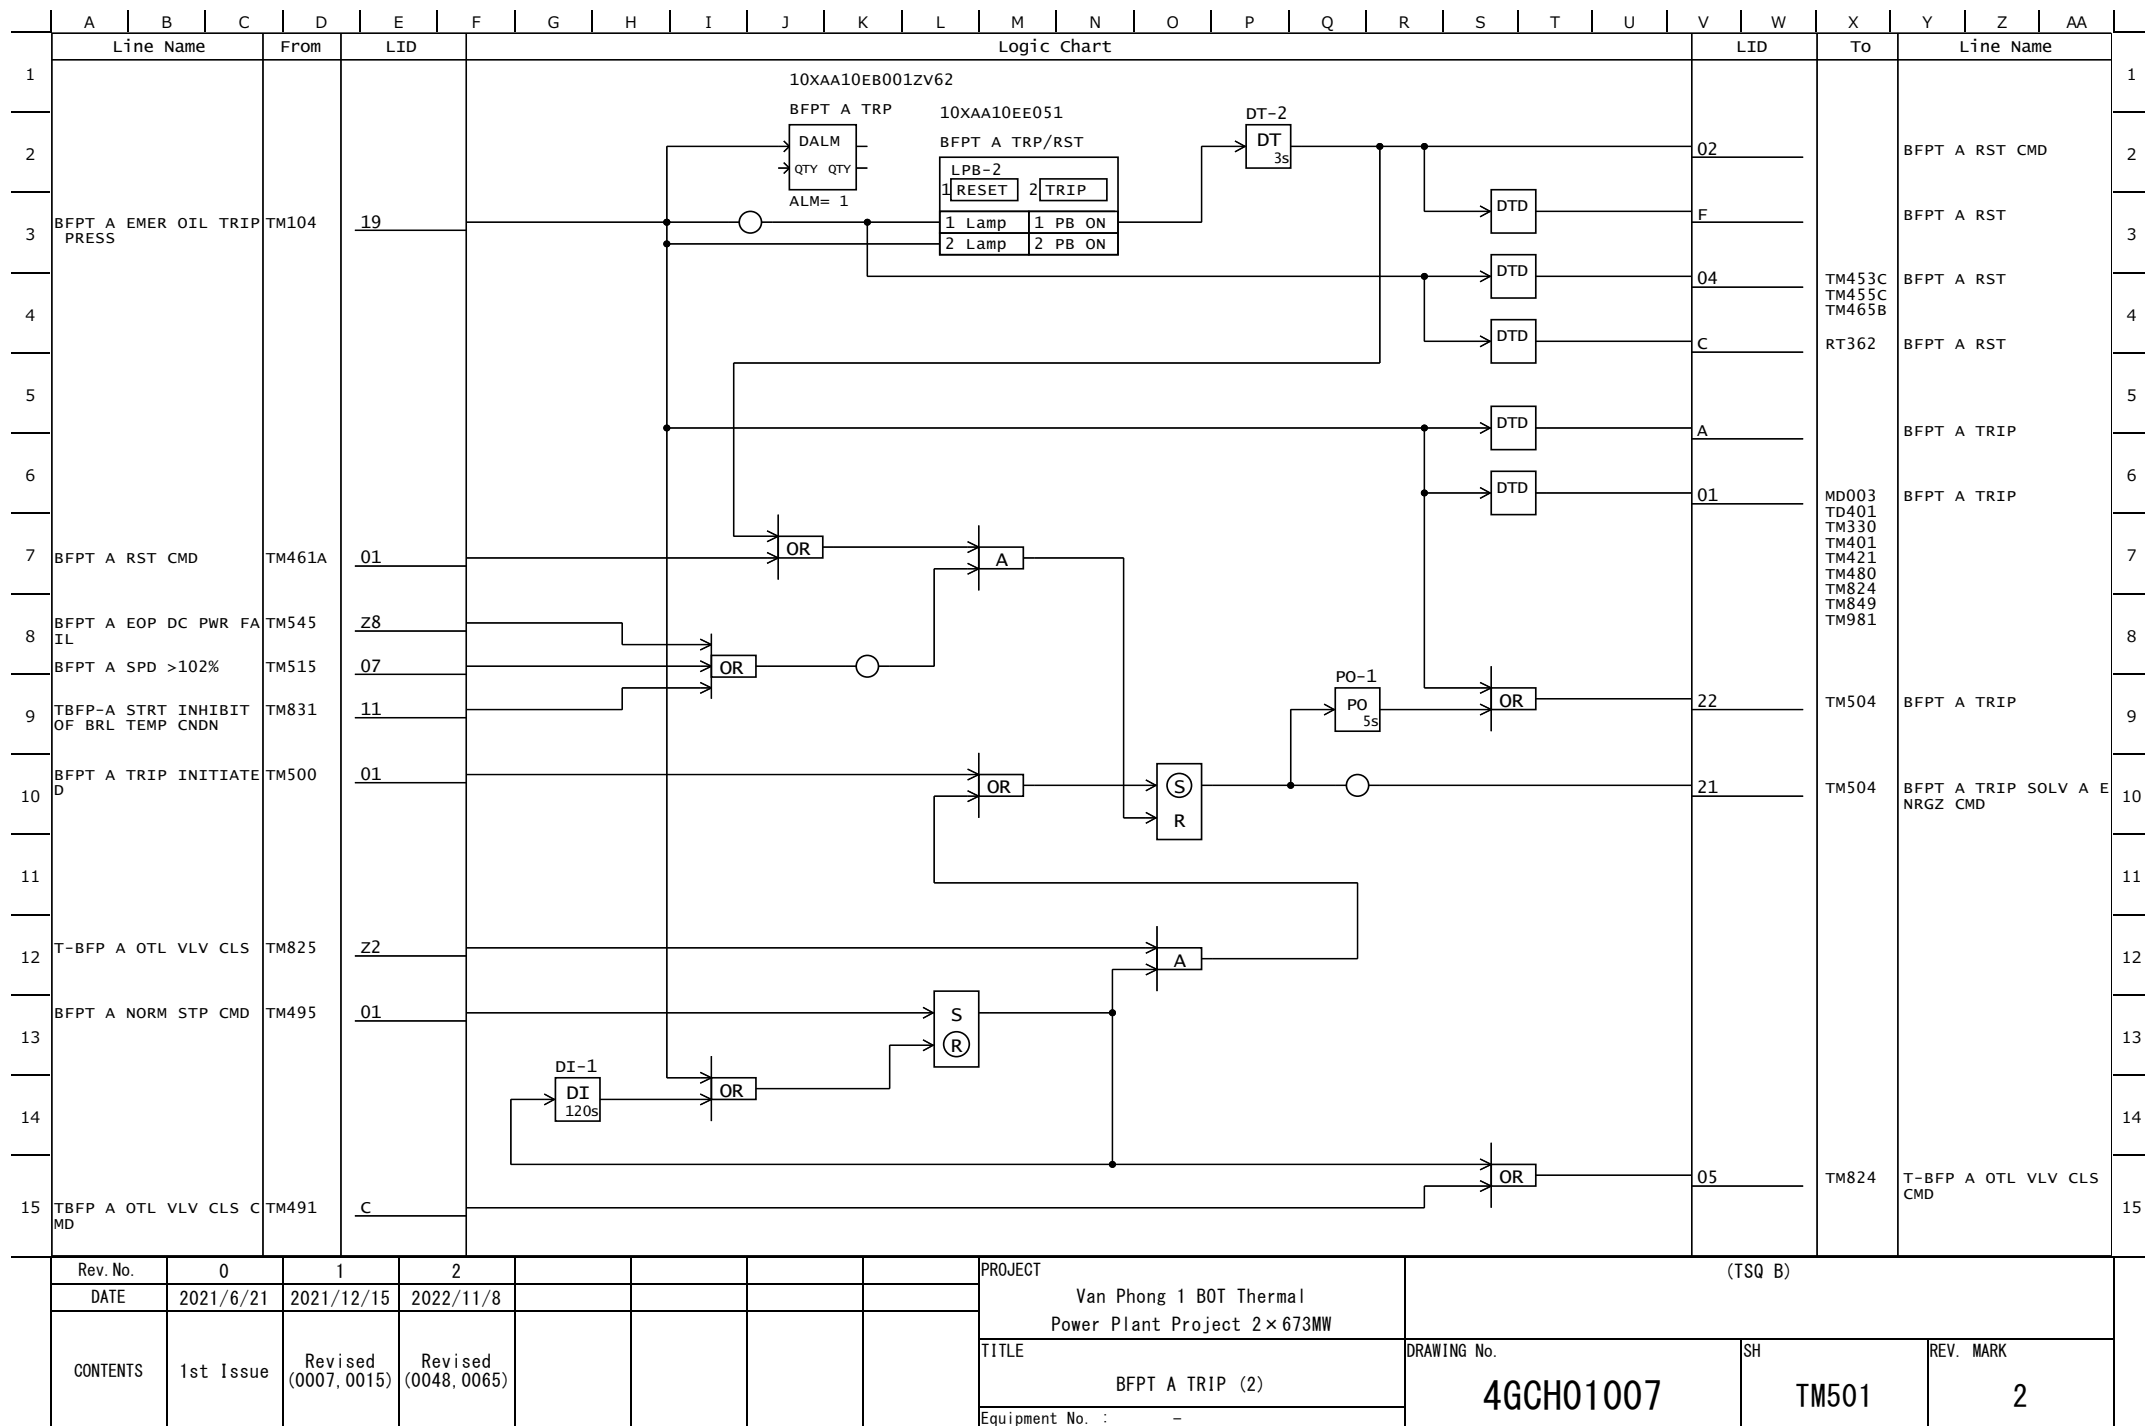

	A	B	C	D	E	F	G	H	I	J	K	L	M	N	O	P	Q	R	S	T	U	V	W	X	Y	Z	AA
	Line Name			From	LID	Logic Chart																	LID	To	Line Name		
1	BFPT A MSV TRIP SOLV A1 ENRGZ CMD BFPT A MSV TRIP SOLV A1 ENRGZ CMD BFPT A MSV TRIP SOLV A2 ENRGZ CMD BFPT A MSV TRIP SOLV A2 ENRGZ CMD BFPT A MSV TRIP SOLV B1 ENRGZ CMD BFPT A MSV TRIP SOLV B1 ENRGZ CMD BFPT A MSV TRIP SOLV B2 ENRGZ CMD BFPT A MSV TRIP SOLV B2 ENRGZ CMD			TSQ-B (TM504)	A	(10XAX11AA659) BFPT A MSV TRIP SOLV A1 ENERGIZE DE-ENERGIZED (10XAX11AA661) BFPT A MSV TRIP SOLV A2 ENERGIZE DE-ENERGIZED (10XAX11AA663) BFPT A MSV TRIP SOLV B1 ENERGIZE DE-ENERGIZED (10XAX11AA665) BFPT A MSV TRIP SOLV B2 ENERGIZE DE-ENERGIZED 10XAX11AA601 BFPT A MSV TRIP VALVE OPERATE RESET 10XAA10AA601 BFPT A MSV CLOSE																					
2																											
3																											
NOTE:


HYDRAULIC

TBL-1

SOV	
POWER	DC24V
FAIL ACT	CLOSE
NOTE	-




Rev.No.	0	1	2					PROJECT	LOCAL						
DATE	2021/6/21	2021/12/15	2022/11/8					Van Phong 1 BOT Thermal Power Plant Project 2x673MW							
CONTENTS	1st Issue	Revised	Revised (0062)					TITLE				DRAWING No.		SH	REV. MARK
								BFPT A MSV				4GCH01007		TM502	2
								Equipment No. : 10MAA10AA601							


	A	B	C	D	E	F	G	H	I	J	K	L	M	N	O	P	Q	R	S	T	U	V	W	X	Y	Z	AA	
	Line Name			From	LID	Logic Chart																	LID	To	Line Name			
1	BFPT A MAN TRIP PB (CCR)			TM261	Y4	10CWA10EA008ZV62 BFPT A MAN TRIP PB (CCR) DALM QTY QTY ALM= 1																	01	TM500	BFPT A MAN TRIP PB			1
2																												2
3																												3
4																												4
5																												5
6																												6
7																												7
8																												8
9																												9
10																												10
11																												11
12																												12
13																												13
14																												14
15																												15
Rev. No.				0	1	2					PROJECT				(TSQ B)													
DATE				2021/6/21	2021/12/15	2022/11/8					Van Phong 1 BOT Thermal Power Plant Project 2×673MW																	
CONTENTS				1st Issue	Revised (0007)	Revised & Tuning (0064)					TITLE				DRAWING No.				SH		REV. MARK							
											BFPT A TRIP (3)				4GCH01007				TM503		2							
											Equipment No. : -																	

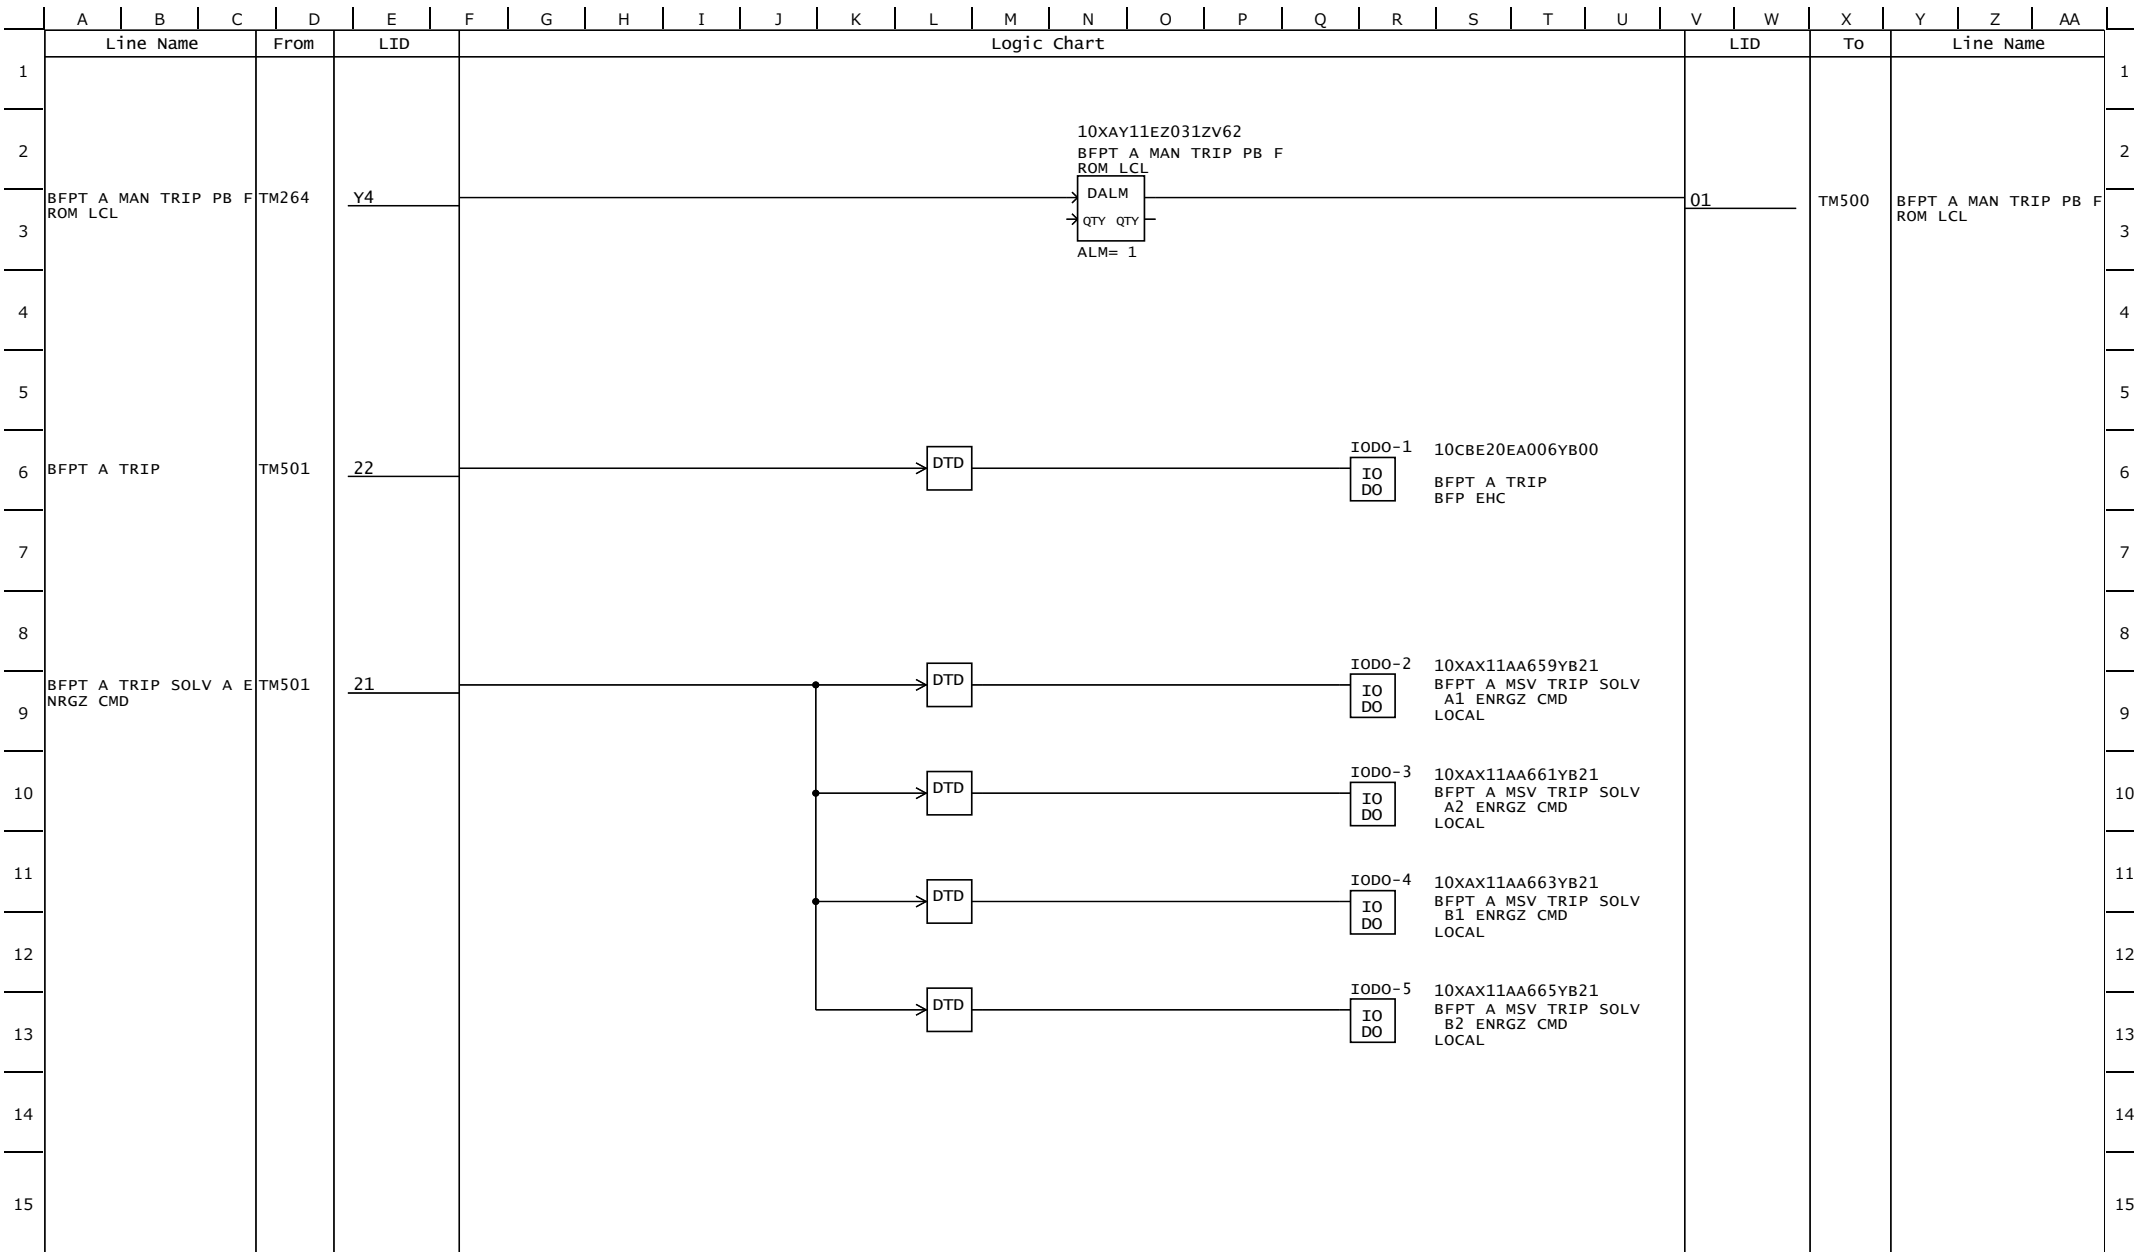

Rev. No.	0	1	2					PROJECT	(TSQ B)			
DATE	2021/6/21	2021/12/15	2022/11/8					Van Phong 1 BOT Thermal Power Plant Project 2×673MW				
CONTENTS	1st Issue	Revised (0007, 0015)	Revised & Tuning (0062, 0064)					TITLE	DRAWING No.	SH	REV. MARK	
								BFPT A TRIP (4)	4GCH01007	TM504	2	
								Equipment No. : -				


	A	B	C	D	E	F	G	H	I	J	K	L	M	N	O	P	Q	R	S	T	U	V	W	X	Y	Z	AA					
	Line Name			From	LID	Logic Chart																	LID	To	Line Name							
1	BFPT A SPD A BFPT A SPD B BFPT A SPD C			TM175	Y1 Y2 Y3																		01		BFPT A SPD							
2																												0 7200 rpm	02	BFPT EHC A BUG OPERA TED		
3																												0 7200 rpm				
4																												0 7200 rpm				
5																																
6																																
7																																
8																																
9																																
10																																
11																																
12																																
13																																
14																																
15																																
Rev.No.		0	1	2	3				PROJECT										(BFPT A EHC)													
DATE		2021/6/21	2021/12/15	2022/11/8	2023/7/5				Van Phong 1 BOT Thermal Power Plant Project 2x673MW																							
CONTENTS		1st Issue	Revised	Revised (0062)	Revised				TITLE										DRAWING No.				SH	REV. MARK								
									BFPT A TRIP (7)										4GCH01007				TM507	3								
									Equipment No. : -																							

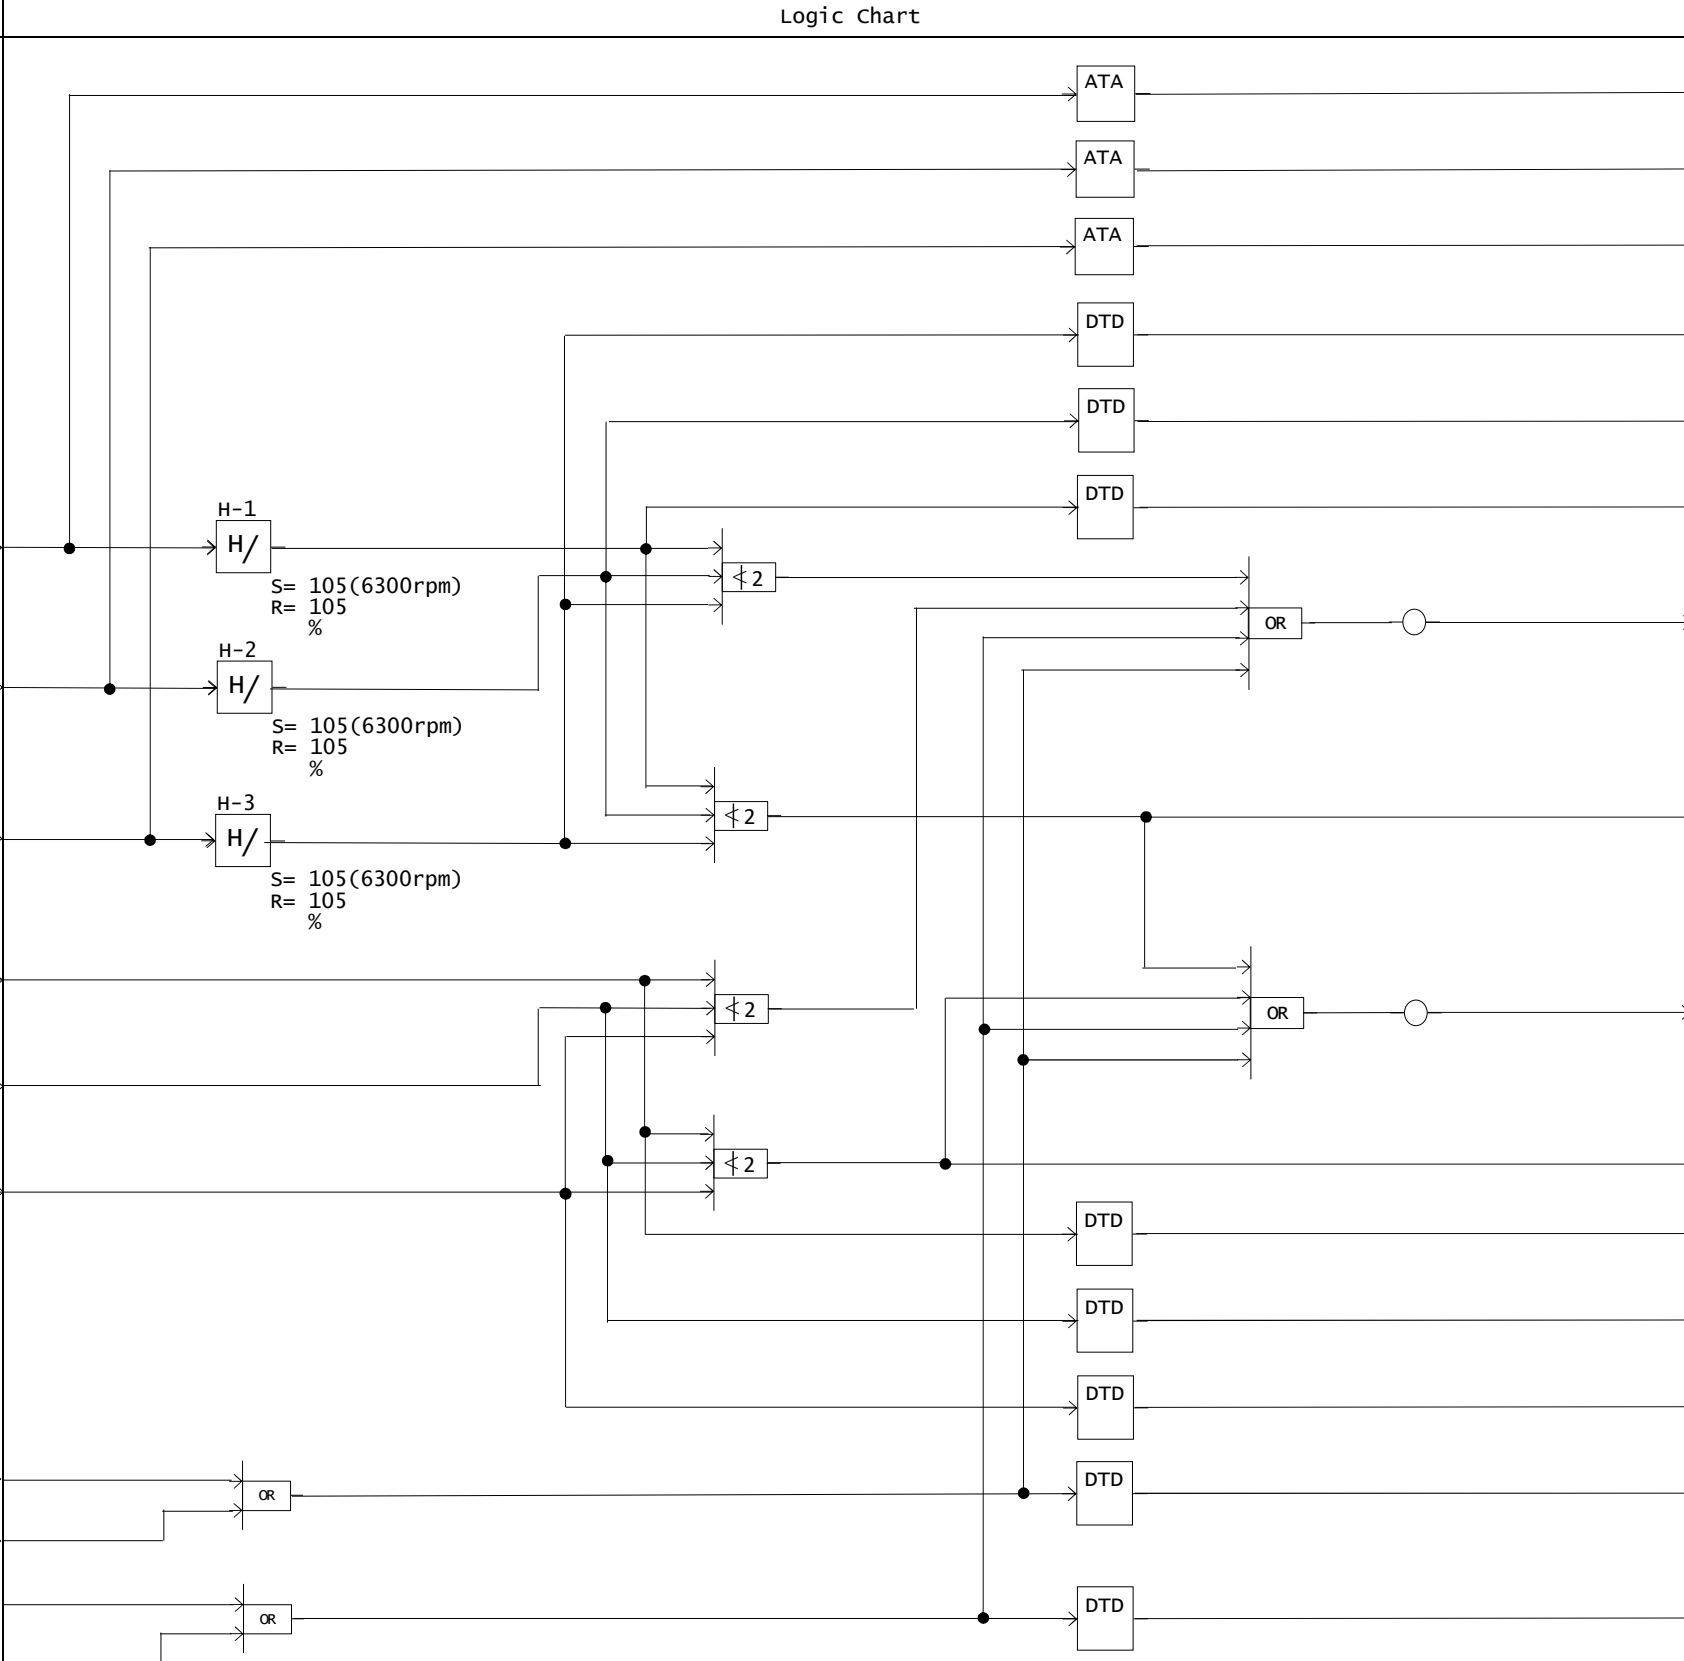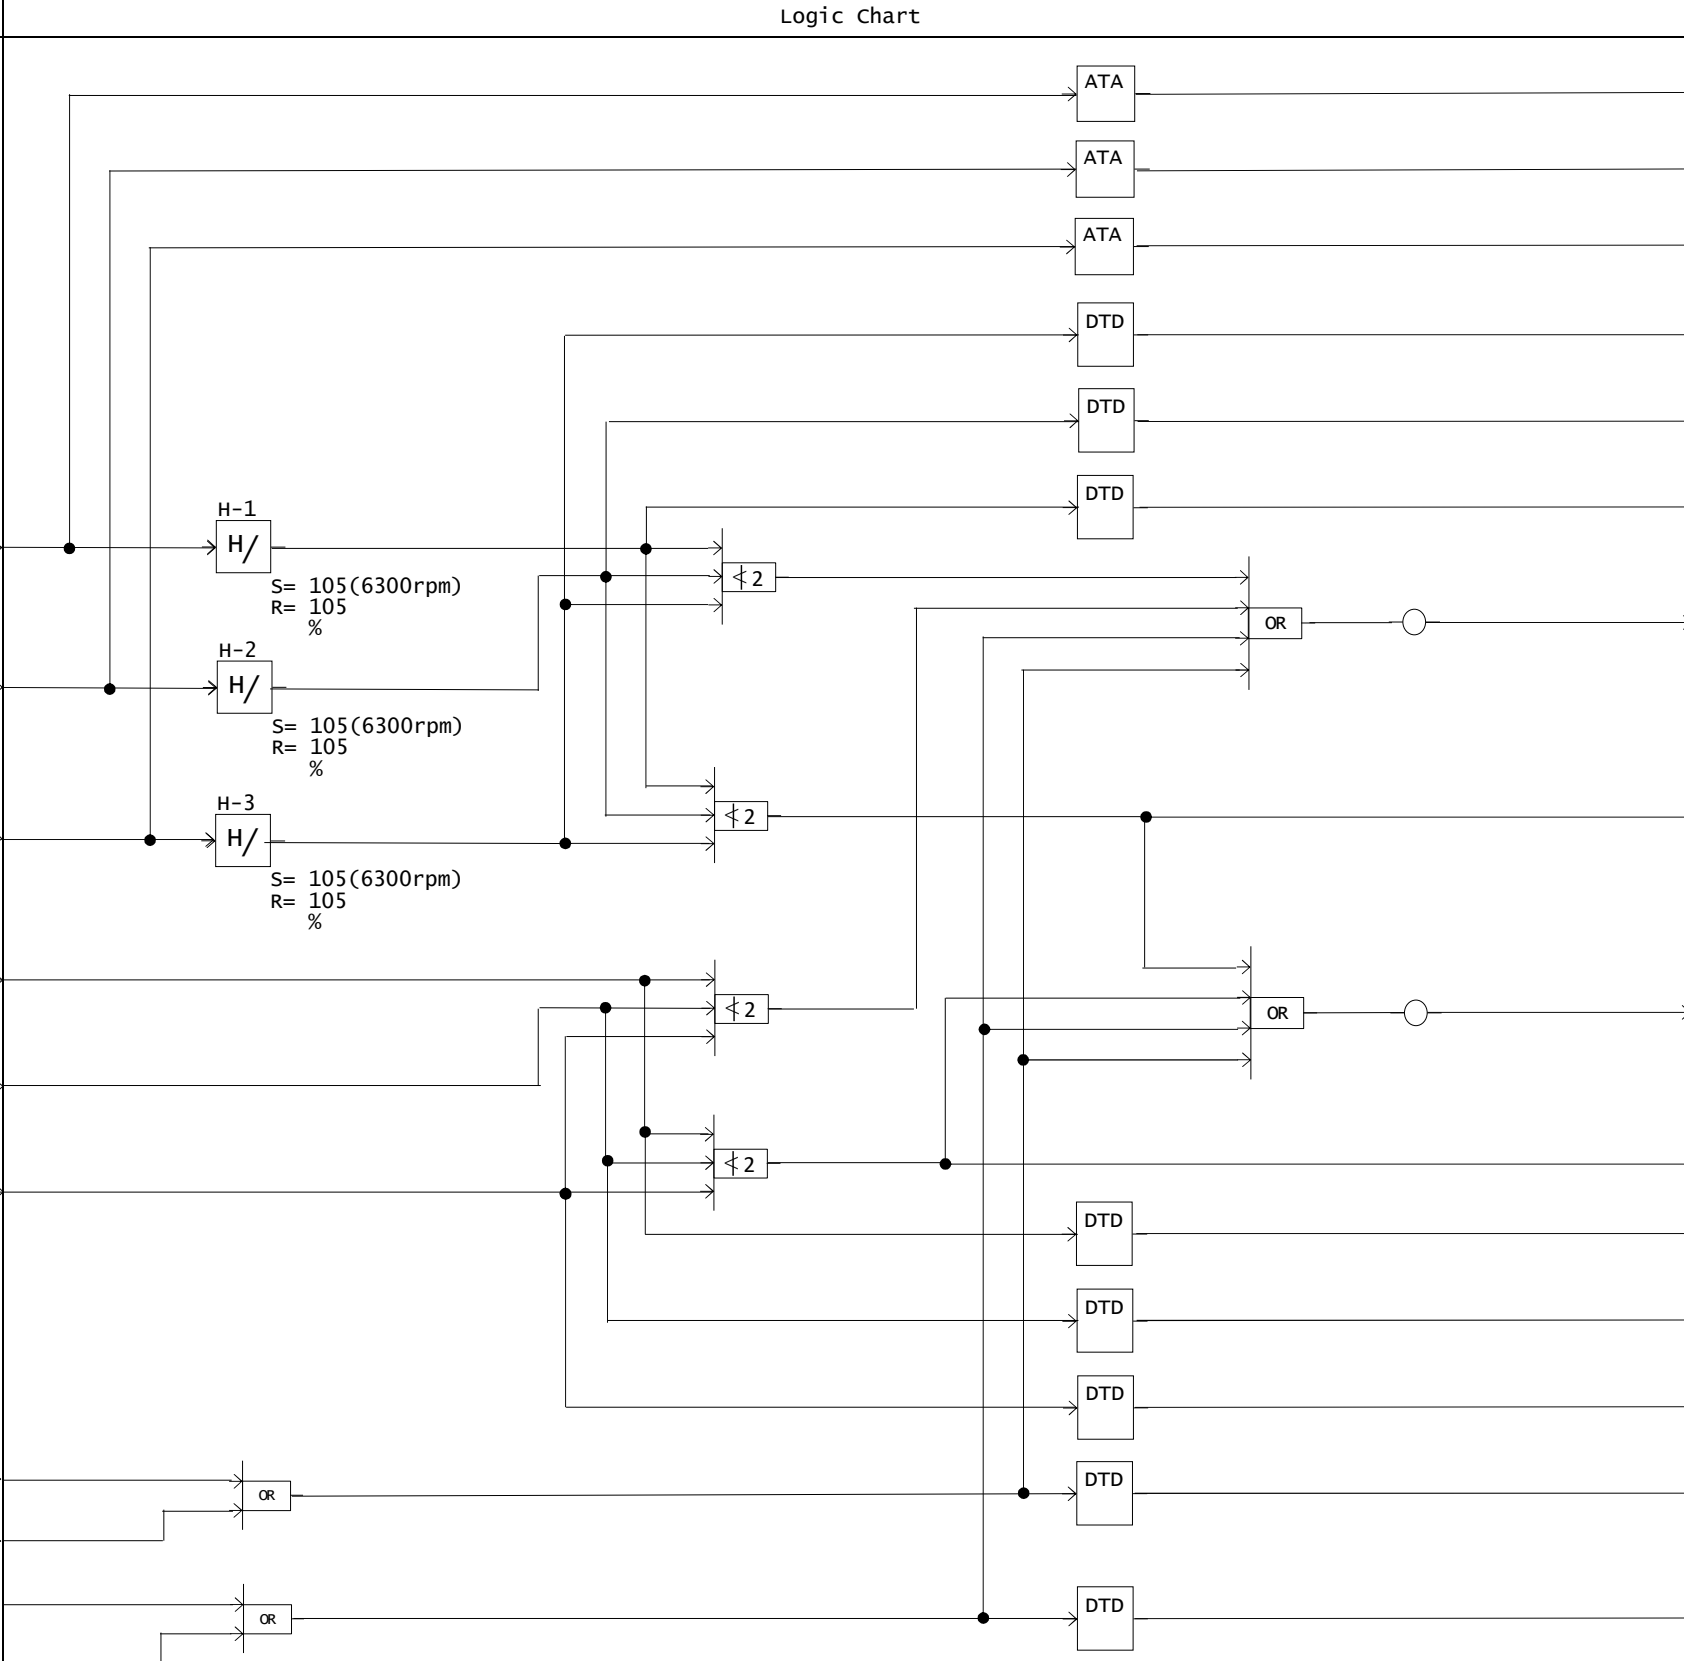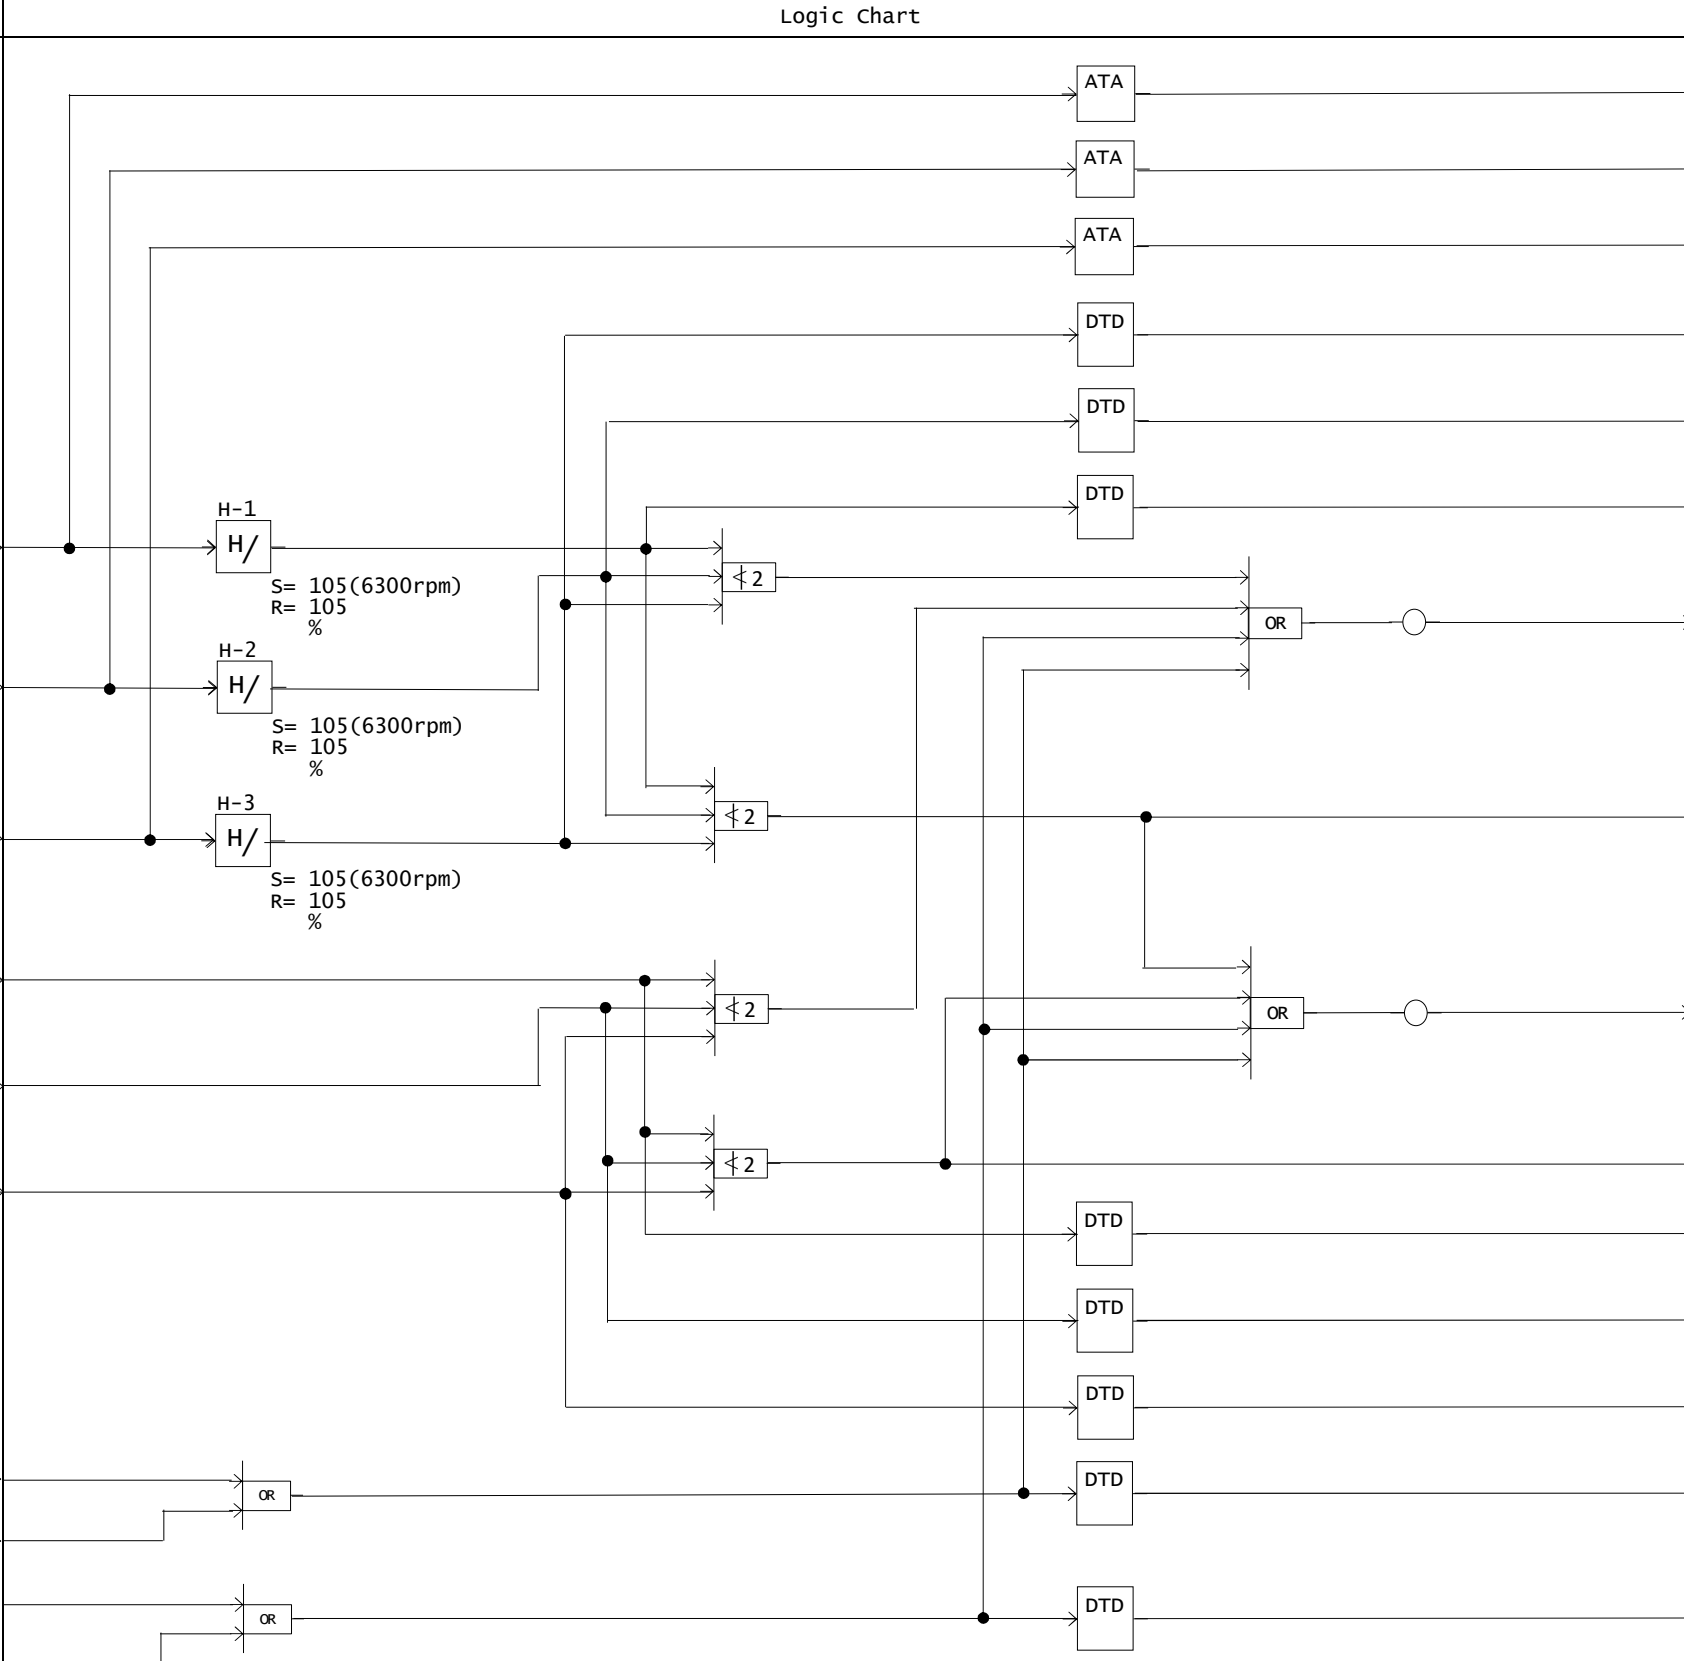	A	B	C	D	E	F	G	H	I	J	K	L	M	N	O	P	Q	R	S	T	U	V	W	X	Y	Z	AA	
	Line Name			From	LID	Logic Chart																	LID	To	Line Name			
1	BFPT A OVRSPD A			LOCAL	A																		L	TM160	BFPT A OVRSPD A			1
2																							M	TM160	BFPT A OVRSPD B			2
3																							N	TM160	BFPT A OVRSPD C			3
4																							C	TM509	BFPT A OVRSPD A			4
5																							D	TM509	BFPT A OVRSPD B			5
6																							E	TM509	BFPT A OVRSPD C			6
7																							A	TM502	BFPT A MSV TRIP SOLV A1 ENRGZ CMD			7
8																							Q	TM193	BFPT A OVRSPD			8
9	BFPT A BKUP OVRSPD A			BFPT-EHC (TM507)																			B	TM502	BFPT A MSV TRIP SOLV A2 ENRGZ CMD			9
10	BFPT A BKUP OVRSPD B			BFPT-EHC (TM507)																			R	TM260	BFPT A BKUP OVRSPD			10
11	BFPT A BKUP OVRSPD C			BFPT-EHC (TM507)																			F	TM509	BFPT A BKUP OVRSPD A			11
12																							G	TM509	BFPT A BKUP OVRSPD B			12
13	BFPT A MAN TRIP PB D (CCR)			CCR DESK	G																		H	TM509	BFPT A BKUP OVRSPD C			13
14	BFPT A MAN TRIP PB E (CCR)			CCR DESK	H																		O	TM509	BFPT A TRIP PB(CCR)			14
15	BFPT A MAN TRIP PB FROM LCL D			LOCAL	I																		P	TM509	BFPT A TRIP PB(LCL)			15
15	BFPT A MAN TRIP PB FROM LCL E			LOCAL	J																		Notes: This CIRCUIT IS MADE BY A HARD WIRED IN TSQ					
Rev.No.		0	1	2	3				PROJECT										TSQ-B									
DATE		2021/6/21	2021/12/15	2022/11/8	2023/7/5				Van Phong 1 BOT Thermal Power Plant Project 2x673MW																			
CONTENTS		1st Issue	Revised	Revised (0062)	Revised	TITLE												DRAWING No.					SH	REV. MARK				
						BFPT A TRIP (8)												4GCH01007										
						Equipment No. : -																	TM508	3				

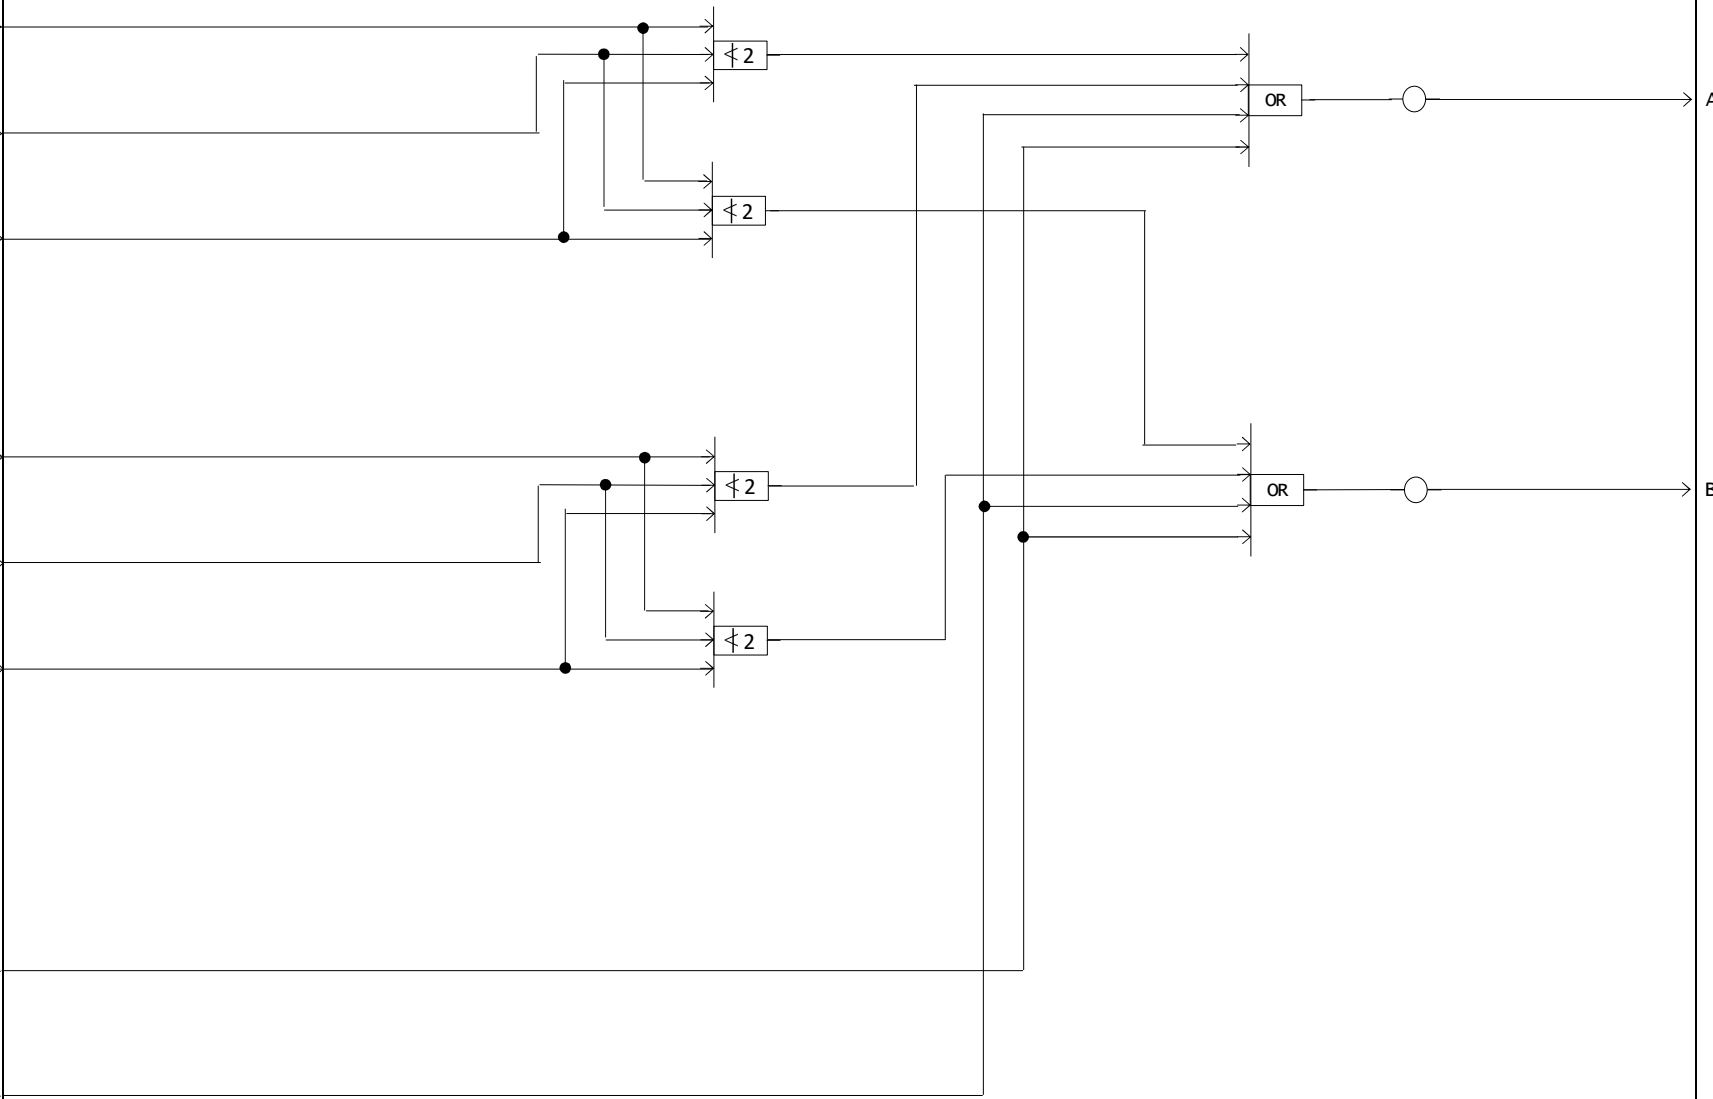	A	B	C	D	E	F	G	H	I	J	K	L	M	N	O	P	Q	R	S	T	U	V	W	X	Y	Z	AA	
	Line Name			From	LID	Logic Chart																	LID	To	Line Name			
1	BFPT A OVSP A			TM508	C																				BFPT A MSV TRIP SOLV B1 ENRGZ CMD			
2																												
3																												
4																												
5																												
6																												
7																												
8																												
9	BFPT A BKUP OVSP A			TM508	F																				BFPT A MSV TRIP SOLV B2 ENRGZ CMD			
10	BFPT A BKUP OVSP B			TM508	G																							
11	BFPT A BKUP OVSP C			TM508	H																							
12																												
13	BFPT A TRIP PB(CCR)			TM508	O																							
14	BFPT A TRIP PB(LCL)			TM508	P																							
15						Notes: This CIRCUIT IS MADE BY A HARD WIRED IN TSQ																						
Rev.No.		0	2						PROJECT										TSQ-B									
DATE		2021/6/21	2022/11/8						Van Phong 1 BOT Thermal Power Plant Project 2x673MW																			
CONTENTS		1st Issue	Revised (0062)						TITLE										DRAWING No.					SH		REV. MARK		
									BFPT A TRIP (9)										4GCH01007					TM509		2		
									Equipment No. : -																			

	A	B	C	D	E	F	G	H	I	J	K	L	M	N	O	P	Q	R	S	T	U	V	W	X	Y	Z	AA																											
	Line Name			From	LID	Logic Chart																	LID	To	Line Name																													
1	BFPT A MSV CLS			TM262	Y1	10XAX11EE053 BFPT A MSV TEST LPB-3 1 TEST 2 OPEN 3 CLOSE 1 Lamp 1 PB ON 2 Lamp 2 PB ON 3 Lamp 3 PB ON IODO-1 10XAX11AA667YB21 BFPT A MSV TEST SOLV ENRGZ CMD LOCAL (TM511) IO DO																								1																								
2																																																						2
3																																																						3
4																											BFPT A MSV OPN			TM262	Y2																							4
5																												5																										
6																												6																										
7																												7																										
8																												8																										
9																												9																										
10																												10																										
11																												11																										
12																												12																										
13																												13																										
14																												14																										
15																												15																										
	Rev. No.		0		1		2		3								PROJECT				(TSQ B)																																	
	DATE		2021/6/21		2021/12/15		2022/11/8		2023/7/5								Van Phong 1 BOT Thermal Power Plant Project 2×673MW																																					
	CONTENTS		1st Issue		Revised (0015)		Revised (0062)		Revised (0140, 0140R)								TITLE				DRAWING No.						SH		REV. MARK																									
																	BFPT A MAIN STOP VALVE TEST (1)				4GCH01007						TM510		3																									
																		Equipment No. : -																																				

	A	B	C	D	E	F	G	H	I	J	K	L	M	N	O	P	Q	R	S	T	U	V	W	X	Y	Z	AA	
	Line Name			From	LID	Logic Chart																	LID	To	Line Name			
1	BFPT A MSV TEST SOLV ENRGZ CMD			TSQ B (TM510)		10XAX11AA667 BFPT A MSV TEST SOLVE ENERGINE DE-ENERGINE 10XAA10AA601 BFPT A MSV OPERATE RESET NOTE : —┐┐┐┐— HYDRAULIC																						
2																												
3																												
Rev.No.		0	1	2					PROJECT										(LOCAL)									
DATE		2021/6/21	2021/12/15	2022/11/8					Van Phong 1 BOT Thermal Power Plant Project 2x673MW										DRAWING No.									
CONTENTS		1st Issue	Revised	Revised (0062)					BFPT A MAIN STOP VALVE TEST (2)										SH		REV. MARK							
									Equipment No. : -										4GCH01007		TM511		2					

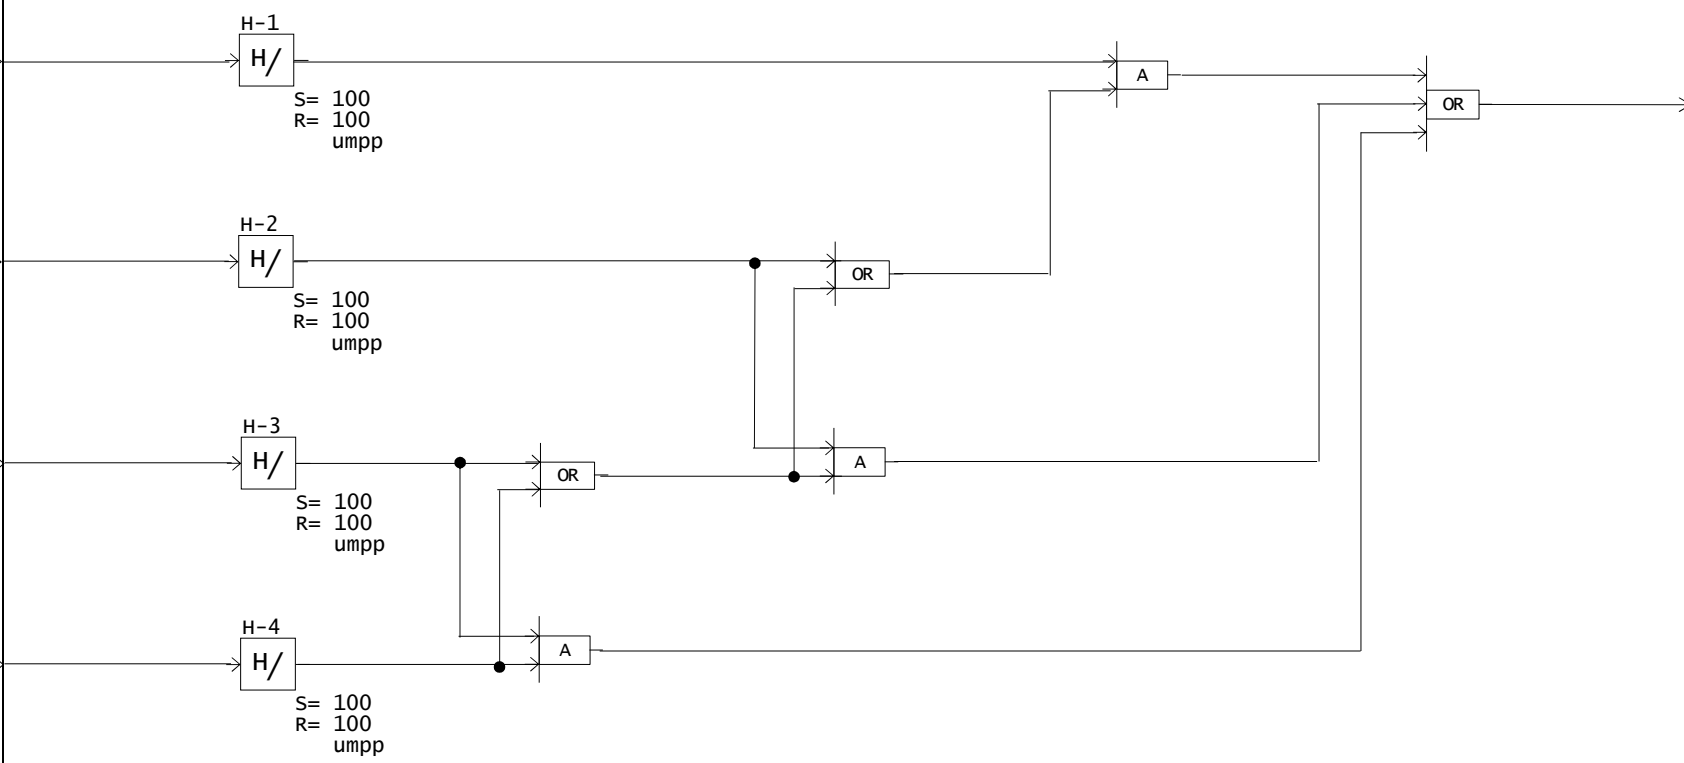	A	B	C	D	E	F	G	H	I	J	K	L	M	N	O	P	Q	R	S	T	U	V	W	X	Y	Z	AA																							
	Line Name			From	LID	Logic Chart																	LID	To	Line Name																									
1	BFPT A BRG 1 VIB X			LOCAL	AI 01																		A	TM513	BFPT A VIB HI-TRP CNDN			1																						
2																												2																						
3																												3																						
4																												4																						
5	BFPT A BRG 1 VIB Y			LOCAL	AI 02																							5																						
6																												6																						
7																												7																						
8																												8																						
9	BFPT A BRG 2 VIB X			LOCAL	AI 03																							9																						
10																												10																						
11																												11																						
12																												12																						
13	BFPT A BRG 2 VIB Y			LOCAL	AI 04																							13																						
14																												14																						
15																												15																						
Rev.No.		0	2							PROJECT					(TSI)																																			
DATE		2021/6/21	2022/11/8							Van Phong 1 BOT Thermal Power Plant Project 2x673MW																																								
CONTENTS		1st Issue	Revised (0062)										TITLE					DRAWING No.						SH		REV. MARK																								
												BFPT A BRG VIB TRIP (TSI) (1)					4GCH01007					TM512		2																										
		Equipment No. : -																																																

	A	B	C	D	E	F	G	H	I	J	K	L	M	N	O	P	Q	R	S	T	U	V	W	X	Y	Z	AA				
	Line Name			From	LID	Logic Chart																	LID	To	Line Name						
1	BFPT A BRG 1 VIB X HI HI >150umpp			LOCAL	DI 01																		A	TSQ B (TM260)	BFPT A BRG VIB HH A						
2																															
3																															
4																															
5																															
6	BFPT A BRG 2 VIB X HI HI > 150umpp			LOCAL	DI 03																		B	TSQ B (TM260)	BFPT A BRG VIB HH B						
7	BFPT A BRG 2 VIB Y HI HI > 150umpp			LOCAL	DI 04																		C	TSQ B (TM260)	BFPT A BRG VIB HH C						
8																															
9	BFPT A VIB HI-TRP CNDN			TM512	A																										
10																															
11																															
12																															
13																															
14																															
15																															
	Rev.No.		0	2		3										PROJECT						(TSI)									
	DATE		2021/6/21	2022/11/8		2023/7/5										Van Phong 1 BOT Thermal Power Plant Project 2x673MW															
	CONTENTS		1st Issue	Revised (0062)		Revised										TITLE						DRAWING No.				SH		REV. MARK			
																BFPT A BRG VIB TRIP (TSI) (2)						4GCH01007				TM513		3			
																Equipment No. : -															


	A	B	C	D	E	F	G	H	I	J	K	L	M	N	O	P	Q	R	S	T	U	V	W	X	Y	Z	AA	
	Line Name			From	LID	Logic Chart																	LID	To	Line Name			
1	BFPT A SPD			TM193	01																		08	TE579 TM824	BFPT A SPD			1
2																							A	TY306	BFPT A SPD			2
3																												3
4																							01	TM579 TM584	BFPT A SPD >2900rpm			4
5																							02	TM589	BFPT A SPD <2000rpm			5
6																							03	TM589	BFPT A SPD >3000rpm			6
7																												7
8																							04	TM824	BFPT A SPD >700rpm			8
9																												9
10																							05	TM300	BFPT A SPD NO SPD			10
11																												11
12																							06		BFPT A SPD >1500rpm			12
13																												13
14																												14
15																							07	TM501	BFPT A SPD >102%			15

Rev. No.	0	1	2					PROJECT	(TSQ B)			
DATE	2021/6/21	2021/12/15	2022/11/8					Van Phong 1 BOT Thermal Power Plant Project 2×673MW				
CONTENTS	1st Issue	Revised (0007, 0026)	Revised (0032, 0045, 0062)					TITLE	DRAWING No.	SH	REV. MARK	
								BFPT A INTERLOCK SIGNAL	4GCH01007	TM515	2	
								Equipment No. : -				

	A	B	C	D	E	F	G	H	I	J	K	L	M	N	O	P	Q	R	S	T	U	V	W	X	Y	Z	AA																									
	Line Name			From	LID	Logic Chart																	LID	To	Line Name																											
1	BFPT A CV CLS TM374 BFPT A ZERO SPD <2RPM TM263 BFPT A T-GEAR AUTO TM520 BFPT A T-GEAR CLUSOLV ENRGZ TM263 BFPT A LUBE OIL PRESS TM187 TBFP-A BRL TMP AVE HI (TP-SCTN&DSCH) TM830 BFPT A T-GEAR RUN TM520																								BFPT A T-GEAR AUTO S TRT TM520 BFPT A CV CLS & ZERO SPD TM521 BFPT A T-GEAR A-STP TM520 BFPT A T-GEAR STRTINH TM520 BFPT A T-GEAR F-STP TM520 BFPT A T-GEAR CLUTCH SOLV ENRGZ CMD TM521																											
2				01																			01	TM520																											2	
3				Y2																																																3
4				11																																																4
5				Y1																																																5
6				01																																																6
7				22																																																7
8																																																				8
9																																																				9
10																																																				10
11																																																				11
12				Z1																																																12
13																																																				13
14																																																				14
15																																																				15
Rev. No.			0	1	2	3								PROJECT					(TSQ B)																																	
DATE			2021/6/21	2021/12/15	2022/11/8	2023/7/5								Van Phong 1 BOT Thermal Power Plant Project 2×673MW																																						
CONTENTS			1st Issue	Revised (0015)	Revised (0062, 0056, 0064)	Revised (0152, 0163)								TITLE					DRAWING No.					SH		REV. MARK																										
														BFPT A TURNING GEAR (1)					4GCH01007					TM519		3																										
														Equipment No. : 0XAA10AE001																																						

	A	B	C	D	E	F	G	H	I	J	K	L	M	N	O	P	Q	R	S	T	U	V	W	X	Y	Z	AA						
	Line Name			From	LID	Logic Chart																	LID	To	Line Name								
1						10XAV11EE001 BFPT A MOP SEL SEL-2PB 1PUMP A 2PUMP B 1 REQ 1 SEL 2 REQ 2 SEL 1 INH 2 INH																	01	TM400 TM401 TM408	BFPT A MOP A SEL								
2																												2					
3																												3					
4																												4					
5																												5					
6																												02	TM400 TM401 TM408	BFPT A MOP B SEL			
7																																	7
8																																	8
9																																	9
10																																	10
11																																	11
12																																	12
13																																	13
14																																	14
15																																	15
Rev. No.			0	1	2					PROJECT			(TSQ B)																				
DATE			2021/6/21	2021/12/15	2022/11/8					Van Phong 1 BOT Thermal Power Plant Project 2×673MW																							
CONTENTS			1st Issue	Revised (0015)	Revised (0032)					TITLE			DRAWING No.					SH		REV. MARK													
										BFPT A MAIN OIL PUMP SELECTOR			4GCH01007					TM530		2													
										Equipment No. : _OXAV11/12AP001																							


	A	B	C	D	E	F	G	H	I	J	K	L	M	N	O	P	Q	R	S	T	U	V	W	X	Y	Z	AA																																											
	Line Name			From	LID	Logic Chart																	LID	To	Line Name																																													
1																												1																																										
2																												2																																										
3																												3																																										
4																												4																																										
5																												5																																										
6																												6																																										
7																												7																																										
8	BFPT A MAIN OIL PUMP A STRT CMD			TM408	11																		11	TM535	BFPT A MOP A A-STRT CMD			8																																										
9				TM532	01																		9																																															
10	BFPT A MOP A BKUP ST RT																						12	TM535	BFPT A MOP A A-STP C MD			10																																										
11																							11																																															
12	BFPT A MAIN OIL PUMP B STRT CMD			TM408	12																		21	TM540	BFPT A MOP B A-STRT CMD			12																																										
13				TM532	02																		13																																															
14	BFPT A MOP B BKUP ST RT																						22	TM540	BFPT A MOP B A-STP C MD			14																																										
15																							15																																															
	Rev. No.		0	1	2																																																																	
	DATE		2021/6/21	2021/12/15	2022/11/8																																																																	
	CONTENTS		1st Issue	Revised (0015)	Revised (0032)																																																																	
														PROJECT														(TSQ B)																																										
														Van Phong 1 BOT Thermal Power Plant Project 2×673MW																																																								
														TITLE														DRAWING No.														SH														REV. MARK														
														BFPT A MAIN OIL PUMP LDG MSTR														4GCH01007														TM533														2														
														Equipment No. : OXAV11/12AP001																																																								

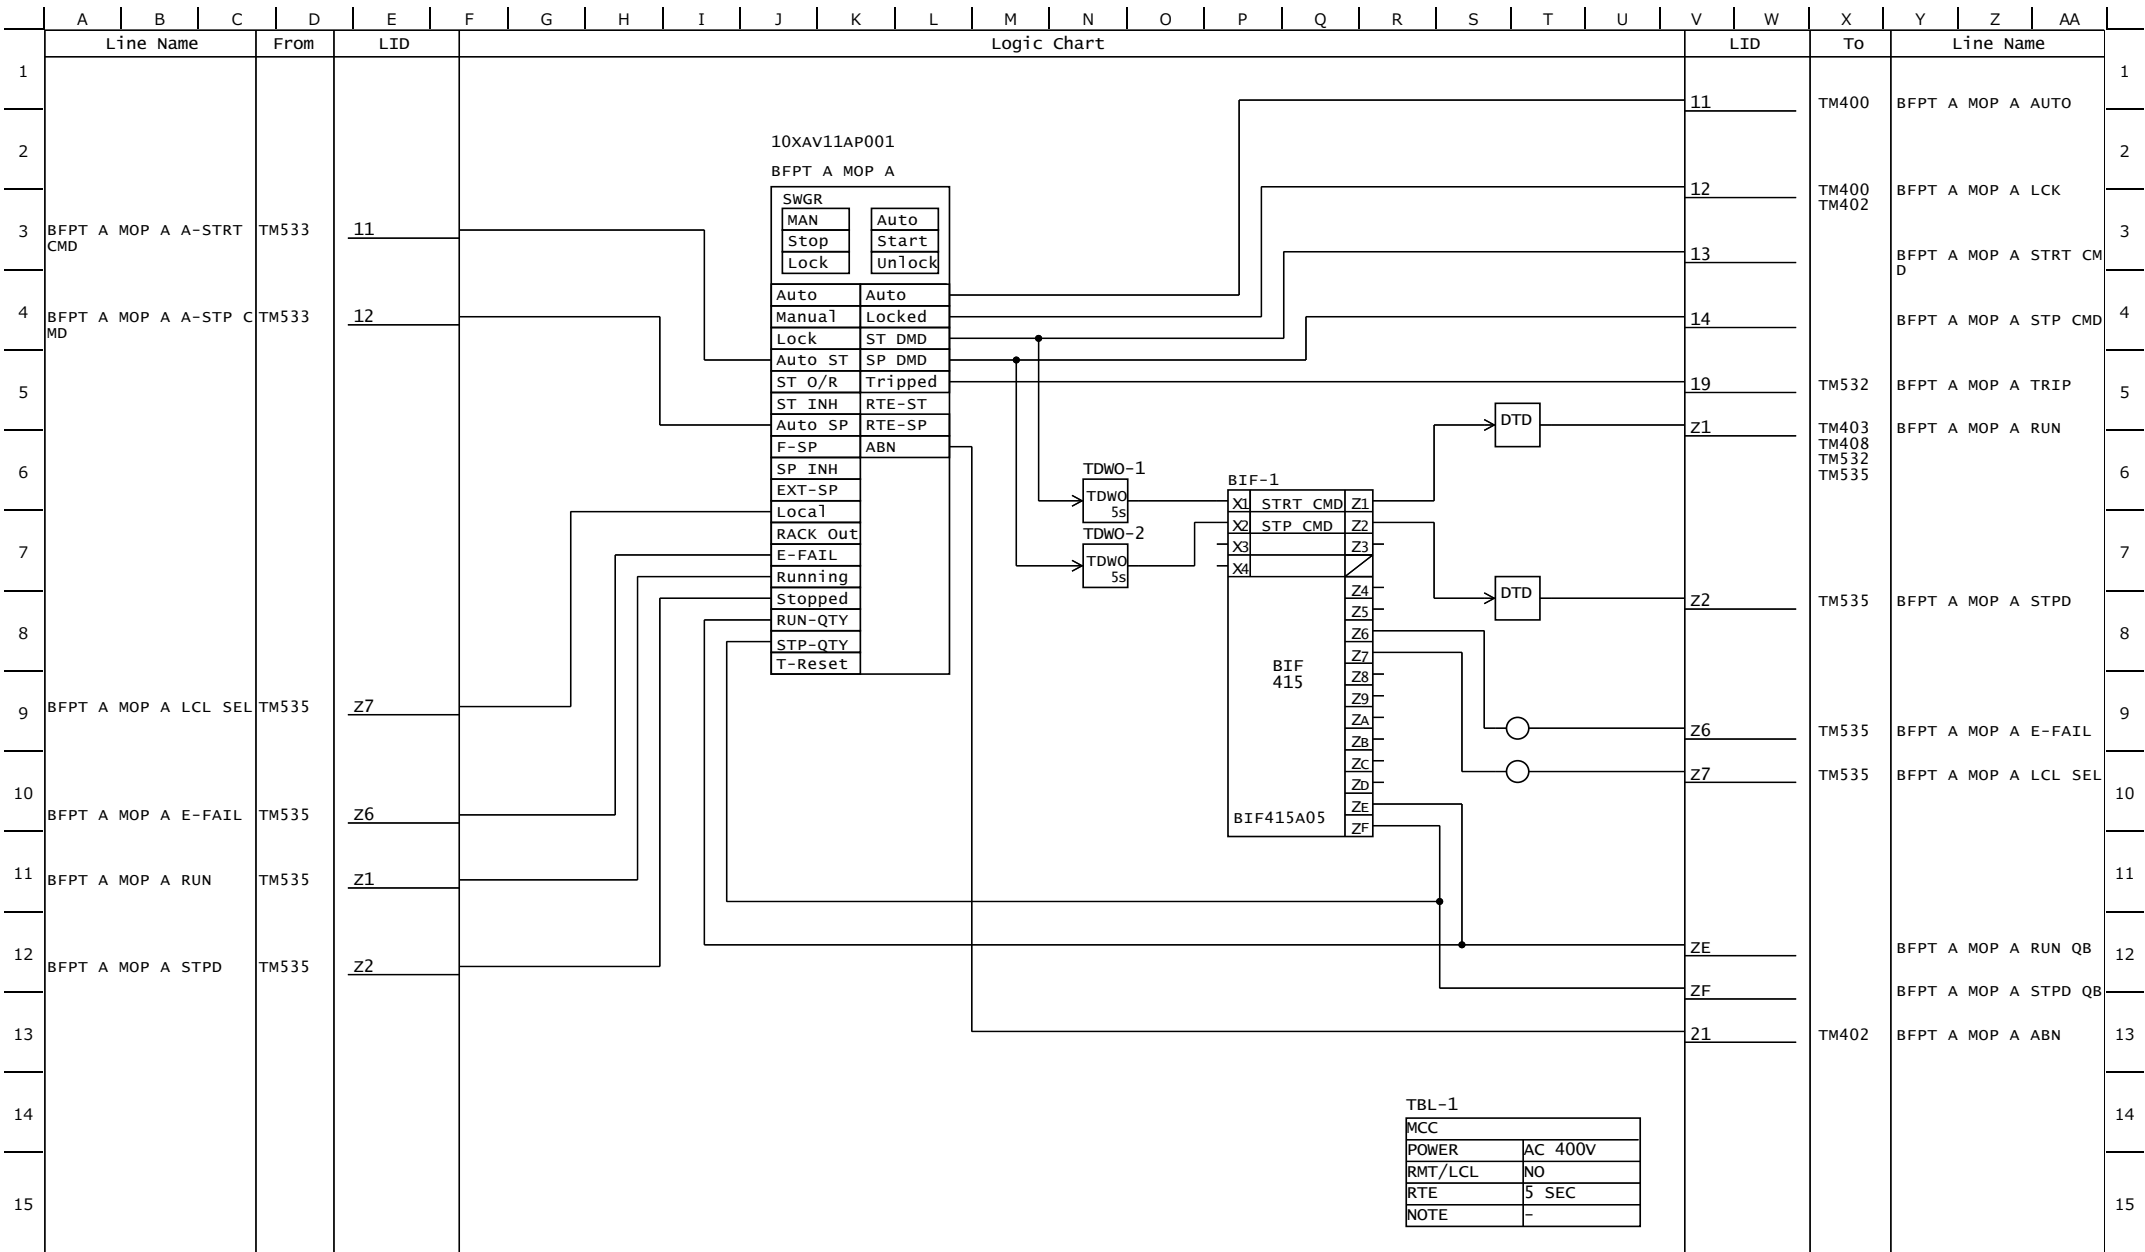

Rev. No.	0	1	2					PROJECT Van Phong 1 BOT Thermal Power Plant Project 2×673MW	(TSQ B)			
DATE	2021/6/21	2021/12/15	2022/11/8									
CONTENTS	1st Issue	Revised (0007, 0015)	Revised (0032)					TITLE	DRAWING No.	SH	REV. MARK	
								BFPT A MAIN OIL PUMP A	4GCH01007	TM535	2	
								Equipment No. : _OXAV11AP001				


	A	B	C	D	E	F	G	H	I	J	K	L	M	N	O	P	Q	R	S	T	U	V	W	X	Y	Z	AA								
	Line Name			From	LID	Logic Chart																	LID	To	Line Name										
1	BFPT A MOP B A-STRT CMD			TM533	21	10XAV12AP001 BFPT A MOP B SWGR MAN Stop Lock Auto Start Unlock Auto Manual Lock Auto ST ST O/R ST INH Auto SP F-SP SP INH EXT-SP Local RACK Out E-FAIL Running Stopped RUN-QTY STP-QTY T-Reset TDWO-1 TDWO-2 TDWO-3 BIF-1 BIF 415 BIF415A05 DTD DTD DTD																	11	TM400	BFPT A MOP B AUTO										
2																							12	TM400 TM402	BFPT A MOP B LCK										
3																							13		BFPT A MOP B STRT CMD										
4																							14		BFPT A MOP B STP CMD										
5																							19	TM532	BFPT A MOP B TRIP										
6																							21	TM403 TM408 TM532 TM540	BFPT A MOP B RUN										
7																							22	TM540	BFPT A MOP B STPD										
8																							26	TM540	BFPT A MOP B E-FAIL										
9																							27	TM540	BFPT A MOP B LCL SEL										
10																							ZE		BFPT A MOP B RUN QB										
11																							ZF		BFPT A MOP B STPD QB										
12																							21	TM402	BFPT A MOP B ABN										
13																																			
14	TBL-1 <table><tr><td colspan="2">EMCC</td></tr><tr><td>POWER</td><td>AC 400V</td></tr><tr><td>RMT/LCL</td><td>NO</td></tr><tr><td>RTE</td><td>5 SEC</td></tr><tr><td>NOTE</td><td>-</td></tr></table>																									EMCC		POWER	AC 400V	RMT/LCL	NO	RTE	5 SEC	NOTE	-
EMCC																																			
POWER	AC 400V																																		
RMT/LCL	NO																																		
RTE	5 SEC																																		
NOTE	-																																		
15																																			

Rev. No.	0	1	2							PROJECT	Van Phong 1 BOT Thermal Power Plant Project 2×673MW				(TSQ B)			
DATE	2021/6/21	2021/12/15	2022/11/8							TITLE	BFPT A MAIN OIL PUMP B				DRAWING No.		SH	REV. MARK
CONTENTS	1st Issue	Revised (0007, 0015)	Revised (0032)							Equipment No. :	OXAV12AP001				4GCH01007		TM540	2

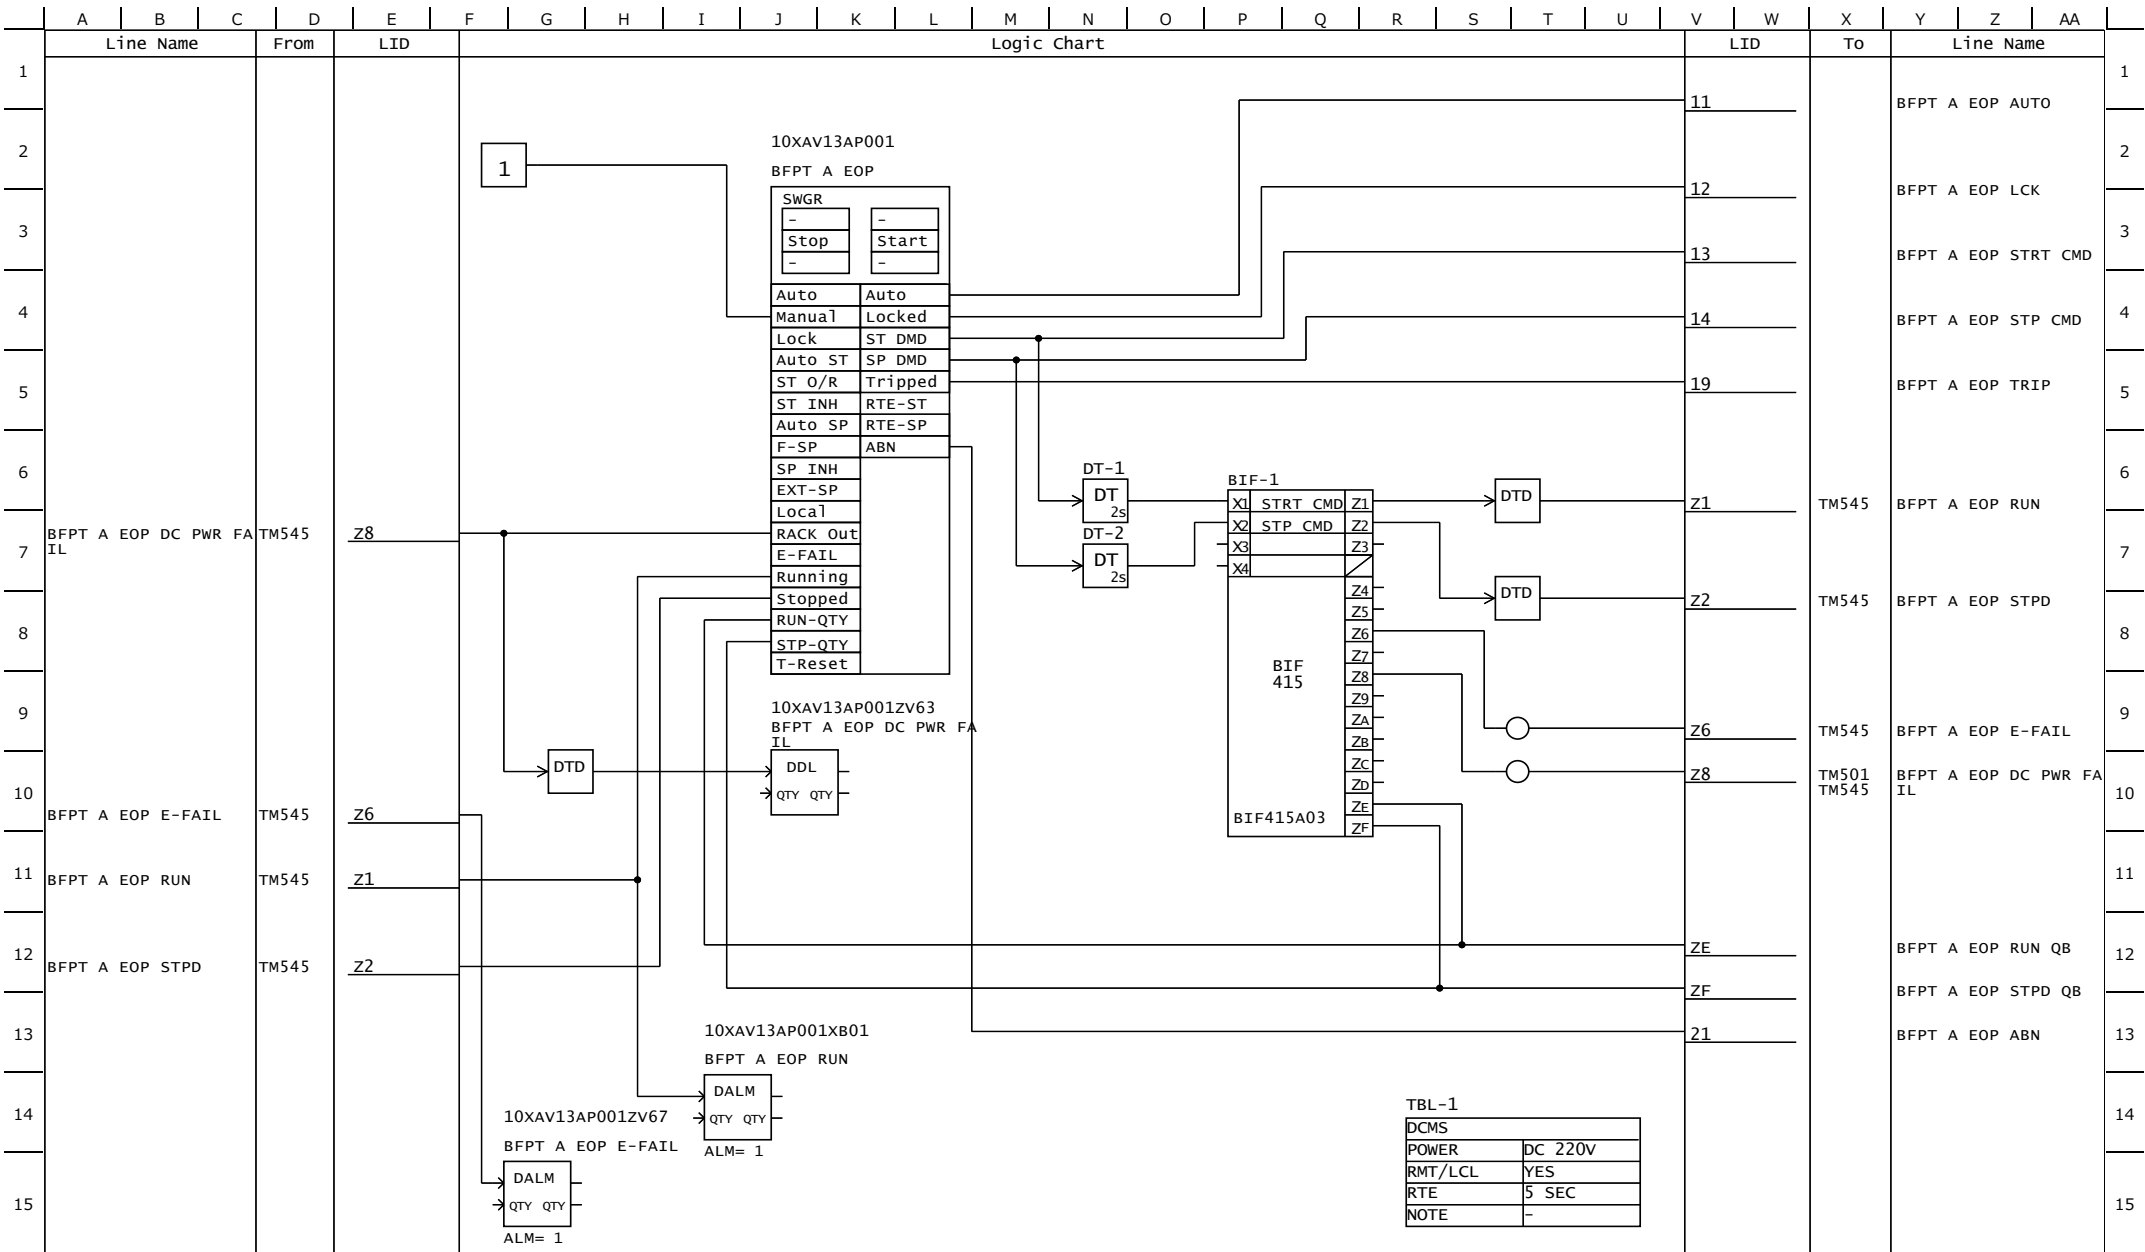



Rev. No.	0	1	2	3				PROJECT Van Phong 1 BOT Thermal Power Plant Project 2×673MW	(TSQ B)			
DATE	2021/6/21	2021/12/15	2022/11/8	2023/7/5								
CONTENTS	1st Issue	Revised (0007, 0022, 0026)	Revised (0081)	Revised (0126, 0129, 0183)				TITLE	DRAWING No.	SH	REV. MARK	
								BFPT A EOP	4GCH01007	TM545	3	
								Equipment No. : _OXAV13AP001				

	A	B	C	D	E	F	G	H	I	J	K	L	M	N	O	P	Q	R	S	T	U	V	W	X	Y	Z	AA																		
	Line Name			From	LID	Logic Chart																	LID	To	Line Name																				
1	BFPT A EOP STRT CMD			TSQ B (TM545)	A																			LOCAL	BFPT A EOP STRT CMD																				
2																												LOCAL	DI																
3																																													
4																																													
5																																													
6																																													
7																																													
8				BFPT A EOP STP CMD																			TSQ B (TM545)	B	NOTE: 1.EOP MOTOR CONTROL CENTER (EOP MCC) MUST BE ALWAYS SWITCHED ON AND THE POWER SUPPLY MUST BE VITAL EXCEPT WHILE TURBINE ROTATION IS COMPLETELY STOPPED. 2.AT THE STAGE OF START UP, EOP MCC MUST BE SWITCHED ON BEFORE TURNING AND AFTER A MAIN OIL PUMP STARTED. 3.AT THE STAGE OF SHUT DOWN, EOP MCC MUST BE SWITCHED OFF AFTER TURNING COMPLETELY STOPPED AND BEFORE A MAIN OIL PUMP STOPPED. 4.THE STOP POSITION OF CONTROL SWITCH WITHOUT A LOCK POSITION IS USED TO WIPE OUT THE START HOLD CIRCUIT ON BEARING OI PRESSUER ESTABLISHED, AFTER AUTO START TEST IS CARRIED OUT WITH OIL DUMP OF THE PRESSURE SWITCH ON AN INSTRUMENT PIPE, OR AFTER ANY OTHER STARTING OPERATION. 5.THIS CONTROL LOGIC MUST BE MADE BY A HARDWIRED CIRCUIT. Notes: THIS CONTROL IS MADE BY HARD-WIRED CIRCUIT (ON DC MCC)																				
9																																													
10																																													
11																																													
12																																													
13																																													
14																																													
15																																													
Rev.No.		1	2						PROJECT										DC-MCC																										
DATE		2021/12/15	2022/11/8						Van Phong 1 BOT Thermal Power Plant Project 2x673MW																																				
CONTENTS		Added	Revised (0064)						TITLE					DRAWING No.					SH		REV. MARK																								
									BFPT A EMARGENCY OIL PUMP (2)					4GCH01007																															
														Equipment No. : -																															

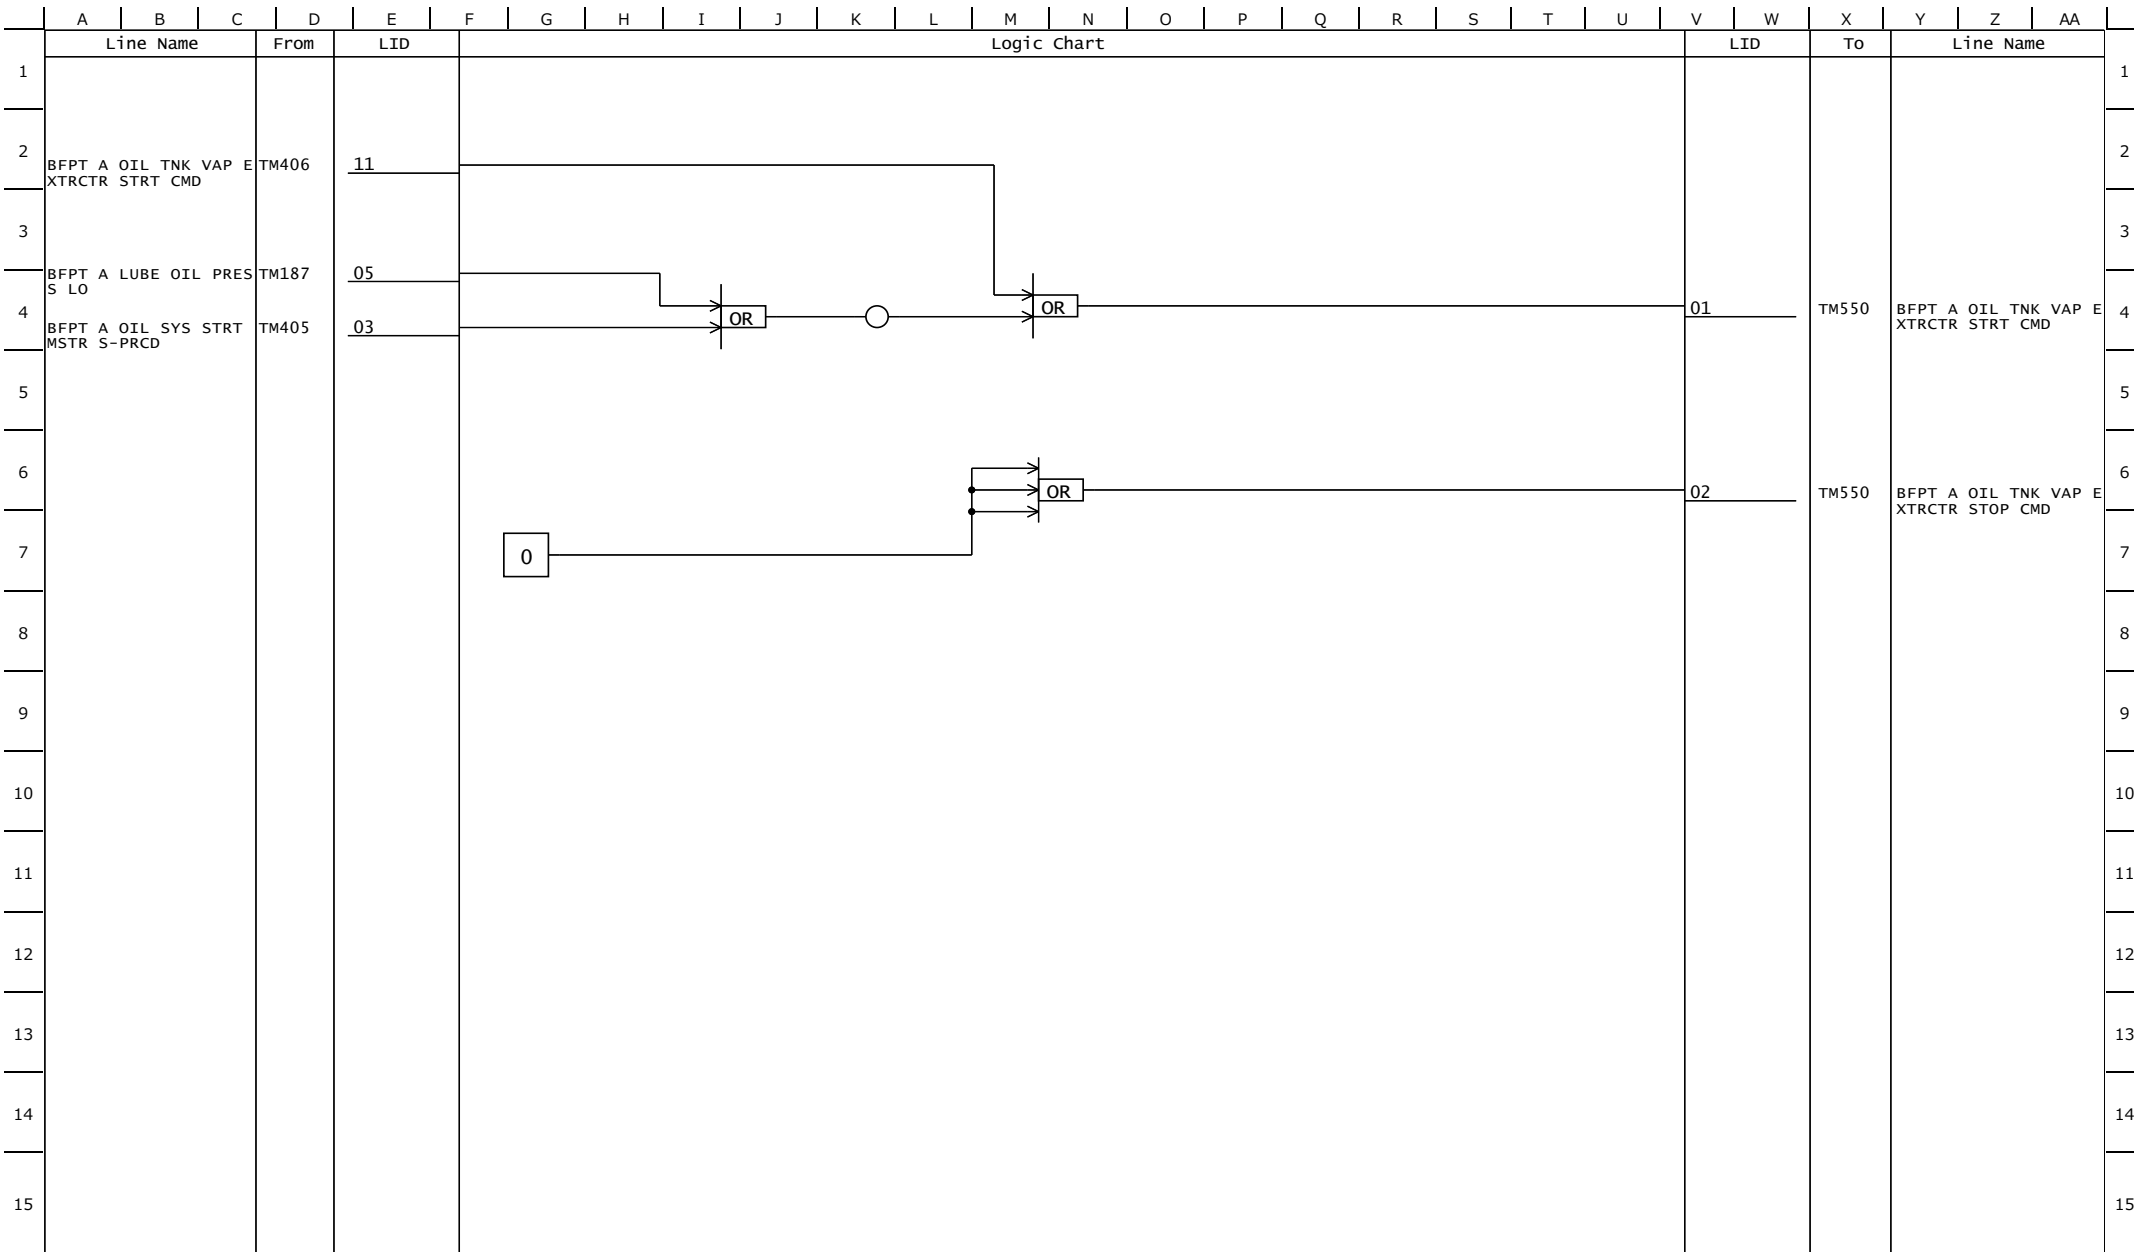

Rev. No.	0	1						PROJECT Van Phong 1 BOT Thermal Power Plant Project 2×673MW	(TSQ B)			
DATE	2021/6/21	2021/12/15										
CONTENTS	1st Issue	Revised (0015)						TITLE BFPT A OIL TNK VAP EXTRCTR (1)	DRAWING No. 4GCH01007	SH TM549	REV. MARK 1	
								Equipment No. : _OXAQ10AN001				

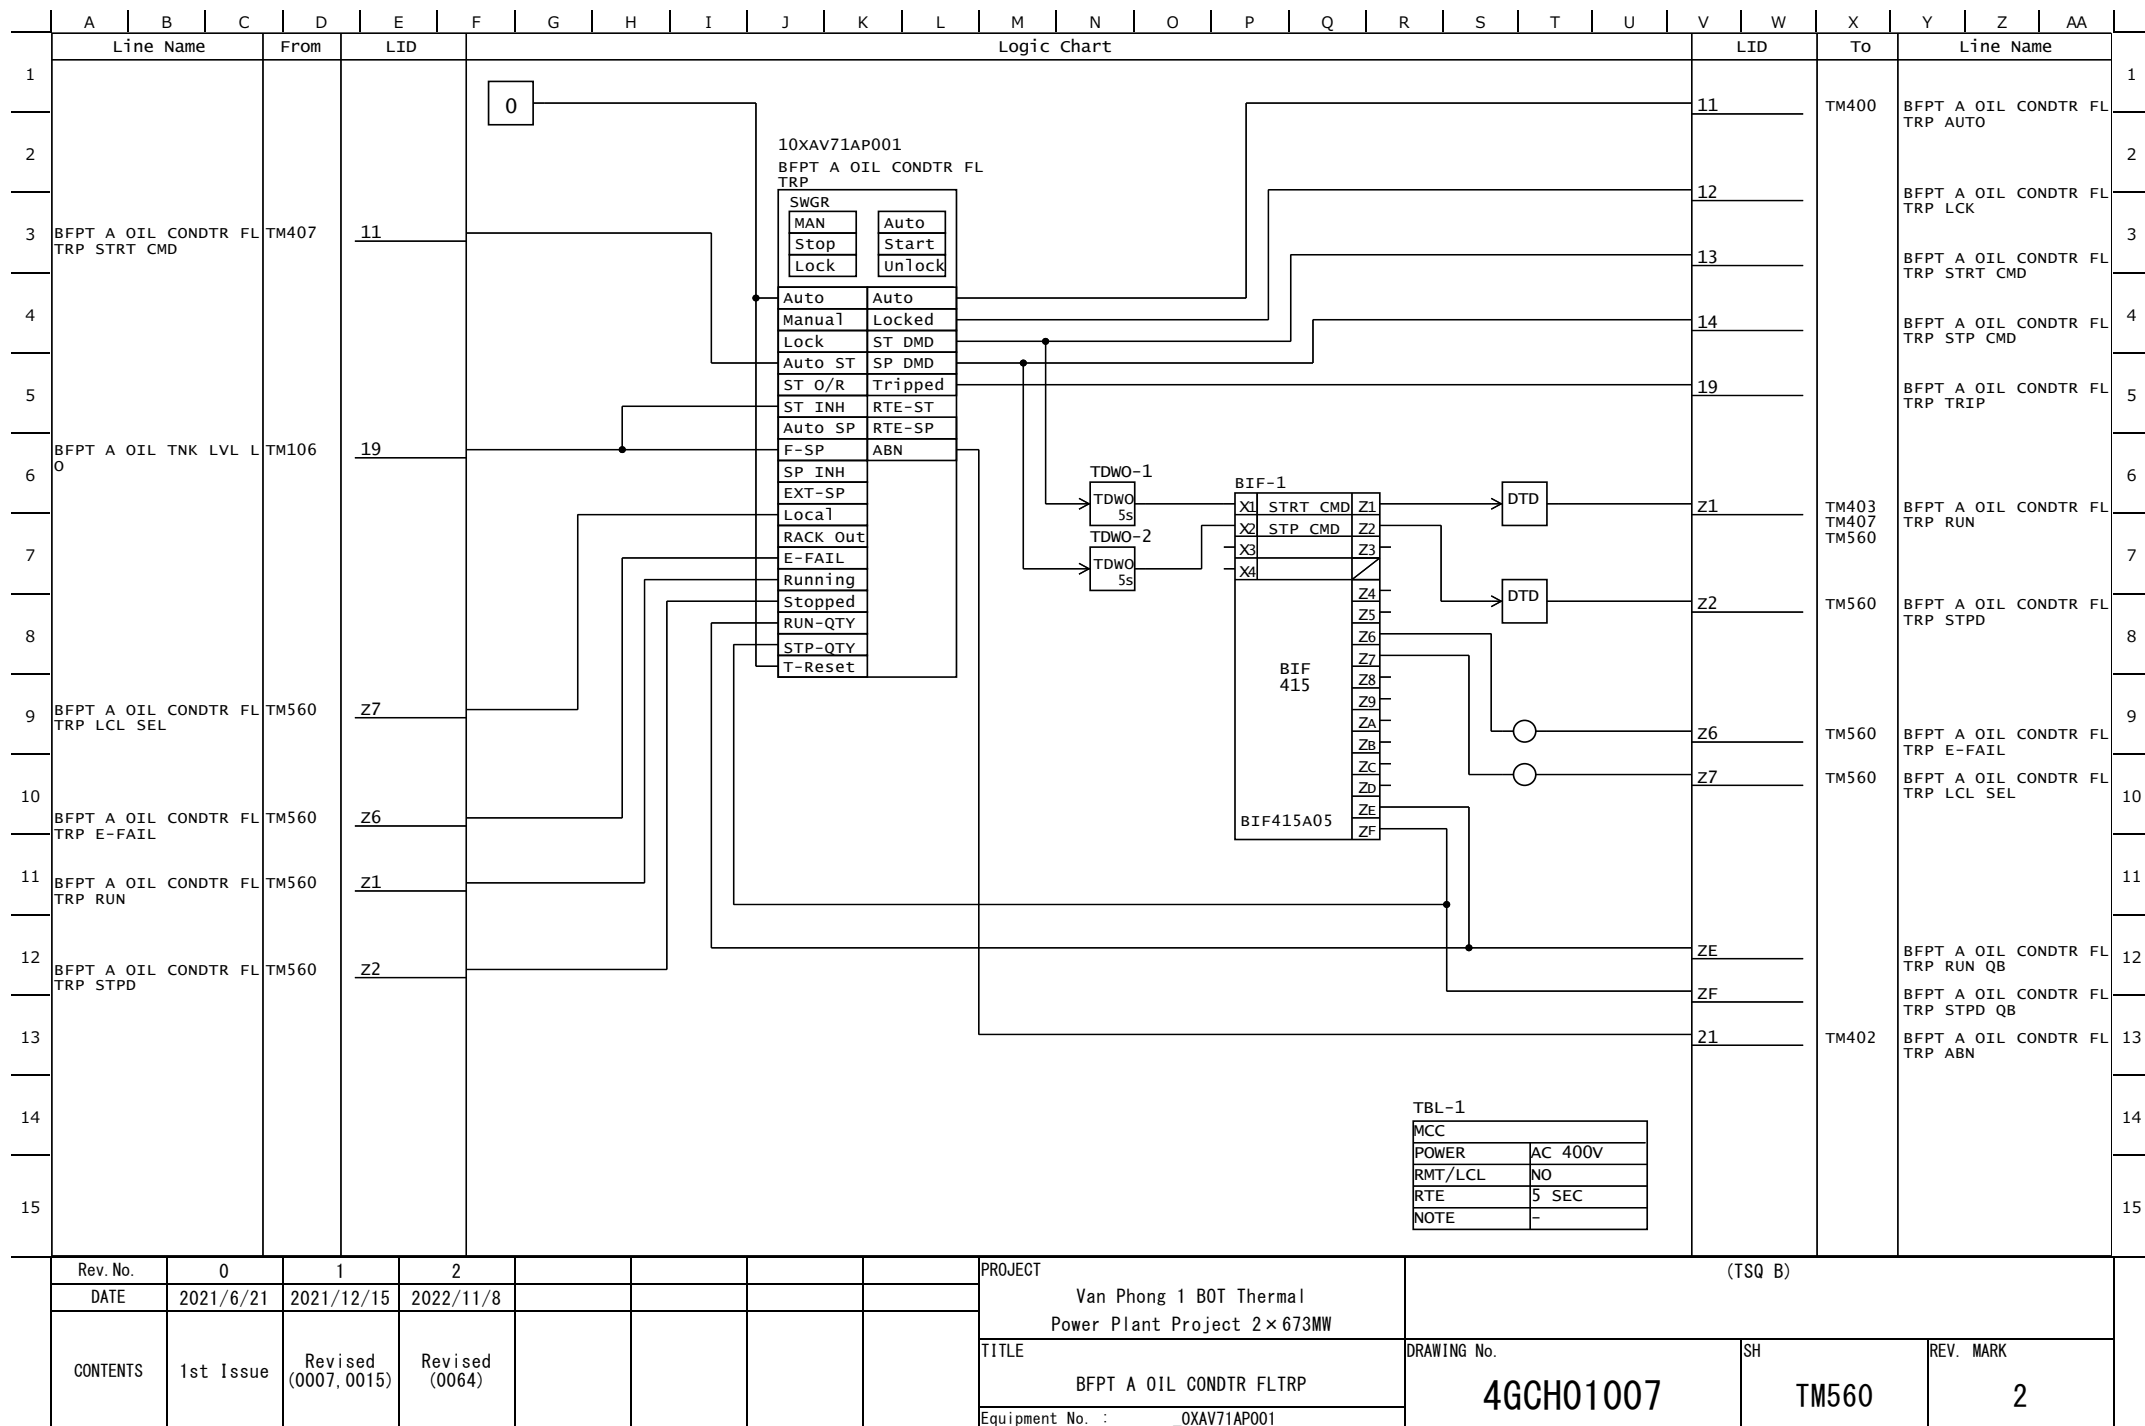

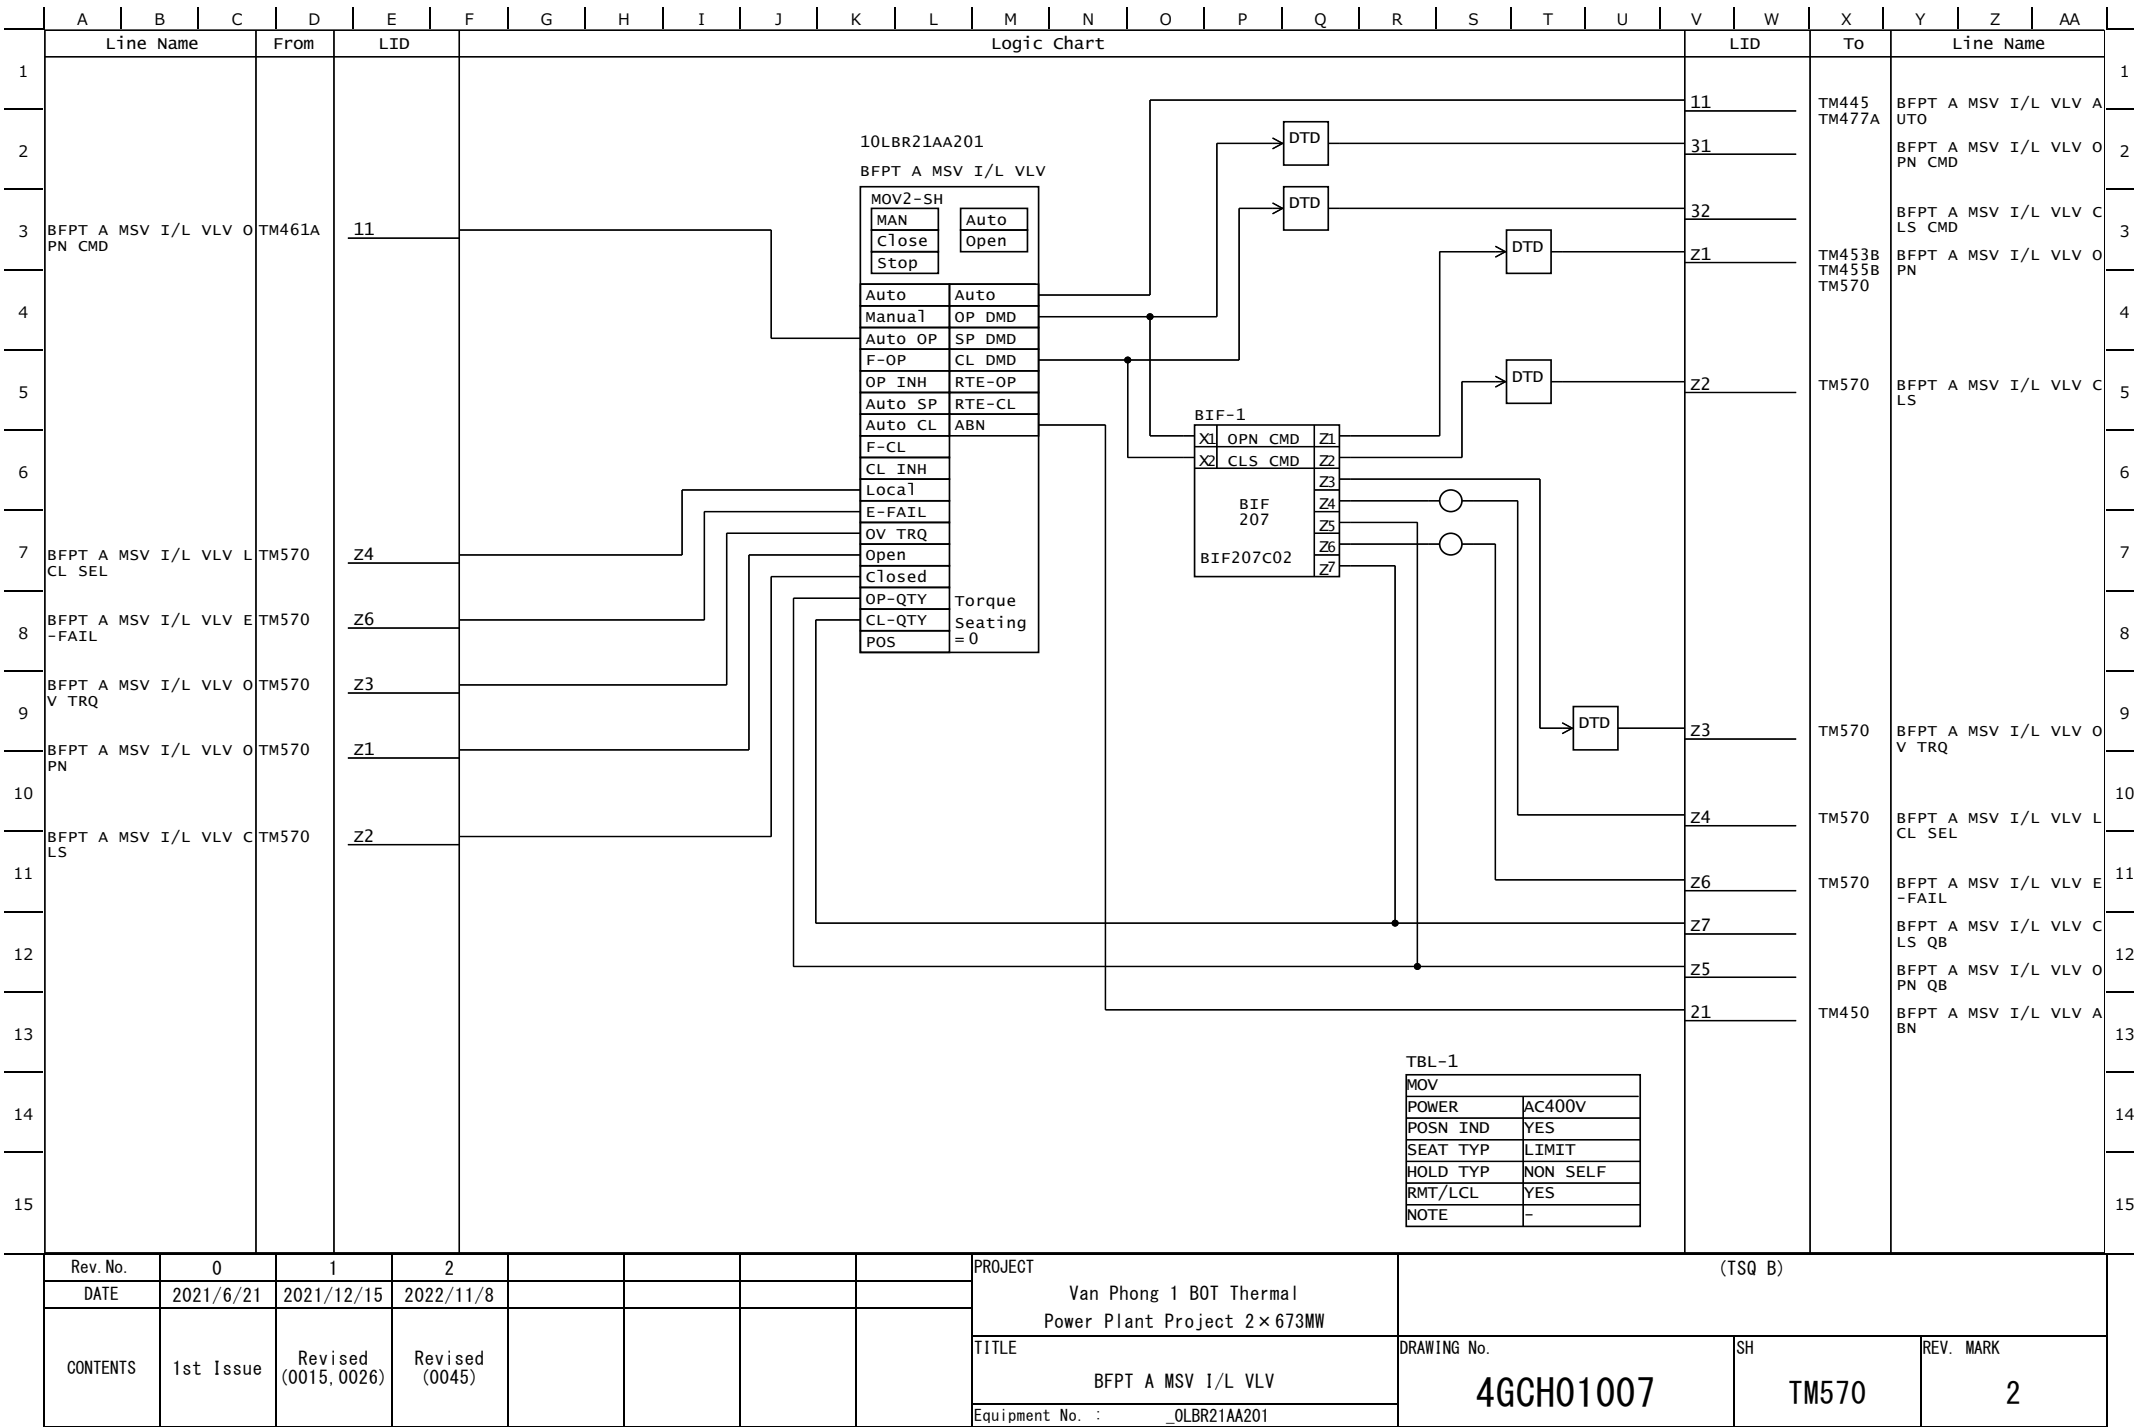

	A	B	C	D	E	F	G	H	I	J	K	L	M	N	O	P	Q	R	S	T	U	V	W	X	Y	Z	AA																														
	Line Name			From	LID	Logic Chart																	LID	To	Line Name																																
1				TM579	01	10MAL81AA401 BFPT A MSV B/S DV S-SOV-EC MAN Auto Close Open Auto Manual Auto OP F-OP OP INH Auto CL F-CL CL INH E-FAIL Open Closed OP-QTY CL-QTY																				11	TM445 TM477A	BFPT A MSV B/S DV AU TO		1																											
2																												2																													
3																												3																													
4																												4																													
5	BFPT A MSV B/S DV A- CLS CMD			TM579	02																		Z1	TM580	BFPT A MSV B/S DV OP N				5																												
6	BFPT A MSV B/S DV A- CLS CMD																												6																												
7	BFPT A MSV B/S DV OP N			TM580	Z1																	Z2	TM580	BFPT A MSV B/S DV CL SD					7																												
8	BFPT A MSV B/S DV CL SD																												8																												
9				TM580	Z2																	Z3	TM450	BFPT A MSV B/S DV CL S QB	BFPT A MSV B/S DV OP N QB			9																													
10																												10																													
11																												11																													
12																												12																													
13				TM450	Z1																	Z4						13																													
14																												14																													
15																												15																													
						TBL-1 <table><tr><td colspan="2">SOV</td></tr><tr><td>POWER</td><td>DC24V</td></tr><tr><td>RMT/LCL</td><td>OPEN</td></tr><tr><td>NOTE</td><td>-</td></tr></table>																							SOV		POWER	DC24V	RMT/LCL	OPEN	NOTE	-																					
SOV																																																									
POWER	DC24V																																																								
RMT/LCL	OPEN																																																								
NOTE	-																																																								
Rev. No.		0	1	2				PROJECT			(TSQ B)																																														
DATE		2021/6/21	2021/12/15	2022/11/8				Van Phong 1 BOT Thermal Power Plant Project 2×673MW																																																	
CONTENTS		1st Issue	Revised (0007, 0015)	Revised (0045)				TITLE			DRAWING No.													SH	REV. MARK																																
								BFPT A MSV B/S DV (2)			4GCH01007													TM580	2																																
								Equipment No. : OMAL81AA401																																																	

	A	B	C	D	E	F	G	H	I	J	K	L	M	N	O	P	Q	R	S	T	U	V	W	X	Y	Z	AA			
	Line Name			From	LID	Logic Chart																	LID	To	Line Name					
1	BFPT A GLD STM PRESS NORM BFPT A CV CLS BFPT A SPD >2900rpm			TM106	29																		01	TM585	BFPT A MSV A/S DV A-OPN CMD		1			
2																											2			
3																											3			
4																											4			
5						01	TM374	01																		02	TM585	BFPT A MSV A/S DV A-CLS CMD		5
6																														6
7																														7
8																														8
9																														9
10																														10
11																														11
12																														12
13																														13
14																														14
15																														15

Rev. No.	0							PROJECT Van Phong 1 BOT Thermal Power Plant Project 2×673MW	(TSQ B)			
DATE	2021/6/21											
CONTENTS	1st Issue							TITLE BFPT A MSV A/S DV (1)	DRAWING No. 4GCH01007	SH TM584	REV. MARK 0	
								Equipment No. : _OMAL81AA402				

	A	B	C	D	E	F	G	H	I	J	K	L	M	N	O	P	Q	R	S	T	U	V	W	X	Y	Z	AA																								
	Line Name			From	LID	Logic Chart																	LID	To	Line Name																										
1				TM584	01	10MAL81AA402 BFPT A MSV A/S DV S-SOV-EC MAN Auto Close Open Auto Auto Manual CL DMD Auto OP RTE-OP F-OP RTE-CL OP INH ABN Auto CL F-CL CL INH E-FAIL Open Closed OP-QTY CL-QTY <td rowspan="4">11</td> <td rowspan="4">TM445 TM477A</td> <td colspan="3" rowspan="4"></td> <td rowspan="4">2</td>																				11	TM445 TM477A				2																				
3																																3																			
4																																4																			
5																																5																			
6	BFPT A MSV A/S DV A- CLS CMD			TM584	02																		Z2	TM585	BFPT A MSV A/S DV CL SD			6																							
7	BFPT A MSV A/S DV OP N																												Z1	TM585	BFPT A MSV A/S DV OP N			7																	
8	BFPT A MSV A/S DV CL SD			TM585	Z2																		Z3		BFPT A MSV A/S DV CL S QB			8																							
9	BFPT A MSV A/S DV OP N QB																												Z4		BFPT A MSV A/S DV OP N QB			9																	
10																											21	TM450							BFPT A MSV A/S DV AB N			13													
11																																		14																	
12																																						15													
13				TM450	21																		21		BFPT A MSV A/S DV AB N				13																						
14																											14																								
15																												15																							
Rev. No.		0	1	2				PROJECT						(TSQ B)																																					
DATE		2021/6/21	2021/12/15	2022/11/8				Van Phong 1 BOT Thermal Power Plant Project 2×673MW																																											
CONTENTS		1st Issue	Revised (0007, 0015)	Revised (0045)				TITLE						DRAWING No.						SH			REV. MARK																												
								BFPT A MSV A/S DV (2)						4GCH01007						TM585			2																												
								Equipment No. : 0MAL81AA402																																											

A	B	C	D	E	F	G	H	I	J	K	L	M	N	O	P	Q	R	S	T	U	V	W	X	Y	Z	AA	
Line Name			From	LID	Logic Chart																	LID	To	Line Name			
1	BFPT A CSG DV A-OPN CMD			TM589	01	10LAC50AA201 BFPT A CSG DV MOV2-SH MAN Close Stop Auto Open Auto Manual Auto OP F-OP OP INH Auto SP Auto CL F-CL CL INH Local E-FAIL OV TRQ Open Closed OP-QTY CL-QTY POS Auto OP DMD SP DMD CL DMD RTE-OP RTE-CL ABN Torque Seating = 1 BIF-1 X1 OPN CMD Z1 X2 CLS CMD Z2 Z3 Z4 Z5 Z6 Z7 BIF 207 BIF207C02 DTD DTD DTD DTD DTD DTD TBL-1 MOV POWER POSN IND SEAT TYP HOLD TYP RMT/LCL NOTE AC400V YES TORQUE SELF HOLD YES -																	11	TD362 TM445 TM477A	BFPT A CSG DV AUTO		1
2																							31		BFPT A CSG DV OPN CMD		2
3																							32		BFPT A CSG DV CLS CMD		3
4																							Z1	TD361 TM447 TM590	BFPT A CSG DV OPN		4
5																							Z2		BFPT A CSG DV CLS		5
6																											6
7																											7
8																											8
9																							Z3	TM590	BFPT A CSG DV OV TRQ		9
10																							Z4	TM590	BFPT A CSG DV LCL SEL		10
11																							Z6	TM590	BFPT A CSG DV E-FAIL		11
12																							Z7		BFPT A CSG DV CLS QB		12
13																							Z5		BFPT A CSG DV OPN QB		13
14																							21	TD363 TM450	BFPT A CSG DV ABN		14
15																											15
Rev. No.			0	1	2	3	PROJECT										(TSQ B)										
DATE			2021/6/21	2021/12/15	2022/11/8	2023/7/5	Van Phong 1 BOT Thermal Power Plant Project 2×673MW																				
CONTENTS			1st Issue	Revised (0007, 0015, 0026)	Revised (0045)	Revised (0103)	TITLE										DRAWING No.			SH		REV. MARK					
							BFPT A CSG DV (2)										4GCH01007			TM590		3					
							Equipment No. : 0LAC50AA201																				

	A	B	C	D	E	F	G	H	I	J	K	L	M	N	O	P	Q	R	S	T	U	V	W	X	Y	Z	AA																			
	Line Name			From	LID	Logic Chart																	LID	To	Line Name																					
1																												1																		
2	BFPT A EXH HOOD DV O PN CMD (SP1)			TM390	.03																							2																		
3																												3																		
4	BFPT A EXH VLV OPN			TM605	.Z1																		01	TM595	BFPT A EXHD DV A-OPN CMD			4																		
5																							02	TM595	BFPT A EXHD DV A-CLS CMD			5																		
6	BFPT A GLD STM PRESS NORM			TM106	.29																							6																		
7	CONDR HTWL LVL HI HI			TM390	.02																		03	TM595	BFPT A EXHD DV F-CLS CMD			7																		
8																												8																		
9																												9																		
10																												10																		
11																												11																		
12																												12																		
13																												13																		
14																												14																		
15																												15																		
	Rev. No.		0																																											
	DATE		2021/6/21																																											
	CONTENTS		1st Issue																																											
														PROJECT														(TSQ B)																		
														Van Phong 1 BOT Thermal Power Plant Project 2×673MW																																
														TITLE														DRAWING No.														SH		REV. MARK		
														BFPT A EXHD DV (1)														4GCH01007														TM594		0		
														Equipment No. : OLAC50AA203																																

	A	B	C	D	E	F	G	H	I	J	K	L	M	N	O	P	Q	R	S	T	U	V	W	X	Y	Z	AA	
	Line Name			From	LID	Logic Chart																	LID	To	Line Name			
1																												1
2	BFPT A GLD STM DV OP N CMD (SP1)			TM390	04																							2
3																												3
4					Z1																		01	TM600	BFPT A SSH DV A-OPN CMD			4
5																							02	TM600	BFPT A SSH DV A-CLS CMD			5
6	BFPT A GLD STM PRESS NORM			TM106	29																							6
7	CONDR HTWL LVL HI HI			TM390	02																		03	TM600	BFPT A SSH DV F-CLS CMD			7
8																												8
9																												9
10																												10
11																												11
12																												12
13																												13
14																												14
15																												15

Rev. No.	0								PROJECT	(TSQ B)			
DATE	2021/6/21								Van Phong 1 BOT Thermal Power Plant Project 2×673MW				
CONTENTS	1st Issue								TITLE	DRAWING No.	SH	REV. MARK	
									BFPT A SSH DV (1)	4GCH01007	TM599	0	
									Equipment No. : _OMAW55AA401				

	A	B	C	D	E	F	G	H	I	J	K	L	M	N	O	P	Q	R	S	T	U	V	W	X	Y	Z	AA																								
	Line Name			From	LID	Logic Chart																	LID	To	Line Name																										
1	BFPT A SSH DV A-OPN CMD			TM599	01	10MAW55AA401 BFPT A SSH DV S-SOV-EC MAN Auto Close Open Auto Auto Manual CL DMD Auto OP RTE-OP F-OP RTE-CL OP INH ABN Auto CL F-CL CL INH E-FAIL Open Closed OP-QTY CL-QTY BIF-1 X1 OPN CMD Z1 X2 CLS CMD Z2 Z3 Z4 Z5 Z6 Z7 BIF 207 BIF207D01 DTD DTD																							11	TD362	BFPT A SSH DV AUTO			1																	
2																													2																						
3																													3																						
4																													4																						
5				TM599	02																			TD361 TM447 TM600	BFPT A SSH DV OPN			5																							
6																									BFPT A SSH DV CLSD			6																							
6	BFPT A SSH DV F-CLS CMD			TM599	03																			Z1	BFPT A SSH DV CLS QB			7																							
7	BFPT A SSH DV OPN																											7																							
8	BFPT A SSH DV CLSD			TM600	Z2																		Z3	BFPT A SSH DV OPN QB			8																								
9	BFPT A SSH DV CLSD																											9																							
10				TM600	Z2																		Z4	BFPT A SSH DV OPN QB			10																								
11																												11																							
12																												12																							
13																											21	BFPT A SSH DV ABN			13																				
14																															14																				
15																															15																				
Rev. No.		0	1		2									PROJECT		(TSQ B)																																			
DATE		2021/6/21	2021/12/15	2022/11/8									Van Phong 1 BOT Thermal Power Plant Project 2×673MW																																						
CONTENTS		1st Issue	Revised (0007, 0015)	Revised (0045)									TITLE		DRAWING No.					SH		REV. MARK																													
													BFPT A SSH DV (2)		4GCH01007					TM600		2																													
													Equipment No. : 0MAW55AA401																																						

	A	B	C	D	E	F	G	H	I	J	K	L	M	N	O	P	Q	R	S	T	U	V	W	X	Y	Z	AA																									
	Line Name			From	LID	Logic Chart																		LID	To	Line Name																										
1						10LBR30AA201 BFPT A EXH VLV MOV2-NSH - Close - Open Auto Manual Auto OP F-OP OP INH Auto CL F-CL CL INH Local E-FAIL OV TRQ Open Closed POS Auto OP DMD CL DMD ABN Torque Seating = 0 DTD DTD DTD DTD DTD BIF-1 X1 X2 OPN CMD CLS CMD Z1 Z2 Z3 Z4 Z5 Z6 Z7 BIF 207 BIF207C02 TBL-1 MOV POWER POSN IND SEAT TYP HOLD TYP RMT/LCL NOTE AC400V YES LIMIT NON SELF YES -																																														
2																																																				
3																																																				
4																																																				
5																																																				
6																																																				
7																																																				
8																																																				
9	BFPT A EXH VLV OV TRQ			TM605	Z3																				TM605	BFPT A EXH VLV OV TRQ																										
10	BFPT A EXH VLV OPN			TM605	Z1																					BFPT A EXH VLV LCL SEL																										
11	BFPT A EXH VLV CLS			TM605	Z2																					BFPT A EXH VLV E-FAIL																										
12																										BFPT A EXH VLV ABN																										
13																																																				
14	BFPT A EXH VLV POSN			TM173	Y3	0 100 %																																														
15																																																				
	Rev.No.	0	1	2										PROJECT										(TSQ B)																												
	DATE	2021/6/21	2021/12/15	2022/11/8										Van Phong 1 BOT Thermal Power Plant Project 2×673MW																																						
	CONTENTS	1st Issue	Revised (0015)	Revised (0046, 0048)										TITLE										DRAWING No.					SH					REV. MARK																		
														BFPT A EXH VLV										4GCH01007					TM605					2																		
														Equipment No. : _OLBR30AA201																																						

	A	B	C	D	E	F	G	H	I	J	K	L	M	N	O	P	Q	R	S	T	U	V	W	X	Y	Z	AA						
	Line Name			From	LID	Logic Chart																	LID	To	Line Name								
1	BFPT B MSV TRIP SOLV A1 ENRGZ CMD BFPT B MSV TRIP SOLV A1 ENRGZ CMD BFPT B MSV TRIP SOLV A2 ENRGZ CMD BFPT B MSV TRIP SOLV A2 ENRGZ CMD BFPT B MSV TRIP SOLV B1 ENRGZ CMD BFPT B MSV TRIP SOLV B1 ENRGZ CMD BFPT B MSV TRIP SOLV B2 ENRGZ CMD BFPT B MSV TRIP SOLV B2 ENRGZ CMD			TSQ-B (TM654)	A	10XAX21AA659 BFPT B MSV TRIP SOLV A1 ENERGIZE DE-ENERGIZED 10XAX21AA661 BFPT B MSV TRIP SOLV A2 ENERGIZE DE-ENERGIZED 10XAX21AA663 BFPT B MSV TRIP SOLV B1 ENERGIZE DE-ENERGIZED 10XAX21AA665 BFPT B MSV TRIP SOLV B2 ENERGIZE DE-ENERGIZED BFPT B MSV TRIP VALVE OPERATE RESET 10XAA20AA601 BFPT B MSV CLOSE NOTE : — — — — — HYDRAULIC TBL-1 <table><tr><th colspan="2">SOV</th></tr><tr><td>POWER</td><td>DC24V</td></tr><tr><td>FAIL ACT</td><td>CLOSE</td></tr><tr><td>NOTE</td><td>-</td></tr></table>																	SOV		POWER	DC24V	FAIL ACT	CLOSE	NOTE	-			
SOV																																	
POWER																							DC24V										
FAIL ACT																							CLOSE										
NOTE				-																													
2																																	
3																																	
Rev.No.	1	2						PROJECT	LOCAL															
DATE	2021/12/15	2022/11/8						Van Phong 1 BOT Thermal Power Plant Project 2x673MW																
CONTENTS	Added	Revised (0062)						TITLE											DRAWING No.				SH	REV. MARK
									BFPT B MSV											4GCH01007				TM652
								Equipment No. :10XAA20AA601																


	A	B	C	D	E	F	G	H	I	J	K	L	M	N	O	P	Q	R	S	T	U	V	W	X	Y	Z	AA					
	Line Name			From	LID	Logic Chart																	LID	To	Line Name							
1	BFPT B MAN TRIP PB (CCR)			TM271	Y4	10CWA10EA012ZV62 BFPT B MAN TRIP PB (CCR) DALM QTY QTY ALM= 1																			01	TM650	BFPT B MAN TRIP PB			1		
2																														2		
3																														3		
4																														4		
5																														5		
6																														6		
7																														7		
8																														8		
9																														9		
10																														10		
11																														11		
12																														12		
13																														13		
14																														14		
15																														15		
Rev. No.		0		2										PROJECT				(TSQ B)														
DATE		2021/6/21		2022/11/8										Van Phong 1 BOT Thermal Power Plant Project 2×673MW																		
CONTENTS		1st Issue		Revised & Tuning (0064)										TITLE				DRAWING No.					SH			REV. MARK						
														BFPT B TRIP (3)				4GCH01007					TM653			2						
														Equipment No. : -																		

	A	B	C	D	E	F	G	H	I	J	K	L	M	N	O	P	Q	R	S	T	U	V	W	X	Y	Z	AA			
	Line Name			From	LID	Logic Chart																	LID	To	Line Name					
1	BFPT B MAN TRIP PB F ROM LCL			TM274	Y4	10XAY21EZ031ZV62 BFPT B MAN TRIP PB F ROM LCL DALM QTY QTY ALM= 1																			01	TM650	BFPT B MAN TRIP PB F ROM LCL			1
2																														2
3																														3
4																														4
5	BFPT B TRIP			TM651	22	DTD IODO-1 IO DO 10CBE20EA007YB00 BFPT B TRIP BFP EHC																			5	TM650	BFPT B TRIP			5
6																														6
7																														7
8																														8
9	BFPT B TRIP SOLV A E NRGZ CMD			TM651	21	DTD IODO-2 IO DO 10XAX21AA659YB21 BFPT B MSV TRIP SOLV A1 ENRGZ CMD LOCAL DTD IODO-3 IO DO 10XAX21AA661YB21 BFPT B MSV TRIP SOLV A2 ENRGZ CMD LOCAL DTD IODO-4 IO DO 10XAX21AA663YB21 BFPT B MSV TRIP SOLV B1 ENRGZ CMD LOCAL DTD IODO-5 IO DO 10XAX21AA665YB21 BFPT B MSV TRIP SOLV B2 ENRGZ CMD LOCAL																			9	TM650	BFPT B TRIP SOLV A E NRGZ CMD			9
10																														10
11																														11
12																														12
13						DTD IODO-3 IO DO 10XAX21AA661YB21 BFPT B MSV TRIP SOLV A2 ENRGZ CMD LOCAL																			9	TM650	BFPT B TRIP SOLV A E NRGZ CMD			13
14																														14
15																														15
Rev. No.		0		1		2								PROJECT		(TSQ B)														
DATE		2021/6/21		2021/12/15		2022/11/8								Van Phong 1 BOT Thermal Power Plant Project 2×673MW																
CONTENTS		1st Issue		Revised (0015)		Revised & Tuning (0062, 0064)										TITLE		DRAWING No.				SH		REV. MARK						
																BFPT B TRIP (4)		4GCH01007				TM654		2						
														Equipment No. : -																

	A	B	C	D	E	F	G	H	I	J	K	L	M	N	O	P	Q	R	S	T	U	V	W	X	Y	Z	AA	
	Line Name			From	LID	Logic Chart																	LID	To	Line Name			
1	BFPT B D EHC HEAVY F AIL			BFPTEHC	A	10CGB20EA001YB00 BFPT B D EHC HEAVY F AIL DALM QTY QTY ALM= 0 • → → DTD DTD • → IODO-1 IODO-2 IO DO IO DO 10CGB20EA001YB00 BFPT B EHC HEAVY FAI L A TSQ B (TM273) 10CGB20EA003YB00 BFPT B EHC HEAVY FAI L B TSQ B (TM273) 01 <td colspan="3">BFPT B D EHC HEAVY F AIL</td><td></td>																	BFPT B D EHC HEAVY F AIL					
2																							2					
3																							3					
4																							4					
5																							5					
6																							6					
7																							7					
8																							8					
9																							9					
10																							10					
11																							11					
12																							12					
13																							13					
14																							14					
15																							15					

Notes:
This CIRCUIT IS MADE BY A HARD WIRED IN BFPT-B EHC

Rev. No.	2							PROJECT	BFPT-B-EHC			
DATE	2022/11/8							Van Phong 1 BOT Thermal Power Plant Project 2×673MW				
CONTENTS	Sheet Added & TUNING (0062, 0064, 0084)							TITLE	DRAWING No.	SH	REV. MARK	
								BFPT B TRIP (6)	4GCH01007	TM656	2	
								Equipment No. : -				

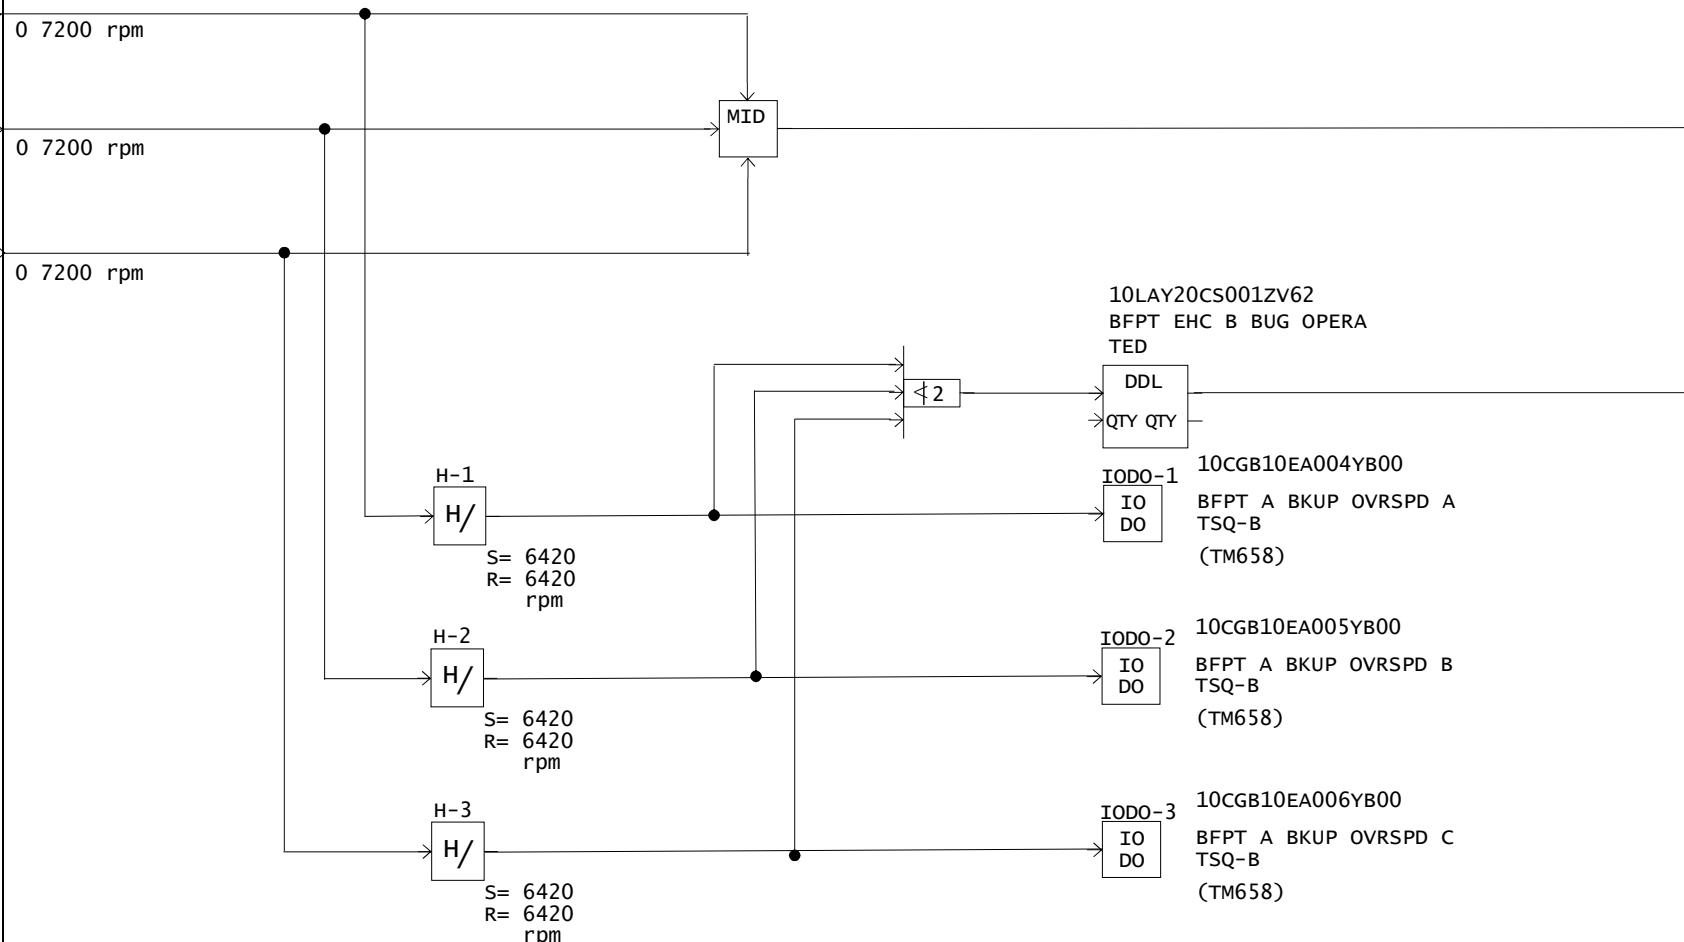
	A	B	C	D	E	F	G	H	I	J	K	L	M	N	O	P	Q	R	S	T	U	V	W	X	Y	Z	AA			
	Line Name			From	LID	Logic Chart																	LID	To	Line Name					
1	BFPT B SPD A BFPT B SPD B BFPT B SPD C			TM176	Y1 Y2 Y3																		01		BFPT B SPD					
2																														
3																														
Rev.No.				1	2	3					PROJECT					(BFPT B EHC)														
DATE				2021/12/15	2022/11/8	2023/7/5					Van Phong 1 BOT Thermal Power Plant Project 2x673MW																			
CONTENTS				Added	Revised (0062)	Revised					TITLE					DRAWING No.					SH		REV. MARK							
											BFPT B TRIP (7)					4GCH01007					TM657		3							
											Equipment No. : -																			

	A	B	C	D	E	F	G	H	I	J	K	L	M	N	O	P	Q	R	S	T	U	V	W	X	Y	Z	AA		
	Line Name			From	LID	Logic Chart																	LID	To	Line Name				
1	BFPT B OVRSPD A			LOCAL	A																		L	TM161	BFPT B OVRSPD A			1	
2																							M		BFPT B OVRSPD B			2	
3																							N		BFPT B OVRSPD C			3	
4																							C		TM659	BFPT B OVRSPD A			4
5																							D			BFPT B OVRSPD B			5
6																							E			BFPT B OVRSPD C			6
7																							A		TM652	BFPT B MSV TRIP SOLV A1 ENRGZ CMD			7
8																							Q						
9	B	TM652	BFPT B MSV TRIP SOLV A2 ENRGZ CMD			9																							
10	BFPT B BKUP OVRSPD A			BFPT-EHC (TM657)																		R	TM270	BFPT B BKUP OVRSPD			10		
11	BFPT B BKUP OVRSPD B			BFPT-EHC (TM657)																		F	TM659	BFPT B BKUP OVRSPD A			11		
12	BFPT B BKUP OVRSPD C			BFPT-EHC (TM657)																		G	TM659	BFPT B BKUP OVRSPD B			12		
13	BFPT B MAN TRIP PB D (CCR)			CCR DESK	G																		H	TM659	BFPT B BKUP OVRSPD C			13	
14	BFPT B MAN TRIP PB E (CCR)			CCR DESK	H																		O	TM659	BFPT B TRIP PB(CCR)			14	
15	BFPT B MAN TRIP PB FROM LCL D			LOCAL	I																		P	TM659	BFPT B TRIP PB(LCL)			15	
15	BFPT B MAN TRIP PB FROM LCL E			LOCAL	J	Notes: This CIRCUIT IS MADE BY A HARD WIRED IN TSQ																					15		
Rev.No.		1	2											PROJECT				TSQ-B											
DATE		2021/12/15	2022/11/8											Van Phong 1 BOT Thermal Power Plant Project 2x673MW															
CONTENTS		Added	Revised (0062)											TITLE				DRAWING No.				SH		REV. MARK					
														BFPT B TRIP (8)				4GCH01007				TM658		2					
															Equipment No. : -														

	A	B	C	D	E	F	G	H	I	J	K	L	M	N	O	P	Q	R	S	T	U	V	W	X	Y	Z	AA	
	Line Name			From	LID	Logic Chart																	LID	To	Line Name			
1				TM658	C																			TM652	BFPT B MSV TRIP SOLV B1 ENRGZ CMD			
2																												
3																												
4																												
5	BFPT B OVSP A			TM658	C																							
6	BFPT B OVSP B			TM658	D																							
7	BFPT B OVSP C			TM658	E																							
8																												
9	BFPT B BKUP OVSP A			TM658	F																							
10	BFPT B BKUP OVSP B			TM658	G																							
11	BFPT B BKUP OVSP C			TM658	H																							
12																												
13	BFPT B TRIP PB(CCR)			TM658	O																							
14	BFPT B TRIP PB(LCL)			TM658	P																							
15						Notes: This CIRCUIT IS MADE BY A HARD WIRED IN TSQ																						
Rev.No.		1	2						PROJECT										TSQ-B									
DATE		2021/12/15	2022/11/8						Van Phong 1 BOT Thermal Power Plant Project 2x673MW																			
CONTENTS		Added	Revised (0062)					TITLE										DRAWING No.					SH	REV. MARK				
								BFPT B TRIP (9)										4GCH01007										
								Equipment No. :-															TM659	2				


	A	B	C	D	E	F	G	H	I	J	K	L	M	N	O	P	Q	R	S	T	U	V	W	X	Y	Z	AA							
	Line Name			From	LID	Logic Chart																	LID	To	Line Name									
1	BFPT B MSV CLS			TM272	Y1	10XAX21EE053 BFPT B MSV TEST LPB-3 1TEST 2OPEN 3CLOSE 1 Lamp 2 Lamp 3 Lamp 1 PB ON 2 PB ON 3 PB ON 10DO-1 IO DO 10XAX21AA667YB21 BFPT B MSV TEST SOLV ENRGZ CMD LOCAL (TM661)																												
2																																		
3																																		
4																																		
5																												5						
6																												6						
7																												7						
8																												8						
9																												9						
10																												10						
11																												11						
12																												12						
13																												13						
14																												14						
15																												15						

Rev. No.	0	1	2	3				PROJECT Van Phong 1 BOT Thermal Power Plant Project 2×673MW	(TSQ B)		
DATE	2021/6/21	2021/12/15	2022/11/8	2023/7/5							
CONTENTS	1st Issue	Revised (0015, 0026)	Revised (0062)	Revised (0140, 0140R)				TITLE BFPT B MAIN STOP VALVE TEST (1)	DRAWING No. 4GCH01007	SH TM660	REV. MARK 3
								Equipment No. : -			

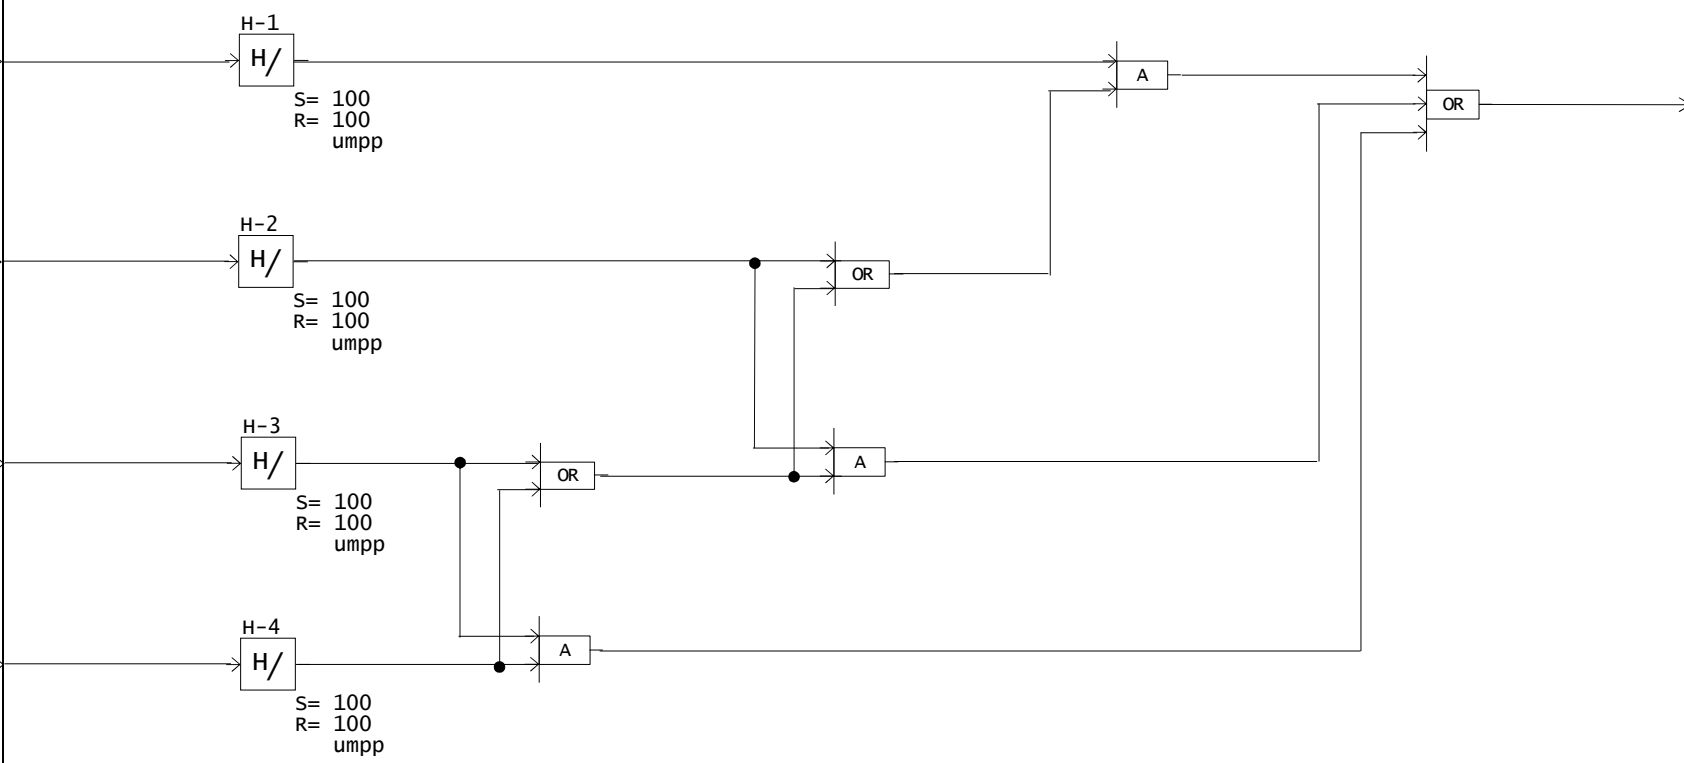
	A	B	C	D	E	F	G	H	I	J	K	L	M	N	O	P	Q	R	S	T	U	V	W	X	Y	Z	AA				
	Line Name			From	LID	Logic Chart																	LID	To	Line Name						
1	BFPT B BRG 1 VIB X			LOCAL	AI 01																		A	TM663	BFPT B VIB HI-TRP CNDN			1			
2																												2			
3																												3			
4																												4			
5	BFPT B BRG 1 VIB Y			LOCAL	AI 02																	A	TM663	BFPT B VIB HI-TRP CNDN			5				
6																											6				
7																											7				
8																											8				
9	BFPT B BRG 2 VIB X			LOCAL	AI 03																	A	TM663	BFPT B VIB HI-TRP CNDN			9				
10																											10				
11																											11				
12																											12				
13	BFPT B BRG 2 VIB Y			LOCAL	AI 04																	A	TM663	BFPT B VIB HI-TRP CNDN			13				
14																											14				
15																											15				
Rev.No.		1	2										PROJECT							(TSI)											
DATE		2021/12/15	2022/11/8										Van Phong 1 BOT Thermal Power Plant Project 2x673MW																		
CONTENTS		Added	Revised (0062)										TITLE							DRAWING No.				SH		REV. MARK					
												BFPT B BRG VIB TRIP (TSI) (1)							4GCH01007					TM662		2					
														Equipment No. : -																	

	A	B	C	D	E	F	G	H	I	J	K	L	M	N	O	P	Q	R	S	T	U	V	W	X	Y	Z	AA									
	Line Name			From	LID	Logic Chart																	LID	To	Line Name											
1	BFPT B BRG 1 VIB X HI HI >150umpp			LOCAL	DI 01																		A	TSQ B (TM270)	BFPT B BRG VIB HH A											
2																																				
3																																				
4				LOCAL	DI 02																	B	TSQ B (TM270)	BFPT B BRG VIB HH B												
5																																				
6	BFPT B BRG 2 VIB X HI HI > 150umpp			LOCAL	DI 03																		C	TSQ B (TM270)	BFPT B BRG VIB HH C											
7																																				
8	BFPT B BRG 2 VIB Y HI HI > 150umpp			LOCAL	DI 04																															
9	BFPT B VIB HI-TRP CNDN			TM662	A																															
10																																				
11																																				
12																																				
13																																				
14																																				
15																																				
Rev.No.				1	2	3					PROJECT										(TSI)															
DATE				2021/12/15	2022/11/8	2023/7/5					Van Phong 1 BOT Thermal Power Plant Project 2x673MW																									
CONTENTS				Added	Revised (0062)	Revised					TITLE										DRAWING No.			SH		REV. MARK										
											BFPT B BRG VIB TRIP (TSI) (2)										4GCH01007			TM663		3										
											Equipment No. : -																									

	A	B	C	D	E	F	G	H	I	J	K	L	M	N	O	P	Q	R	S	T	U	V	W	X	Y	Z	AA										
	Line Name			From	LID	Logic Chart																	LID	To	Line Name												
1	BFPT B SPD			TM194	01	Logic Chart ATA																	08	TE579 TM834	BFPT B SPD			1									
2																							A	TY306	BFPT B SPD			2									
3																							H-1 H/ S= 2900 R= 2850 rpm			01	TM729 TM734	BFPT B SPD >2900rpm			3						
4																										L-1 /L S= 2000 R= 2050 rpm			02	TM739	BFPT B SPD <2000rpm			4			
5																													H-2 H/ S= 3000 R= 2950 rpm			03	TM739	BFPT B SPD >3000rpm			5
6																																H-3 H/ S= 700 R= 650 rpm			04	TM834	BFPT B SPD >700rpm
7																										L-2 /L S= 0 R= 2 rpm			05	TM310	BFPT B SPD NO SPD				7		
8																							H-4 H/ S= 1500 R= 1450 rpm						06	10LAY20EE151zv00 BFPT B SPD >102% DDL QTY QTY			BFPT B SPD >1500rpm			8	
9																										H-5 H/ S= 6120 R= 6100 rpm			07				TM651	BFPT B SPD >102%			9
10																																			10		
11																																			11		
12																																			12		
13																																			13		
14																																			14		
15																																			15		
	Rev. No.	0	1	2																																	
	DATE	2021/6/21	2021/12/15	2022/11/8																																	
	CONTENTS	1st Issue	Revised (0007, 0026)	Revised (0032, 0045, 0056, 0062)																																	

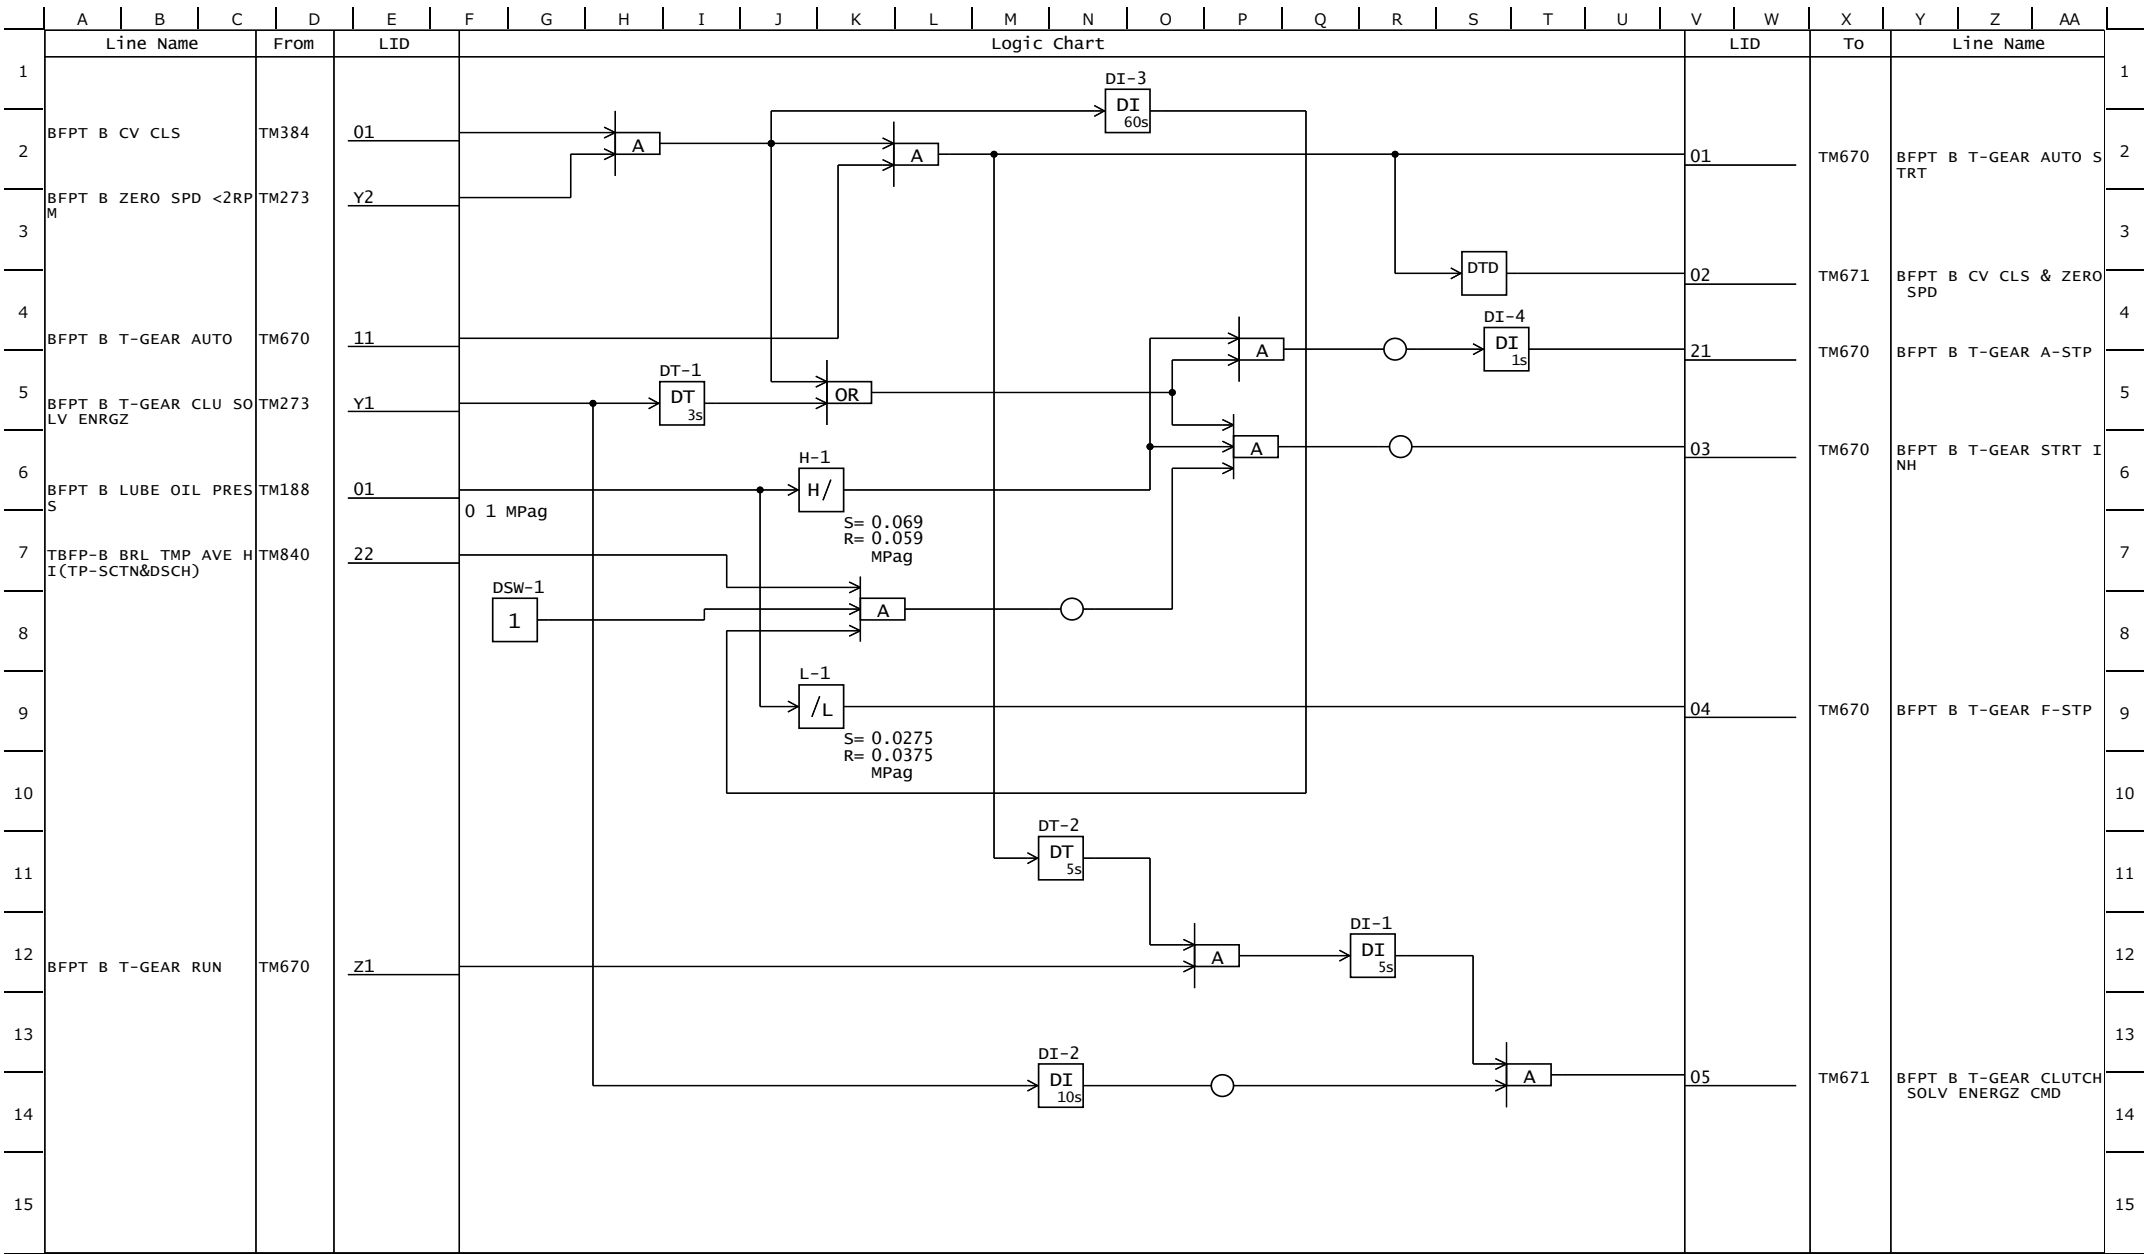

Rev. No.	0	1	2	3				PROJECT	(TSQ B)			
DATE	2021/6/21	2021/12/15	2022/11/8	2023/7/5				Van Phong 1 BOT Thermal Power Plant Project 2×673MW				
CONTENTS	1st Issue	Revised (0015)	Revised (0062, 0056, 0064)	Revised (0152, 0163)				TITLE	DRAWING No.	SH	REV. MARK	
								BFPT B TURNING GEAR (1)	4GCH01007	TM669	3	
								Equipment No. : _0XAA20AE001				

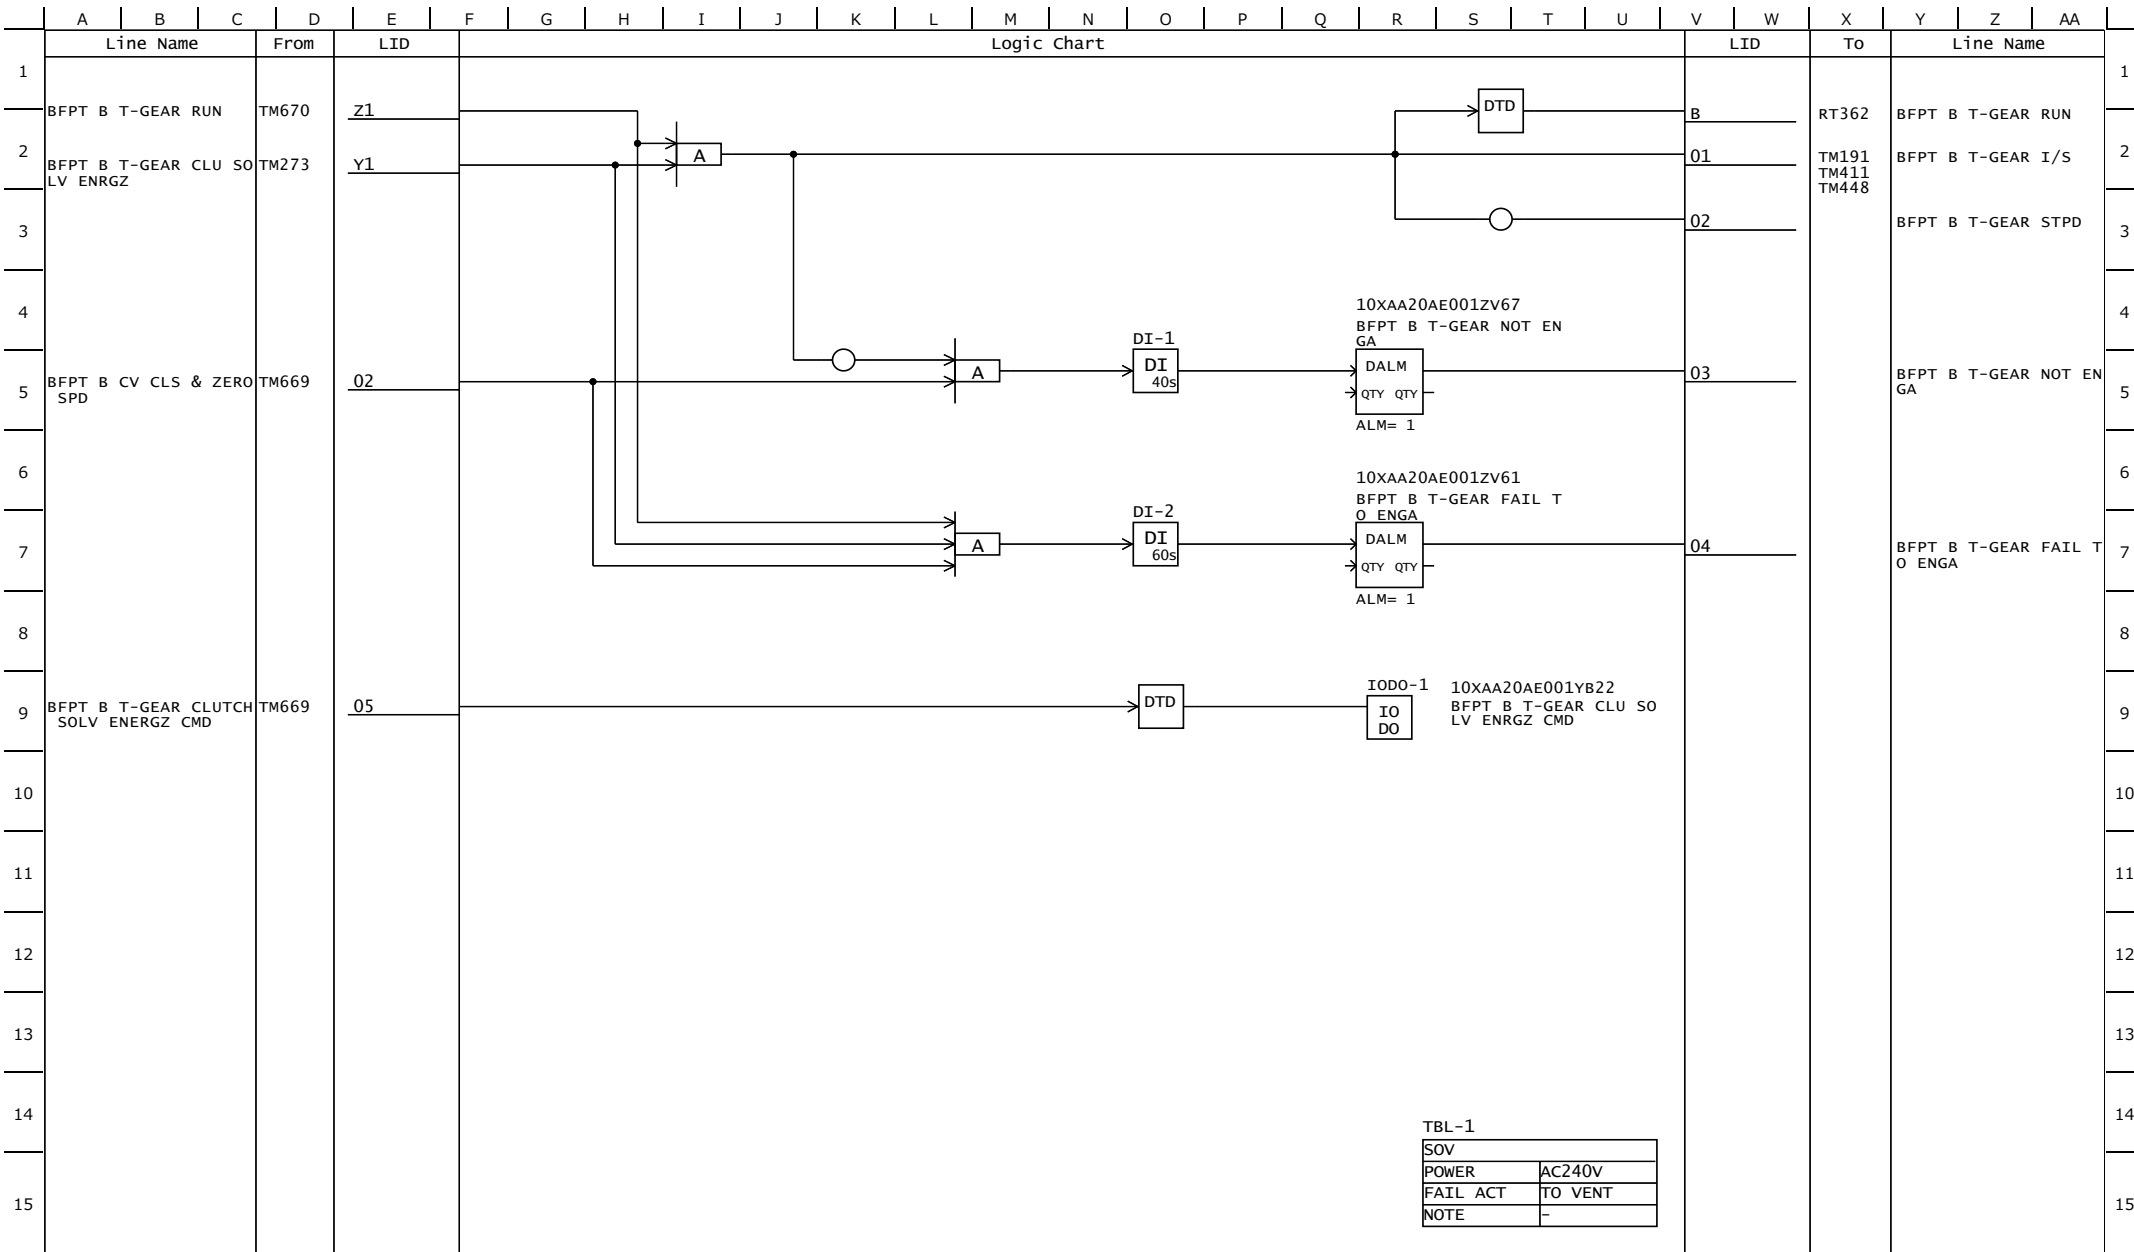

TBL-1	
SOV	
POWER	AC240V
FAIL ACT	TO VENT
NOTE	-

Rev. No.	0	1	2	3				PROJECT	(TSQ B)			
DATE	2021/6/21	2021/12/15	2022/11/8	2023/7/5				Van Phong 1 BOT Thermal Power Plant Project 2×673MW				
CONTENTS	1st Issue	Revised (0007, 0015)	Revised & Tuning (0064, 0065)	Revised (0110)				TITLE	DRAWING No.	SH	REV. MARK	
								BFPT B TURNING GEAR (3)	4GCH01007	TM671	3	
								Equipment No. : _0XAA20AE001				


	A	B	C	D	E	F	G	H	I	J	K	L	M	N	O	P	Q	R	S	T	U	V	W	X	Y	Z	AA
	Line Name			From	LID	Logic Chart																	LID	To	Line Name		
1						10XAV21EE001 BFPT B MOP SEL SEL-2PB 1PUMP A 2PUMP B 1 REQ 1 SEL 2 REQ 2 SEL 1 INH 2 INH 01 02																					
2																											
3																											
Rev. No.				0		1		2								PROJECT		(TSQ B)									
DATE				2021/6/21		2021/12/15		2022/11/8								Van Phong 1 BOT Thermal Power Plant Project 2×673MW											
CONTENTS				1st Issue		Revised (0015)		Revised (0032)								TITLE		DRAWING No.				SH		REV. MARK			
																BFPT B MAIN OIL PUMP SELECTOR		4GCH01007				TM680		2			
																Equipment No. : _OXAV21/22AP001											

	A	B	C	D	E	F	G	H	I	J	K	L	M	N	O	P	Q	R	S	T	U	V	W	X	Y	Z	AA	
	Line Name			From	LID	Logic Chart																	LID	To	Line Name			
1	BFPT B MOP B TRIP			TM690	19																		01	TM683	BFPT B MOP A BKUP ST	RT		1
2					Y3																				2			
3																									3			
4																									4			
5	BFPT B MOP A TRIP			TM685	19																		02	TM683	BFPT B MOP B BKUP ST	RT		5
6																									6			
7																									7			
8																									8			
9	BFPT B MOP A RUN			TM685	Z1																						9	
10																									10			
11																									11			
12																									12			
12	BFPT B MOP B RUN			TM690	Z1																						12	
13																									13			
14																									14			
15																												15

Rev. No.	0	2						PROJECT	(TSQ B)			
DATE	2021/6/21	2022/11/8						Van Phong 1 BOT Thermal Power Plant Project 2×673MW				
CONTENTS	1st Issue	Revised (0064)						TITLE	DRAWING No.	SH	REV. MARK	
								BFPT B MAIN OIL PUMP BACK UP STRT	4GCH01007	TM682	2	
								Equipment No. : _OXAV21/22AP001				

	A	B	C	D	E	F	G	H	I	J	K	L	M	N	O	P	Q	R	S	T	U	V	W	X	Y	Z	AA	
	Line Name			From	LID	Logic Chart																	LID	To	Line Name			
1																												1
2																												2
3																												3
4																												4
5																												5
6																												6
7																												7
8	BFPT B MAIN OIL PUMP A STRT CMD			TM418	11																		11	TM685	BFPT B MOP A A-STRT CMD			8
9				TM682	01																							9
10	BFPT B MOP A BKUP ST RT																						12	TM685	BFPT B MOP A A-STP C MD			10
11																												11
12	BFPT B MAIN OIL PUMP B STRT CMD			TM418	12																		21	TM690	BFPT B MOP B A-STRT CMD			12
13				TM682	02																							13
14	BFPT B MOP B BKUP ST RT																						22	TM690	BFPT B MOP B A-STP C MD			14
15																												15

Rev. No.	0	1	2					PROJECT	(TSQ B)			
DATE	2021/6/21	2021/12/15	2022/11/8					Van Phong 1 BOT Thermal Power Plant Project 2×673MW				
CONTENTS	1st Issue	Revised (0015)	Revised (0032)					TITLE	DRAWING No.	SH	REV. MARK	
								BFPT B MAIN OIL PUMP LDG MSTR	4GCH01007	TM683	2	
								Equipment No. : _OXAV21/22AP001				

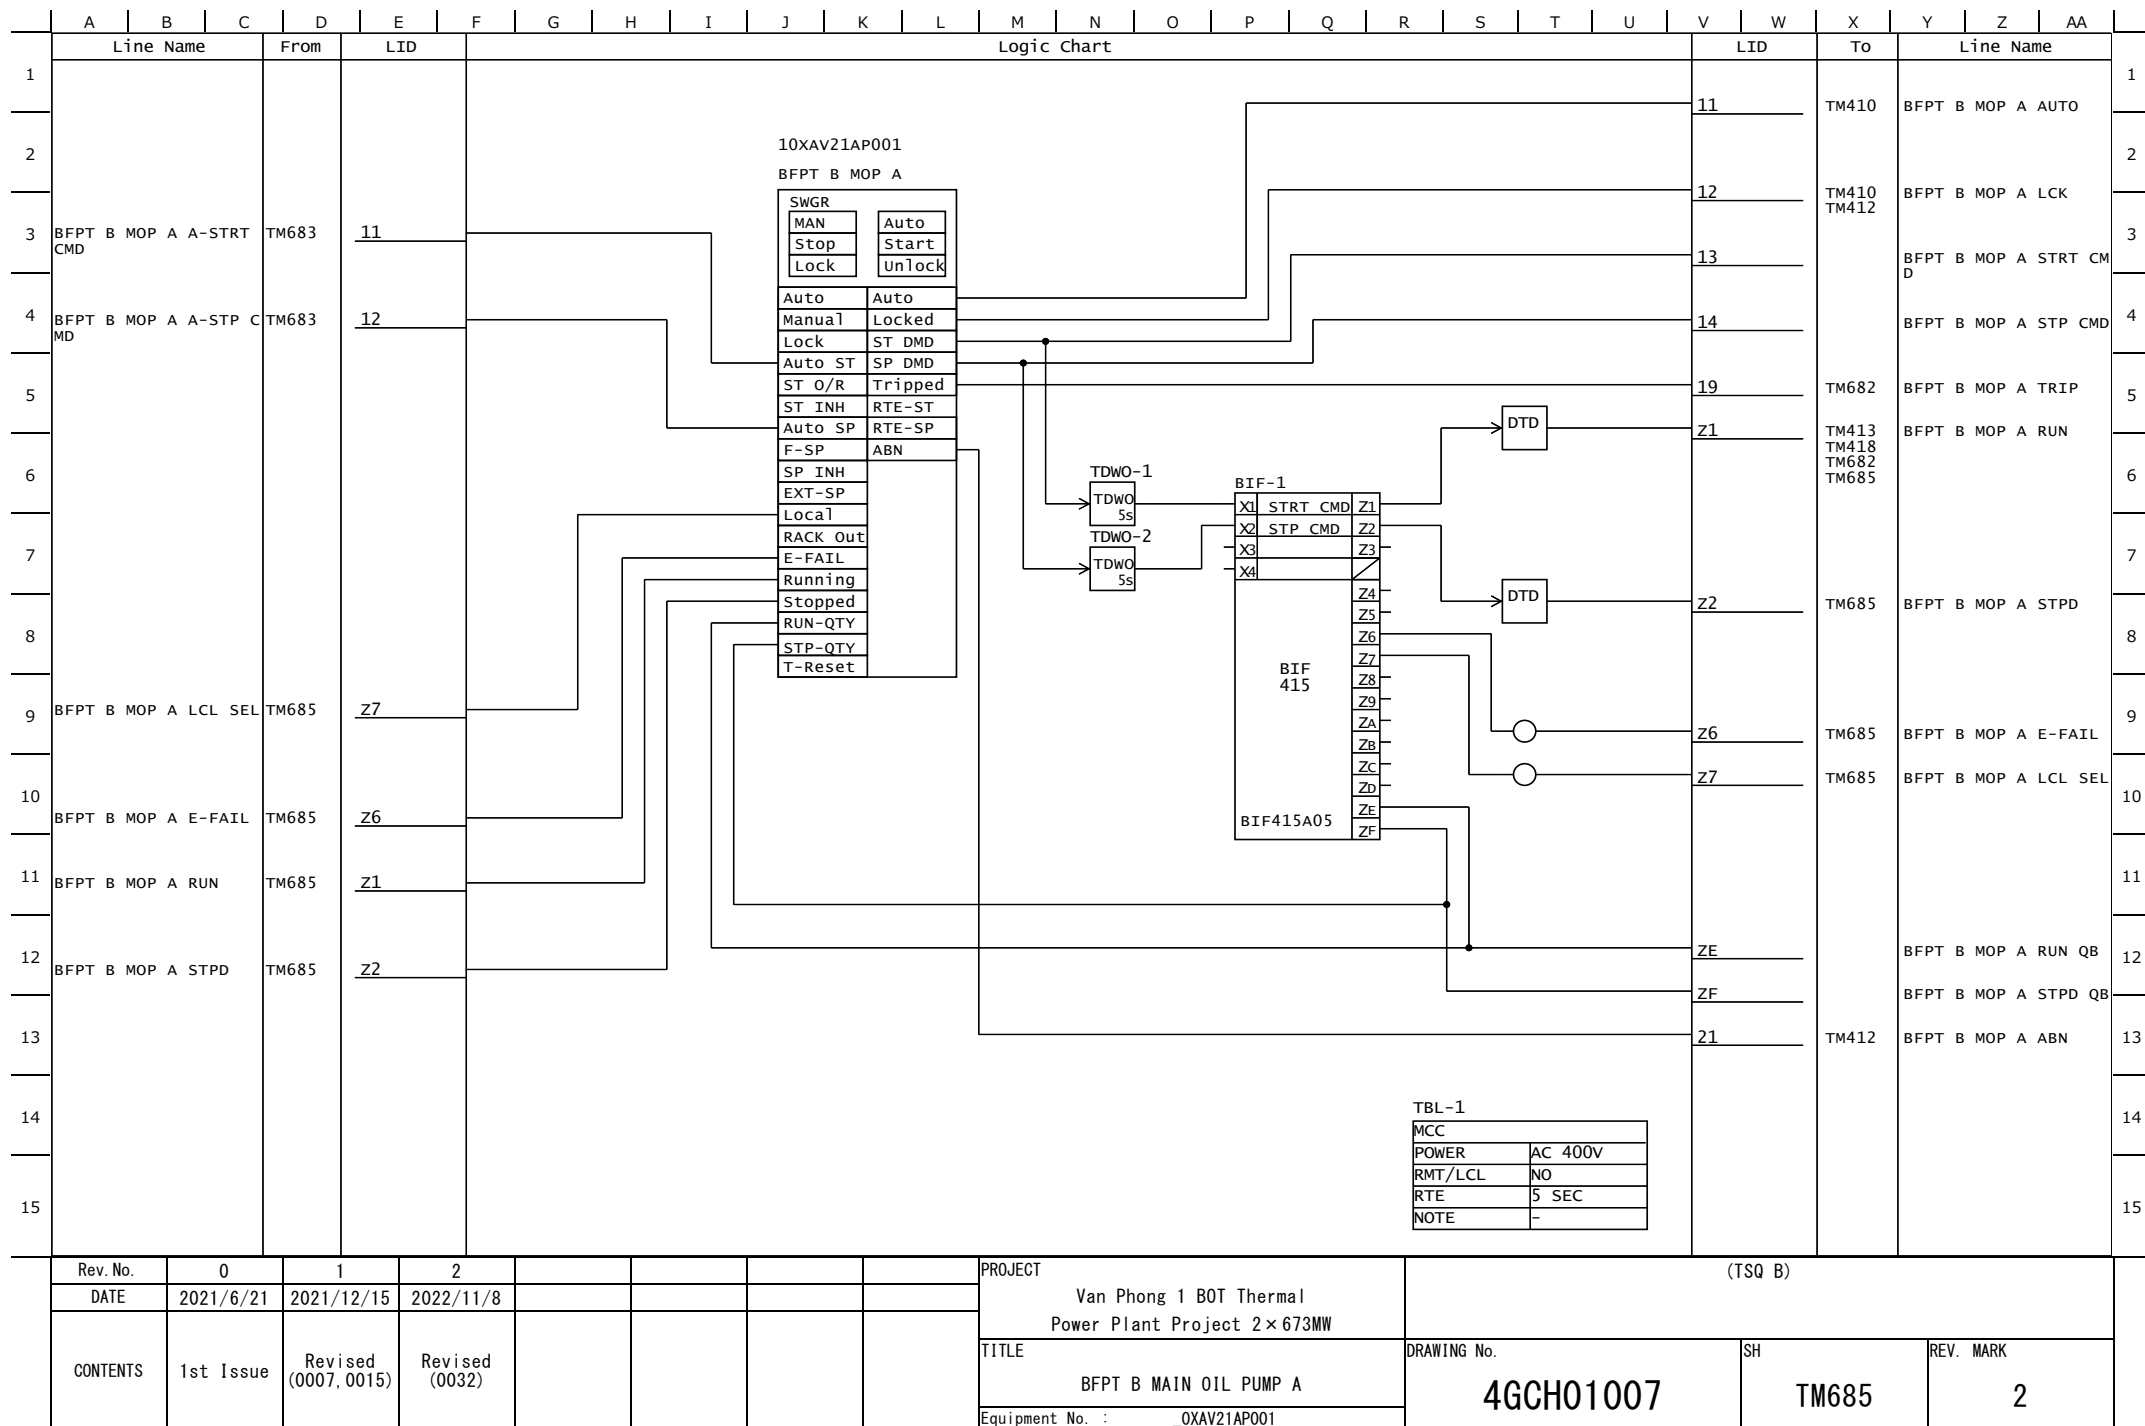

A	B	C	D	E	F	G	H	I	J	K	L	M	N	O	P	Q	R	S	T	U	V	W	X	Y	Z	AA				
Line Name			From	LID	Logic Chart																	LID	To	Line Name						
1	BFPT B MOP B A-STRT CMD			TM683	21	10XAV22AP001 BFPT B MOP B SWGR MAN Stop Lock Auto Start Unlock Auto Manual Lock Auto ST ST O/R ST INH Auto SP F-SP SP INH EXT-SP Local RACK Out E-FAIL Running Stopped RUN-QTY STP-QTY T-Reset Auto Locked ST DMD SP DMD Tripped RTE-ST RTE-SP ABN TDWO-1 5s TDWO-2 5s BIF-1 X1 X2 X3 X4 Z1 Z2 Z3 Z4 Z5 Z6 Z7 Z8 Z9 ZA ZB ZC ZD ZE ZF BIF 415 BIF415A05 DTD DTD DTD																	11	TM410	BFPT B MOP B AUTO					
2																							12	TM410 TM412	BFPT B MOP B LCK					
3																							13		BFPT B MOP B STRT CMD					
4																							14		BFPT B MOP B STP CMD					
5																							19	TM682	BFPT B MOP B TRIP					
6																							Z1	TM413 TM418 TM682 TM690	BFPT B MOP B RUN					
7																														
8																							Z2	TM690	BFPT B MOP B STPD					
9																							Z6	TM690	BFPT B MOP B E-FAIL					
10																							Z7	TM690	BFPT B MOP B LCL SEL					
11																							Z1							
12																							ZE		BFPT B MOP B RUN QB					
	ZF		BFPT B MOP B STPD QB																											
13	21	TM412	BFPT B MOP B ABN																											
14	TBL-1 <table><tr><td>EMCC</td><td></td></tr><tr><td>POWER</td><td>AC 400V</td></tr><tr><td>RMT/LCL</td><td>NO</td></tr><tr><td>RTE</td><td>5 SEC</td></tr><tr><td>NOTE</td><td>-</td></tr></table>																	EMCC		POWER	AC 400V	RMT/LCL	NO	RTE	5 SEC	NOTE	-			
EMCC																														
POWER	AC 400V																													
RMT/LCL	NO																													
RTE	5 SEC																													
NOTE	-																													
15																														

Rev. No.	0	1	2						PROJECT	(TSQ B)			
DATE	2021/6/21	2021/12/15	2022/11/8						Van Phong 1 BOT Thermal Power Plant Project 2×673MW				
CONTENTS	1st Issue	Revised (0007, 0015)	Revised (0032)					TITLE	DRAWING No.		SH	REV. MARK	
								BFPT B MAIN OIL PUMP B		4GCH01007		TM690	2
								Equipment No. : 0XAV22AP001					


TOSHIBA ENERGY SYSTEMS & SOLUTIONS CORPORATION (work in TOSHIBA PLANT SYSTEMS & SERVICES CORPORATION)

A	B	C	D	E	F	G	H	I	J	K	L	M	N	O	P	Q	R	S	T	U	V	W	X	Y	Z	AA
Line Name			From	LID	Logic Chart																	LID	To	Line Name		
1	BFPT B EOP DC PWR FA IL			TM695	Z8	10XAV23AP001 BFPT B EOP SWGR - Stop - - Start - Auto Auto Manual Locked Lock ST DMD Auto ST SP DMD ST O/R Tripped ST INH RTE-ST Auto SP RTE-SP F-SP ABN SP INH EXT-SP Local RACK Out E-FAIL Running Stopped RUN-QTY STP-QTY T-Reset 10XAV23AP001ZV63 BFPT B EOP DC PWR FA IL DDL QTY QTY 10XAV23AP001XB01 BFPT B EOP RUN DALM QTY QTY ALM= 1 10XAV23AP001ZV67 BFPT B EOP E-FAIL DALM QTY QTY ALM= 1 DT 2s DT 2s BIF-1 X1 STRT CMD Z1 X2 STP CMD Z2 X3 Z3 X4 Z4 Z5 Z6 Z7 Z8 Z9 ZA ZB ZC ZD ZE ZF BIF 415 BIF415A03 DTD DTD DTD DT 2s <																				

	A	B	C	D	E	F	G	H	I	J	K	L	M	N	O	P	Q	R	S	T	U	V	W	X	Y	Z	AA														
	Line Name			From	LID	Logic Chart																	LID	To	Line Name																
1	BFPT B EOP STRT CMD			TSQ B (TM695)	A																			LOCAL	BFPT B EOP STRT CMD																
2																																									
3				LOCAL	DI																			LOCAL																	
4																																									
5				MCC																																					
6																																									
7				MCC																																					
8																																									
9	BFPT B EOP STP CMD			TSQ B (TM695)	B	NOTE: 1.EOP MOTOR CONTROL CENTER (EOP MCC) MUST BE ALWAYS SWITCHED ON AND THE POWER SUPPLY MUST BE VITAL EXCEPT WHILE TURBINE ROTATION IS COMPLETELY STOPPED. 2.AT THE STAGE OF START UP, EOP MCC MUST BE SWITCHED ON BEFORE TURNING AND AFTER A MAIN OIL PUMP STARTED. 3.AT THE STAGE OF SHUT DOWN, EOP MCC MUST BE SWITCHED OFF AFTER TURNING COMPLETELY STOPPED AND BEFORE A MAIN OIL PUMP STOPPED. 4.THE STOP POSITION OF CONTROL SWITCH WITHOUT A LOCK POSITION IS USED TO WIPE OUT THE START HOLD CIRCUIT ON BEARING OI PRESSUER ESTABLISHED, AFTER AUTO START TEST IS CARRIED OUT WITH OIL DUMP OF THE PRESSURE SWITCH ON AN INSTRUMENT PIPE, OR AFTER ANY OTHER STARTING OPERATION. 5.THIS CONTROL LOGIC MUST BE MADE BY A HARDWIRED CIRCUIT. Notes: THIS CONTROL IS MADE BY HARD-WIRED CIRCUIT (ON DC MCC)																																			
10																																									
11																																									
12																																									
13																																									
14																																									
15																																									
Rev.No.		1	2						PROJECT										DC-MCC																						
DATE		2021/12/15	2022/11/8						Van Phong 1 BOT Thermal Power Plant Project 2x673MW																																
CONTENTS		Added	Revised (0064)					TITLE										DRAWING No.				SH		REV. MARK																	
								BFPT B EMARGENCY OIL PUMP (2)										4GCH01007				TM696		2																	
Equipment No. : -																																									

	A	B	C	D	E	F	G	H	I	J	K	L	M	N	O	P	Q	R	S	T	U	V	W	X	Y	Z	AA		
	Line Name			From	LID	Logic Chart																	LID		To	Line Name			
1	BFPT B OIL TNK VAP E XTRCTR STRT CMD			TM416																					BFPT B OIL TNK VAP E XTRCTR STRT CMD			1	
2					11																			2					
3					05																			3					
4					03																		01	TM700				4	
5	BFPT B LUBE OIL PRES S LO			TM188																					BFPT B OIL TNK VAP E XTRCTR STOP CMD			5	
6																								6					
7																								7					
8																								8					
9	BFPT B OIL SYS STRT MSTR S-PRCD			TM415																					BFPT B OIL TNK VAP E XTRCTR STOP CMD			9	
10																								10					
11																								11					
12																								12					
13																												13	
14																								14					
15																								15					

Rev. No.	0	1						PROJECT	(TSQ B)			
DATE	2021/6/21	2021/12/15						Van Phong 1 BOT Thermal Power Plant Project 2×673MW				
CONTENTS	1st Issue	Revised (0015)						TITLE	DRAWING No.	SH	REV. MARK	
								BFPT B OIL TNK VAP EXTRCTR (1)	4GCH01007	TM699	1	
								Equipment No. : _OXAQ20AN001				

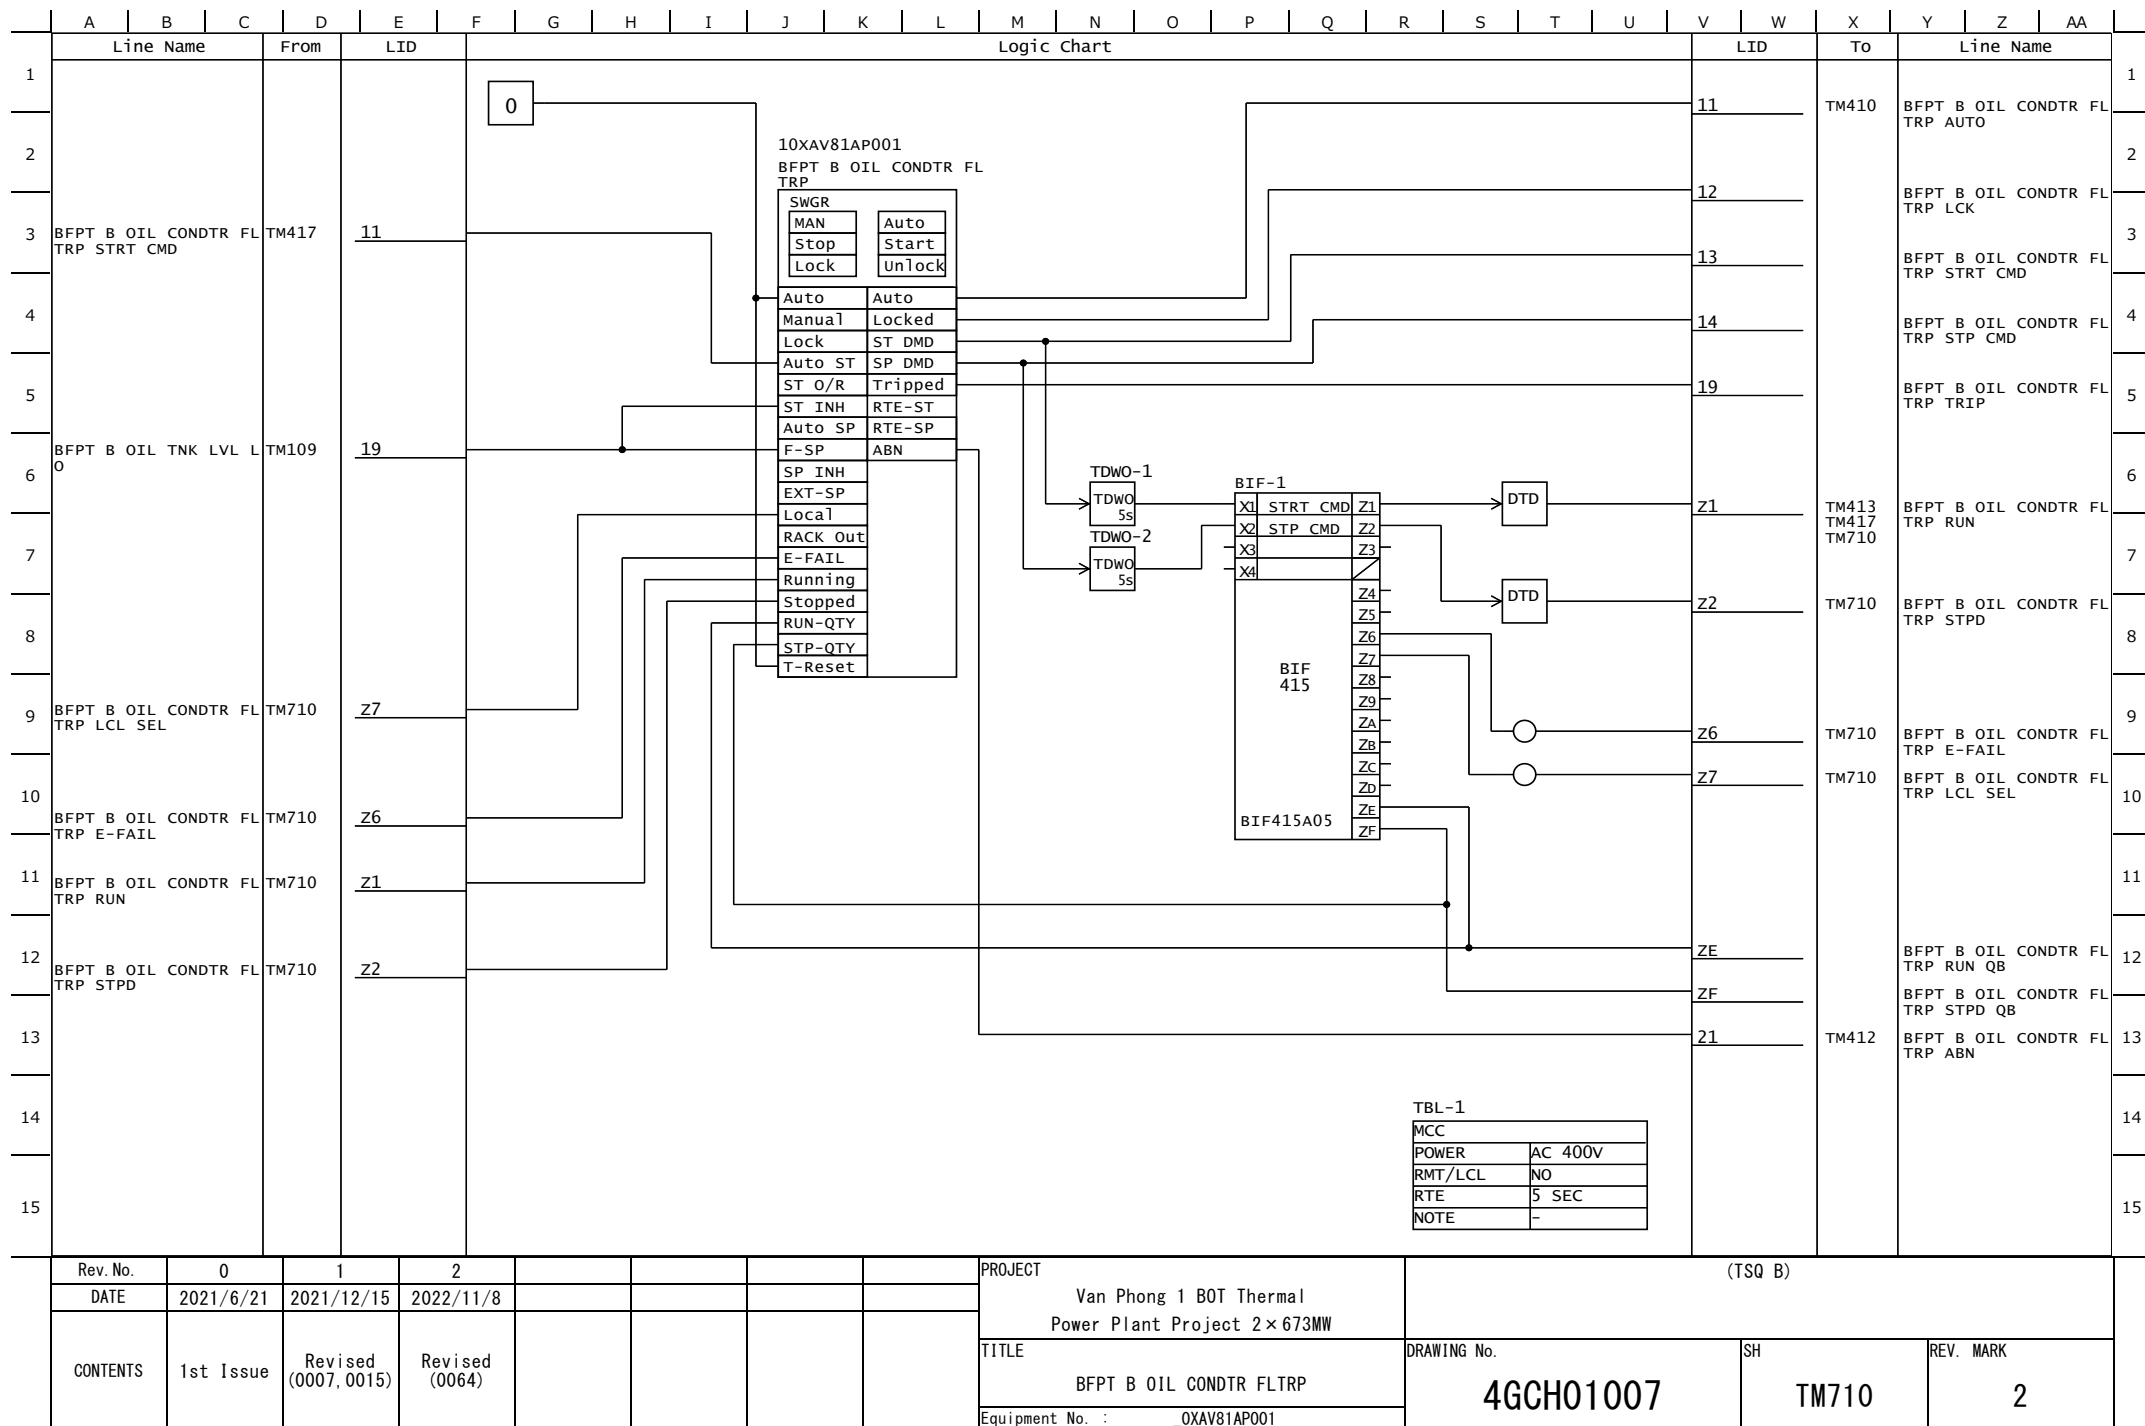

	A	B	C	D	E	F	G	H	I	J	K	L	M	N	O	P	Q	R	S	T	U	V	W	X	Y	Z	AA																										
	Line Name			From	LID	Logic Chart																	LID	To	Line Name																												
1				TM729	01	10MAL91AA401 BFPT B MSV B/S DV S-SOV-EC MAN Auto Close Open Auto Auto Manual CL DMD Auto OP RTE-OP F-OP RTE-CL OP INH ABN Auto CL F-CL CL INH E-FAIL Open Closed OP-QTY CL-QTY																				11	TM446 TM477B	BFPT B MSV B/S DV AU TO		1																							
2																													2																								
3																													3																								
4																													4																								
5	BFPT B MSV B/S DV A- OPN CMD			TM729	02																		Z1	TM730	BFPT B MSV B/S DV OP N		5																										
6	BFPT B MSV B/S DV A- CLS CMD																												6																								
7	BFPT B MSV B/S DV OP N			TM730	Z1																		Z2	TM730	BFPT B MSV B/S DV CL SD		7																										
8	BFPT B MSV B/S DV CL SD																												8																								
9				TM730	Z2																		Z3	TM451	BFPT B MSV B/S DV CL S QB		9																										
10																													10																								
11																													11																								
12																													12																								
13				TM451	Z4																		Z4	TM451	BFPT B MSV B/S DV AB N		13																										
14																													14																								
15																													15																								
Rev. No.		0	1	2					PROJECT				(TSQ B)																																								
DATE		2021/6/21	2021/12/15	2022/11/8					Van Phong 1 BOT Thermal Power Plant Project 2×673MW																																												
CONTENTS		1st Issue	Revised (0007, 0015)	Revised (0045)					TITLE				DRAWING No.				SH		REV. MARK																																		
									BFPT B MSV B/S DV (2)				4GCH01007				TM730		2																																		
									Equipment No. : 0MAL91AA401																																												

	A	B	C	D	E	F	G	H	I	J	K	L	M	N	O	P	Q	R	S	T	U	V	W	X	Y	Z	AA	
	Line Name			From	LID	Logic Chart																	LID	To	Line Name			
1	BFPT B GLD STM PRESS NORM			TM109	29																		01	TM735	BFPT B MSV A/S DV A-OPN CMD			1
2																												2
3																												3
4																												4
5																												5
6																												6
7																												7
8																												8
9																												9
10																												10
11																												11
12																												12
13																												13
14																												14
15																												15

Rev. No.	0							PROJECT	(TSQ B)			
DATE	2021/6/21							Van Phong 1 BOT Thermal Power Plant Project 2×673MW				
CONTENTS	1st Issue							TITLE	DRAWING No.	SH	REV. MARK	
								BFPT B MSV A/S DV (1)	4GCH01007	TM734	0	
								Equipment No. : _OMAL91AA402				

	A	B	C	D	E	F	G	H	I	J	K	L	M	N	O	P	Q	R	S	T	U	V	W	X	Y	Z	AA										
	Line Name			From	LID	Logic Chart																	LID	To	Line Name												
1	BFPT B MSV A/S DV A-OPN CMD BFPT B MSV A/S DV A-CLS CMD BFPT B MSV A/S DV OP N BFPT B MSV A/S DV CL SD			TM734	01 02 Z1 Z2	10MAL91AA402 BFPT B MSV A/S DV S-SOV-EC MAN Auto Close Open Auto Auto Manual CL DMD Auto OP RTE-OP F-OP RTE-CL OP INH ABN Auto CL F-CL CL INH E-FAIL Open Closed OP-QTY CL-QTY BIF-1 X1 OPN CMD Z1 X2 CLS CMD Z2 Z3 Z4 Z5 Z6 Z7 BIF 207 BIF207D01 DTD DTD																	11	TM446 TM477B	BFPT B MSV A/S DV AU TO	2											
3								3																													
4								4																													
5								5																													
6								6																													
7								7																													
8								8																													
9								9																													
10								10																													
11								11																													
12								12																													
13								13																													
14								14																													
15								15																													
						TBL-1 <table><tr><td>SOV</td><td></td></tr><tr><td>POWER</td><td>DC24V</td></tr><tr><td>RMT/LCL</td><td>OPEN</td></tr><tr><td>NOTE</td><td>-</td></tr></table>																	SOV				POWER	DC24V	RMT/LCL	OPEN	NOTE	-					
SOV																																					
POWER	DC24V																																				
RMT/LCL	OPEN																																				
NOTE	-																																				
<table><tr><td>Rev. No.</td><td>0</td><td>1</td><td>2</td><td></td><td></td><td></td><td></td></tr><tr><td>DATE</td><td>2021/6/21</td><td>2021/12/15</td><td>2022/11/8</td><td></td><td></td><td></td><td></td></tr></table>					Rev. No.	0	1	2					DATE	2021/6/21	2021/12/15	2022/11/8					PROJECT Van Phong 1 BOT Thermal Power Plant Project 2×673MW										(TSQ B)						
Rev. No.	0	1	2																																		
DATE	2021/6/21	2021/12/15	2022/11/8																																		
<table><tr><td>CONTENTS</td><td>1st Issue</td><td>Revised (0007, 0015)</td><td>Revised (0045)</td><td></td><td></td><td></td><td></td></tr></table>					CONTENTS	1st Issue	Revised (0007, 0015)	Revised (0045)					TITLE BFPT B MSV A/S DV (2)										DRAWING No. 4GCH01007			SH TM735		REV. MARK 2									
CONTENTS	1st Issue	Revised (0007, 0015)	Revised (0045)																																		
					Equipment No. : 0MAL91AA402																																

BIF-1

X1

X2

OPN_CMD

CLS_CMD

Z1

Z2

Z3

Z4

Z5

Z6

Z7

BIF

207

BIF207D01

DTD

DTD

11

Z1

Z2

Z3

Z4

21

TM446

TM477B

TM448

TM735

TM735

TM451

BFPT B MSV A/S DV AU

TO

BFPT B MSV A/S DV OP

N

BFPT B MSV A/S DV CL

SD

BFPT B MSV A/S DV CL

S QB

BFPT B MSV A/S DV OP

N QB

BFPT B MSV A/S DV AB

N

1

2

3

BFPT B MSV A/S DV A-
OPN CMD

BFPT B MSV A/S DV A-
CLS CMD

BFPT B MSV A/S DV OP
N

BFPT B MSV A/S DV CL
SD

TBL-1

SOV

POWER

RMT/LCL

NOTE


DC24V

OPEN


-

Rev. No.	0	1	2					PROJECT Van Phong 1 BOT Thermal Power Plant Project 2×673MW	(TSQ B)		
DATE	2021/6/21	2021/12/15	2022/11/8								
CONTENTS	1st Issue	Revised (0007, 0015)	Revised (0045)					TITLE	DRAWING No.	SH	REV. MARK
								BFPT B MSV A/S DV (2)	4GCH01007	TM735	2
								Equipment No. : 0MAL91AA402			

	A	B	C	D	E	F	G	H	I	J	K	L	M	N	O	P	Q	R	S	T	U	V	W	X	Y	Z	AA																			
	Line Name			From	LID	Logic Chart																	LID	To	Line Name																					
1																												1																		
2	BFPT B EXH HOOD DV O PN CMD (SP1)			TM390	.06																							2																		
3																												3																		
4	BFPT B EXH VLV OPN			TM755	.Z1																		.01	TM745	BFPT B EXHD DV A-OPN CMD			4																		
5																							.02	TM745	BFPT B EXHD DV A-CLS CMD			5																		
6	BFPT B GLD STM PRESS NORM			TM109	.29																							6																		
7	CONDR HTWL LVL HI HI			TM390	.02																		.03	TM745	BFPT B EXHD DV F-CLS CMD			7																		
8																												8																		
9																												9																		
10																												10																		
11																												11																		
12																												12																		
13																												13																		
14																												14																		
15																												15																		
	Rev. No.		0																																											
	DATE		2021/6/21																																											
	CONTENTS		1st Issue																																											
														PROJECT														(TSQ B)																		
														Van Phong 1 BOT Thermal Power Plant Project 2×673MW																																
														TITLE														DRAWING No.														SH		REV. MARK		
														BFPT B EXHD DV (1)														4GCH01007														TM744		0		
														Equipment No. : OLAC60AA203																																

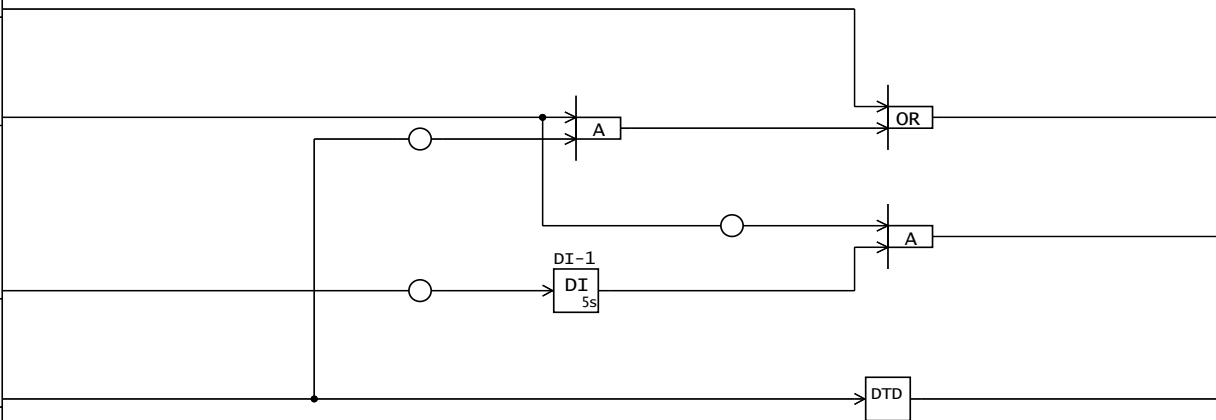
	A	B	C	D	E	F	G	H	I	J	K	L	M	N	O	P	Q	R	S	T	U	V	W	X	Y	Z	AA	
	Line Name			From	LID	Logic Chart																	LID	To	Line Name			
1	BFPT B GLD STM DV OP N CMD (SP1)			TM390																				TM750	BFPT B SSH DV A-OPN CMD			
2					07																							
3					21																							
4																												
5	BFPT B GLD STM PRESS NORM			TM109	29																		02	TM750	BFPT B SSH DV A-CLS CMD			
6																												
7					02																		03	TM750	BFPT B SSH DV F-CLS CMD			
8																												
9	CONDR HTWL LVL HI HI			TM390																				TM750	BFPT B SSH DV F-CLS CMD			
10																												
11																												
12																												
13																												
14																												
15																												


Rev. No.	0							PROJECT	(TSQ B)			
DATE	2021/6/21							Van Phong 1 BOT Thermal Power Plant Project 2×673MW				
CONTENTS	1st Issue							TITLE	DRAWING No.	SH	REV. MARK	
								BFPT B SSH DV (1)	4GCH01007	TM749	0	
								Equipment No. : _OMAW65AA401				

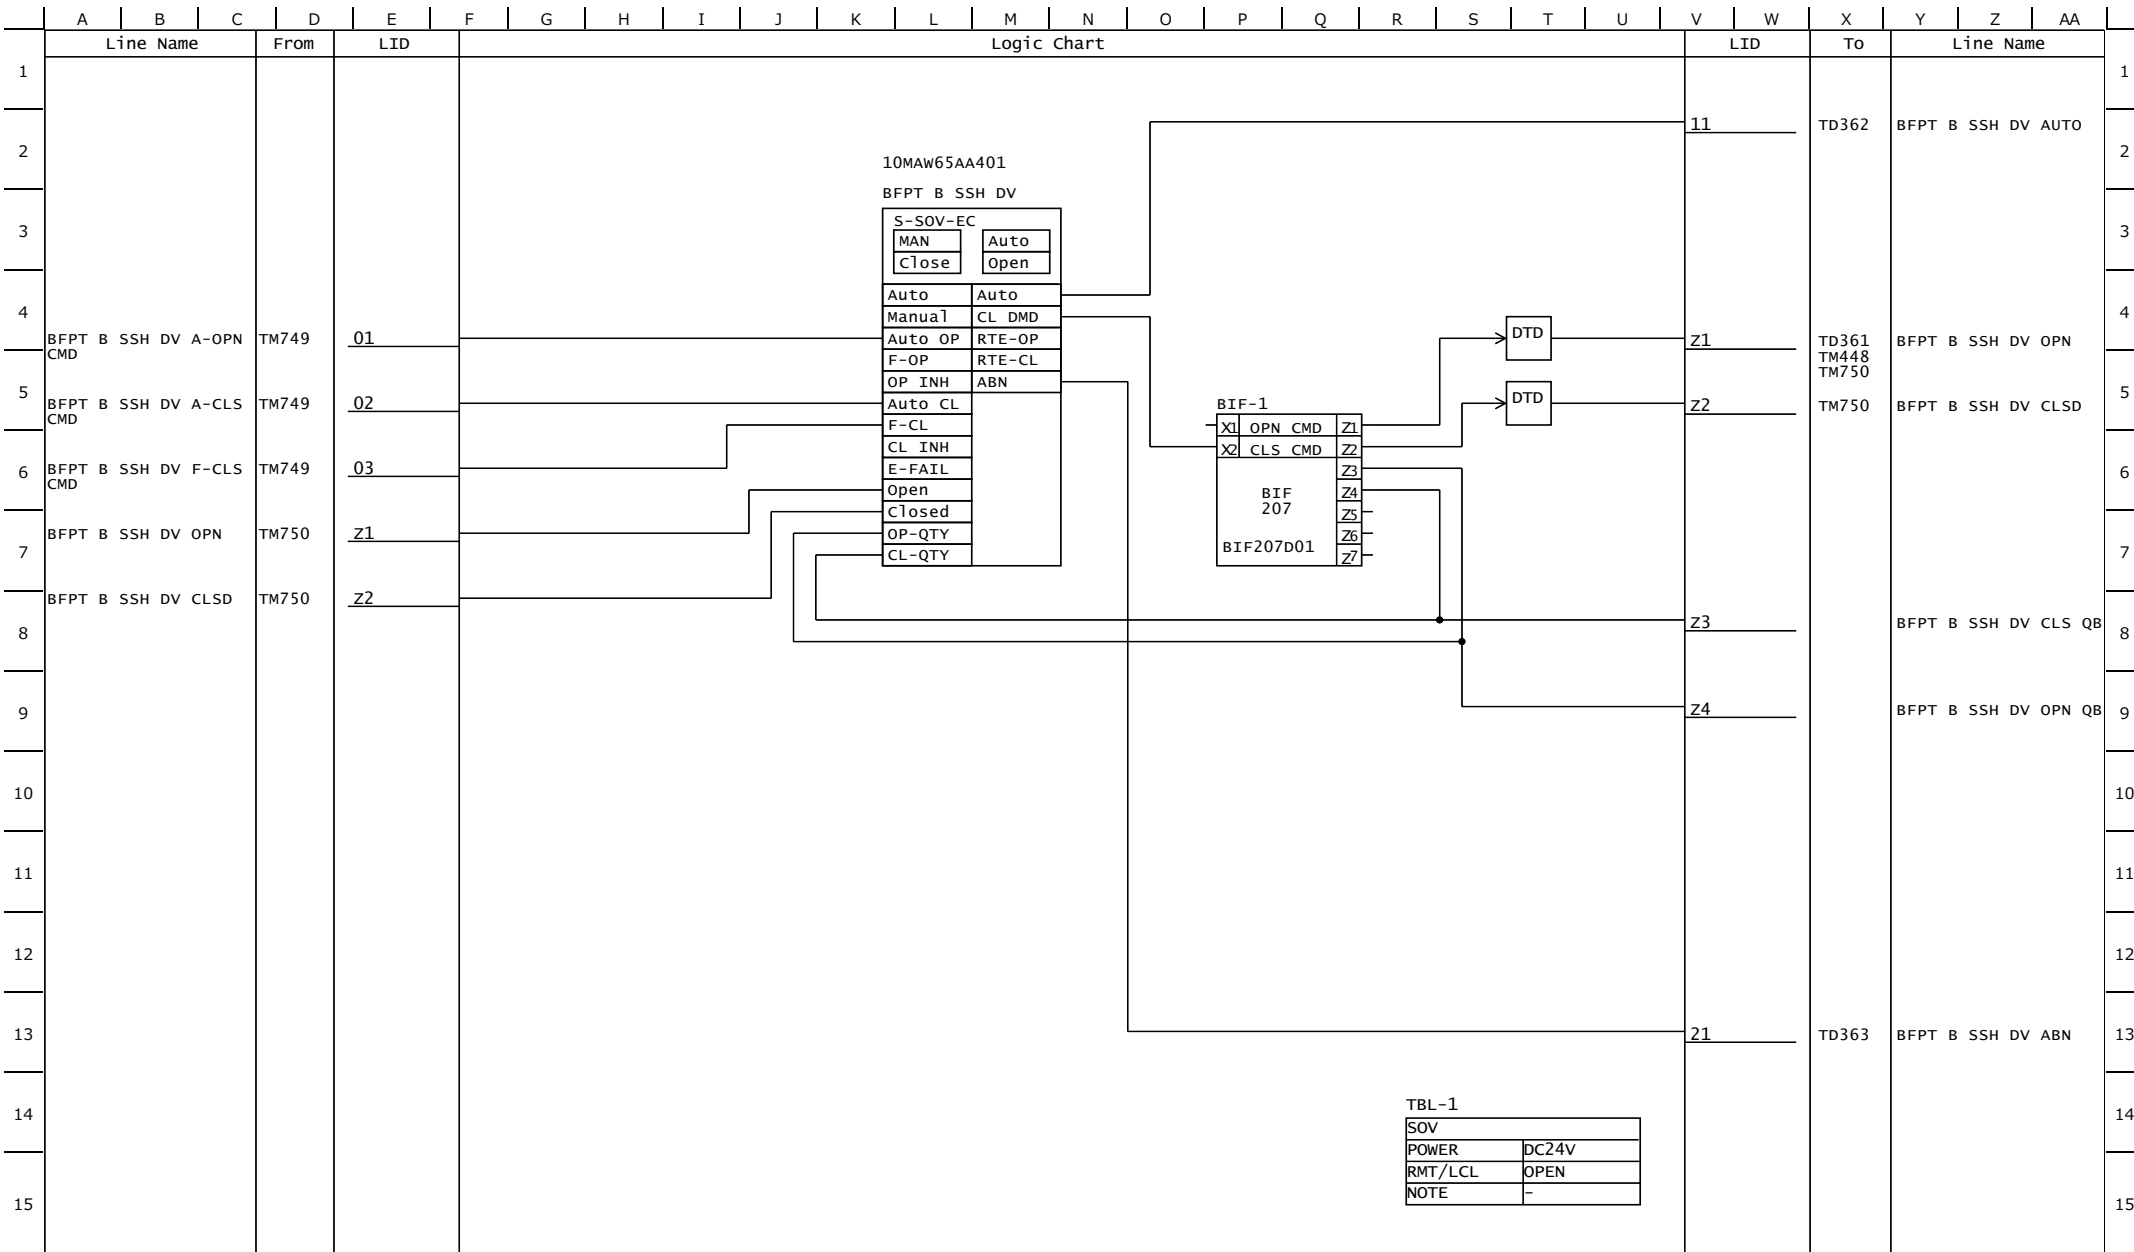


Rev. No.	0	1	2					PROJECT Van Phong 1 BOT Thermal Power Plant Project 2×673MW	(TSQ B)			
DATE	2021/6/21	2021/12/15	2022/11/8									
CONTENTS	1st Issue	Revised (0007, 0015)	Revised (0045)					TITLE BFPT B SSH DV (2)	DRAWING No. 4GCH01007	SH TM750	REV. MARK 2	
								Equipment No. : _OMAW65AA401				

A	B	C	D	E	F	G	H	I	J	K	L	M	N	O	P	Q	R	S	T	U	V	W	X	Y	Z	AA	
Line Name			From	LID	Logic Chart																	LID	To	Line Name			
1	BFPT B EXH VLV OV TRQ BFPT B EXH VLV OPN BFPT B EXH VLV CLS BFPT B EXH VLV POSN			TM755	Z3	10LBR20AA201 BFPT B EXH VLV MOV2-NSH - Close - Open Auto Manual Auto OP F-OP OP INH Auto CL F-CL CL INH Local E-FAIL OV TRQ Open Closed POS Torque Seating = 0 BIF-1 X1 OPN CMD Z1 X2 CLS CMD Z2 Z3 Z4 Z5 Z6 Z7 BIF 207 BIF207C02																	11	TM755	BFPT B EXH VLV AUTO		
2																							31		BFPT B EXH VLV OPN CMD		
3																							32		BFPT B EXH VLV CLS CMD		
4																							Z1		BFPT B EXH VLV OPN		
5																							Z2		BFPT B EXH VLV CLS		
6																											
7																											
8																											
9																							Z3		BFPT B EXH VLV OV TRQ		
10																							Z4		BFPT B EXH VLV LCL SEL		
11																							Z6		BFPT B EXH VLV E-FAIL		
12																											
13																							21		BFPT B EXH VLV ABN		
14																											
15																											
Rev. No.			0	1	2	PROJECT																	(TSQ B)				
DATE			2021/6/21	2021/12/15	2022/11/8	Van Phong 1 BOT Thermal Power Plant Project 2×673MW																					
CONTENTS			1st Issue	Revised (0015)	Revised (0046, 0048)	TITLE																	DRAWING No.		SH	REV. MARK	
						BFPT B EXH VLV																	4GCH01007		TM755	2	
						Equipment No. : 0LBR20AA201																					

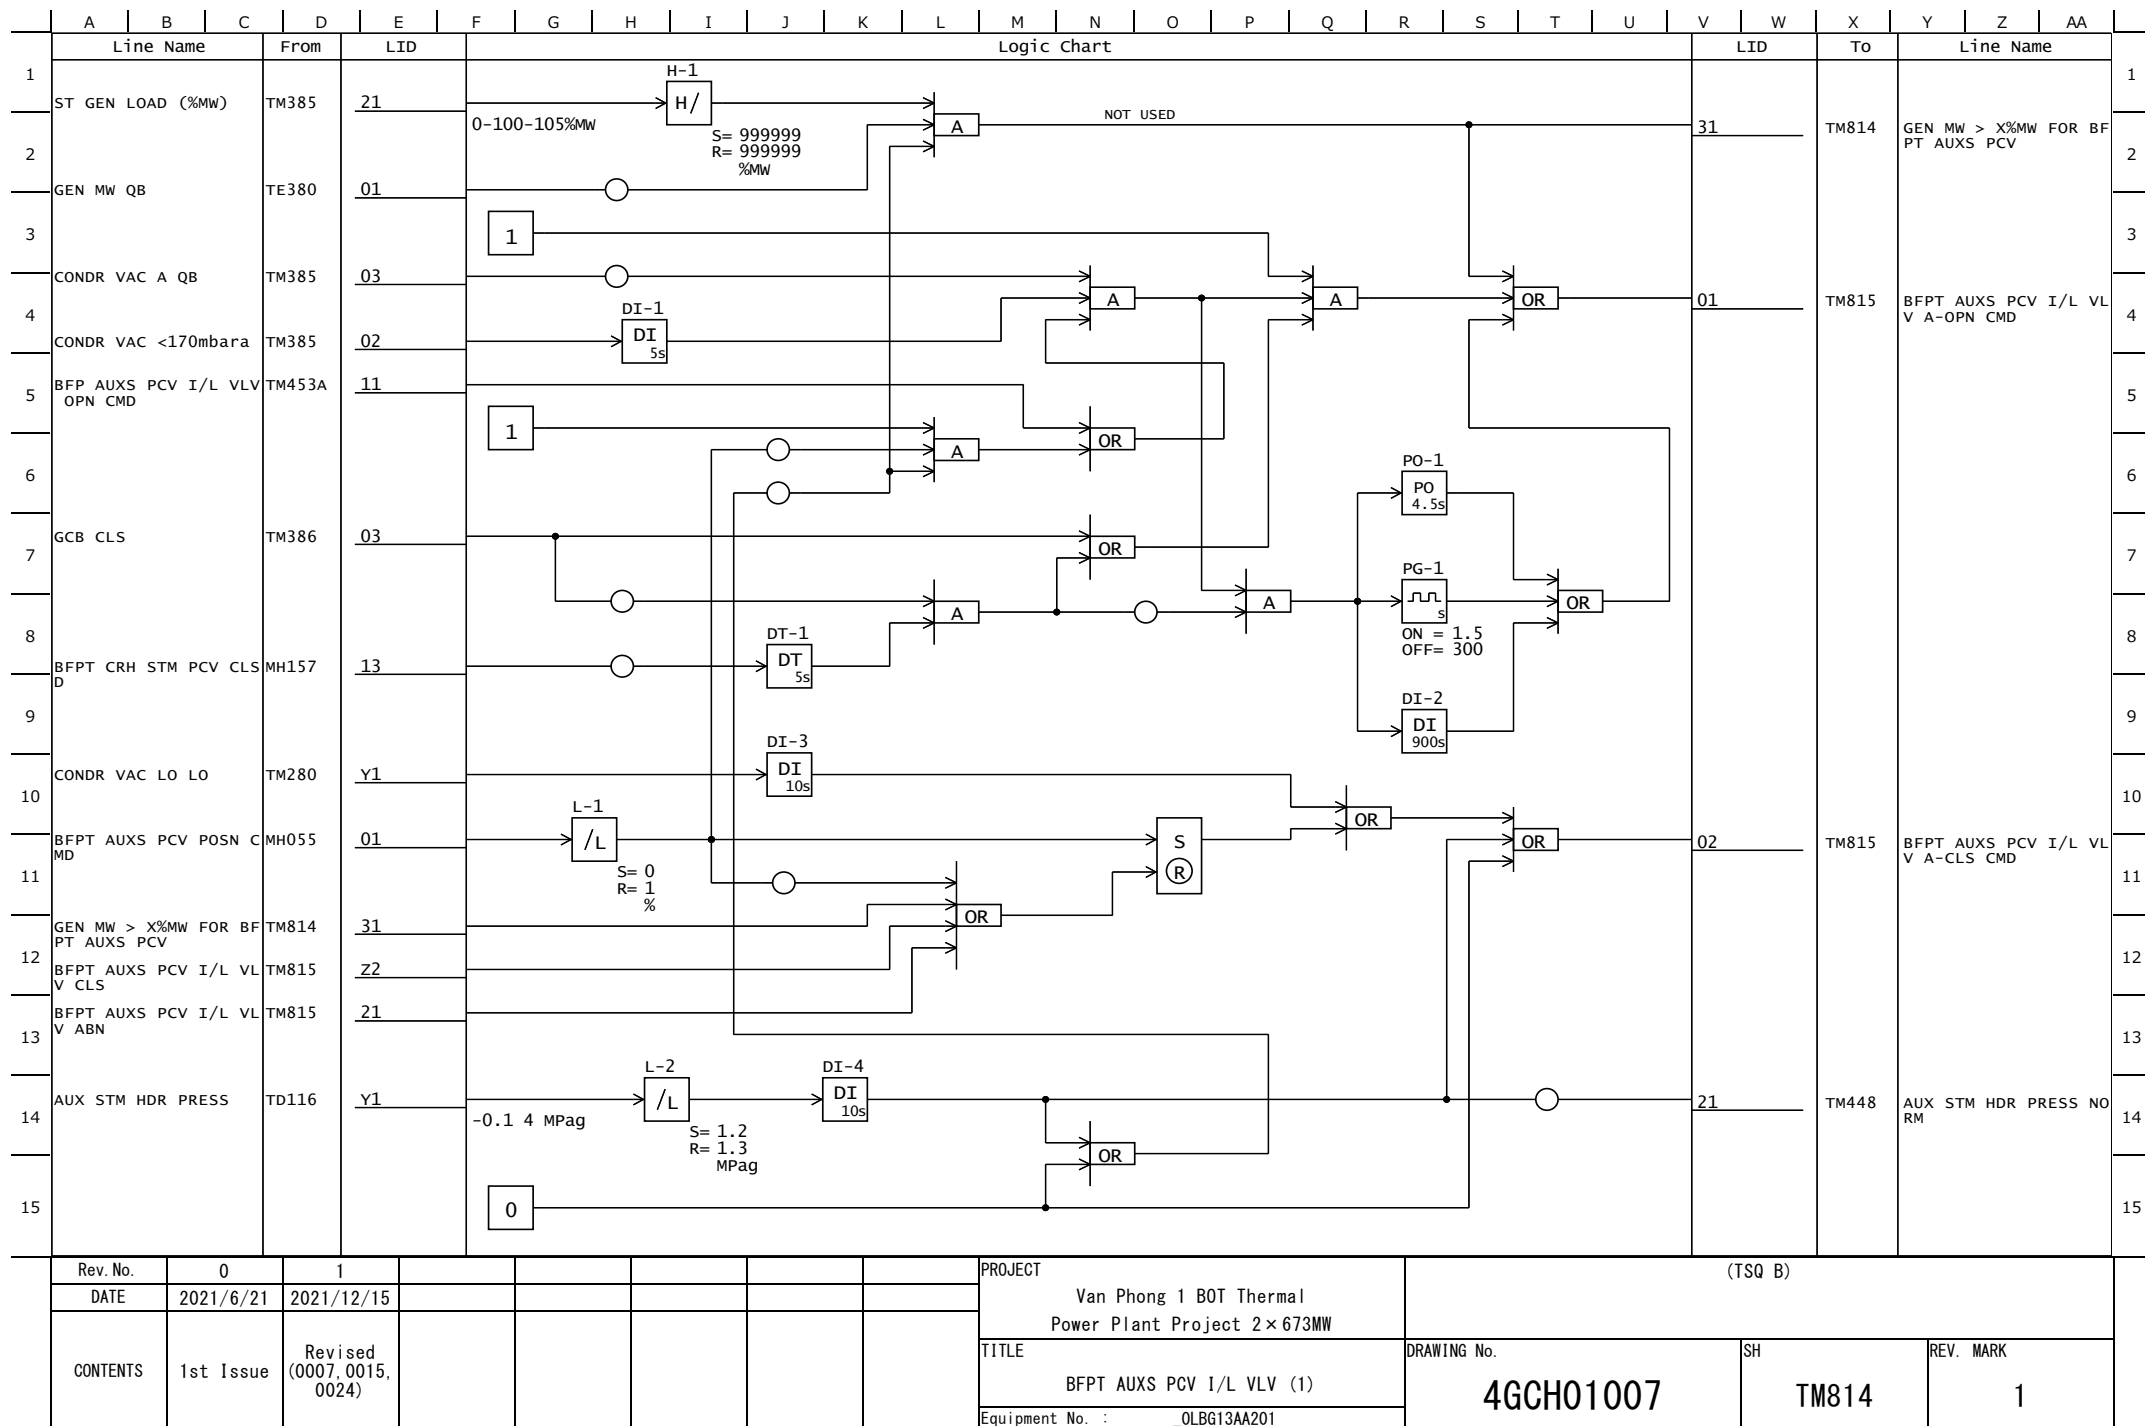


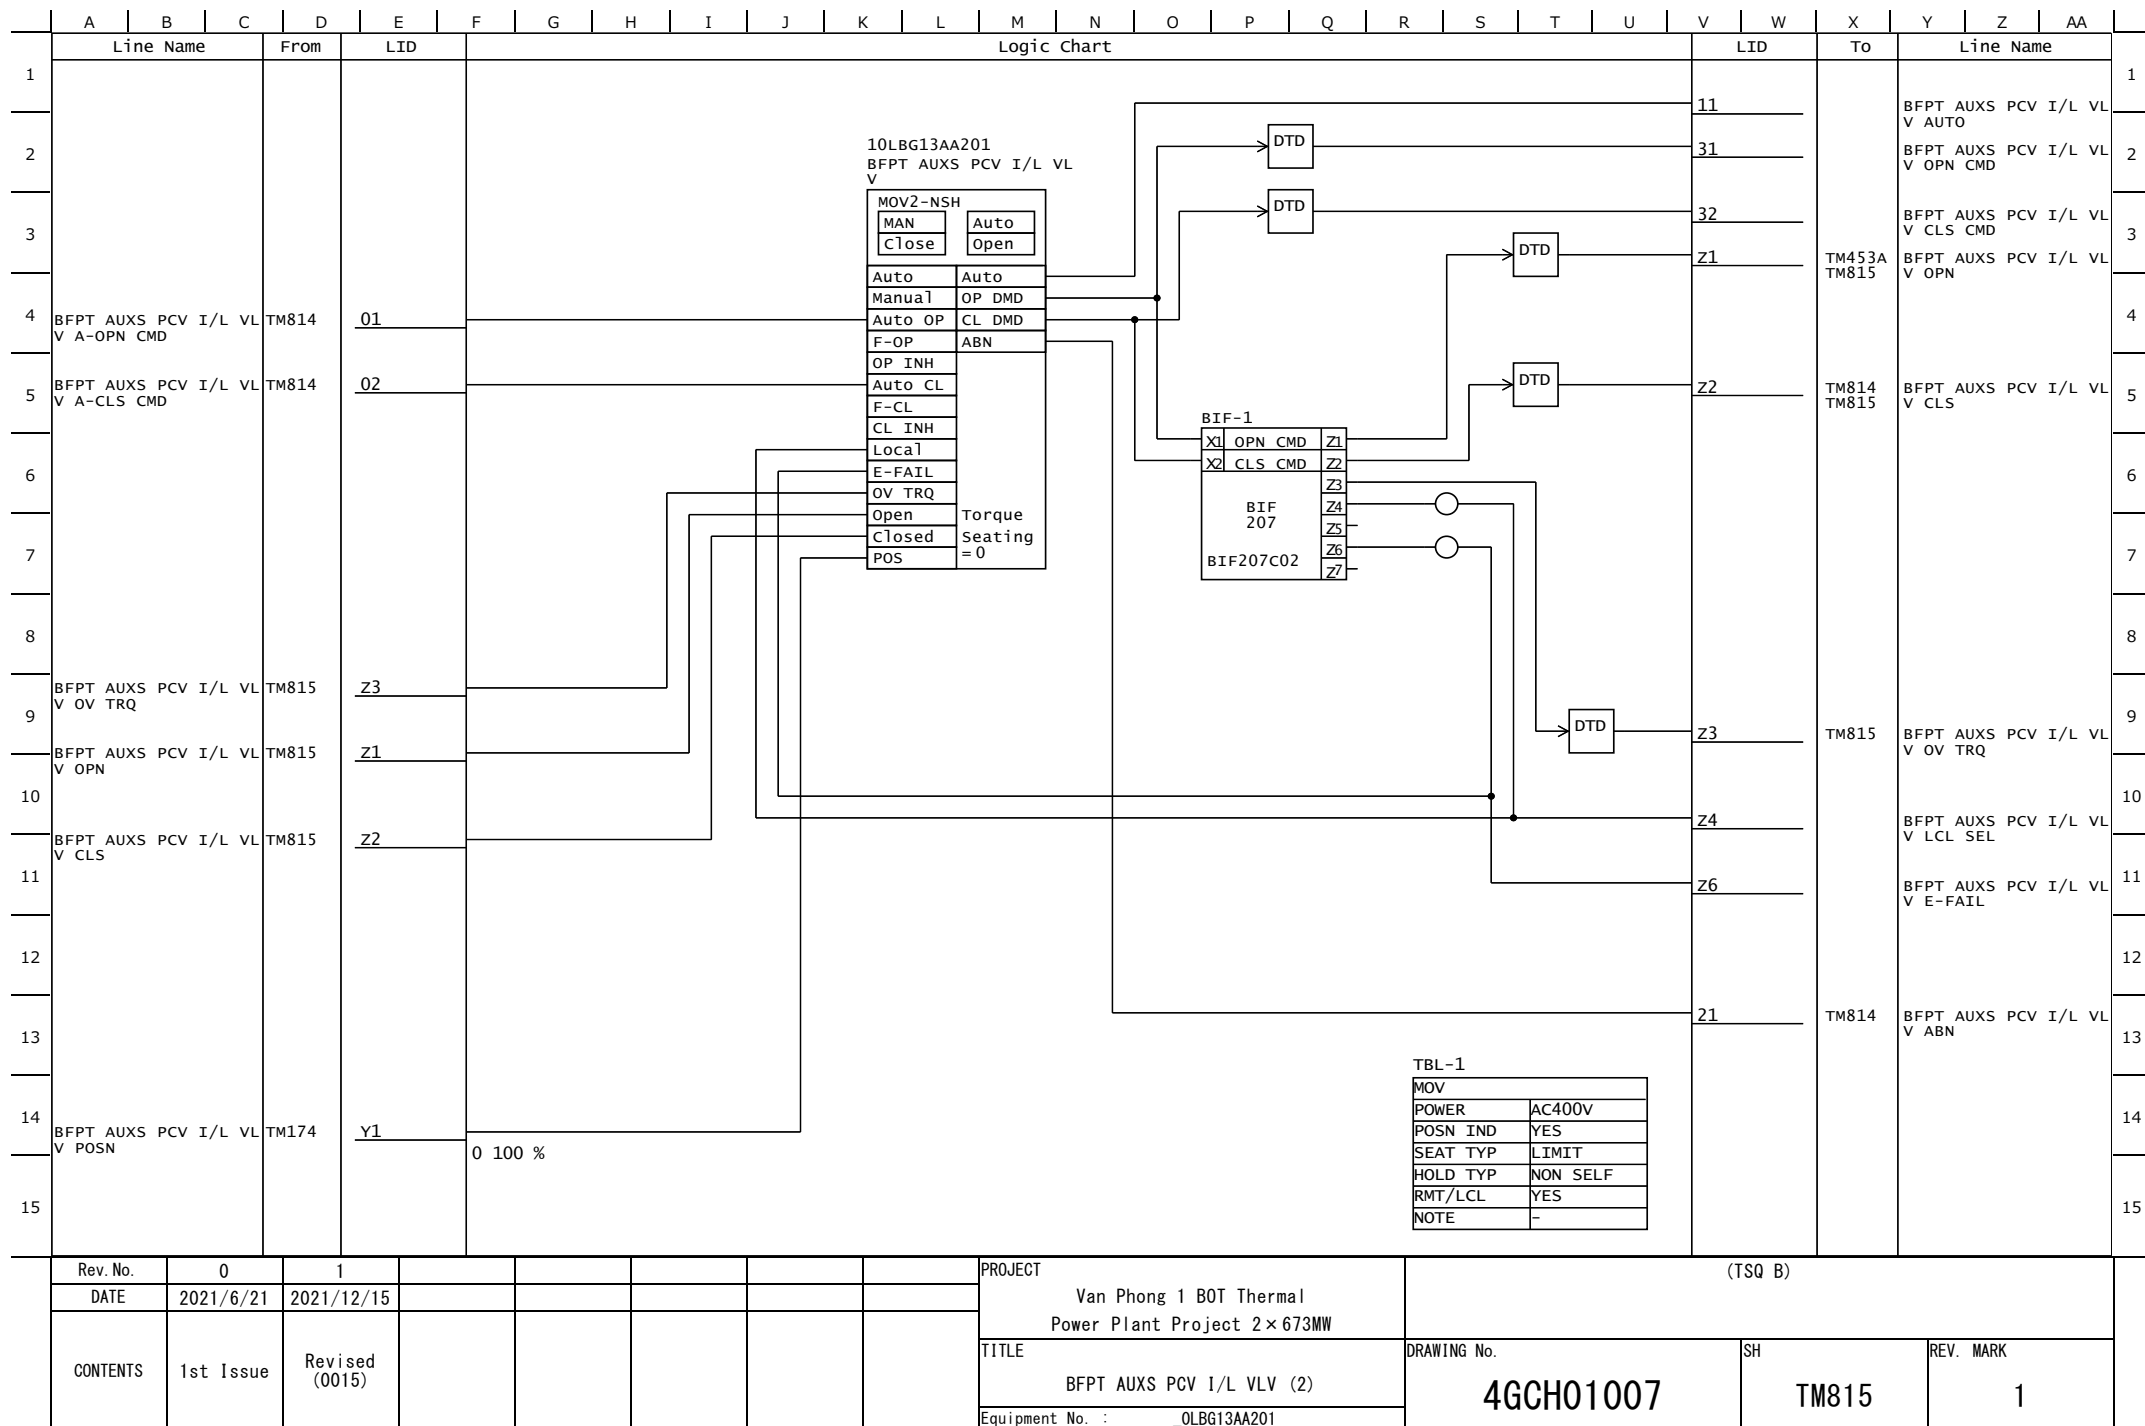

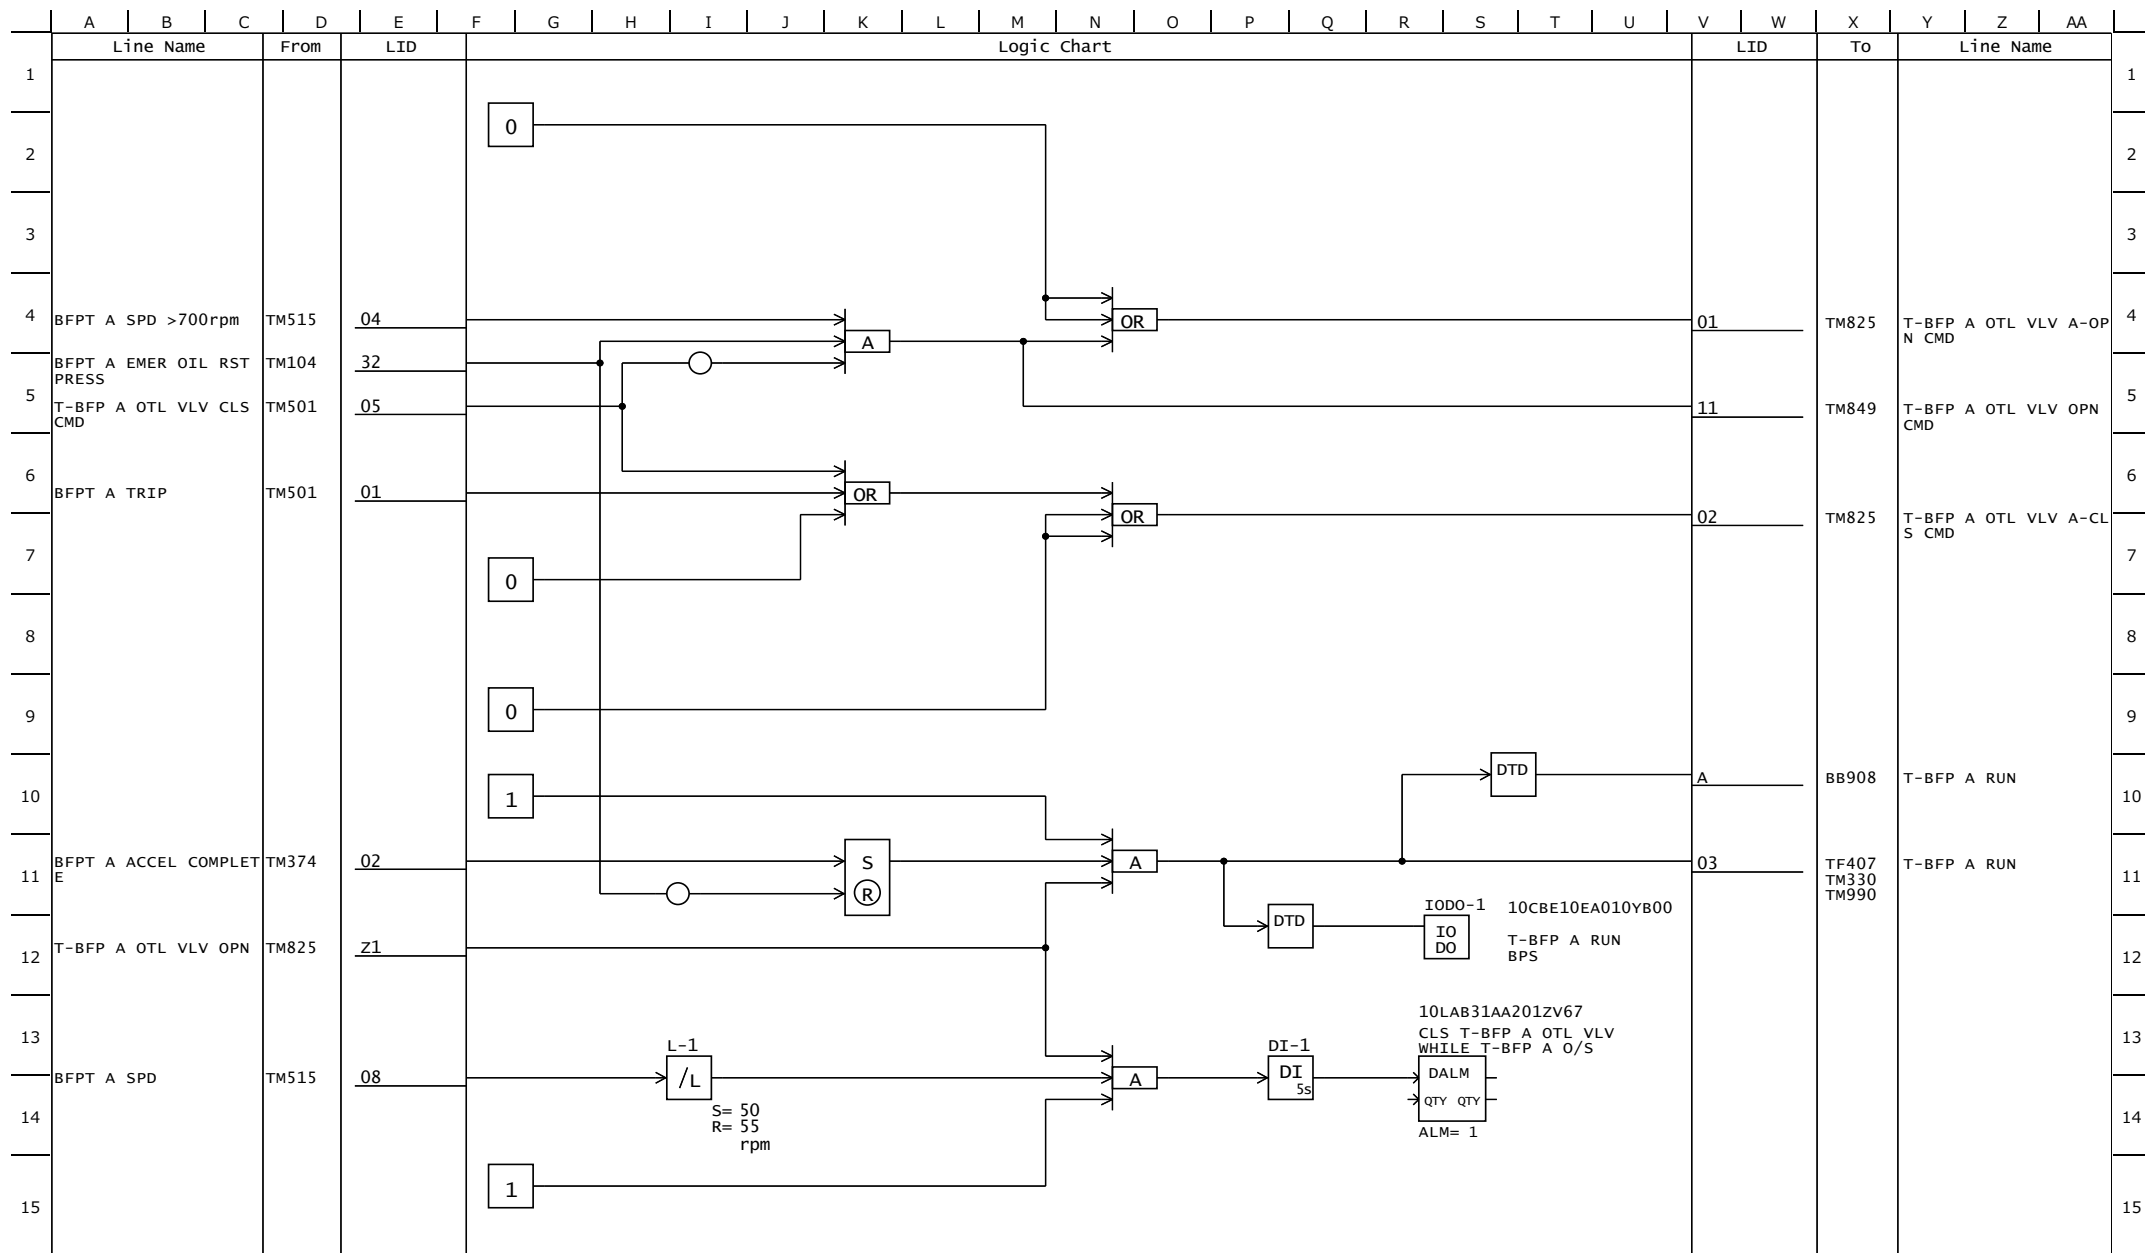


Rev. No.	0	1						PROJECT	(TSQ B)			
DATE	2021/6/21	2021/12/15						Van Phong 1 BOT Thermal Power Plant Project 2×673MW				
CONTENTS	1st Issue	Revised (0015, 0026)						TITLE	DRAWING No.	SH	REV. MARK	
								T-BFP A OTL VLV (1)	4GCH01007	TM824	1	
								Equipment No. : _OLAB31AA201				


	A	B	C	D	E	F	G	H	I	J	K	L	M	N	O	P	Q	R	S	T	U	V	W	X	Y	Z	AA				
	Line Name			From	LID	Logic Chart																	LID	To	Line Name						
1	DFWT TEMP			TF131	Y4	10LAA10CT051ZV26 TBFP A BRL TMP DEV(D EA&SCTN) ALM1F C/0-H 1H C/0-L 1L QTY QTY SIH= 50 SIL= -999999 degC T1H= 0 T1L= 0 S [SIH RESET=45degC]																			01	TM831	TBFP A BRL TMP DEV(D EA&SCTN) HI			1	
2																														2	
3																														3	
4																														4	
5	BFPT A CV CLS			TM374	01	10LAA10CT051ZV26 TBFP A BRL TMP DEV(D EA&SCTN) ALM1F C/0-H 1H C/0-L 1L QTY QTY SIH= 50 SIL= -999999 degC T1H= 0 T1L= 0 S [SIH RESET=45degC]																			TM831		TBFP A BRL TMP DEV(D EA&SCTN) HI			5	
6	BFPT A ZERO SPD <2RPM			TM263	Y2																									6	
7	TBFP A UPR BRL TEMP A QB			TM137	11	10LAC10CT057ZQ06 TBFP-A BRL TMP AVE(TP-SCTN&DSCH) ALM1F C/0-H 1H C/0-L 1L QTY QTY SIH= 90 SIL= -999999 degC T1H= 0 T1L= 0 S [SIH RESET=85degC]																			21		TM519	TBFP-A BRL TMP AVE(TP-SCTN&DSCH)			7
8	TBFP A UPR BRL TEMP A			TM137	Y1																										8
9	TBFP A UPR BRL TEMP B QB			TM137	21																										9
10	TBFP A UPR BRL TEMP B			TM137	Y2																										10
11						10LAC10CT058ZQ06 TBFP A BRL TMP AVE(SCTN TOP&BTM) ALM1F C/0-H 1H C/0-L 1L QTY QTY SIH= 50 SIL= -999999 degC T1H= 0 T1L= 0 S [SIH RESET=45degC]																			31		TM830	TBFP A BRL TMP AVE(SCTN TOP&BTM)			11
12																															12
13																															13
14	TBFP A LWR BRL TEMP A QB			TM138	11																										14
15	TBFP A LWR BRL TEMP A			TM138	Y1	10LAC10CT058ZQ06 TBFP A BRL TMP AVE(SCTN TOP&BTM) ALM1F C/0-H 1H C/0-L 1L QTY QTY SIH= 50 SIL= -999999 degC T1H= 0 T1L= 0 S [SIH RESET=45degC]																			32		TM830	TBFP A BRL TMP AVE(HI(SCTN TOP&BTM))			15
Rev. No.		0	1	2	3						PROJECT										(TSQ B)										
DATE		2021/6/21	2021/12/15	2022/11/8	2023/7/5						Van Phong 1 BOT Thermal Power Plant Project 2×673MW																				
CONTENTS		1st Issue	Revised (0015)	Revised & Tuning (0056, 0064, 0080)	Revised (0152, 0163)						TITLE										DRAWING No.		SH	REV. MARK							
											T-BFP A CONDITION (1)										4GCH01007		TM830	3							
											Equipment No. : -																				

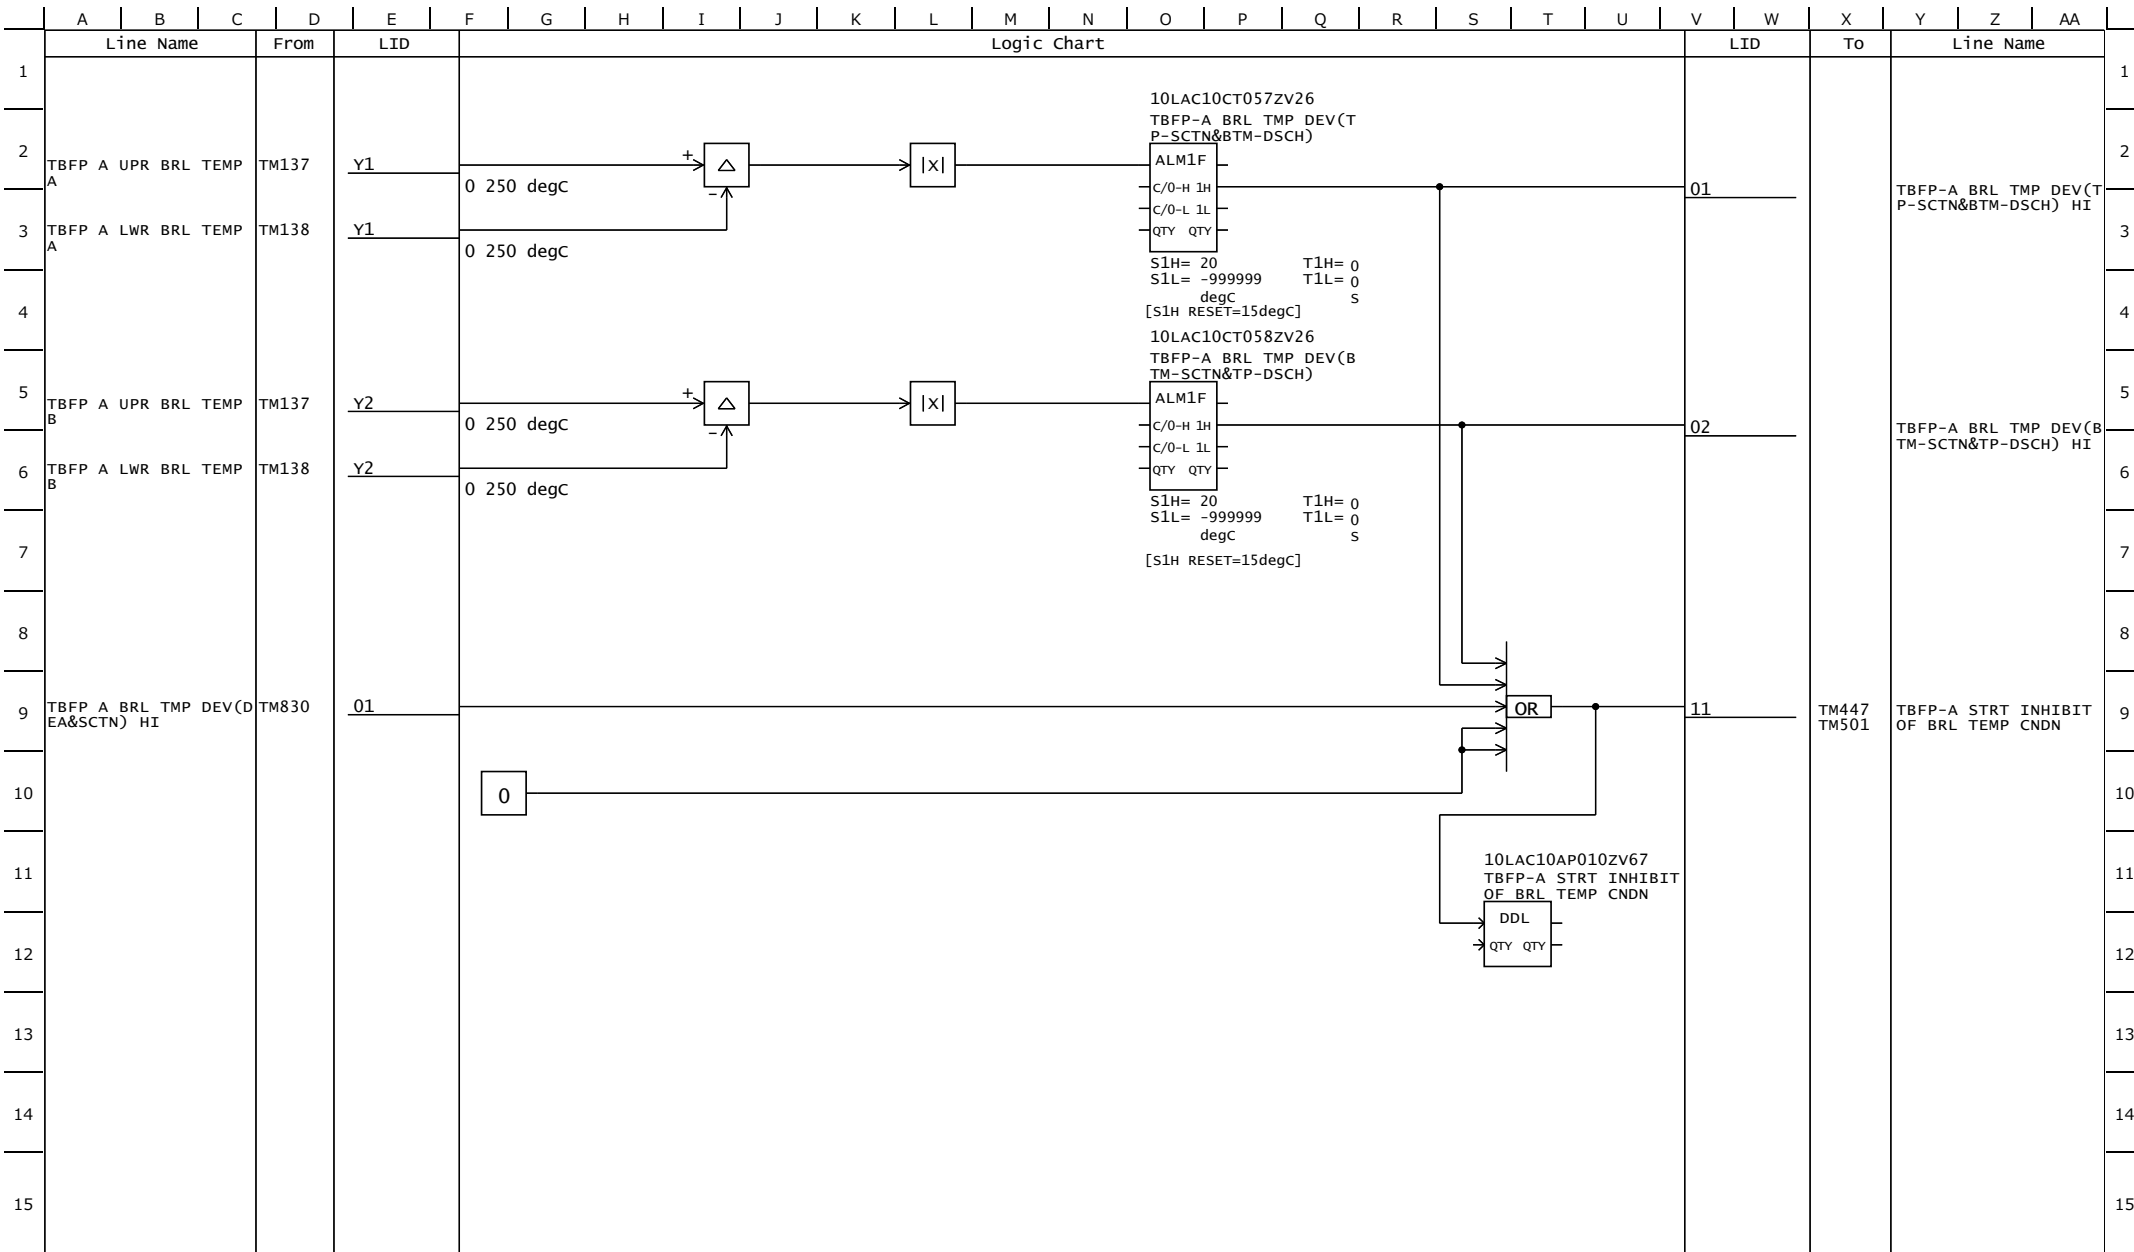


Rev. No.	0	1	2	3				PROJECT	(TSQ B)						
DATE	2021/6/21	2021/12/15	2022/11/8	2023/7/5				Van Phong 1 BOT Thermal Power Plant Project 2×673MW							
CONTENTS	1st Issue	Revised (0015)	Revised & Tuning (0056, 0064, 0080, 0081)	Revised (0152)				T-BFP A CONDITION (2)	DRAWING No.	SH	REV. MARK				
								Equipment No. : -	4GCH01007	TM831	3				

	A	B	C	D	E	F	G	H	I	J	K	L	M	N	O	P	Q	R	S	T	U	V	W	X	Y	Z	AA		
	Line Name			From	LID	Logic Chart																	LID	To	Line Name				
1	BFPT B SPD >700rpm BFPT B EMER OIL RST PRESS T-BFP B OTL VLV CLS CMD BFPT B TRIP BFPT B ACCEL COMPLET E T-BFP B OTL VLV OPN BFPT B SPD			TM665	04																		01	TM835	T-BFP B OTL VLV A-OP N CMD			4	
2																													2
3																													3
4																													4
5																													5
6																													6
7																													7
8																													8
9																													9
10																													10
11																													11
12																													12
13																													13
14																													14
15																													15
Rev. No.			0	1													PROJECT			(TSQ B)									
DATE			2021/6/21	2021/12/15													Van Phong 1 BOT Thermal Power Plant Project 2×673MW												
CONTENTS			1st Issue	Revised (0015, 0026)													TITLE			DRAWING No.					SH		REV. MARK		
																	T-BFP B OTL VLV (1)			4GCH01007					TM834		1		
																	Equipment No. : 0LAB32AA201												

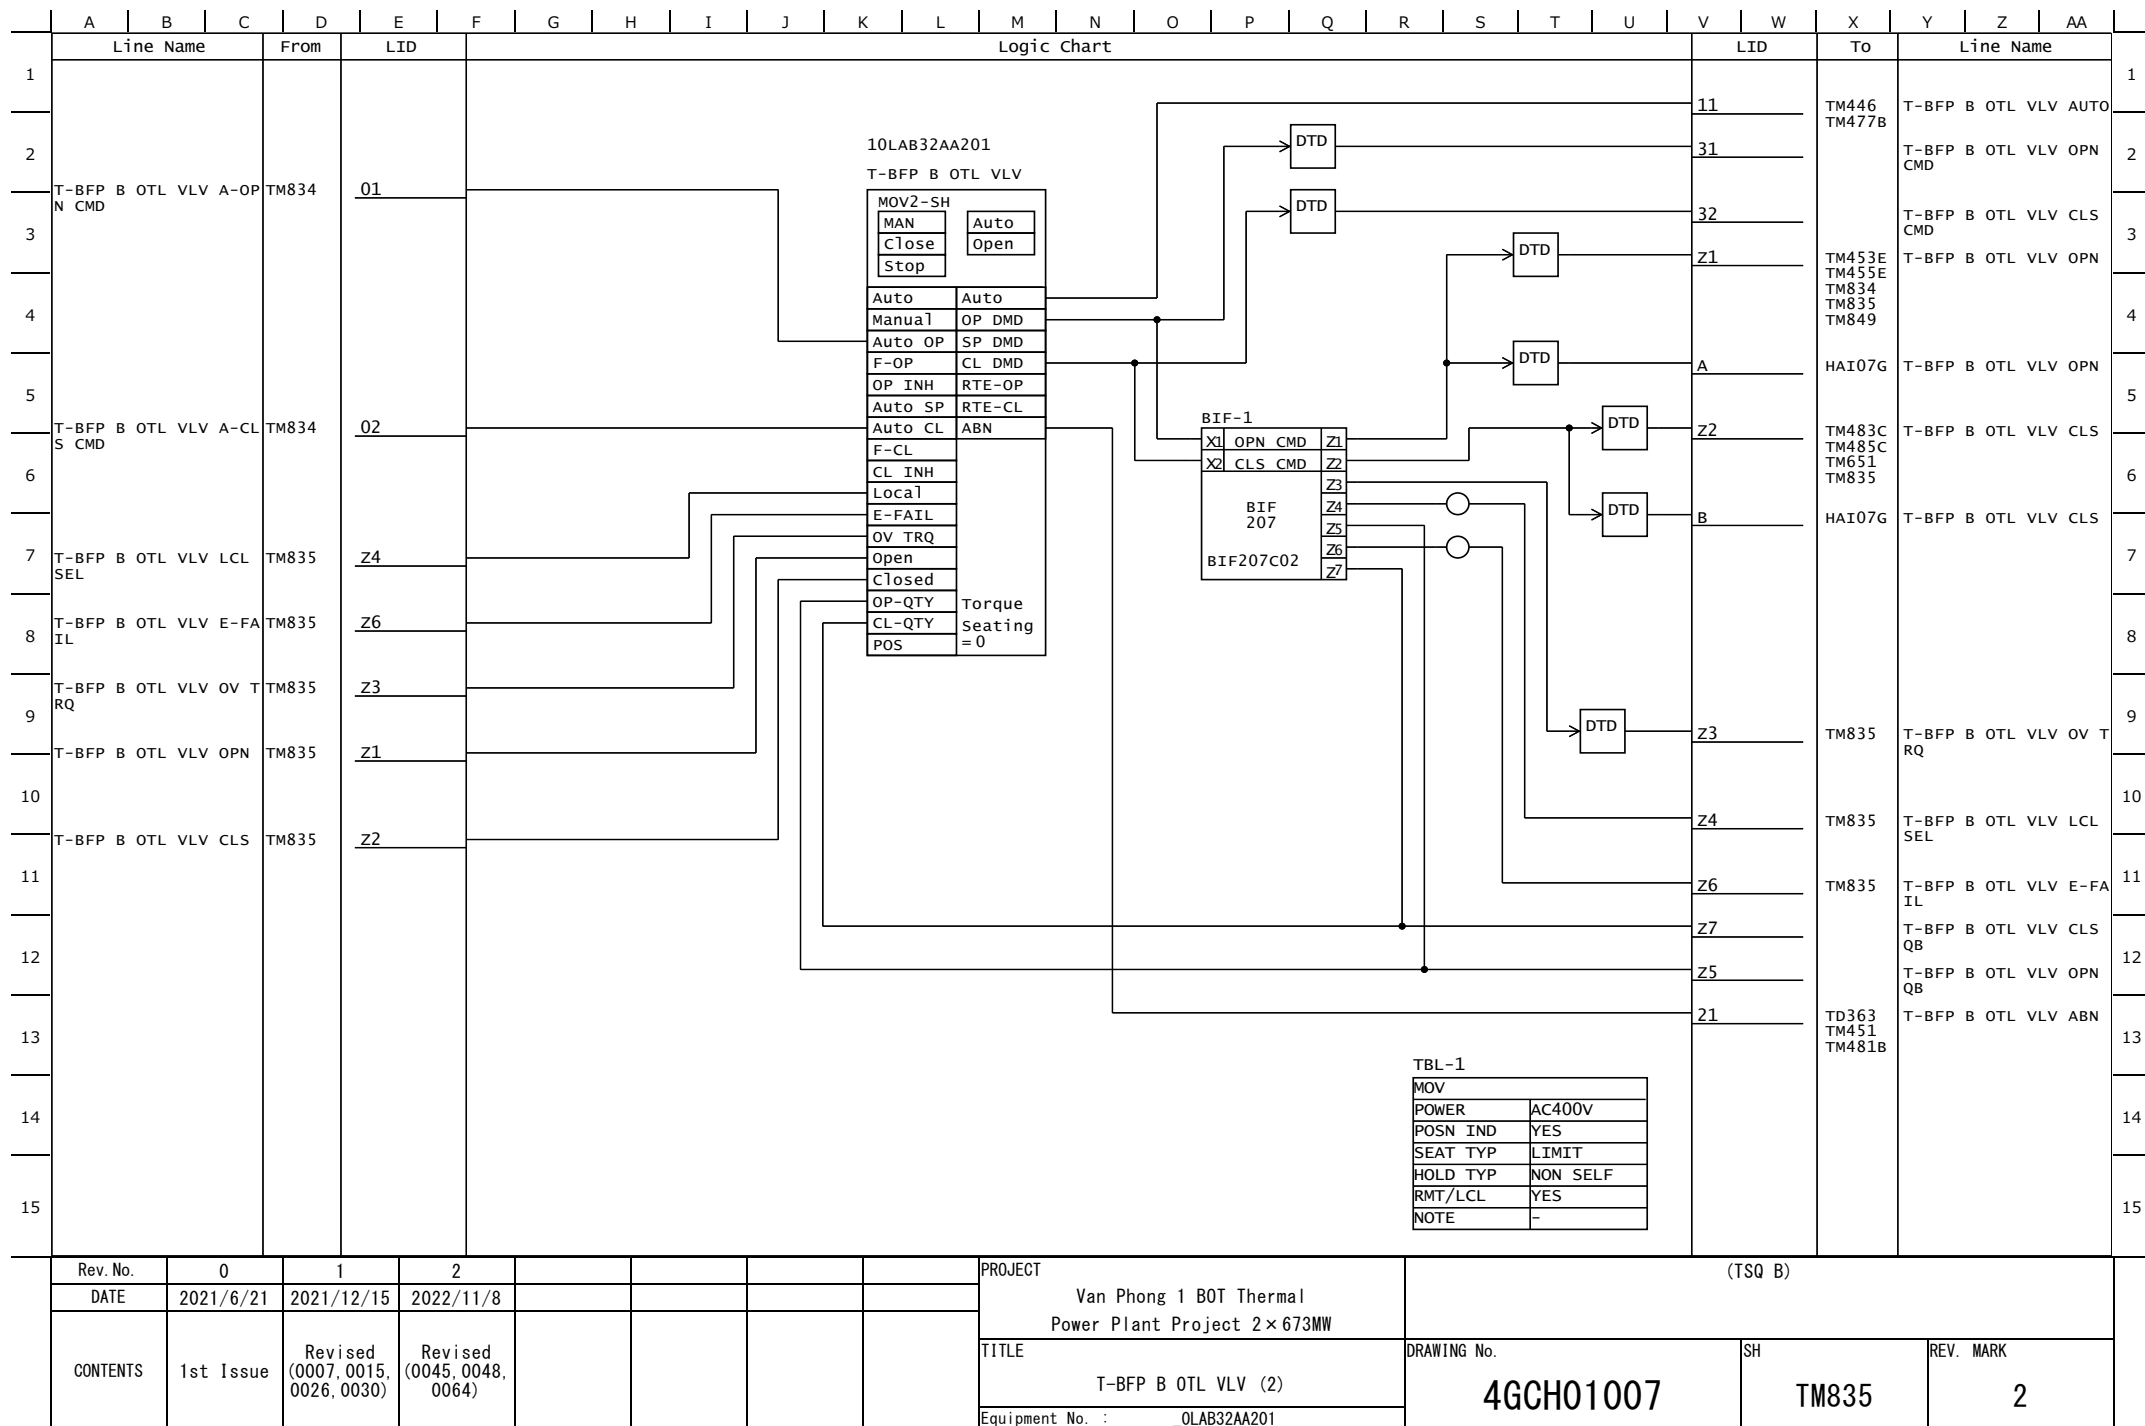


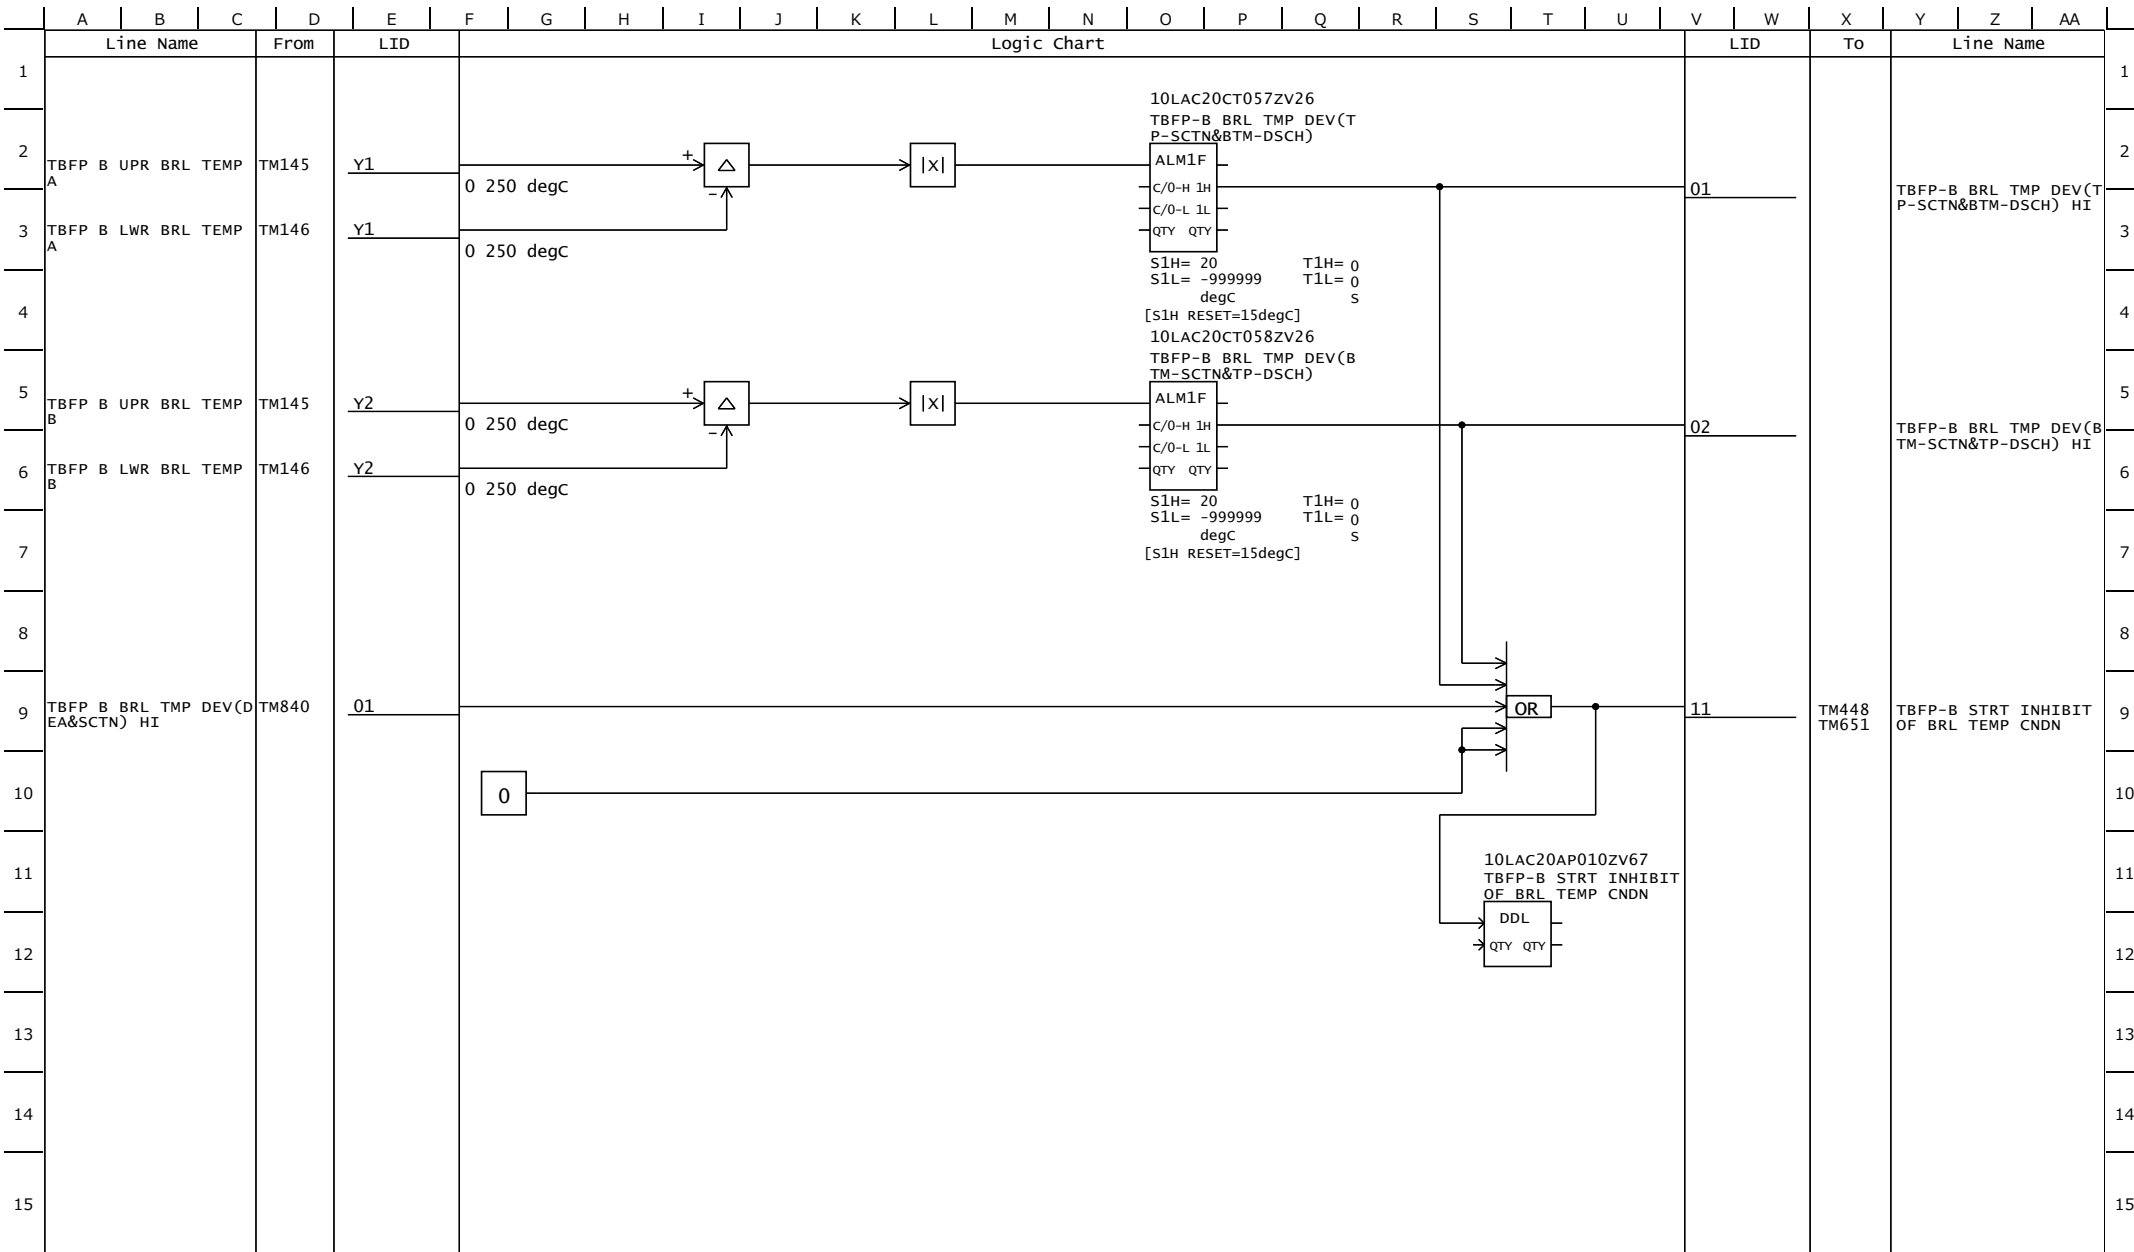

Rev. No.	0	1	2	3				PROJECT	(TSQ B)			
DATE	2021/6/21	2021/12/15	2022/11/8	2023/7/5				Van Phong 1 BOT Thermal Power Plant Project 2×673MW				
CONTENTS	1st Issue	Revised (0015)	Revised & Tuning (0056, 0064, 0080, 0081)	Revised (0152)				TITLE	DRAWING No.	SH	REV. MARK	
								T-BFP B CONDITION (2)	4GCH01007	TM841	3	
								Equipment No. : -				

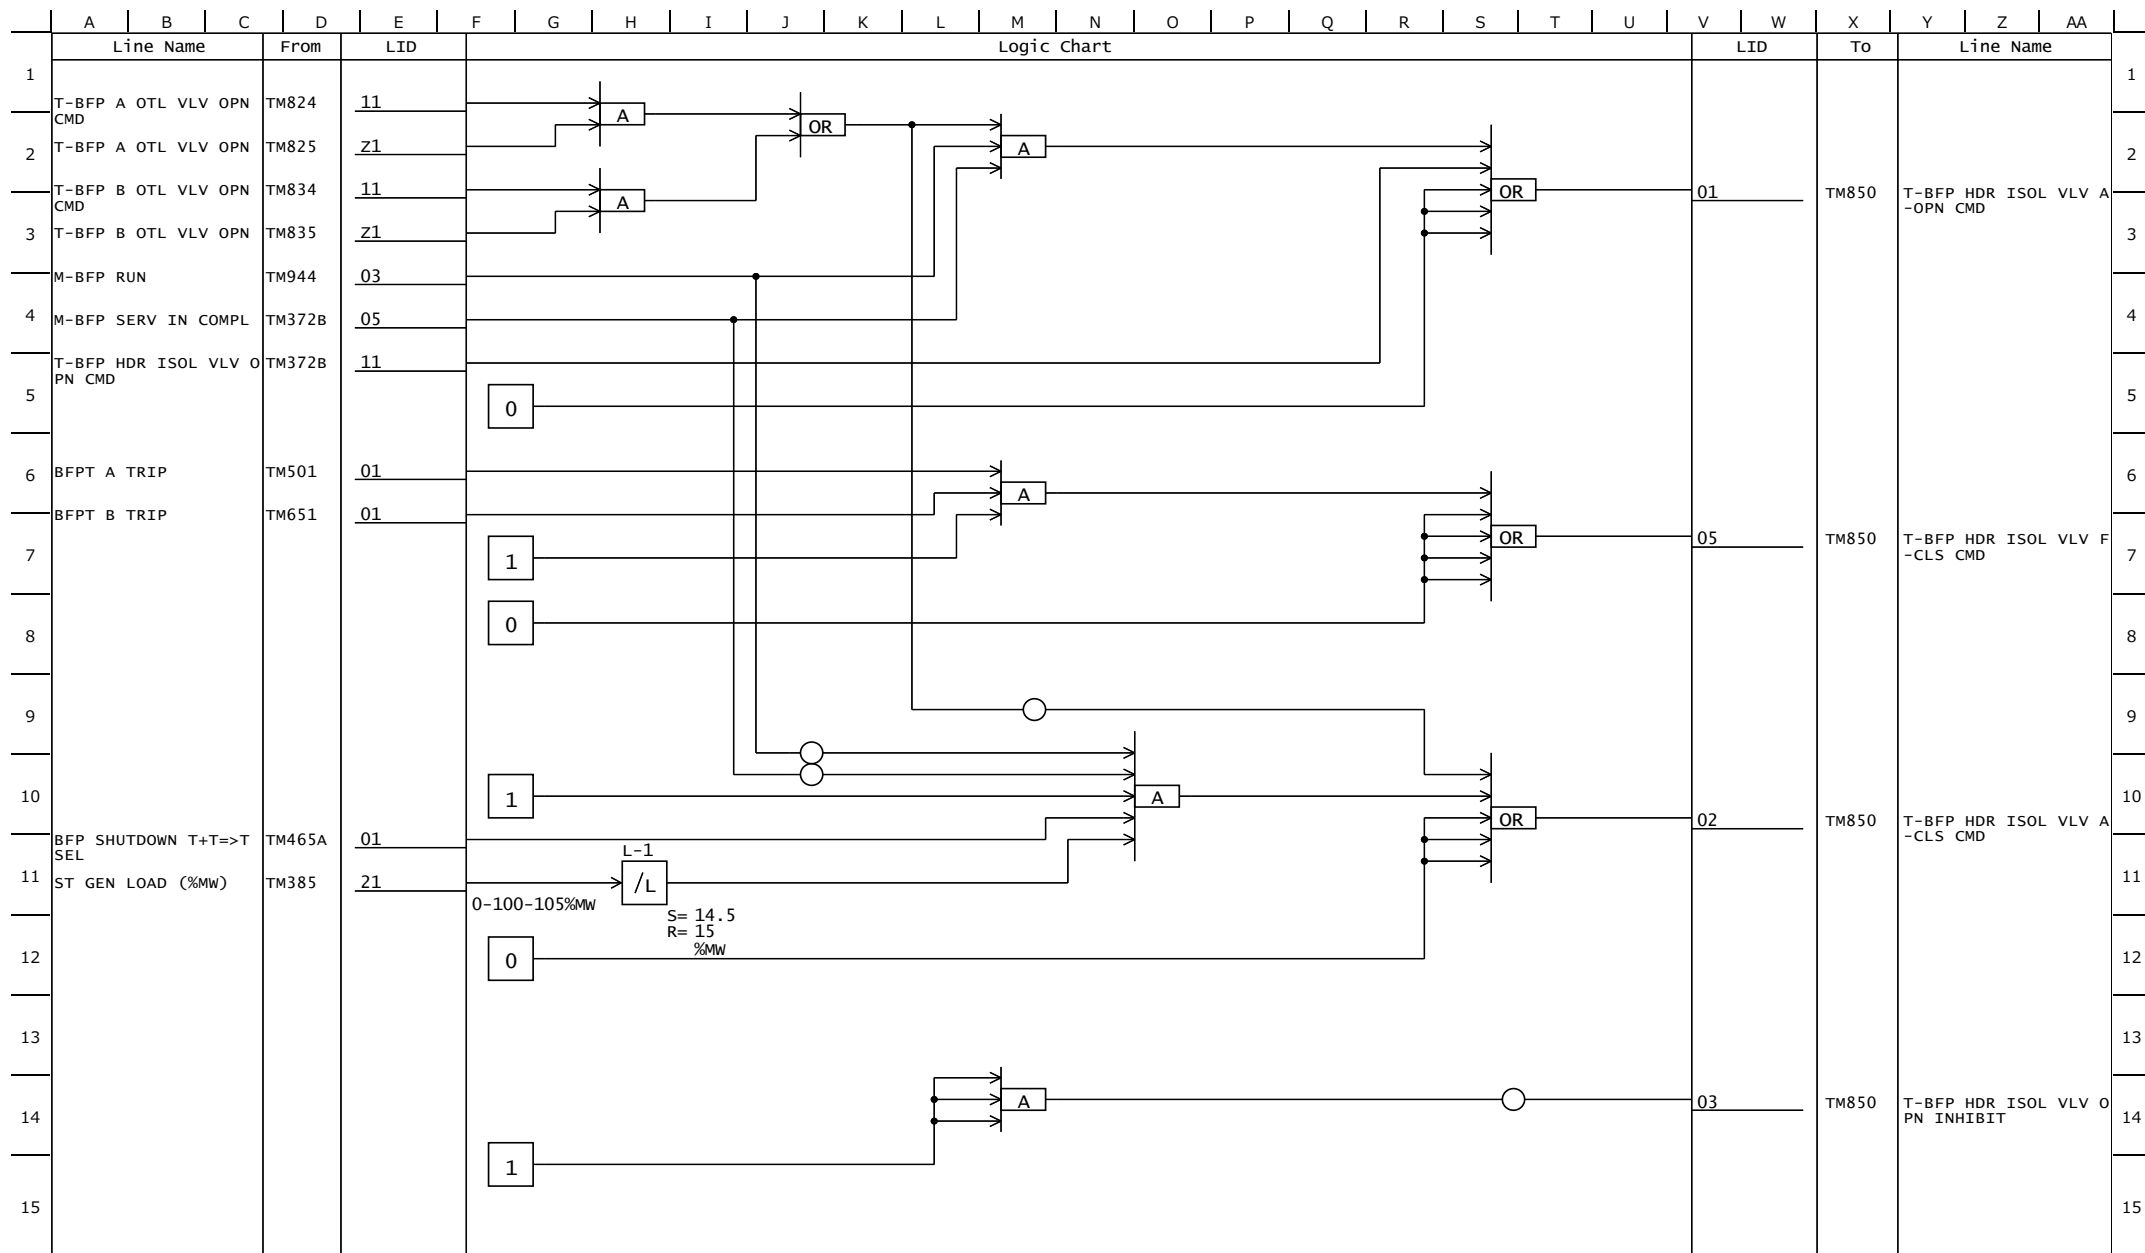

Rev. No.	0	1							PROJECT	(TSQ B)			
DATE	2021/6/21	2021/12/15							Van Phong 1 BOT Thermal Power Plant Project 2×673MW				
CONTENTS	1st Issue	Revised (0015)						TITLE	DRAWING No.	SH	REV. MARK		
								T-BFP HDR ISOL VLV (1)	4GCH01007	TM849	1		
								Equipment No. : _OLAB40AA201					

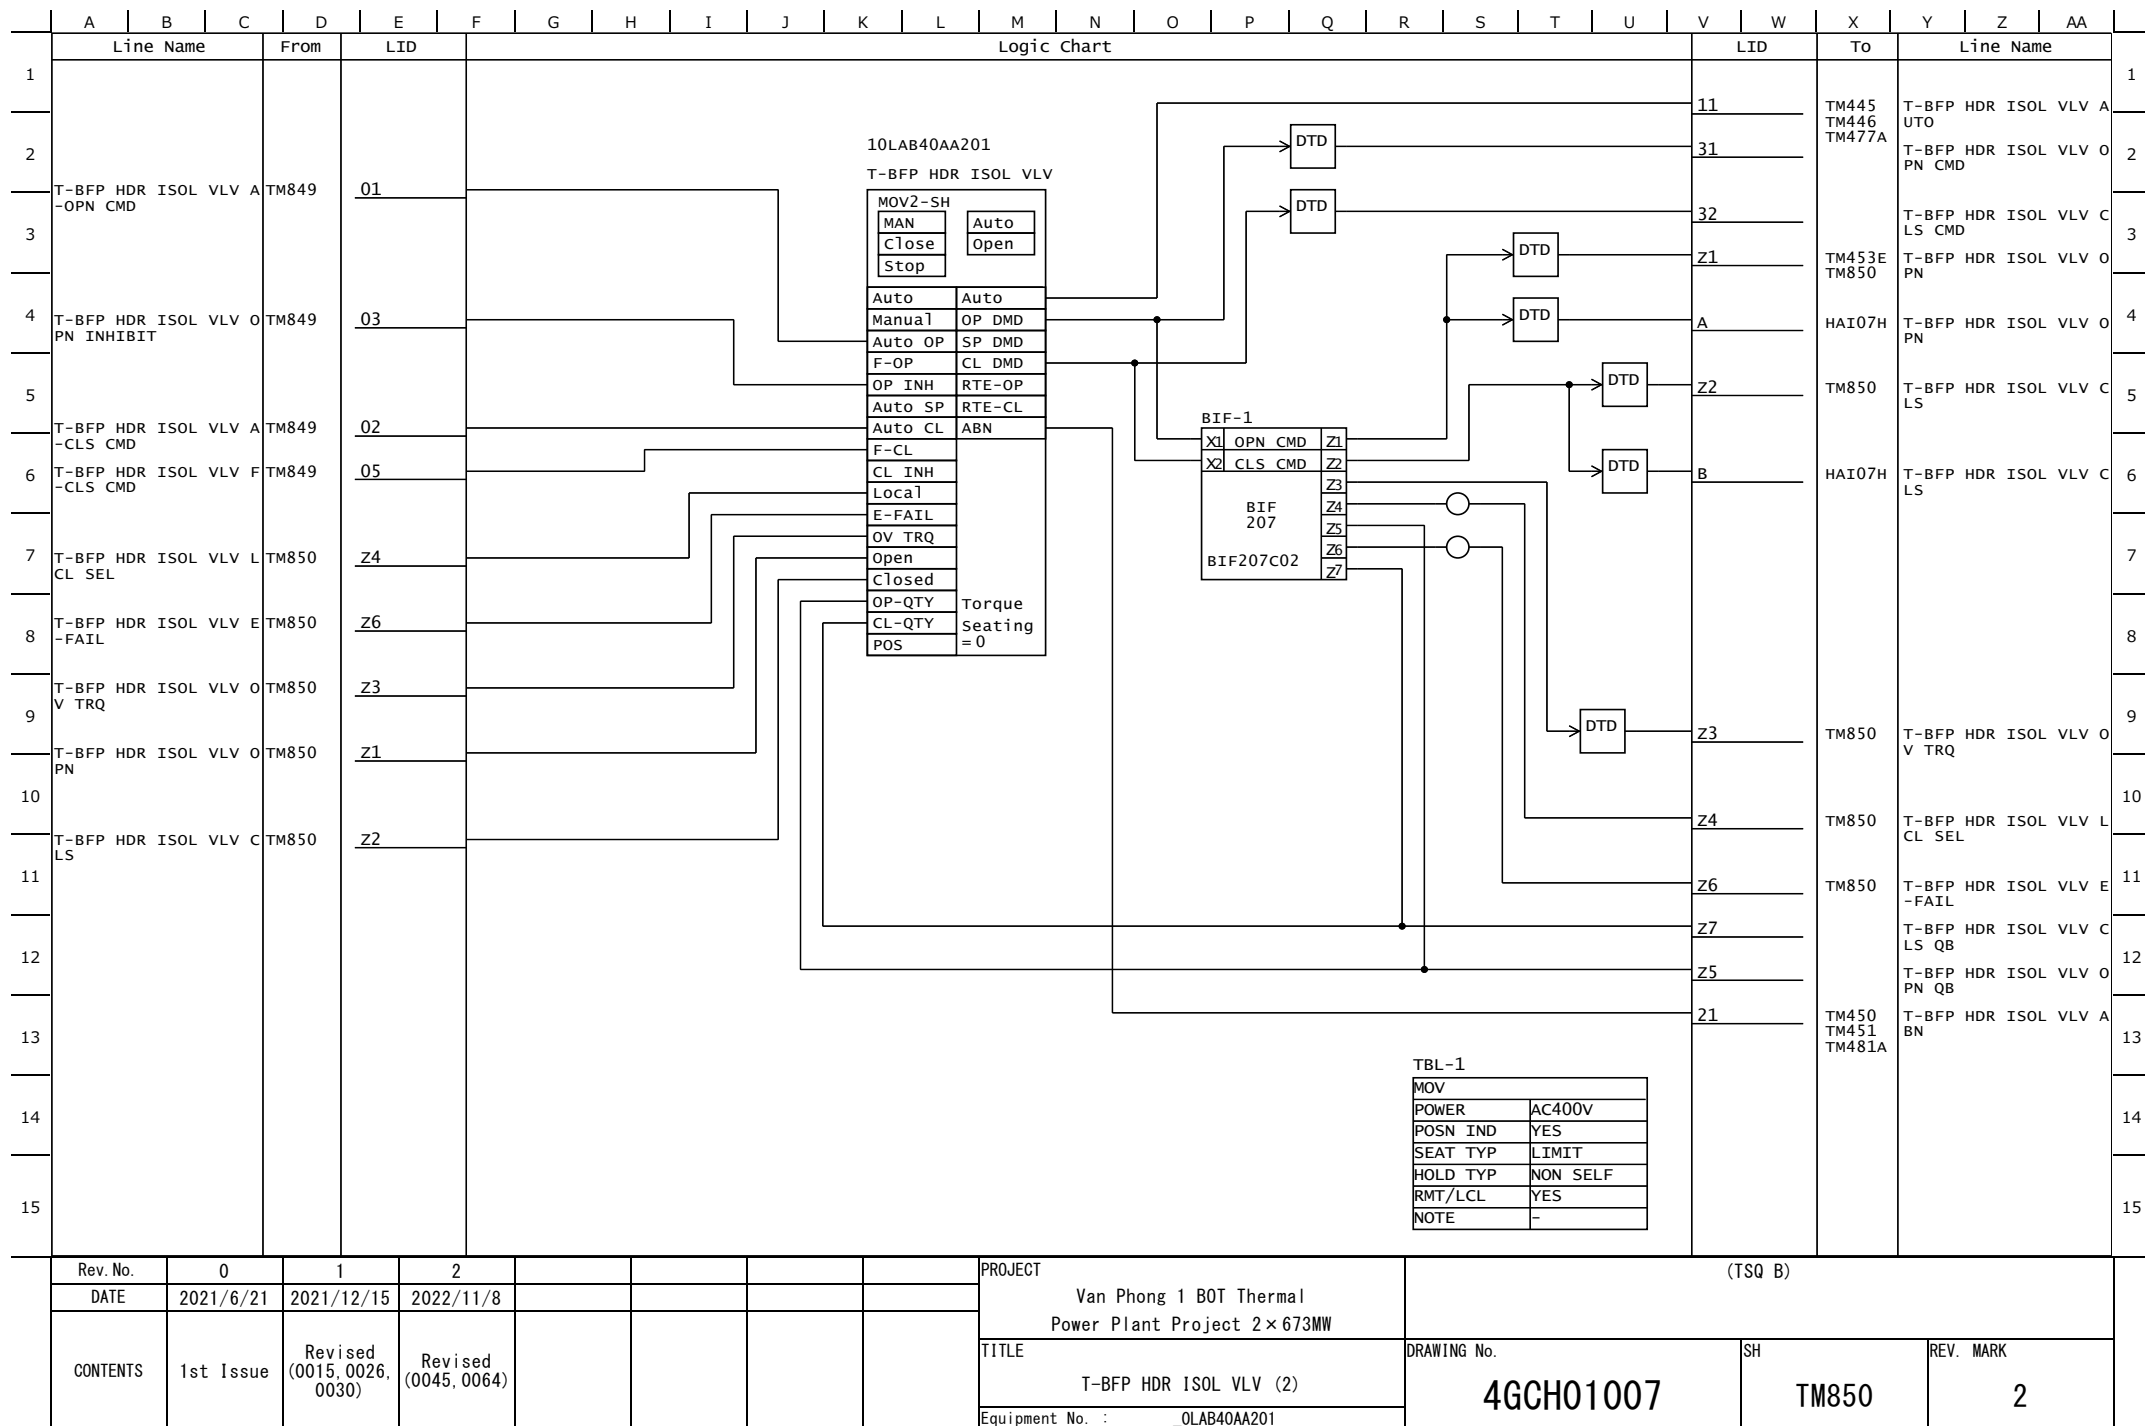

	A	B	C	D	E	F	G	H	I	J	K	L	M	N	O	P	Q	R	S	T	U	V	W	X	Y	Z	AA	
	Line Name			From	LID	Logic Chart																	LID	To	Line Name			
1	T-BFP A NOISE ECLSR FAN STRT CMD			TM851	21	→ DTD																	01	TM855	T-BFP A NOISE ECLSR FAN A-STRT CMD			1
2																												2
3																												3
4																												4
5																												5
6																												6
7	T-BFP A NOISE ECLSR FAN STP CMD			TM851	22	→ DTD																	02	TM855	T-BFP A NOISE ECLSR FAN A-STP CMD			7
8																												8
9																												9
10																												10
11																												11
12																												12
13																												13
14																												14
15																												15
Rev. No.				0	1	2					PROJECT				(TSQ B)													
DATE				2021/6/21	2021/12/15	2022/11/8					Van Phong 1 BOT Thermal Power Plant Project 2×673MW																	
CONTENTS				1st Issue	Revised (0022)	Revised (0045)					TITLE				DRAWING No.				SH		REV. MARK							
											T-BFP A NOISE ECLSR FAN (1)				4GCH01007				TM854		2							
											Equipment No. : _OLAC10AP060																	

	A	B	C	D	E	F	G	H	I	J	K	L	M	N	O	P	Q	R	S	T	U	V	W	X	Y	Z	AA
	Line Name			From	LID	Logic Chart																	LID	To	Line Name		
1	T-BFP A NOISE ECLSR FAN A-STRT CMD			TM854	01	10LAC10AP060 T-BFP A NOISE ECLSR FAN SWGR MAN Stop Lock Auto Start Unlock Auto Manual Lock Auto ST ST O/R ST INH Auto SP F-SP SP INH EXT-SP Local RACK Out E-FAIL Running Stopped RUN-QTY STP-QTY T-Reset TDWO-1 TDWO 5s IODO-1 IO DO 10LAC10AP060YB21 T-BFP A NOISE ECLSR FAN STRT CMD TBFP A LCP TDWO-2 TDWO 5s IODO-2 IO DO 10LAC10AP060YB24 T-BFP A NOISE ECLSR FAN STP CMD TBFP A LCP <td>11</td> <td rowspan="4">TM445 TM477A</td> <td rowspan="4">T-BFP A NOISE ECLSR FAN AUTO</td> <td>1</td>																	11	TM445 TM477A	T-BFP A NOISE ECLSR FAN AUTO	1	
2																							12			T-BFP A NOISE ECLSR FAN LCK	2
3																							13			T-BFP A NOISE ECLSR FAN STRT CMD	3
4																							14			T-BFP A NOISE ECLSR FAN STP CMD	4
5	T-BFP A NOISE ECLSR FAN LCL SEL			TM287	Y5																		19	T-BFP A NOISE ECLSR FAN TRIP	5		
6																									6		
7																									7		
8																									8		
9	T-BFP A NOISE ECLSR FAN RUN			TM287	Y4																		21	TM450	T-BFP A NOISE ECLSR FAN ABN	13	
10																										10	
11																										11	
12																										12	
13	T-BFP A NOISE ECLSR FAN RUN QB			TM287	41																		21	TM450	T-BFP A NOISE ECLSR FAN ABN	15	
14																										14	
15																											
Rev. No.				0	1	2	PROJECT										(TSQ B)										
DATE				2021/6/21	2021/12/15	2022/11/8	Van Phong 1 BOT Thermal Power Plant Project 2×673MW																				
CONTENTS				1st Issue	Revised (0007, 0022, 0024)	Revised (0045, 0048)	TITLE										DRAWING No.			SH	REV. MARK						
							T-BFP A NOISE ECLSR FAN (2)										4GCH01007			TM855	2						
							Equipment No. : 0LAC10AP060																				

11

TM445

TM477A

T-BFP A NOISE ECLSR FAN AUTO

	A	B	C	D	E	F	G	H	I	J	K	L	M	N	O	P	Q	R	S	T	U	V	W	X	Y	Z	AA				
	Line Name			From	LID	Logic Chart																	LID	To	Line Name						
1	TBFP B NOISE HOOD TEMPERATURE			TM150	Y3																				21	TM864	T-BFP B NOISE ECLSR FAN STRT CMD			1	
2																														2	
3																														3	
4						22	TM864	T-BFP B NOISE ECLSR FAN STP CMD			4																				
5											5																				
6											6																				
7											7																				
8	TBFP B NOISE HOOD TEMPERATURE			TM150	31																								8		
9																													9		
10																													10		
11																													11		
12																													12		
13																													13		
14																													14		
15																													15		

Rev. No.	0	1	2					PROJECT	(TSQ B)				
DATE	2021/6/21	2021/12/15	2022/11/8					Van Phong 1 BOT Thermal Power Plant Project 2×673MW					
CONTENTS	1st Issue	Revised (0022, 0030)	Revised (0056, 0064)					T-BFP B NOISE ECLSR FAN	DRAWING No.	SH	REV. MARK		
								Equipment No. : OLAC20AP060	4GCH01007	TM861	2		

	A	B	C	D	E	F	G	H	I	J	K	L	M	N	O	P	Q	R	S	T	U	V	W	X	Y	Z	AA				
	Line Name			From	LID	Logic Chart																			LID	To	Line Name				
1	T-BFP B NOISE ECLSR FAN A-STRT CMD			TM864	01	10LAC20AP060 T-BFP B NOISE ECLSR FAN SWGR MAN Stop Lock Auto Start Unlock Auto Manual Lock Auto ST ST O/R ST INH Auto SP F-SP SP INH EXT-SP Local RACK Out E-FAIL Running Stopped RUN-QTY STP-QTY T-Reset TDWO-1 TDWO 5s IOD0-1 IO DO 10LAC20AP060YB21 T-BFP B NOISE ECLSR FAN STRT CMD TBFP B LCP TDWO-2 TDWO 5s IOD0-2 IO DO 10LAC20AP060YB24 T-BFP B NOISE ECLSR FAN STP CMD TBFP B LCP TBL-1 MCC POWER RMT/LCL RTE NOTE AC 400V NO 5 SEC -																			11	TM446 TM477B	T-BFP B NOISE ECLSR FAN AUTO	1			
2																									12			T-BFP B NOISE ECLSR FAN LCK	2		
3																									13			T-BFP B NOISE ECLSR FAN STRT CMD	3		
4																									14			T-BFP B NOISE ECLSR FAN STP CMD	4		
5	T-BFP B NOISE ECLSR FAN A-STP CMD			TM864	02																				19		T-BFP B NOISE ECLSR FAN TRIP	5			
6																												6			
7																												7			
8																												8			
9	T-BFP B NOISE ECLSR FAN LCL SEL			TM287	Y7																							9			
10			10																												
11	T-BFP B NOISE ECLSR FAN RUN			TM287	Y6																									11	
12	T-BFP B NOISE ECLSR FAN RUN QB			TM287	61																									12	
13																									21	TM451	T-BFP B NOISE ECLSR FAN ABN	13			
14																												14			
15																												15			
Rev. No.				0	1	2													PROJECT				(TSQ B)								
DATE				2021/6/21	2021/12/15	2022/11/8													Van Phong 1 BOT Thermal Power Plant Project 2×673MW												
CONTENTS				1st Issue	Revised (0007, 0022, 0024)	Revised (0045, 0048)													TITLE				DRAWING No.		SH	REV. MARK					
																			T-BFP B NOISE ECLSR FAN (2)				4GCH01007			TM865	2				
																			Equipment No. : 0LAC20AP060												

T11

TM446

TM477B

T-BFP B NOISE ECLSR FAN AUTO


	A	B	C	D	E	F	G	H	I	J	K	L	M	N	O	P	Q	R	S	T	U	V	W	X	Y	Z	AA	
	Line Name			From	LID	Logic Chart																	LID	To	Line Name			
1																												1
2																												2
3	MBFP AUXOP RUN			TM930	Z1																							3
4	MBFP LUBE OIL PRESS LO			TM204	Y3																		01	TM921	M-BFP LKG-STRT PERMIT			4
5	M-BFP MIN FCV POSN			MD109	04																							5
6	M-BFP FLU CPL POSN			TM365	01																							6
7	M-BFP HYDCPLG ABN			TM372C	04																							7
8																												8
9	MBFP STRT INHIBIT OF BRL TEMP CNDN			TM951	11																							9
10	MBFP BSTR PP I/L VLV OPN			TM202	Y3																							10
11																												11
12																												12
13	M-BFP F-STP			TM920	01																		04	TM921	MBFP SERV IN MA STRT INH (1)			13
14	M-BFP MOT WTR LK			TM330	01																		02	TM921	M-BFP STRT INH			14
15	MBFP OTL VLV CLS			TM945	Z2																		03	TM921	M-BFP LKG-STP INH			15
	Rev. No.	0	1	2																		(TSQ B)						
	DATE	2021/6/21	2021/12/15	2022/11/8																								
	CONTENTS	1st Issue	Revised (0007, 0015)	Revised (0048)																		DRAWING No.		SH	REV. MARK			
																						4GCH01007		TM919	2			


	A	B	C	D	E	F	G	H	I	J	K	L	M	N	O	P	Q	R	S	T	U	V	W	X	Y	Z	AA	
	Line Name			From	LID	Logic Chart																	LID	To	Line Name			
1	M-BFP STRT CMD(BSQ)			TM388	01																		01	TM925	MBFP MOT A-STRT CMD			1
2	M-BFP STRT CMD (PAS)			TM371	01																					2		
	MBFP STRT CMD			TM441B	11																					3		
3																										4		
4	M-BFP STP CMD (PAS)			TM371	02																		02	TM925	MBFP MOT A-STOP CMD			4
5	MBFP STP CMD			TM474C	11																					5		
6	M-BFP STRT INH			TM919	02																		03	TM925	MBFP MOT STRT INH			6
7	M-BFP F-STP			TM920	01																					7		
	MBFP MOT RESTRT INH			TM321	ZA																					8		
8	MBFP SERV IN MA STRT INH (1)			TM919	04																		13	TM436	MBFP SERV IN MA STRT INH (2)			8
9	M-BFP LKG-STRT PERMIT			TM919	01																					9		
10																										10		
11	M-BFP LKG-STP INH			TM919	03																		05	TM925	MBFP MOT LKG-STP INH			11
12																										12		
13	MBFP MOT 1 RUN QB			TM200	11																		11	TM925	MBFP MOT RUN QB			13
	MBFP MOT 2 RUN QB			TM201	11																					14		
14	MBFP MOT 1 STPD QB			TM200	12																		12	TM925	MBFP MOT STPD QB			14
	MBFP MOT 2 STPD QB			TM201	12																					15		
15																										15		
	Rev.No.	0	1	2						PROJECT									(TSQ B)									
	DATE	2021/6/21	2021/12/15	2022/11/8						Van Phong 1 BOT Thermal Power Plant Project 2×673MW																		
	CONTENTS	1st Issue	Revised (0015)	Revised (0048)						TITLE									DRAWING No.				SH		REV. MARK			
										MBFP (3)									4GCH01007				TM921		2			
										Equipment No. : OLAC30AP010																		

A	B	C	D	E	F	G	H	I	J	K	L	M	N	O	P	Q	R	S	T	U	V	W	X	Y	Z	AA																								
Line Name			From	LID	Logic Chart																	LID	To	Line Name																										
1	MBFP MOT A-STRT CMD MBFP MOT STRT INH MBFP MOT LKG-ST INH MBFP MOT A-STOP CMD M-BFP F-STP MBFP MOT LKG-STP INH MBFP MOT LCL SEL MBFP MOT RO MBFP MOT E-FAIL MBFP MOT RUN MBFP MOT STPD MBFP MOT RUN QB MBFP MOT STPD QB			TM921	01	10LAC30AP010 MBFP SWGR-L MAN Stop Lock Auto Start Unlock Auto Manual Lock Auto ST ST O/R ST INH L-ST INH Auto SP F-SP SP INH L-SP INH EXT-SP Local RACK Out E-FAIL Running Stopped RUN-QTY STP-QTY T-Reset TDWO-1 TDWO-3 TDWO-2 TDWO-4 DI-1 DTD IODO-1 IODO-2 IODO-3 IODO-4 DI 10LAC30AP010YB21 M-BFP STRT CMD 1 10LAC30AP010YB22 M-BFP STRT CMD 2 10LAC30AP010YB24 M-BFP STP CMD 1 10LAC30AP010YB25 M-BFP STP CMD 2 TBL-1 MV SWGR POWER RMT/LCL RTE NOTE AC 10kv YES 5 SEC -																	11	TF406 TM422 TM435 TM466A TM470	MBFP AUTO																									
2				12	TM422 TM466A																		MBFP LCK																											
3				14	MD109 TM929																						MBFP LINK STRT																							
4				06	TM944																								MBFP LKG STP																					
5				19																											MBFP TRIP																			
6																																																		
7																																																		
8																																																		
9																																																		
10																																																		
11																																																		
12																																																		
13				A	B8908																																										MBFP ABN			
14				21	TF408 TM422 TM437 TM466A TM472																																												MBFP ABN	
15																																																		

Rev. No.	0	1	2	3					PROJECT	(TSQ B)			
DATE	2021/6/21	2021/12/15	2022/11/8	2023/7/5					Van Phong 1 BOT Thermal Power Plant Project 2×673MW				
CONTENTS	1st Issue	Revised (0007, 0015, 0026)	Revised (0032, 0064)	Revised (0186)					TITLE	DRAWING No.	SH	REV. MARK	
									MBFP (4)	4GCH01007	TM925	3	
									Equipment No. :	0LAC30AP010			


	A	B	C	D	E	F	G	H	I	J	K	L	M	N	O	P	Q	R	S	T	U	V	W	X	Y	Z	AA				
	Line Name			From	LID	Logic Chart																	LID	To	Line Name						
1	M-BFP F-STP			TM920	01																		01	TM930	M-BFP AUXOP STRT CMD			1			
2																												2			
3																												3			
4																												4			
5																												5			
6																												6			
7	MBFP LINK STRT			TM925	14																							7			
4	MBFP MOT STPD			TM320	02																							4			
5	MBFP LUBE OIL PRESS LO			TM204	Y3																							5			
6	MBFP MOT RUN			TM320	01																							6			
7																												7			
8																												8			
9																							02	TM930	M-BFP AUXOP STP CMD			9			
10																												10			
11	MBFP FLU CPL BRG 1 M TL TEMP HI			TM127	41																		03	TM930	M-BFP AUXOP STRT INH			11			
12	MBFP FLU CPL BRG 2 M TL TEMP HI			TM127	42																										12
13	MBFP FLU CPL BRG 3 M TL TEMP HI			TM127	43																										13
14	MBFP FLU CPL BRG 4 M TL TEMP HI			TM128	41																										14
15	MBFP FLU CPL BRG 5 M TL TEMP HI			TM128	42																										15
	MBFP FLU CPL BRG 6 M TL TEMP HI			TM128	43																										
	MBFP FLU CPL BRG 7 M TL TEMP HI			TM129	41																										
	MBFP FLU CPL BRG 8 M TL TEMP HI			TM129	42																										
	MBFP FLU CPL BRG 9 M TL TEMP HI			TM129	43																										
15	MBFP FLU CPL BRG 10 MTL TEMP HI			TM130	41																							15			
	Rev. No.	0	1	2										PROJECT					(TSQ B)												
	DATE	2021/6/21	2021/12/15	2022/11/8										Van Phong 1 BOT Thermal Power Plant Project 2×673MW																	
	CONTENTS	1st Issue	Revised (0015)	Revised (0048)										TITLE					DRAWING No.					SH			REV. MARK				
														MBFP AUXOP (1)					4GCH01007					TM929			2				
														Equipment No. : OLAV30AP020																	

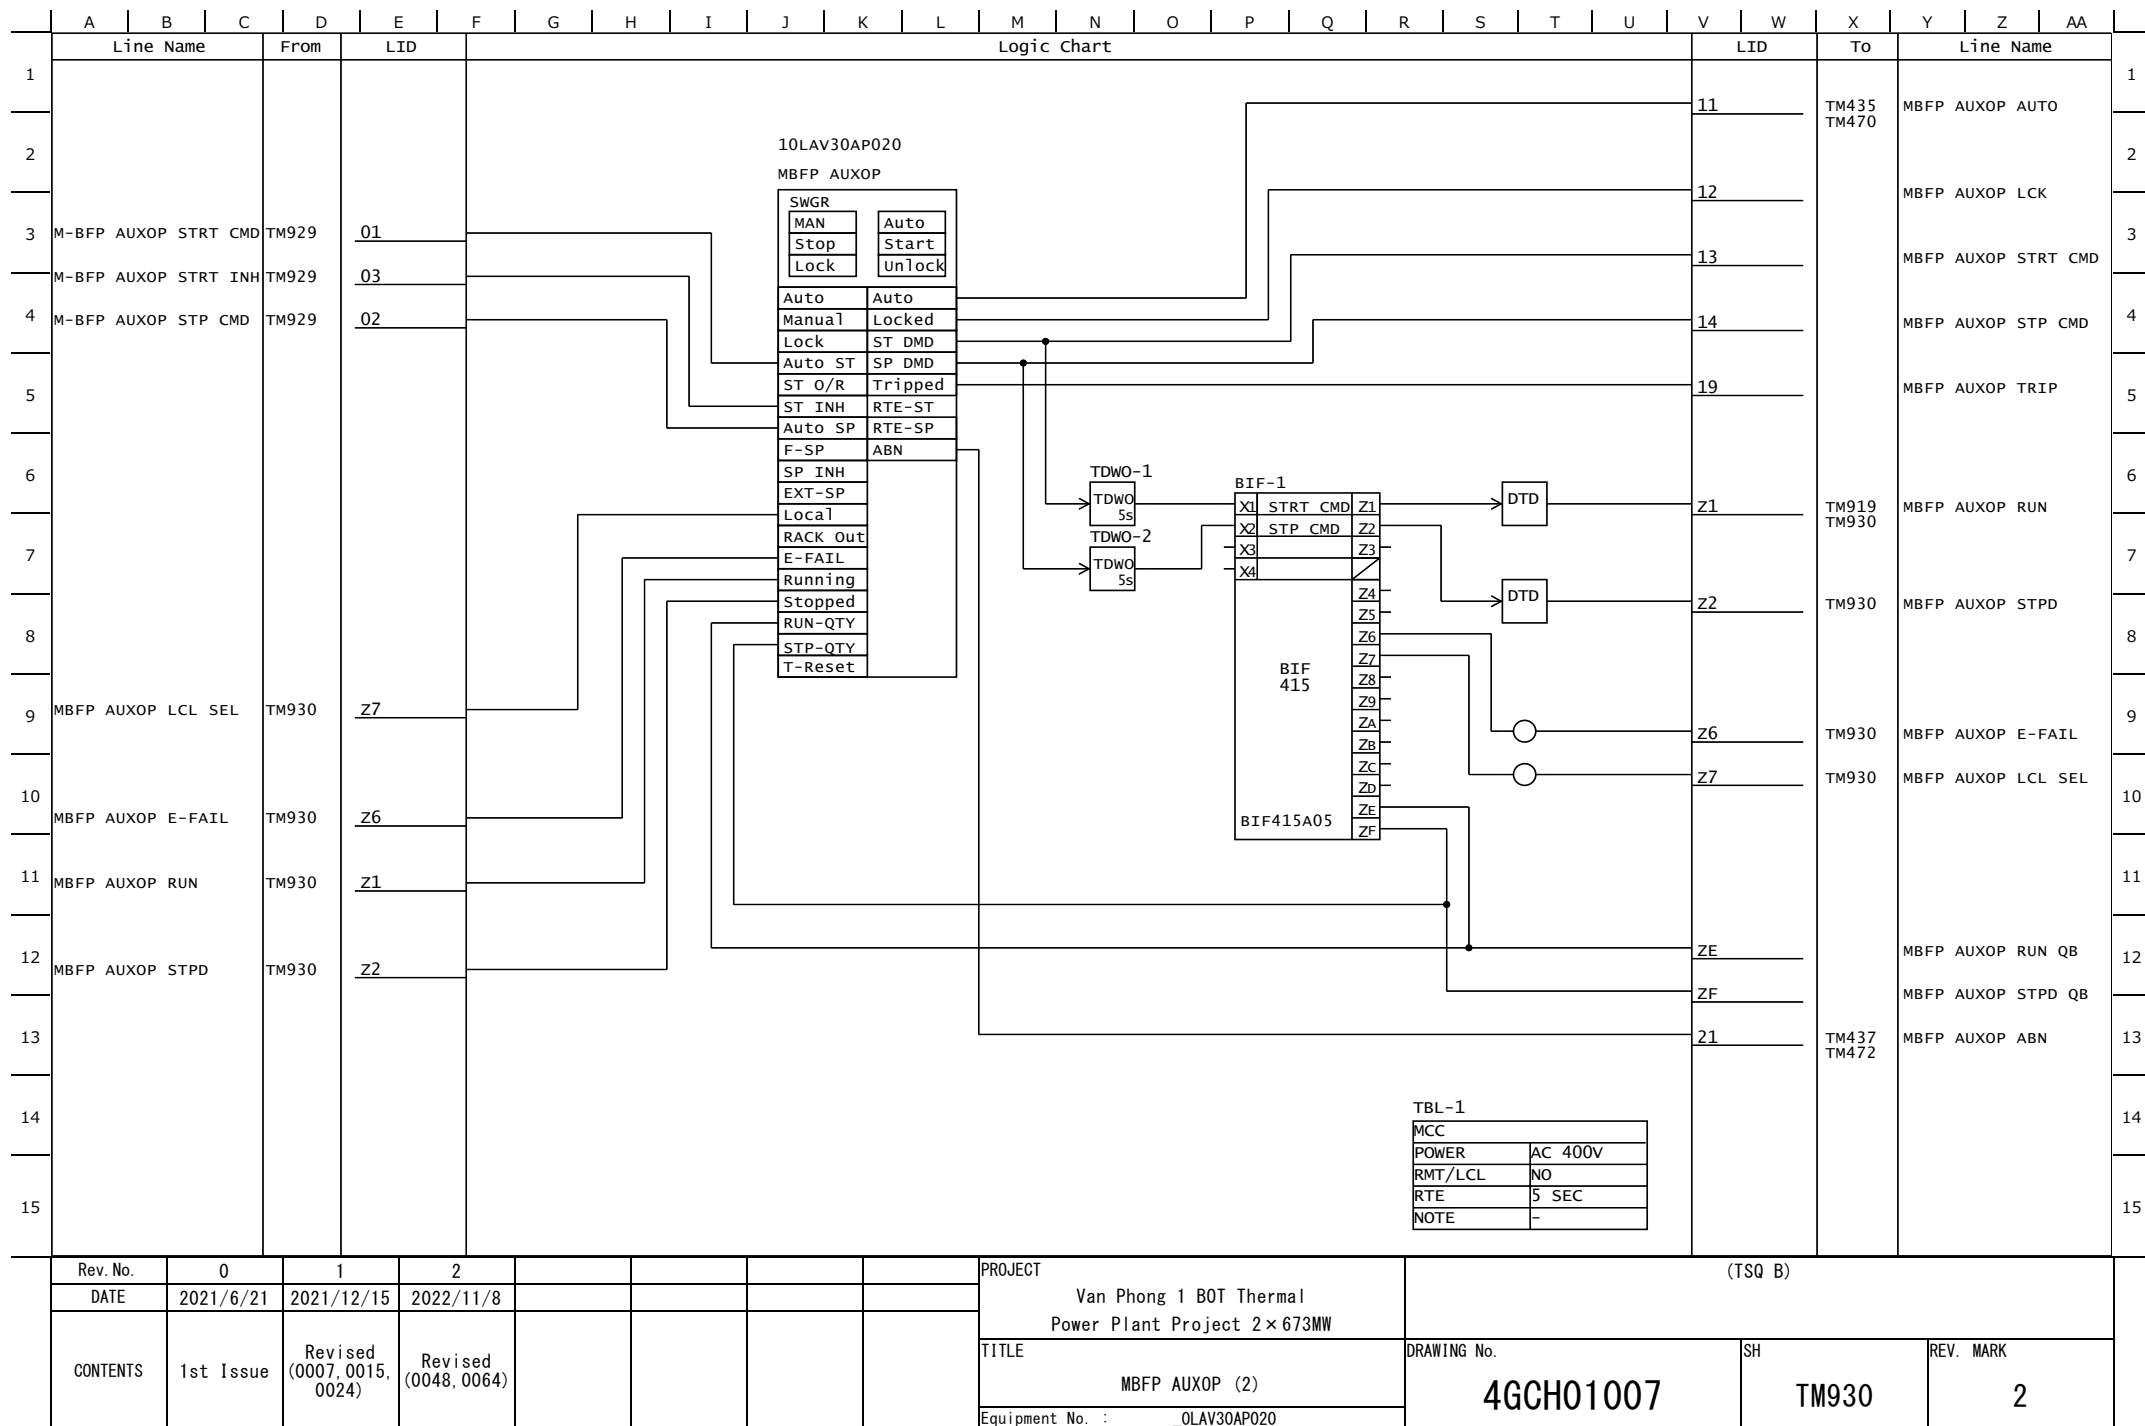

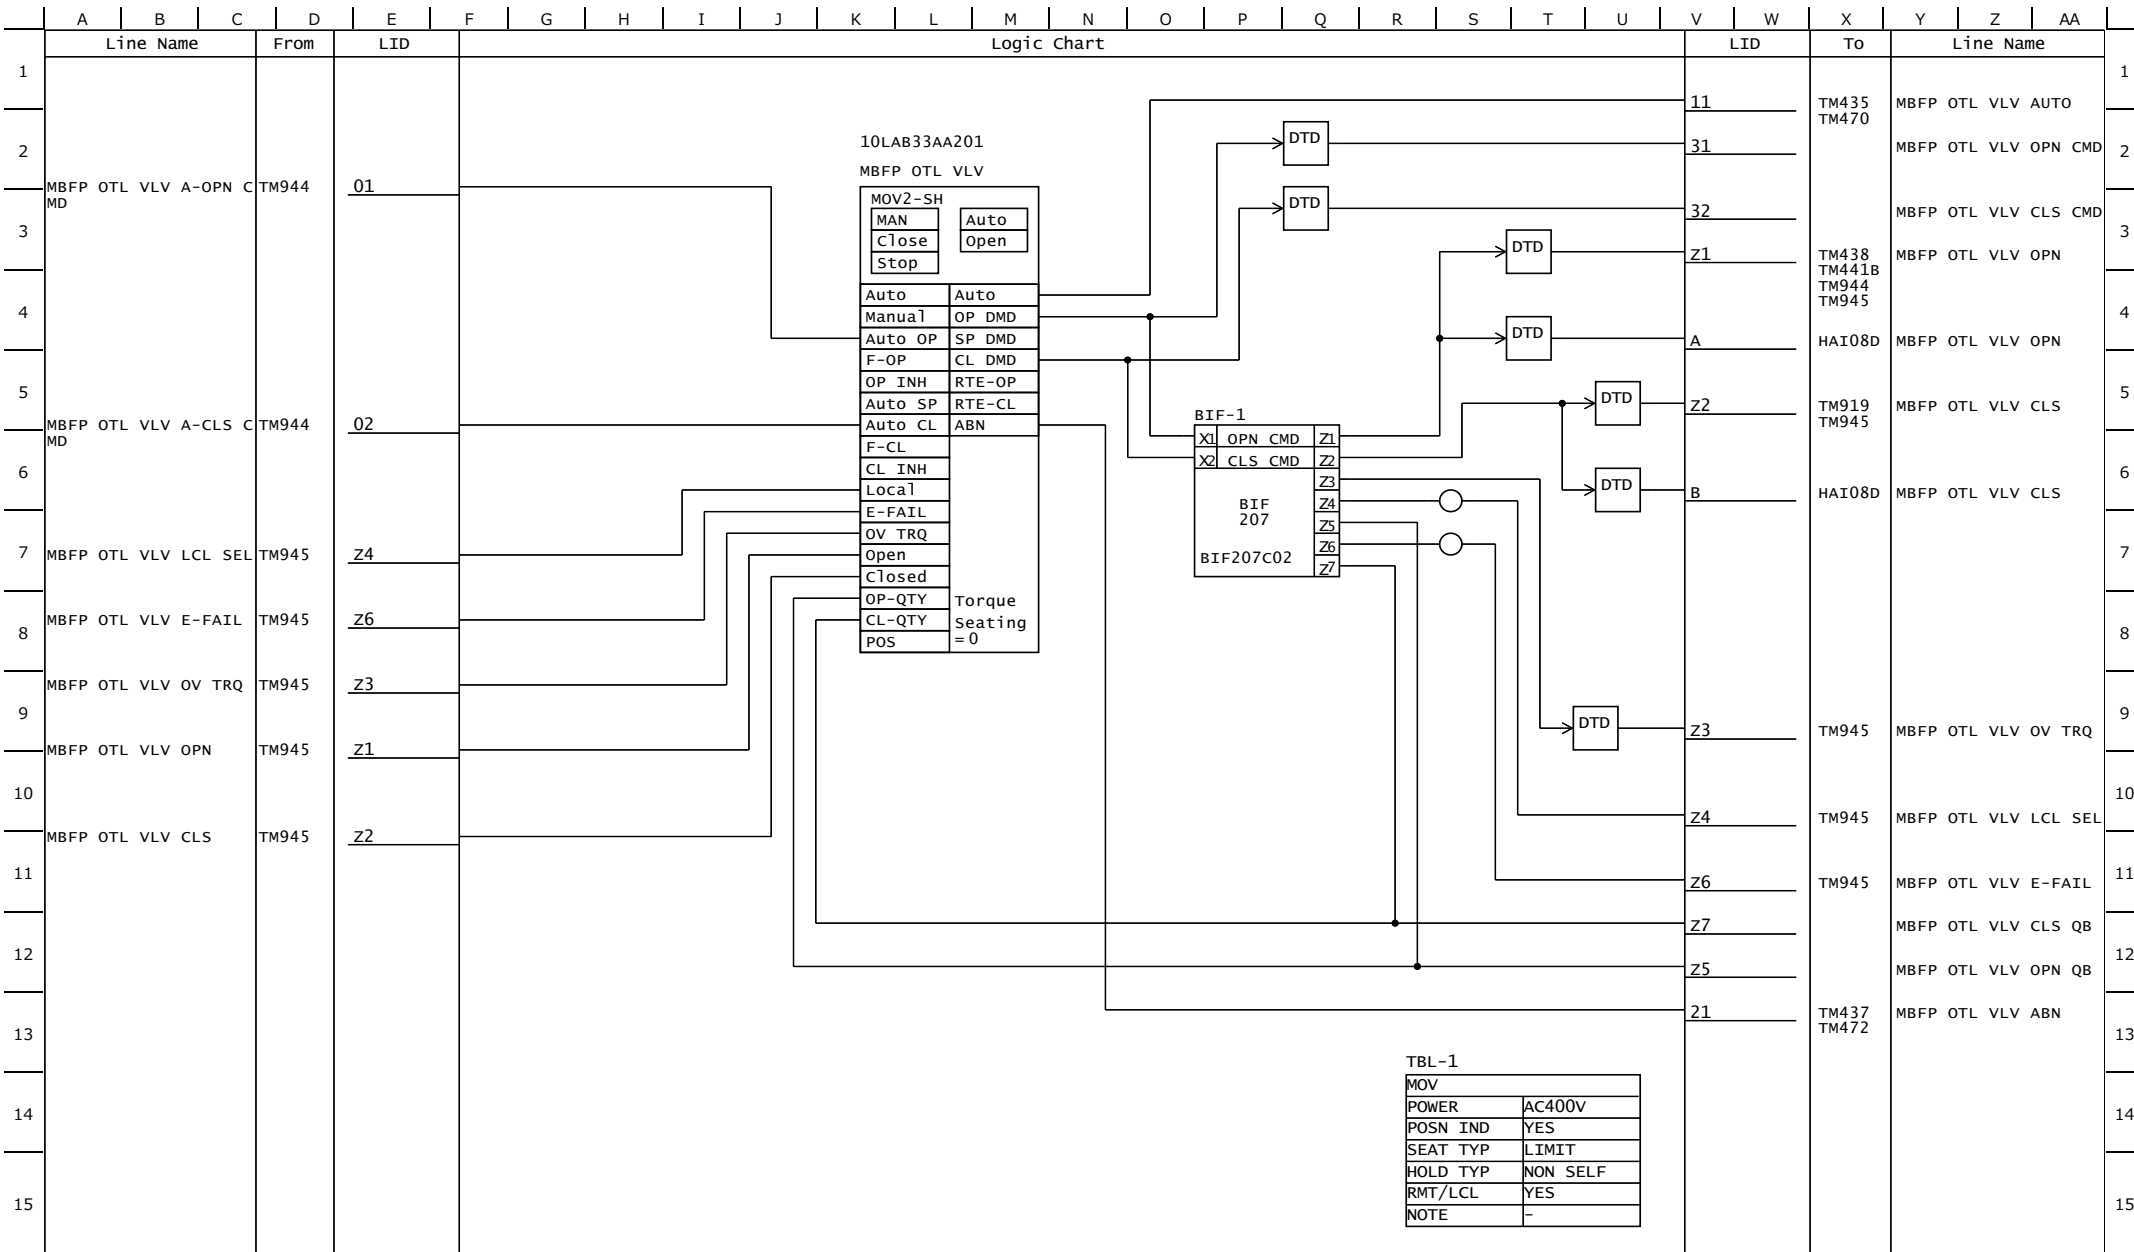

Rev. No.	0	1	2					PROJECT Van Phong 1 BOT Thermal Power Plant Project 2×673MW	(TSQ B)			
DATE	2021/6/21	2021/12/15	2022/11/8									
CONTENTS	1st Issue	Revised (0015, 0026, 0030)	Revised (0045, 0064)					TITLE	DRAWING No.	SH	REV. MARK	
								MBFP OTL VLV (2)	4GCH01007	TM945	2	
								Equipment No. : _OLAB33AA201				


	A	B	C	D	E	F	G	H	I	J	K	L	M	N	O	P	Q	R	S	T	U	V	W	X	Y	Z	AA							
	Line Name		From	LID	Logic Chart																	LID	To	Line Name										
1																											1							
2	DFWT TEMP		TF131	Y4	10LAA30CT051ZV26 MBFP BRL TMP DEV(DEA &TP AVE) ALM1F C/0-H 1H C/0-L 1L QTY QTY SIH= 50 SIL= -999999 degC T1H= 0 T1L= 0 S [SIH RESET=45degC]																				01	TM951	MBFP BRL TMP DEV(DEA &BTM AVE) HI			2				
3	MBFP BRL TMP AVE(TP-SCTN&DSCH)		TM950	21						3																								
4										4																								
5																											5							
6																											6							
7	MBFP UPR BRL TEMP A QB		TM119	11	10LAC30CT057ZQ06 MBFP BRL TMP AVE(TP-SCTN&DSCH) ALM1F C/0-H 1H C/0-L 1L QTY QTY SIH= 99999 SIL= -999999 degC T1H= 0 T1L= 0 S																				21	TM950	MBFP BRL TMP AVE(TP-SCTN&DSCH)			7				
8	MBFP UPR BRL TEMP A		TM119	Y1						8																								
9							MBFP BRL TMP AVE HI(TP-SCTN&DSCH)			9																								
10	MBFP LWR BRL TEMP A QB		TM120	11						10																								
11	MBFP LWR BRL TEMP A		TM120	Y1																							11							
12	MBFP UPR BRL TEMP B QB		TM119	21	10LAC30CT058ZQ06 MBFP BRL TMP AVE(BTM-SCTN&DSCH) ALM1F C/0-H 1H C/0-L 1L QTY QTY SIH= 999999 SIL= -999999 degC T1H= 0 T1L= 0 S																				31		MBFP BRL TMP AVE(BTM-SCTN&DSCH)			12				
13	MBFP UPR BRL TEMP B		TM119	Y2						13																								
14	MBFP LWR BRL TEMP B QB		TM120	21						14																								
15	MBFP LWR BRL TEMP B		TM120	Y2																				MBFP BRL TMP AVE HI(BTM-SCTN&DSCH)			15							
Rev. No.					0	1	2								PROJECT					(TSQ B)														
DATE					2021/6/21	2021/12/15	2022/11/8								Van Phong 1 BOT Thermal Power Plant Project 2×673MW																			
CONTENTS					1st Issue	Revised (0015)	Revised & Tuning (0056, 0064, 0080)								TITLE					DRAWING No.					SH			REV. MARK						
															MBFP CONDITION (1)					4GCH01007					TM950			2						
															Equipment No. : -																			

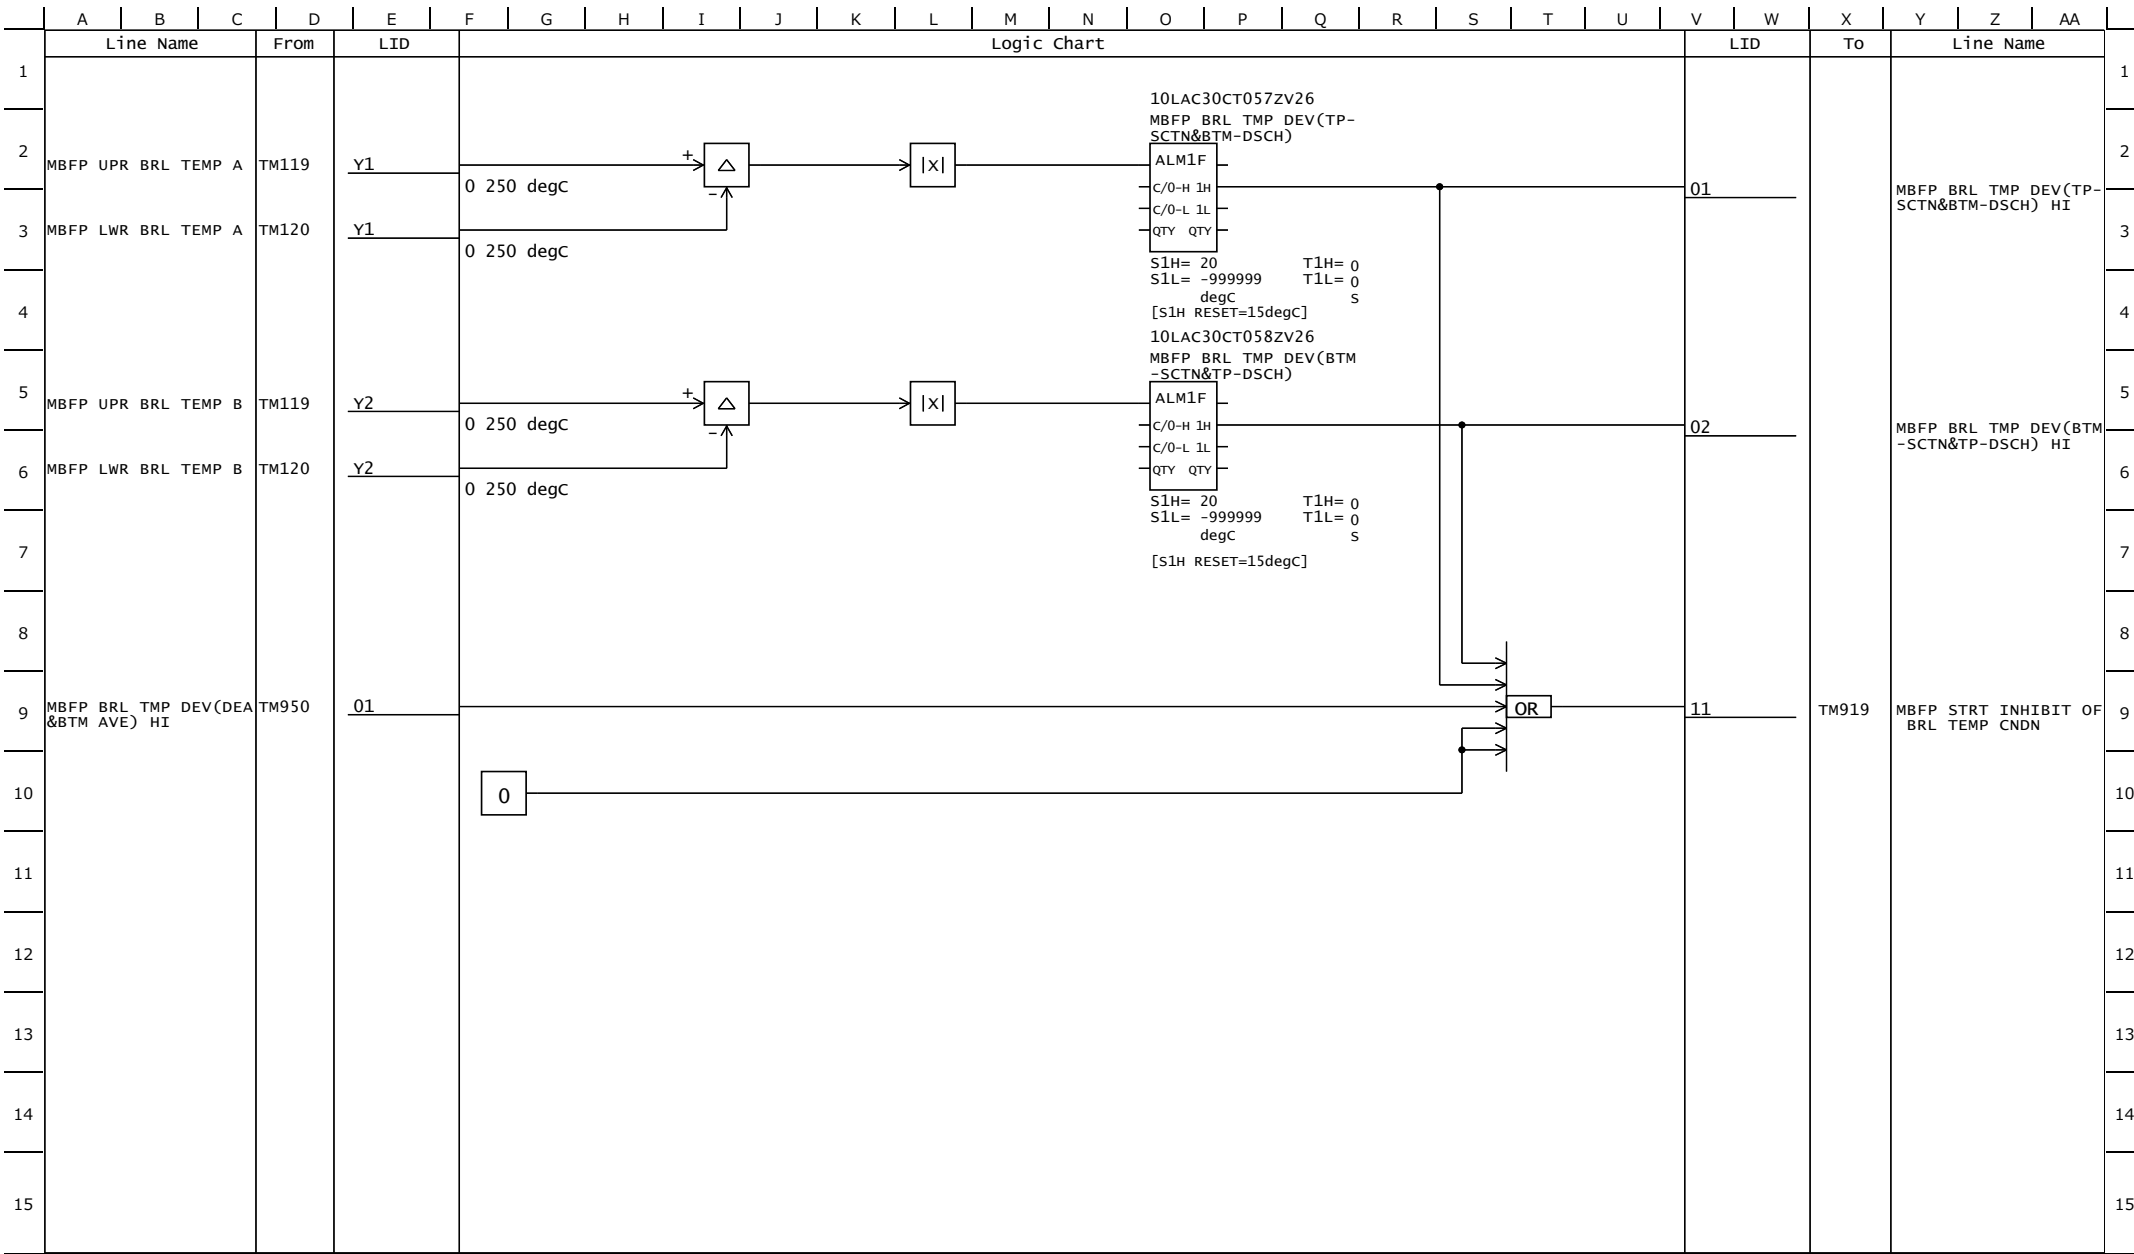

Rev. No.	0	1	2	3				PROJECT	(TSQ B)				
DATE	2021/6/21	2021/12/15	2022/11/8	2023/7/5				Van Phong 1 BOT Thermal Power Plant Project 2×673MW					
CONTENTS	1st Issue	Revised (0015)	Revised & Tuning (0056, 0064, 0080)	Tuning (0186)				MBFP CONDITION (2)	DRAWING No.	SH	REV. MARK		
								Equipment No. : -	4GCH01007	TM951	3		

	A	B	C	D	E	F	G	H	I	J	K	L	M	N	O	P	Q	R	S	T	U	V	W	X	Y	Z	AA	
	Line Name			From	LID	Logic Chart																	LID	To	Line Name			
1	MBFP NOISE HOOD TEMP			TM130	Y2	1 H-1 S= 30 R= 28 degC DI-1 5s L-1 S= 30 R= 32 degC DI-2 30s H-2 S= 35 R= 33 degC DI-3 5s L-2 S= 30 R= 32 degC DI-4 30s A A A A																	21	TM964	MBFP NOISE ECLSR FAN A STRT CMD			1
2																												2
3																												3
4																												4
5																												5
6																												6
7																												7
8																												8
9	MBFP NOISE HOOD TEMP QB			TM130	21	A																						9
10																												10
11																												11
12																												12
13																												13
14																												14
15																												15



Rev. No.	0	1	2	3				PROJECT	(TSQ B)			
DATE	2021/6/21	2021/12/15	2022/11/8	2023/7/5				Van Phong 1 BOT Thermal Power Plant Project 2×673MW				
CONTENTS	1st Issue	Revised (0030)	Revised (0056, 0064, 0079)	Revised (0186)				TITLE	DRAWING No.	SH	REV. MARK	
								MBFP NOISE ECLSR FAN	4GCH01007	TM961	3	
								Equipment No. : _OLAC21AP060/61				

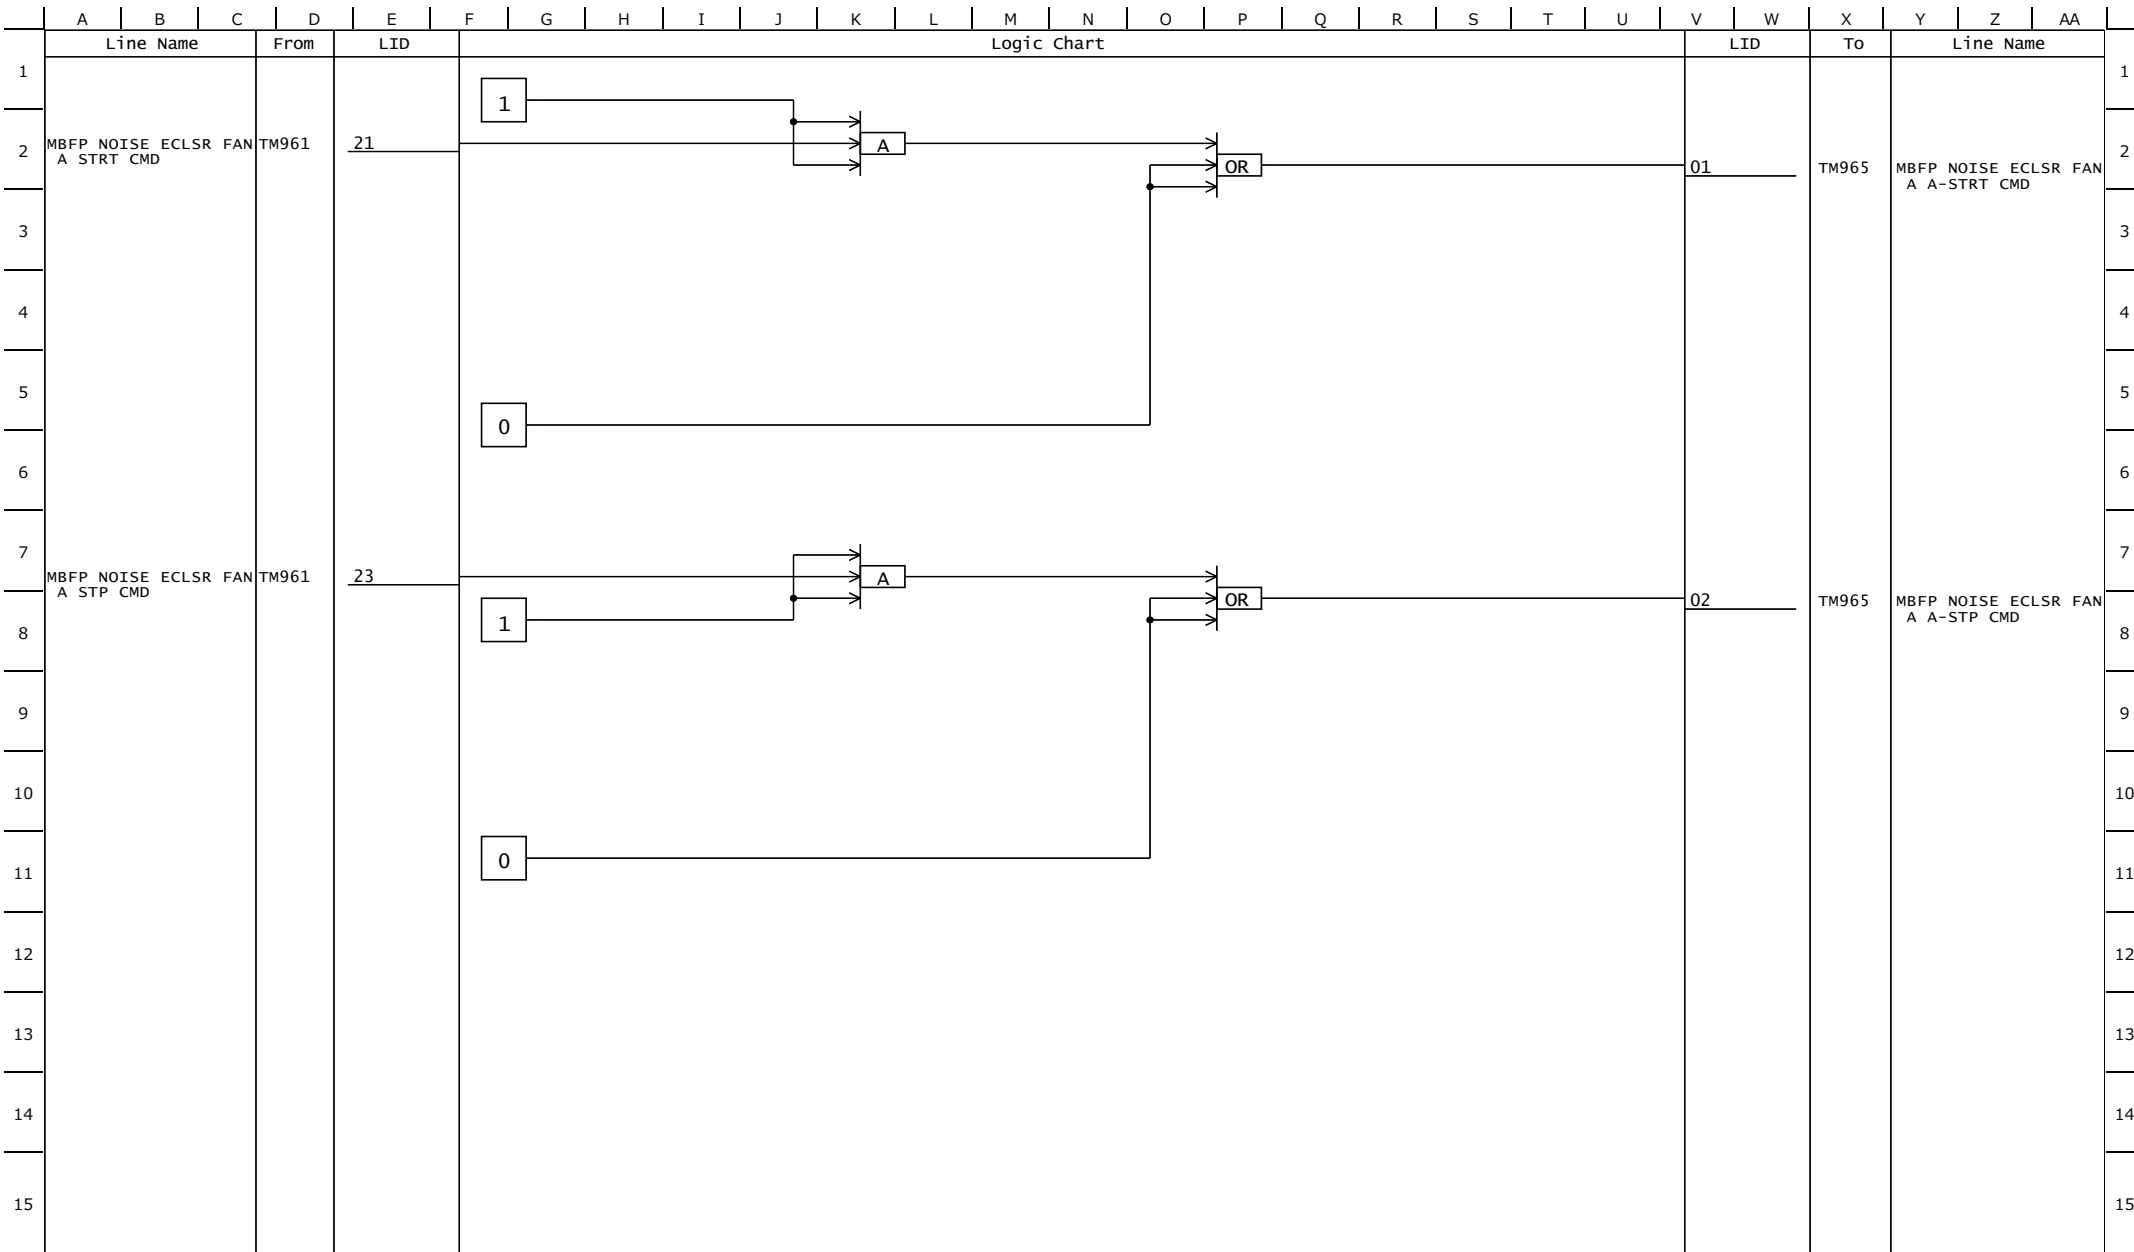

Rev. No.	0	1						PROJECT Van Phong 1 BOT Thermal Power Plant Project 2×673MW	(TSQ B)			
DATE	2021/6/21	2021/12/15										
CONTENTS	1st Issue	Revised (0030)						TITLE	DRAWING No.	SH	REV. MARK	
								MBFP NOISE ECLSR FAN A (1)	4GCH01007	TM964	1	
								Equipment No. : _OLAC21AP060				

A	B	C	D	E	F	G	H	I	J	K	L	M	N	O	P	Q	R	S	T	U	V	W	X	Y	Z	AA	
Line Name			From	LID	Logic Chart																	LID	To	Line Name			
1	MBFP NOISE ECLSR FAN A A-STRT CMD			TM964	01	10LAC21AP060 MBFP NOISE ECLSR FAN A SWGR MANStopLock AutoStartUnlock AutoManualLock Auto STLock ST O/RST INH Auto SPF-SP SP INHEXT-SPLocal RACK OutE-FAILRunningStopped RUN-QTYSTP-QTYT-Reset <td>11</td> <td rowspan="5">TM435</td> <td colspan="2">MBFP NOISE ECLSR FAN A AUTO</td> <td>1</td>																	11	TM435	MBFP NOISE ECLSR FAN A AUTO		1
2																							12		MBFP NOISE ECLSR FAN A LCK		2
3																							13		MBFP NOISE ECLSR FAN A STRT CMD		3
4																							14		MBFP NOISE ECLSR FAN A STP CMD		4
5																							19		MBFP NOISE ECLSR FAN A TRIP		5
6	MBFP NOISE ECLSR FAN A A-STP CMD			TM964	02	TDWO-1 TDWO5s IODO-1 IO DO 10LAC21AP060YB21 MBFP NOISE ECLSR FAN A STRT CMD MBFP LCP <td>6</td> <td rowspan="5"></td> <td colspan="2" rowspan="5"></td> <td>6</td>																	6				6
7																							7				
8																							8				
9																							9				
10																							10				
11	MBFP NOISE ECLSR FAN A LCL SEL			TM288	Y2	TDWO-2 TDWO5s IODO-2 IO DO 10LAC21AP060YB24 MBFP NOISE ECLSR FAN A STP CMD MBFP LCP <td>11</td> <td rowspan="5"></td> <td colspan="2" rowspan="5"></td> <td>11</td>																	11				11
12																							12				
13																							13				
14																							14				
15																							15				
MBFP NOISE ECLSR FAN A RUN			TM288	Y1	TBL-1 MCC POWERAC 400V RMT/LCLNO RTE5 SEC NOTE- <td>21</td> <td rowspan="5">TM437</td> <td colspan="2" rowspan="5">MBFP NOISE ECLSR FAN A ABN</td> <td>13</td>																	21	TM437	MBFP NOISE ECLSR FAN A ABN		13	
																						14				14	
																						15				15	
																						16				16	
																						17				17	
MBFP NOISE ECLSR FAN A RUN QB			TM288	11																		21				13	
																						14				14	
																						15				15	
																						16				16	
																						17				17	

Rev. No.	0	1	2						PROJECT	Van Phong 1 BOT Thermal Power Plant Project 2×673MW				(TSQ B)						
DATE	2021/6/21	2021/12/15	2022/11/8						TITLE	MBFP NOISE ECLSR FAN A (2)				DRAWING No.				SH	REV. MARK	
CONTENTS	1st Issue	Revised (0007, 0015, 0030)	Revised (0048)						Equipment No. :	0LAC21AP060				4GCH01007				TM965	2	

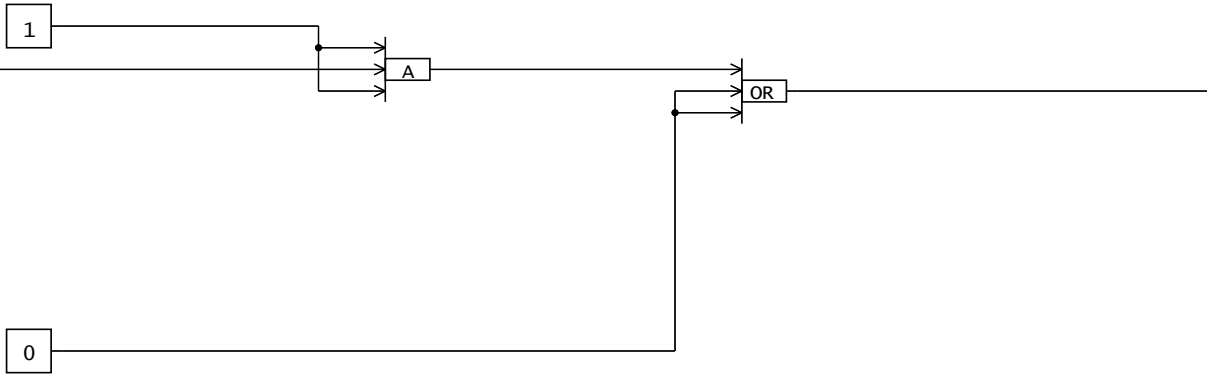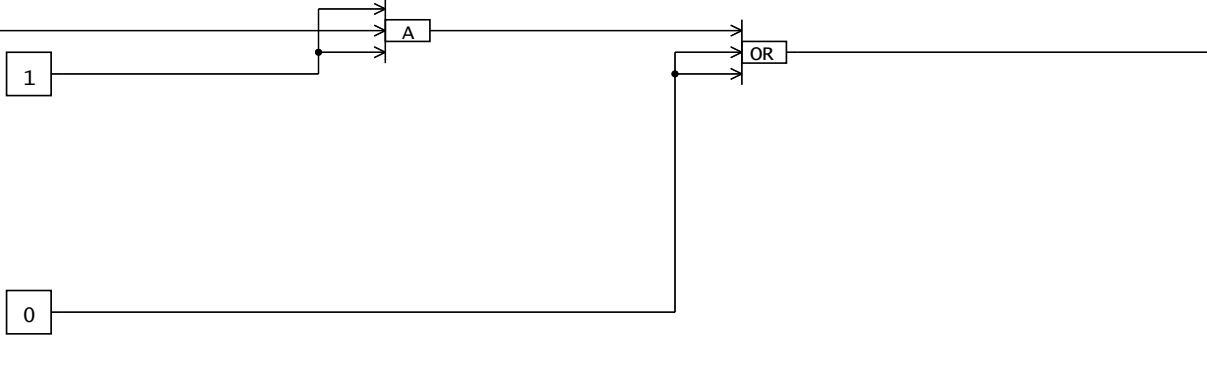	A	B	C	D	E	F	G	H	I	J	K	L	M	N	O	P	Q	R	S	T	U	V	W	X	Y	Z	AA			
	Line Name			From	LID	Logic Chart																	LID	To	Line Name					
1	MBFP NOISE ECLSR FAN B STRT CMD			TM961	22																				01	TM970	MBFP NOISE ECLSR FAN B A-STRT CMD			1
2																														2
3																														3
4																														4
5																														5
6																														6
7	MBFP NOISE ECLSR FAN B STP CMD			TM961	24																				02	TM970	MBFP NOISE ECLSR FAN B A-STP CMD			7
8																														8
9																														9
10																														10
11																														11
12																														12
13																													13	
14																													14	
15																													15	
Rev. No.		0		1										PROJECT		(TSQ B)														
DATE		2021/6/21		2021/12/15										Van Phong 1 BOT Thermal Power Plant Project 2×673MW																
CONTENTS		1st Issue		Revised (0030)										TITLE		DRAWING No.				SH		REV. MARK								
														MBFP NOISE ECLSR FAN B (1)		4GCH01007				TM969		1								
														Equipment No. : OLAC21AP061																

